•	
	INDEX TO DRAWINGS
SHEET NO.	DESCRIPTION
Ļ	TITLE SHEET
2	STANDARD PLAN SUMMARY
3	GENERAL NOTES & LEGEND
4	TYPICAL SECTIONS & DETAILS
5-9	PLANS
10	PAVEMENT MARKING LEGEND,
	DETAILS & NOTES
11-15	SIGNING & PAVING MARKING PLANS
16	SIGN DETAILS & TRAFFIC SUMMARIES
·	
·	

MARCH, 1992 DATE

587-2242 PHONE

JULIUS B. FRONDA P. S. & E. BY STATE OF HAWAII

DEPARTMENT OF TRANSPORTATION


HIGHWAYS DIVISION

HONOLULU, HAWAII

"AS-BUILT"
PLANS FOR

KALAE HIGHWAY RESURFACING
KALAMA STREET TO KALAUPAPA LOOKOUT PARKING
PROJECT NO. 470A - 01-92M


DISTRICT OF MOLOKAI

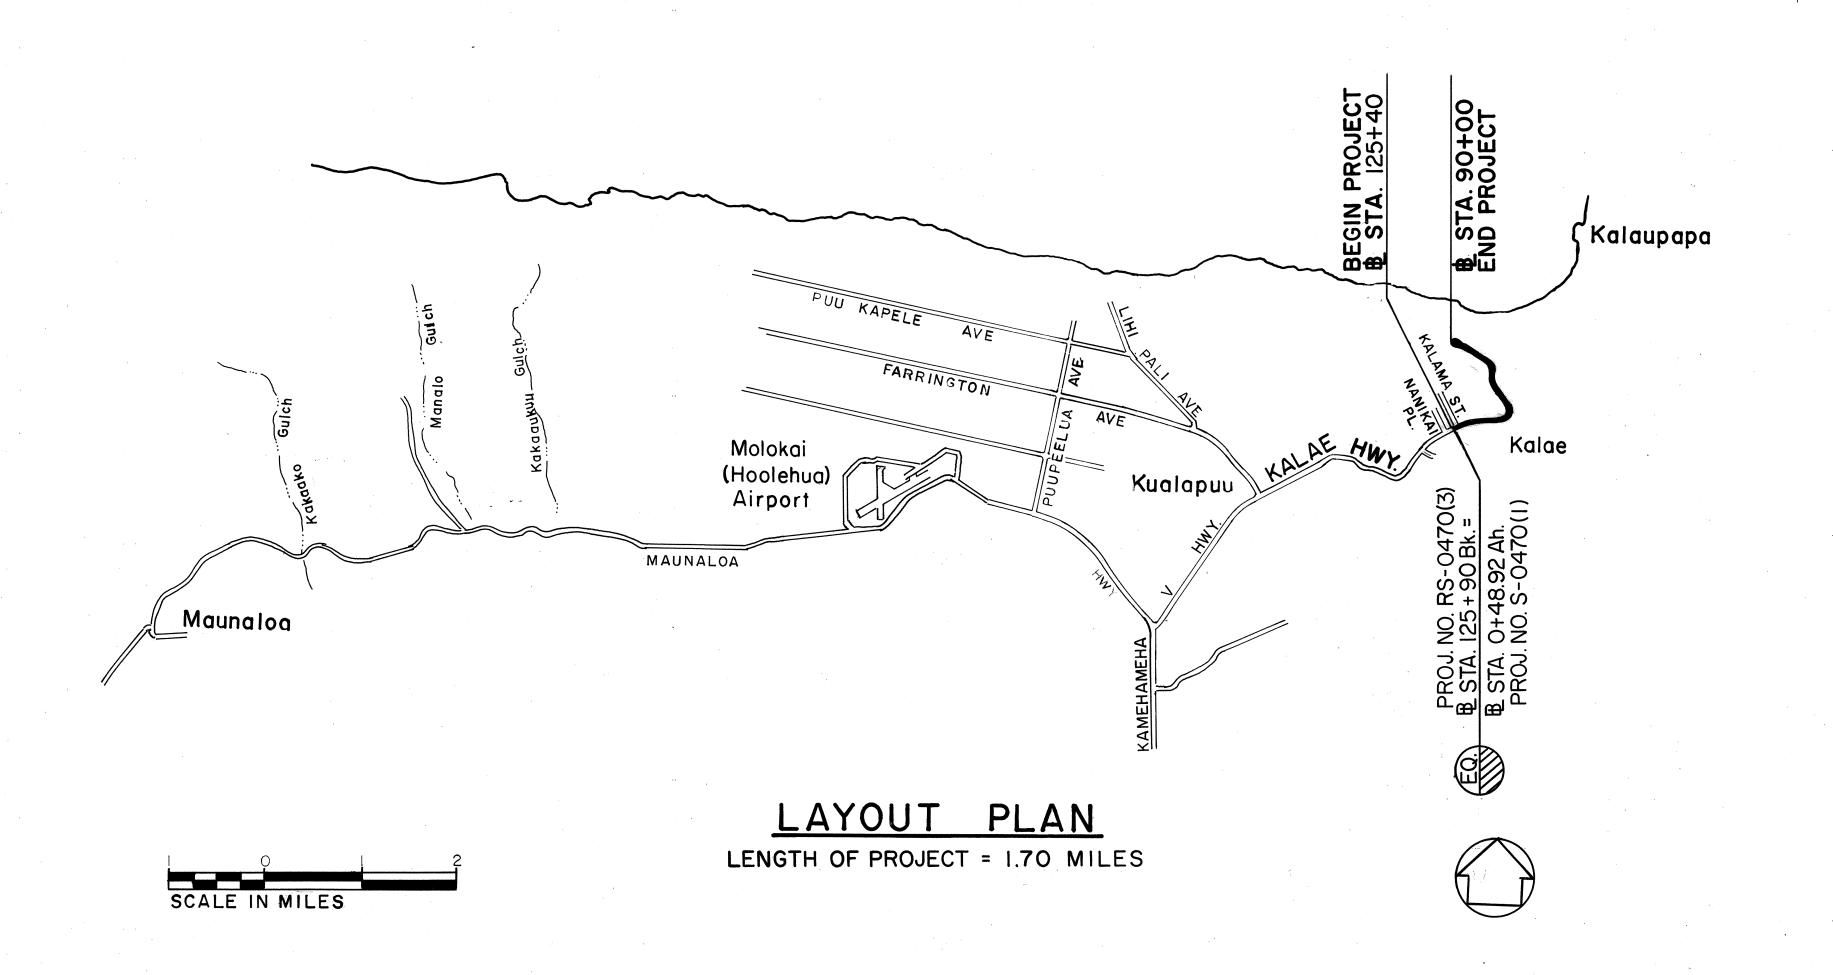


FED. ROAD DIST. NO. STATE PROJ. NO. FISCAL YEAR NO. SHEET SHEETS

HAWAII HAW. 470A-01-92M 1992 I 16



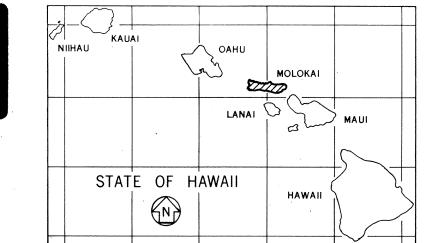

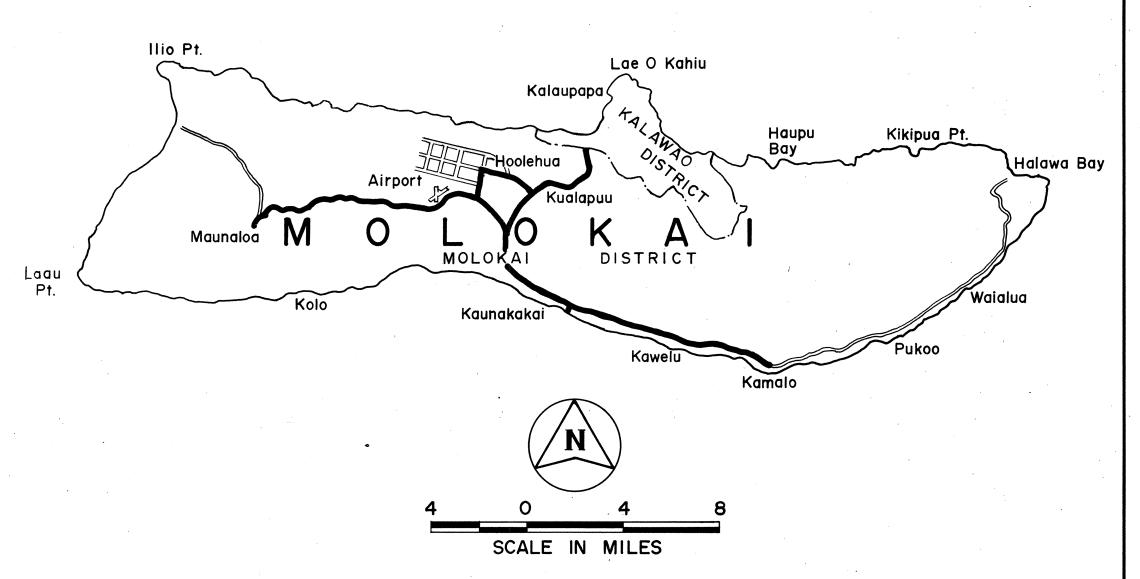

FEDERAL AID PROJECTS PREVIOUSLY CONSTRUCTED OR UNDER CONSTRUCTION

MILE POST 4.13 TO MILE POST 5.83

CHANGES MADE DURING CONSTRUCTION HAVE BEEN INCORPORATED ON THESE PLANS EXCEPT CHANGES IN THE ORIGINAL THEORETICAL QUANTITIES, FOR ACTUAL QUANTITIES, REFER TO PROJECT LEDGER AND/OR COMPUTATION BOOK.

RESIDENT ENGINEER

10-18-96 DATE

