INDEX TO DRAWINGS		
SHEET NO.	DESCRIPTION	
1	TITLE SHEET	
2	STANDARD PLANS SUMMARY	
3	GENERAL NOTES AND LEGEND	
4	TYPICAL SECTIONS AND DETAILS	
5	GUARDRAIL DETAIL	
6 – 8	DRAINAGE DETAILS	
9	PAVEMENT MARKINGS LEGEND, DETAILS AND NOTES	
10 – 14	ROADWAY AND SIGNING PLANS	
15	SIGN PANEL LAYOUT & NOTES	
16	MISCELLANEOUS SUMMARIES	

STATE OF HAWAII

DEPARTMENT OF TRANSPORTATION


DIVISION HIGHWAYS HONOLULU, HAWAII
"AS-BUILT"
PLANS FOR


KALAE HIGHWAY GUARDRAIL AND SHOULDER IMPROVEMENTS MAUNALOA HIGHWAY TO FARRINGTON AVENUE FEDERAL AID PROJECT NO. STP-0470(4)

DISTRICT OF MOLOKAI ISLAND OF MOLOKAI

PROJECT LIMITS

SCALE IN THOUSAND FEET

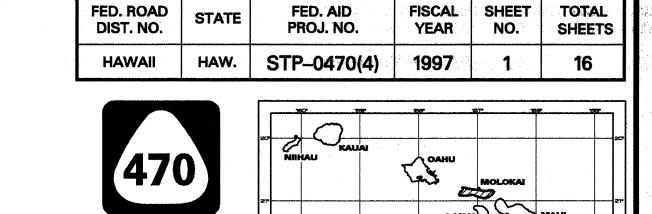

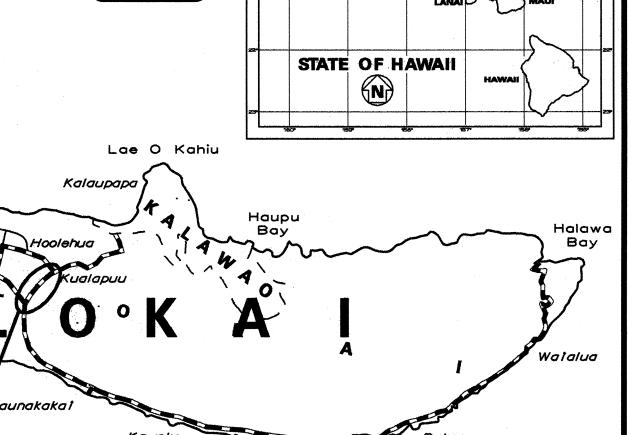

SCALE IN MILES

MILE POST 0.00 TO MILE POST 1.74

EDERAL AID PROJECTS PREVIOUSLY CONSTRUCTED

CHANGES MADE DURING CONSTRUCTION HAVE BEEN INCORPORATED ON THESE PLANS EXCEPT CHANGES IN THE ORIGINAL THEORETICAL QUANTITIES. FOR ACTUAL QUANTITIES, REFER TO PROJECT LEDGER AND/OR COMPUTATION BOOK.

OR UNDER CONSTRUCTION

RESIDENT ENGINEER

9/16/01

DESIGN DESIGNATION

PROJECT LOCATION

Fed. Aid Project No. STP-0470(4)

ADT	(1996)	2.540
	(2006)	-
		-
		*
Τ.		.5 %
٧.	4	0 M.P.H.

DEPARTMENT OF TRANSPORTATION STATE OF HAWAII

APPROVED:

9/10/96 DIR. OF TRANSPORTATION

School KUALAPUU LAYOUT PLAN

GROSS LENGTH OF PROJECT.....1.74 MILES

NET LENGTH OF PROJECT.....1.74 MILES

DATE