
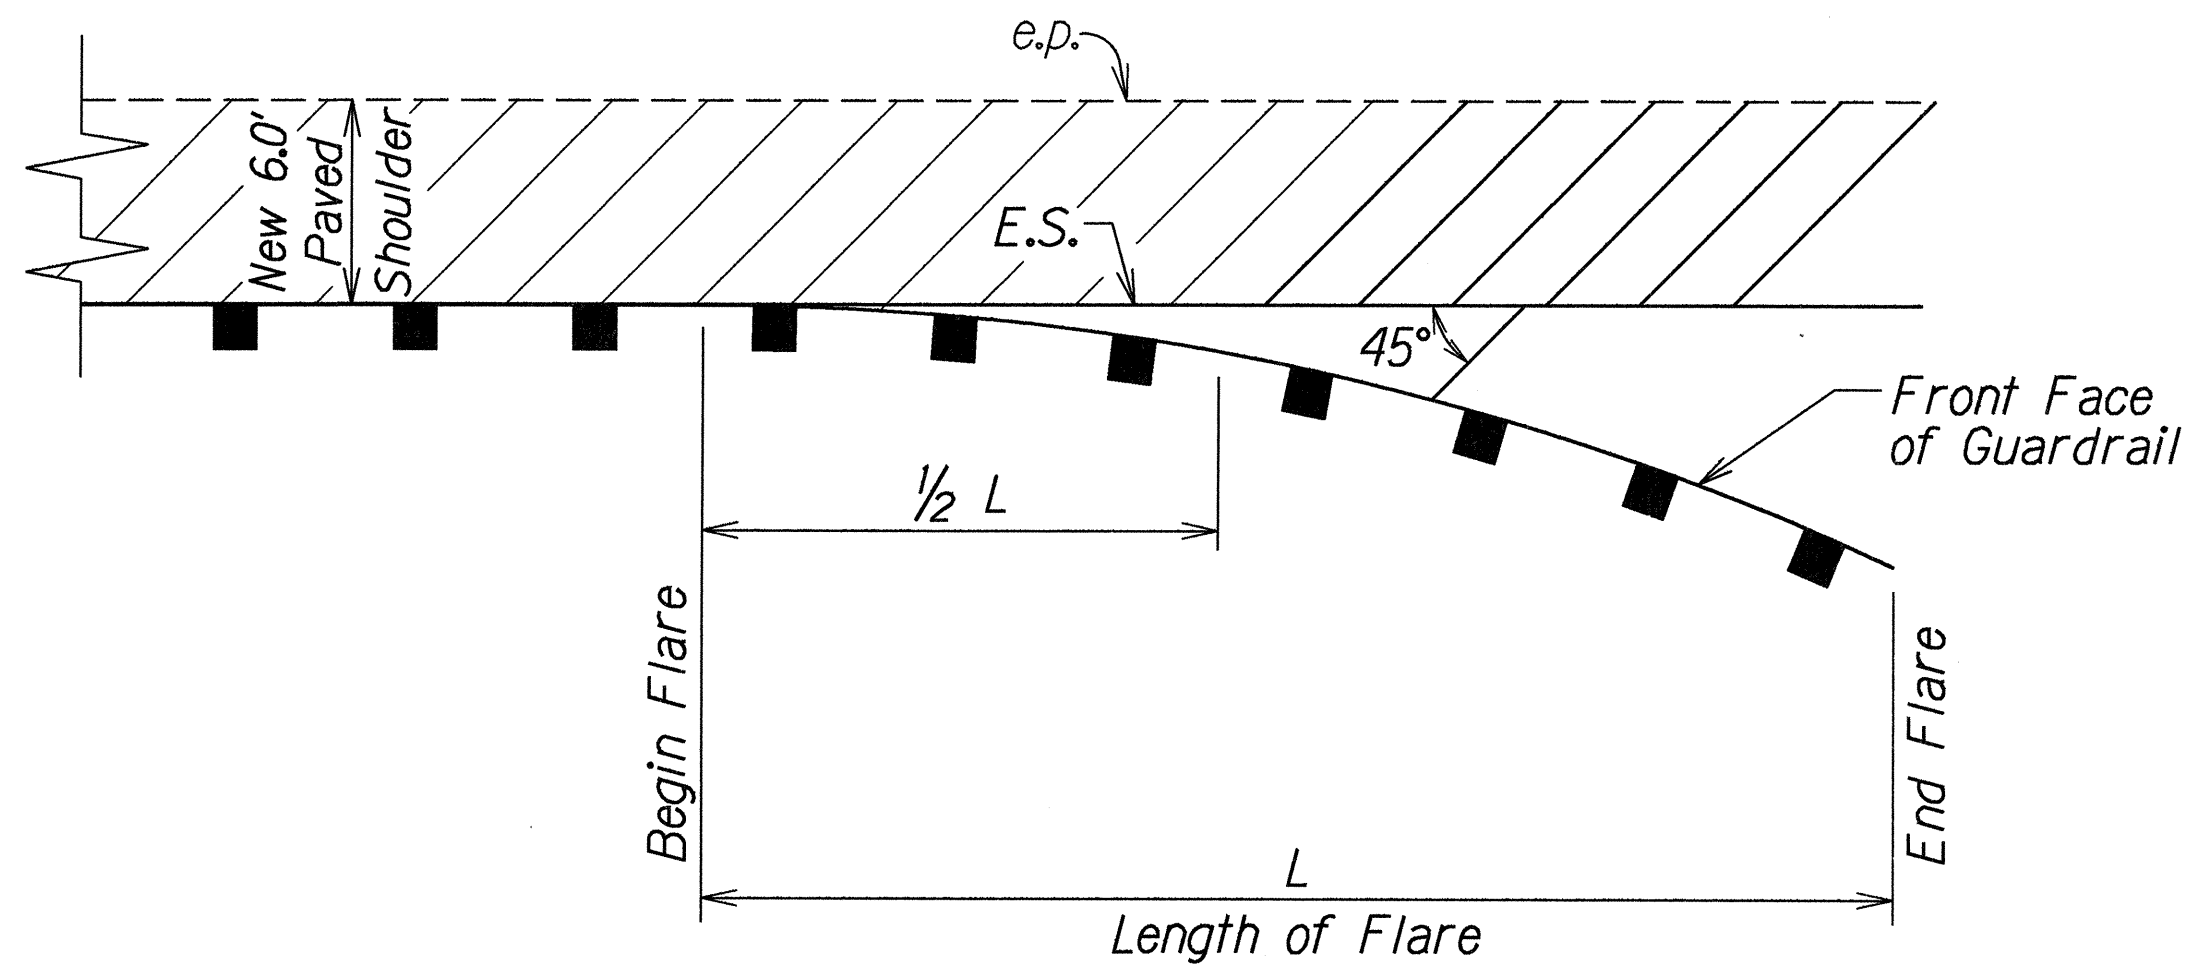
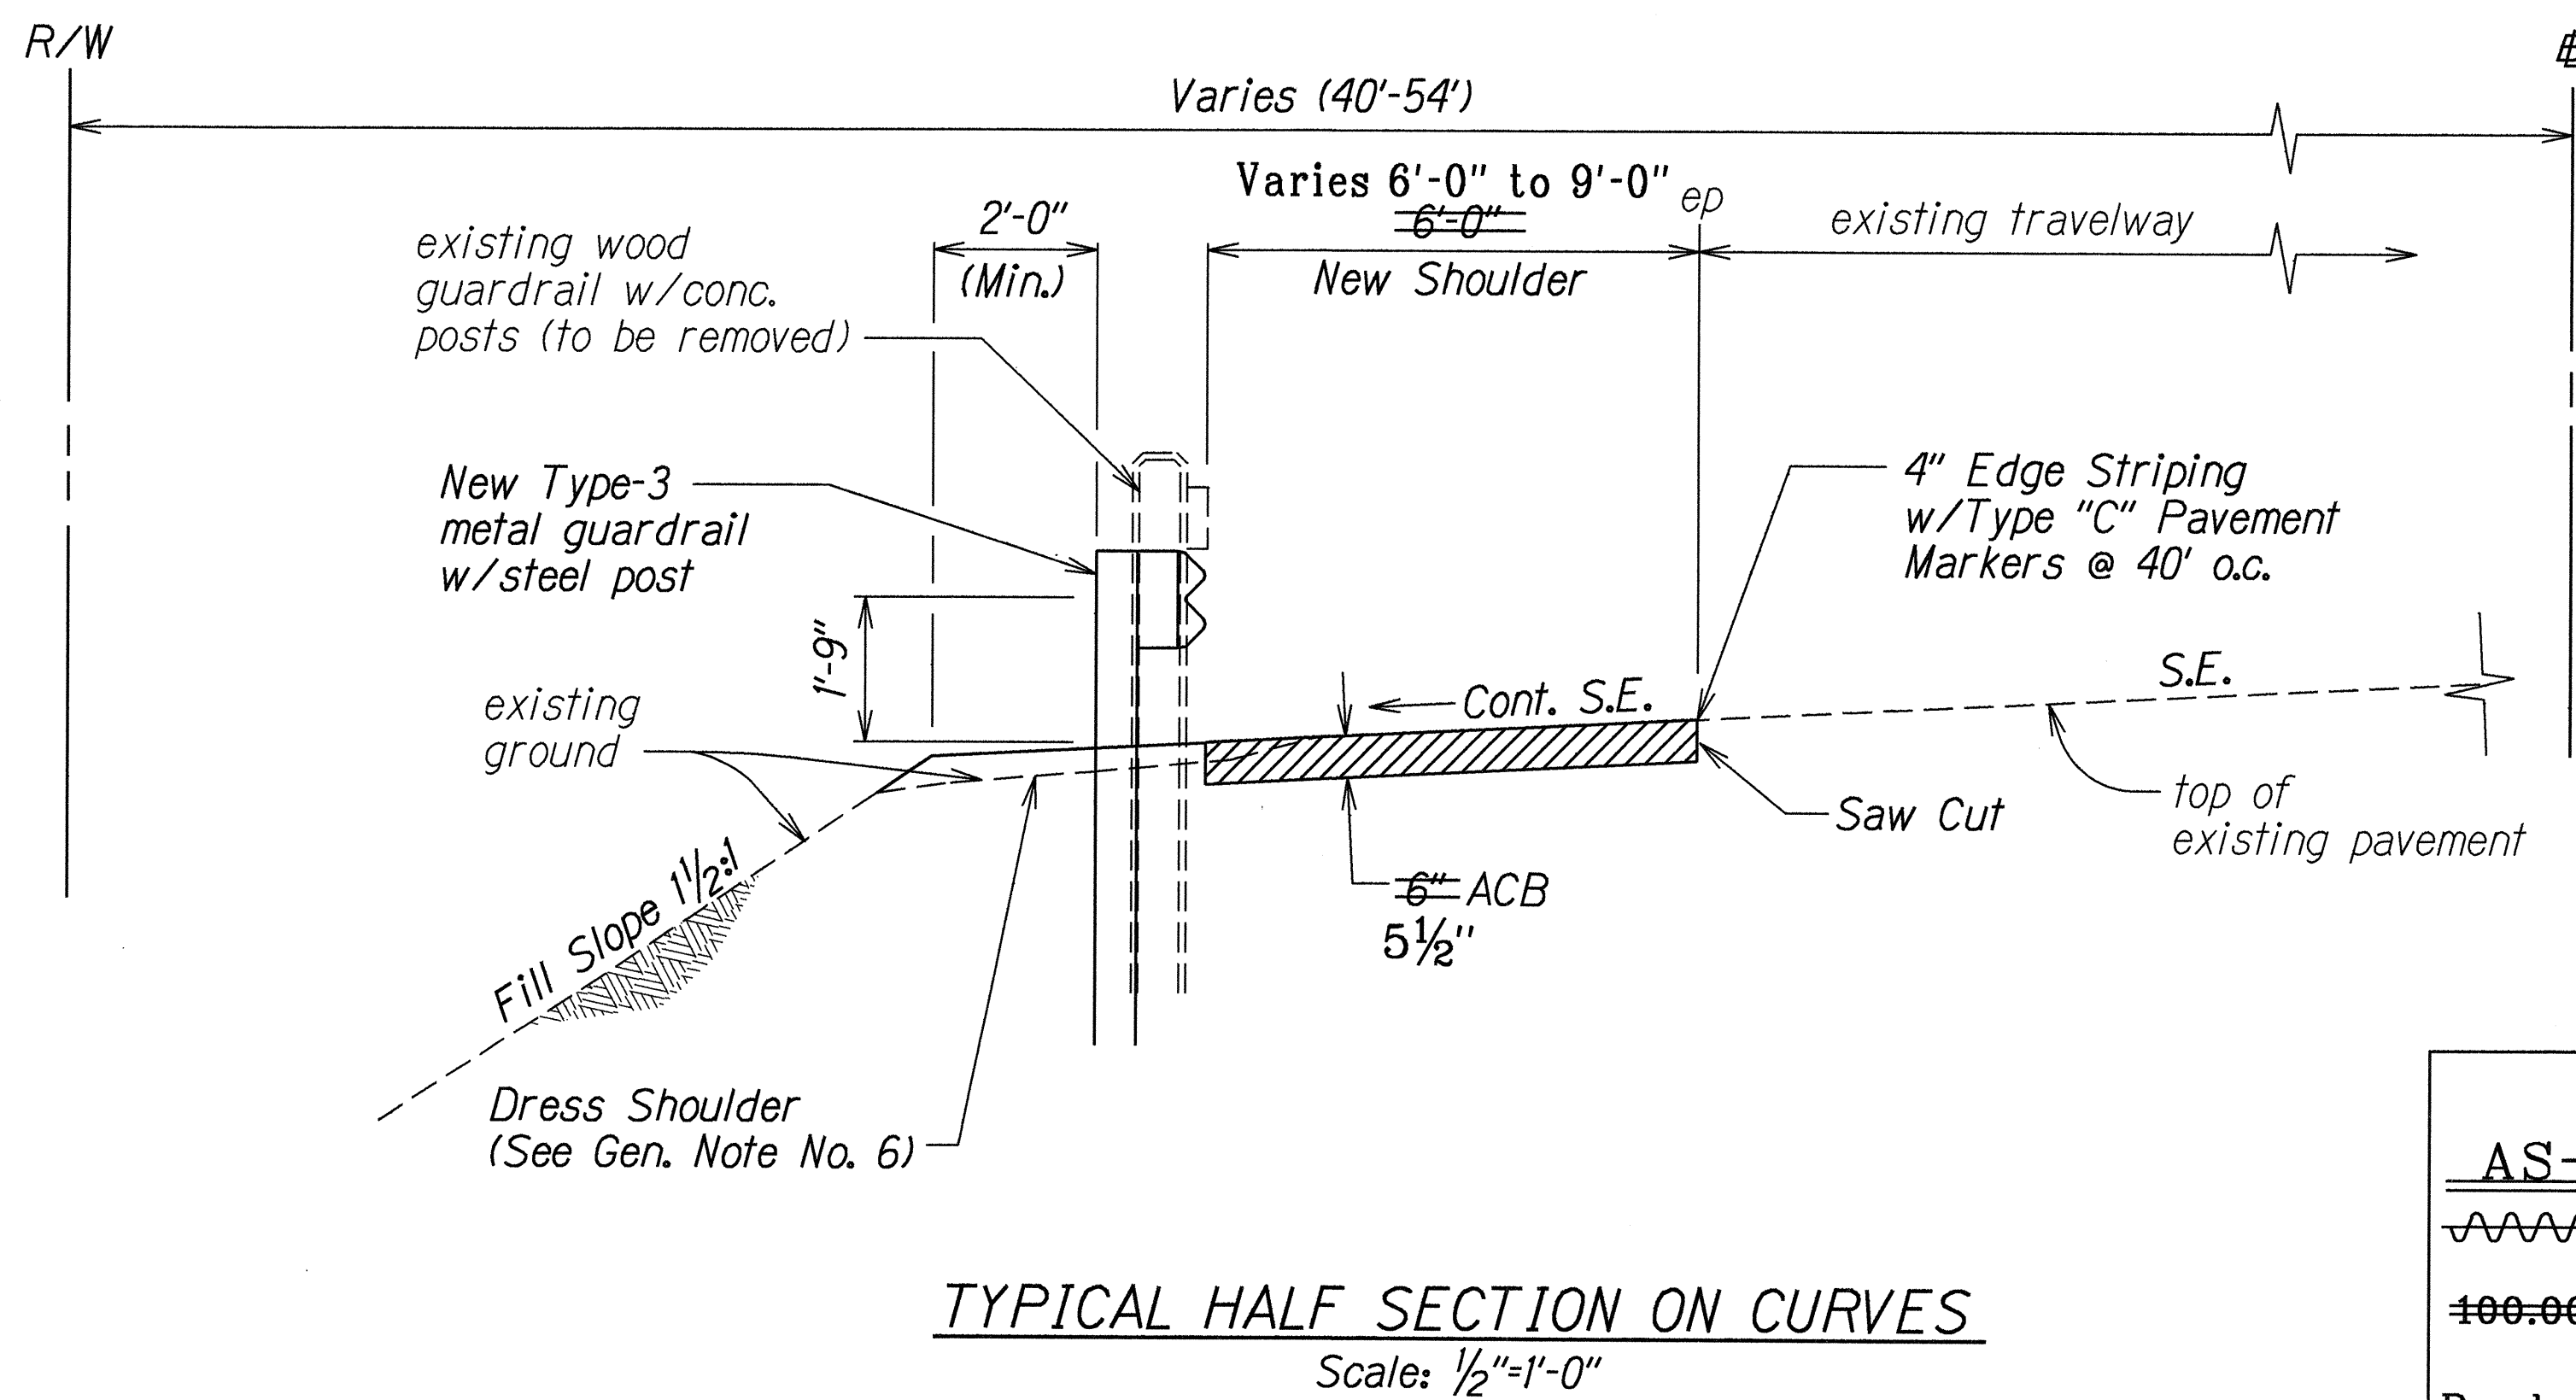


FED. ROAD DIST. NO.	STATE	FED. AID PROJ. NO.	FISCAL YEAR	SHEET NO.	TOTAL SHEETS
HAWAII	HAW.	STP-0470(4)	1997	4	16

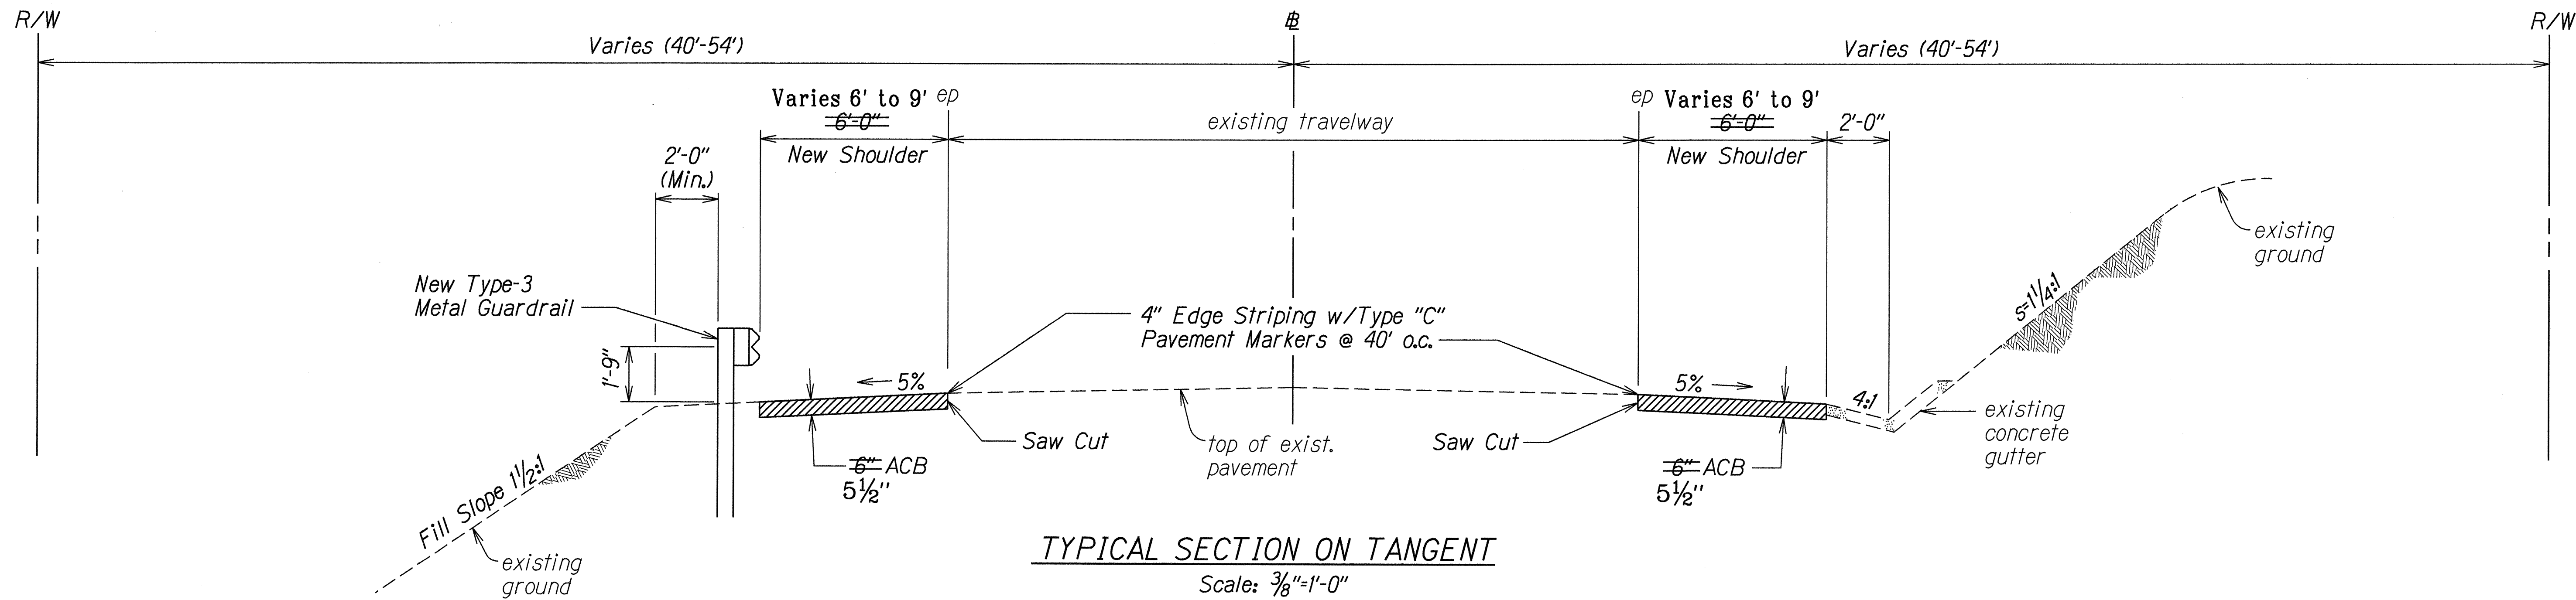

LEGEND FOR AS-BUILT POSTINGS	
	Squiggly line for as-built deletion
	Double line for as-built deletion
Roadway	Text for as-built posting

STATE OF HAWAII

DEPARTMENT OF TRANSPORTATION

HIGHWAYS DIVISION

TYPICAL SECTIONS & DETAILS

KALAE HIGHWAY

GUARDRAIL & SHOULDER IMPROVEMENTS

Maunaloa Highway to Farrington Avenue

Fed. Aid Project No. STP-0470(4)

Scale: As Shown

Date: Sept., 1995

SHEET No. 1 OF 1 SHEETS

DESIGNED BY	DATE
DRAWN BY	11/2/95
CHECKED BY	
NOTED BY	
QUANTITIES BY	
CHECKED BY	