

STATE OF HAWAII

## DEPARTMENT OF TRANSPORTATION


HIGHWAYS DIVISION HONOLULU, HAWAII

PLANS FOR


## KALAE HIGHWAY RESURFACING


MAUNALOA HIGHWAY TO KALAUPAPA LOOKOUT PARKING LOT PROJECT NO. 470A-01-00M

DISTRICT OF MOLOKAI
ISLAND OF MOLOKAI

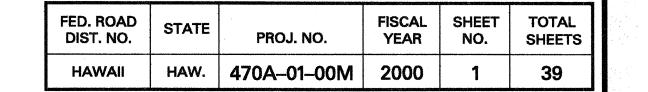



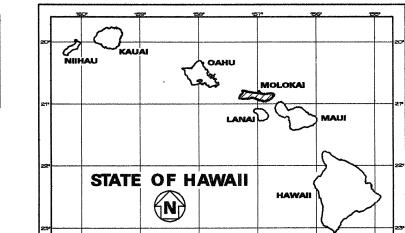


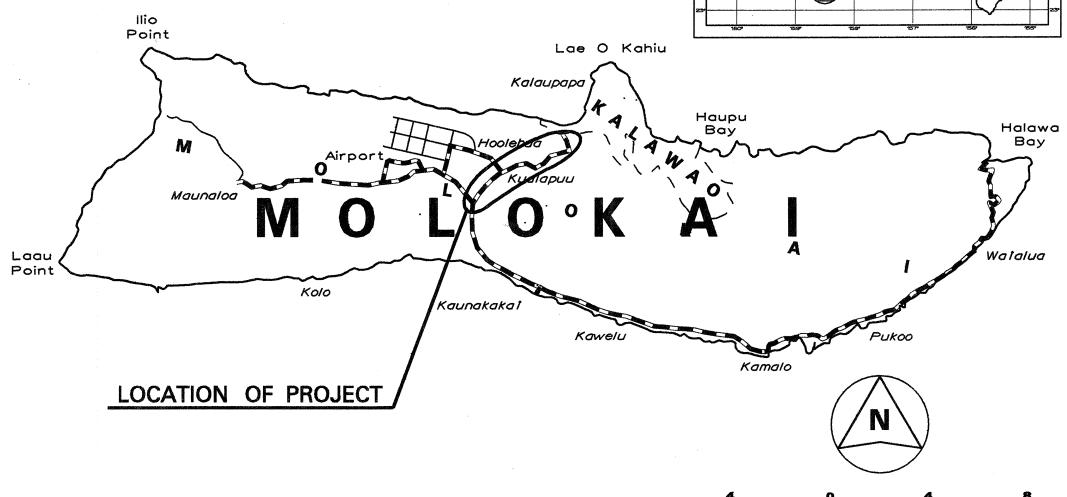

FEDERAL AID PROJECTS PREVIOUSLY CONSTRUCTED OR UNDER CONSTRUCTION


SCALE IN MILES

MILE POST 0.00 TO MILE POST 5.79

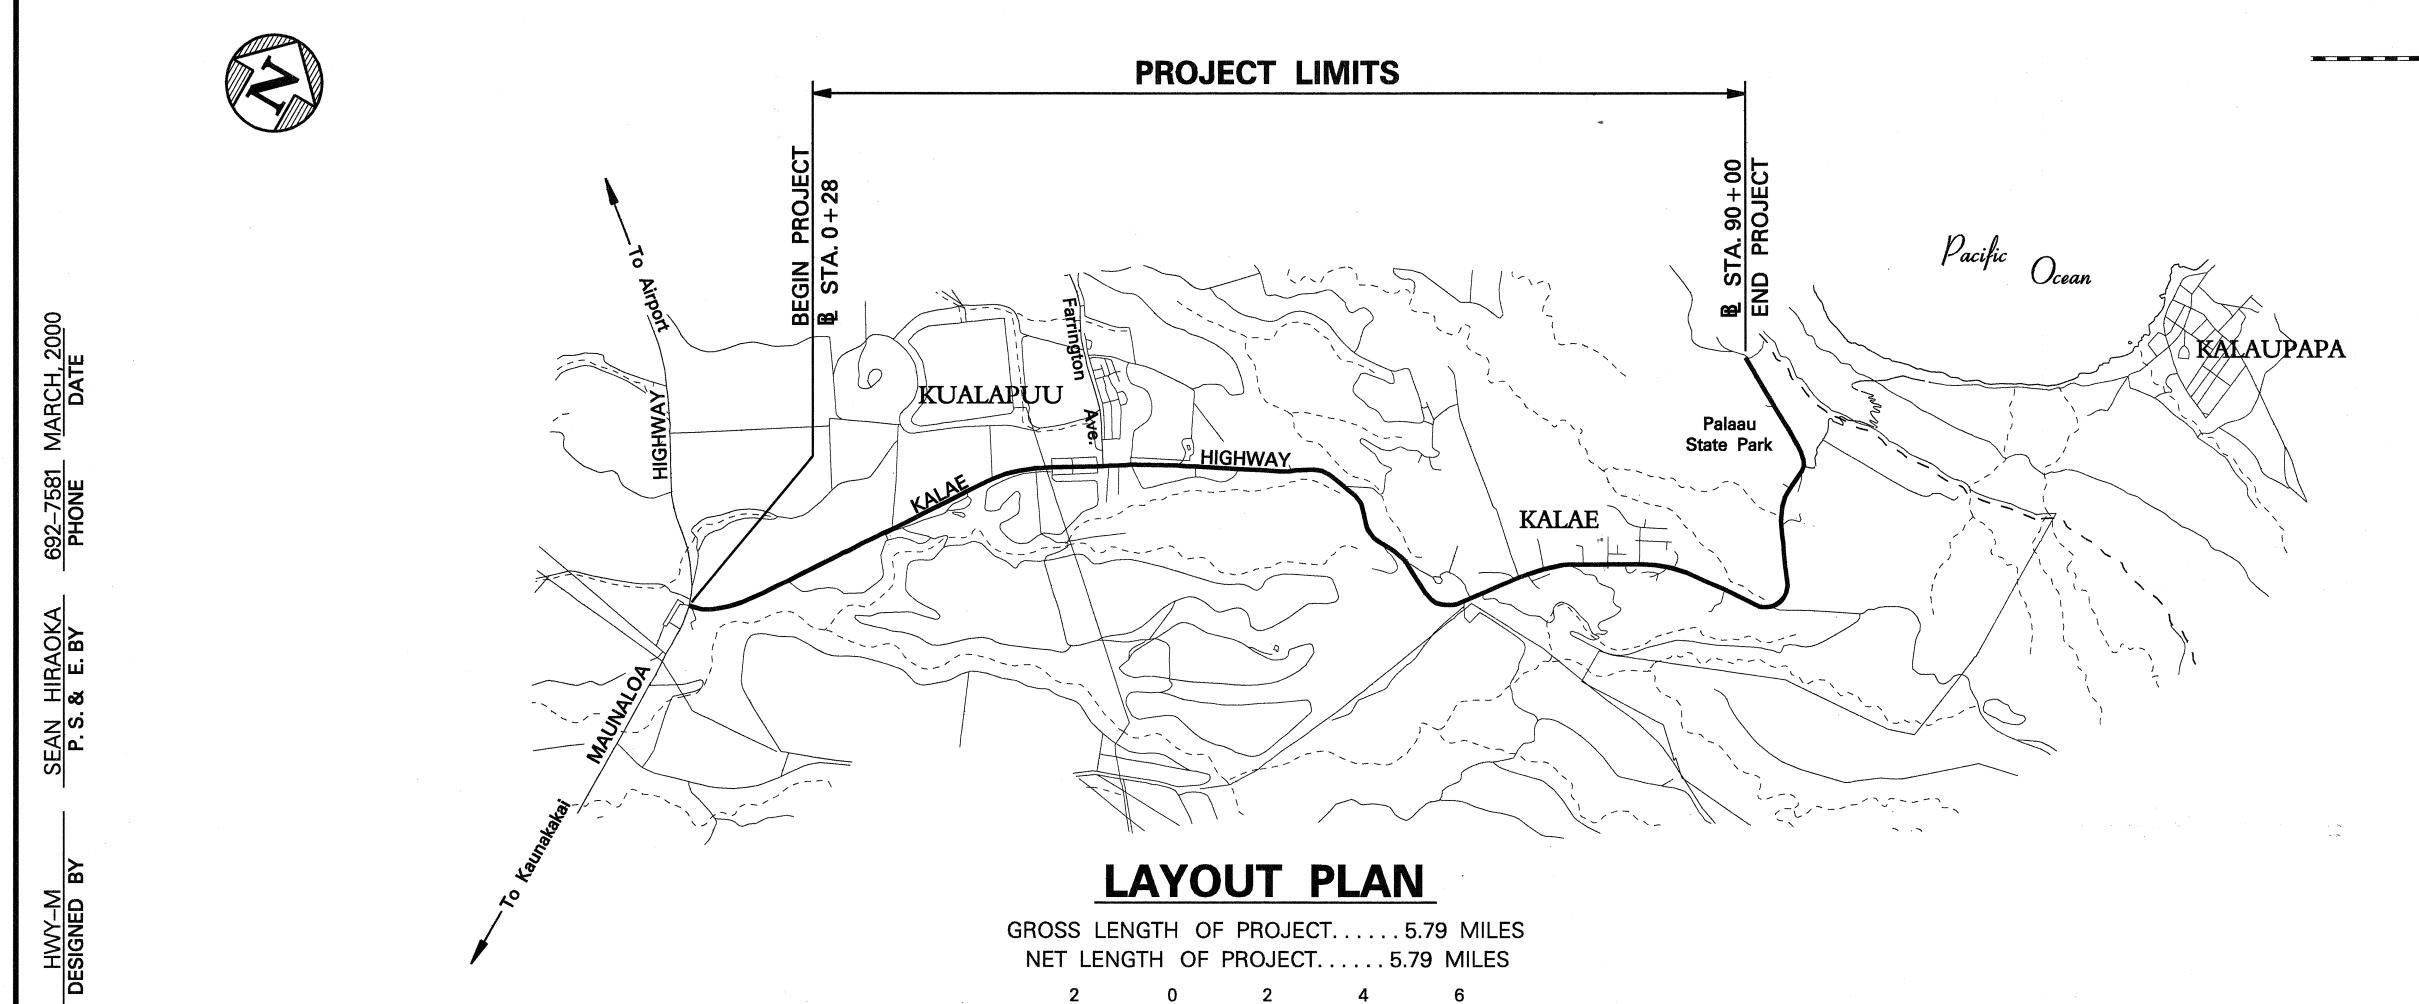

SCALE IN THOUSAND FEET

CHANGES MADE DURING CONSTRUCTION HAVE BEEN INCORPORATED ON THESE PLANS EXCEPT CHANGES IN THE ORIGINAL THEORETICAL QUANTITIES. FOR ACTUAL QUANTITIES, REFER TO PROJECT LEDGER AND/OR COMPUTATION BOOK.

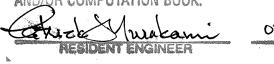

DEPARTMENT OF TRANSPORTATION STATE OF HAWAII

APPROVED:

DIR. OF TRANSPORTATION