	INDEX TO DRAWINGS
SHEET NO.	DESCRIPTION
. 1	TITLE SHEET
2	STANDARD PLANS SUMMARY
3	GENERAL NOTES AND LEGEND
4 – 5	WATER POLLUTION & EROSION CONTROL NOTES
6	TYPICAL SECTIONS AND DETAILS
7 – 21	ROADWAY PLANS
22	PAVEMENT MARKINGS LEGEND, DETAILS AND NOTES
23	WORK ZONE SIGNING PLAN, NOTES & DETAILS
24 – 38	SIGNING AND PAVEMENT MARKING PLANS

STATE OF HAWAII

DEPARTMENT OF TRANSPORTATION

HIGHWAYS DIVISION


HONOLULU, HAWAII "AS-BUILT"

PLANS FOR

KALAE HIGHWAY PAVEMENT PREVENTIVE MAINTENANCE

MAUNALOA HIGHWAY TO KALAUPAPA LOOKOUT FEDERAL-AID PROJECT NO. ARR-0470(6)

> DISTRICT OF MOLOKAI ISLAND OF MOLOKAI

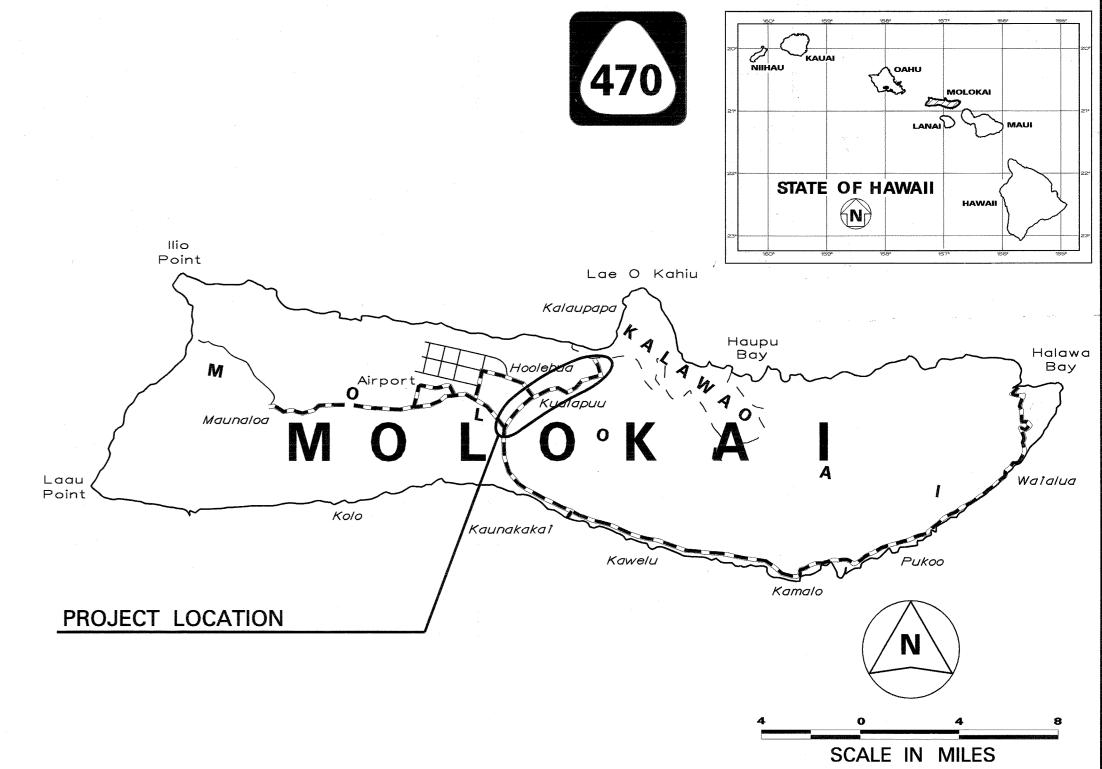

FED. ROAD DIST. NO.

FED. AID PROJ. NO.

FEDERAL AID PROJECTS PREVIOUSLY CONSTRUCTED OR UNDER CONSTRUCTION

MILE POST <u>0.00</u> TO MILE POST <u>5.79</u>

CHANGES MADE DURING CONSTRUCTION HAVE BEEN INCORPORATED ON THESE PLANS EXCEPT CHANGES ACTUAL QUANTITIES, REFER TO PROJECT LEDGER

DESIGN DESIGNATION

MAUNALOA HWY. FARRINGTON AVE. KIPU ROAD **TRAFFIC** TO DATA KIPU ROAD FARRINGTON AVE. KALAUPAPA LOOKOUT 1,080 420 ADT (2009) 2,440 1,230 2,720 480 ADT (2019) 120 60 DHV DESIGN K 12.0 13.0 DESIGN D 60/40 70/30 65/35 DESIGN T

T24

4.5 6.5 4.0 3.0 2.0

> DEPARTMENT OF TRANSPORTATION STATE OF HAWAII

APPROVED:

4-17-09 Steen m. Jami DATE DIR. OF TRANSPORTATION

PROJECT LIMITS Pacific Ocean KALAUPAPA KUALAPUU Palaau State Park HIGHWAY KALAE

SCALE IN THOUSAND FEET

LAYOUT PLAN

GROSS LENGTH OF PROJECT.....5.79 MILES NET LENGTH OF PROJECT.....5.79 MILES