


ORIGINAL SURVEY	SURVEYED PLOTTED	BY	DATE
NOTE BOOK	TEMPLATE		
NO.	AREAS CHECKED		

FED. ROAD DIST. NO.	STATE	FED. AID PROJ. NO.	FISCAL YEAR	SHEET NO.	TOTAL SHEETS
HAWAII	HAW	SI (2)	1946	10A	13

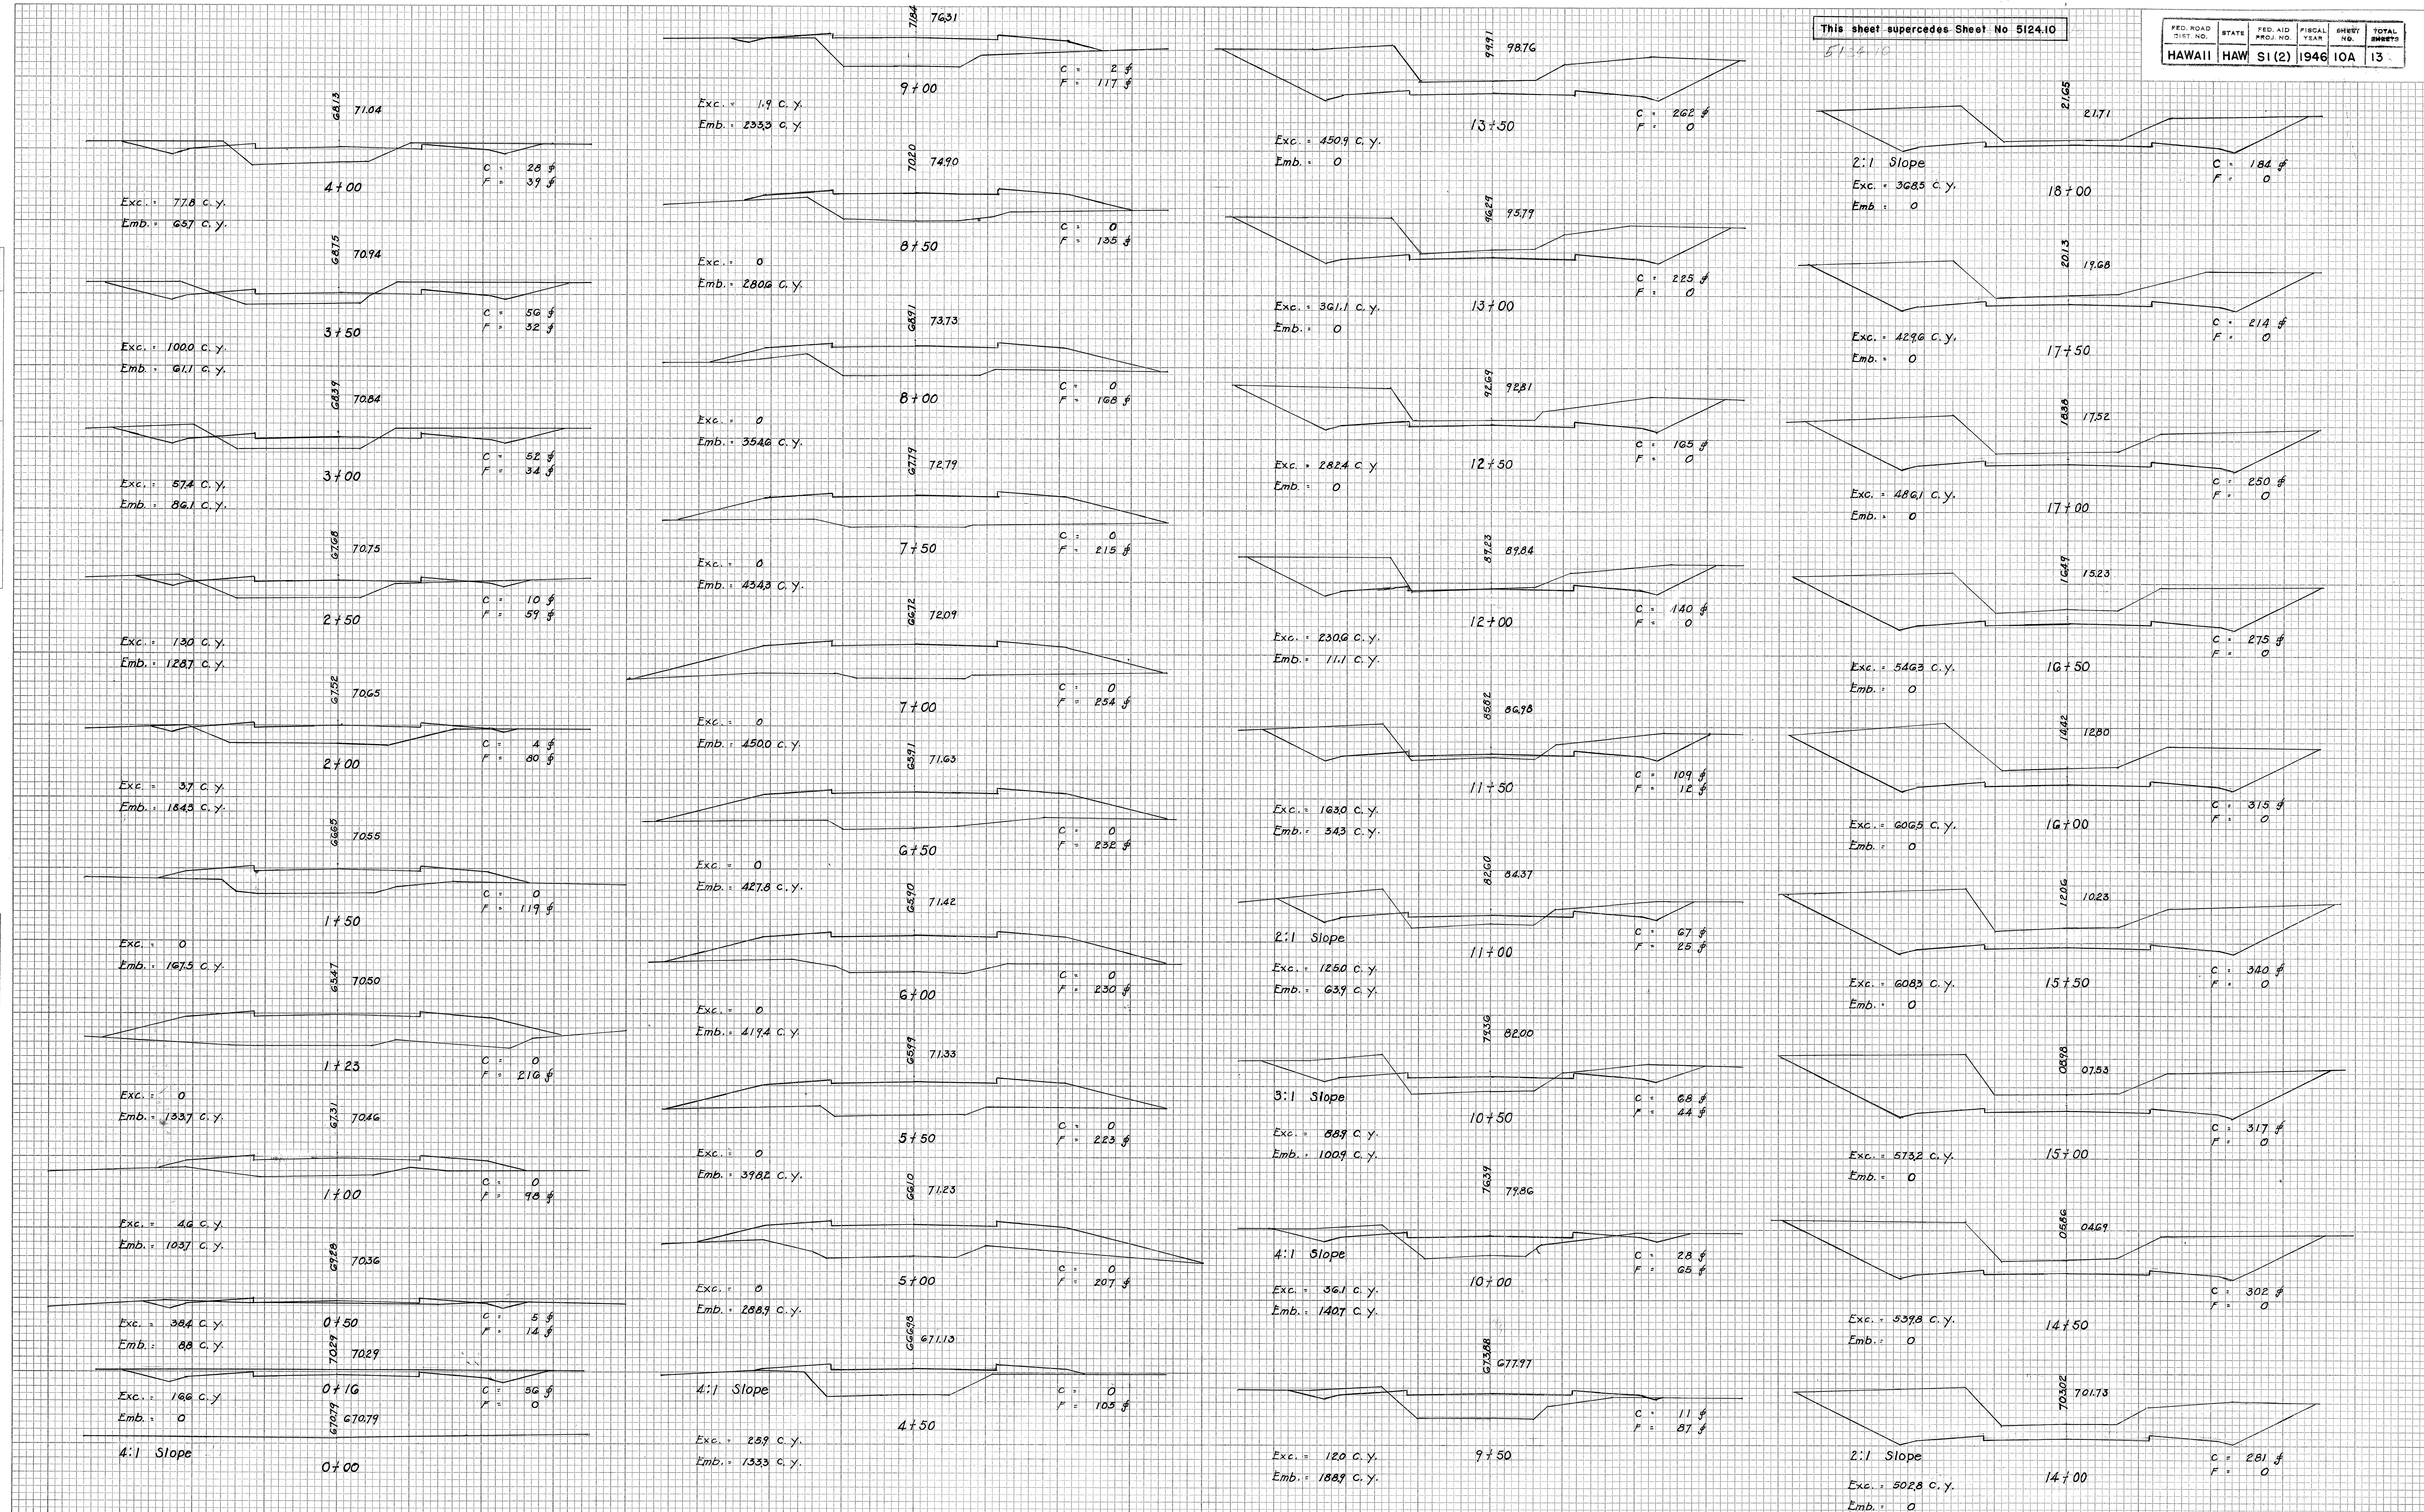

5 1 2 4 . 1 0 A

5124, 10.A

DATE: Jan 1947
BY: H. Hayashi
H. Kawada
NO. 1

FINAL SURVEY
SURVEYED
NOTE BOOK
NO. 1

AREAS CHECKED

Sections taken at time of stakeout
Feb. 1947





DATE: Feb 1947
BY: H. Hayashi
H. Kawada
NO. 1

ORIGINAL SURVEY
SURVEYED
NOTE BOOK
NO. 1


AREAS CHECKED

This sheet supercedes Sheet No 5124.11


FED. ROAD DIST. NO.	STATE	FED. AID PROJ. NO.	FISCAL YEAR	SHEET NO.	TOTAL SHEETS
HAWAII	HAW	S 1 (2)	1946	11A	13

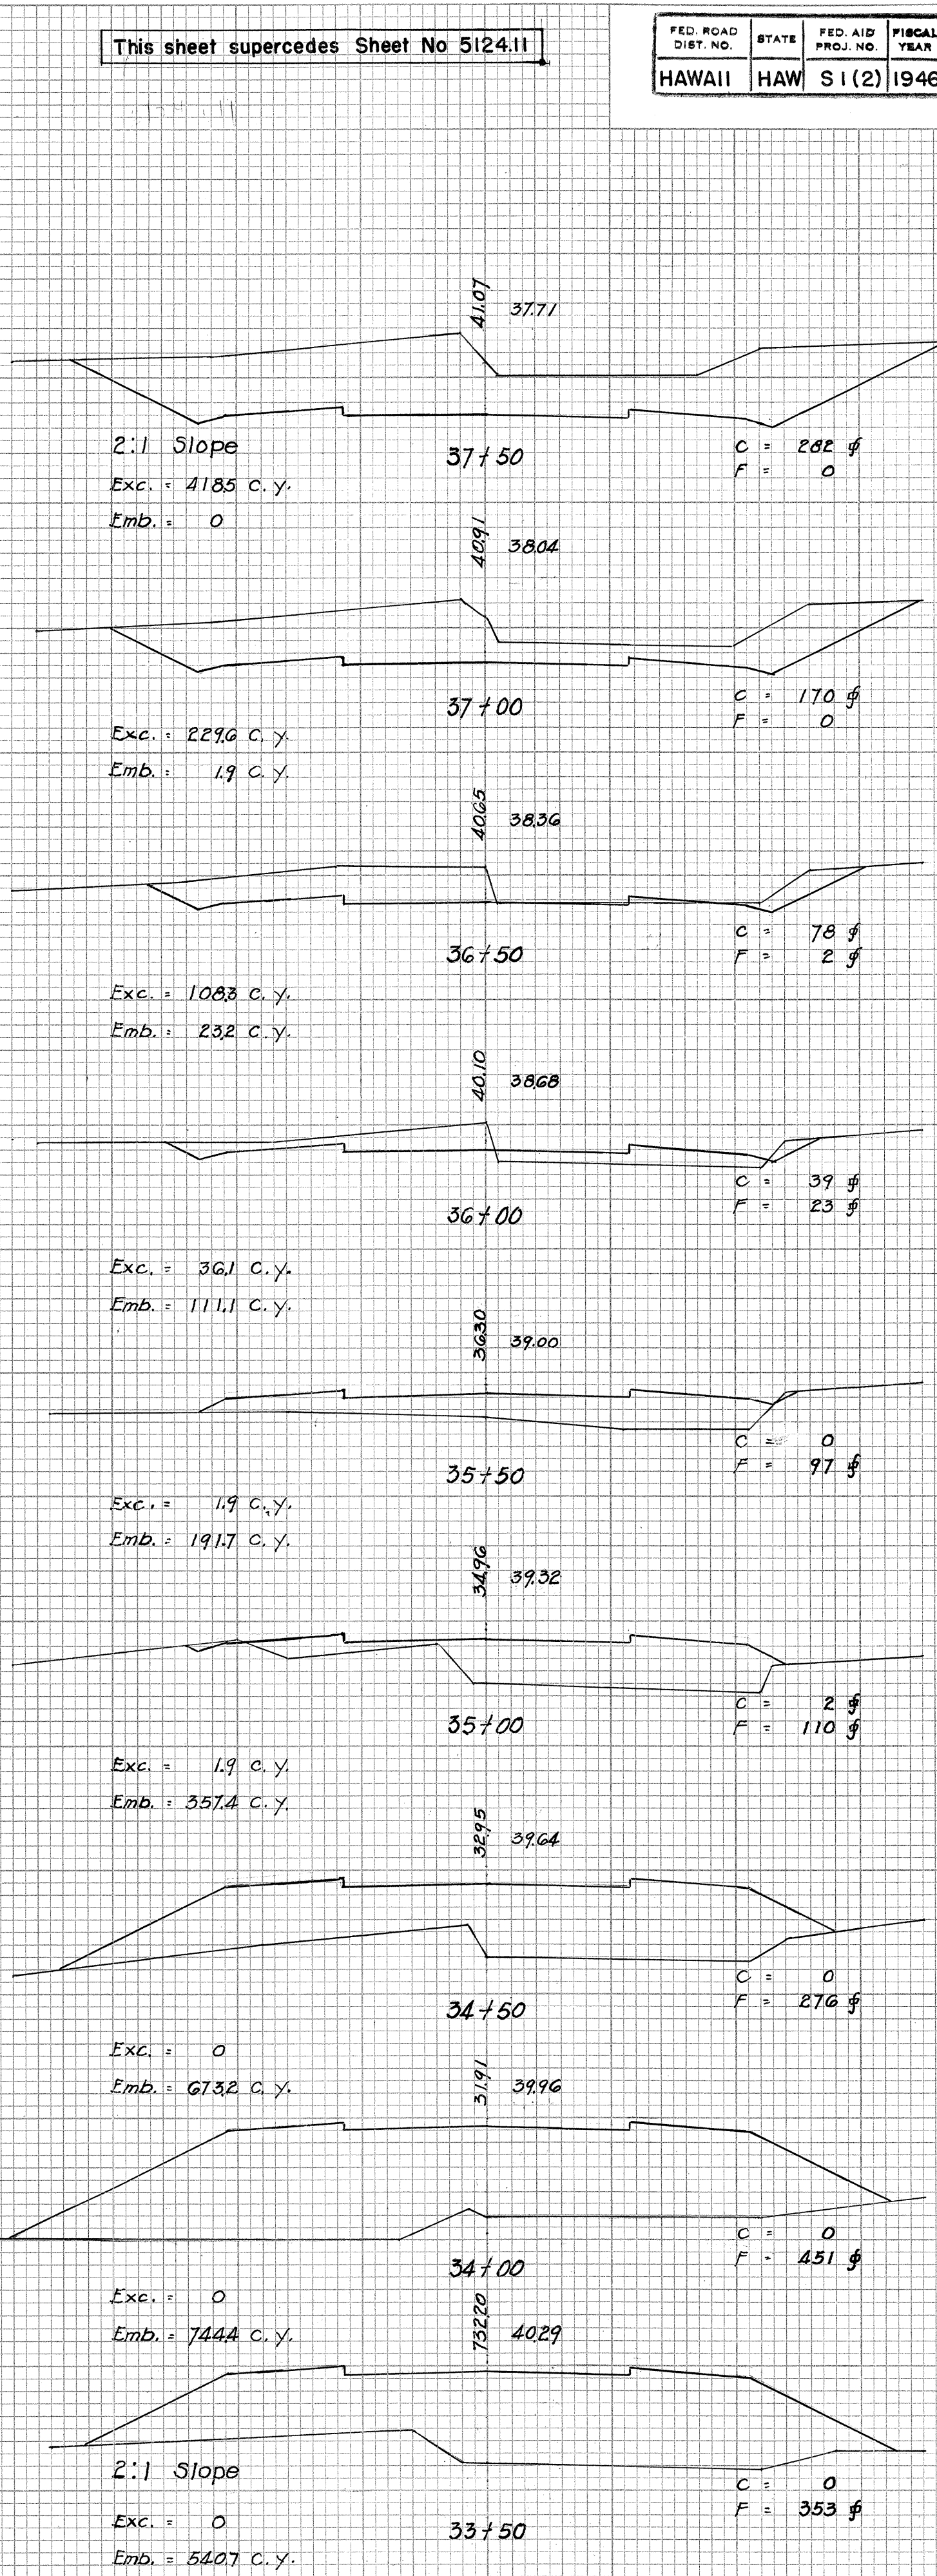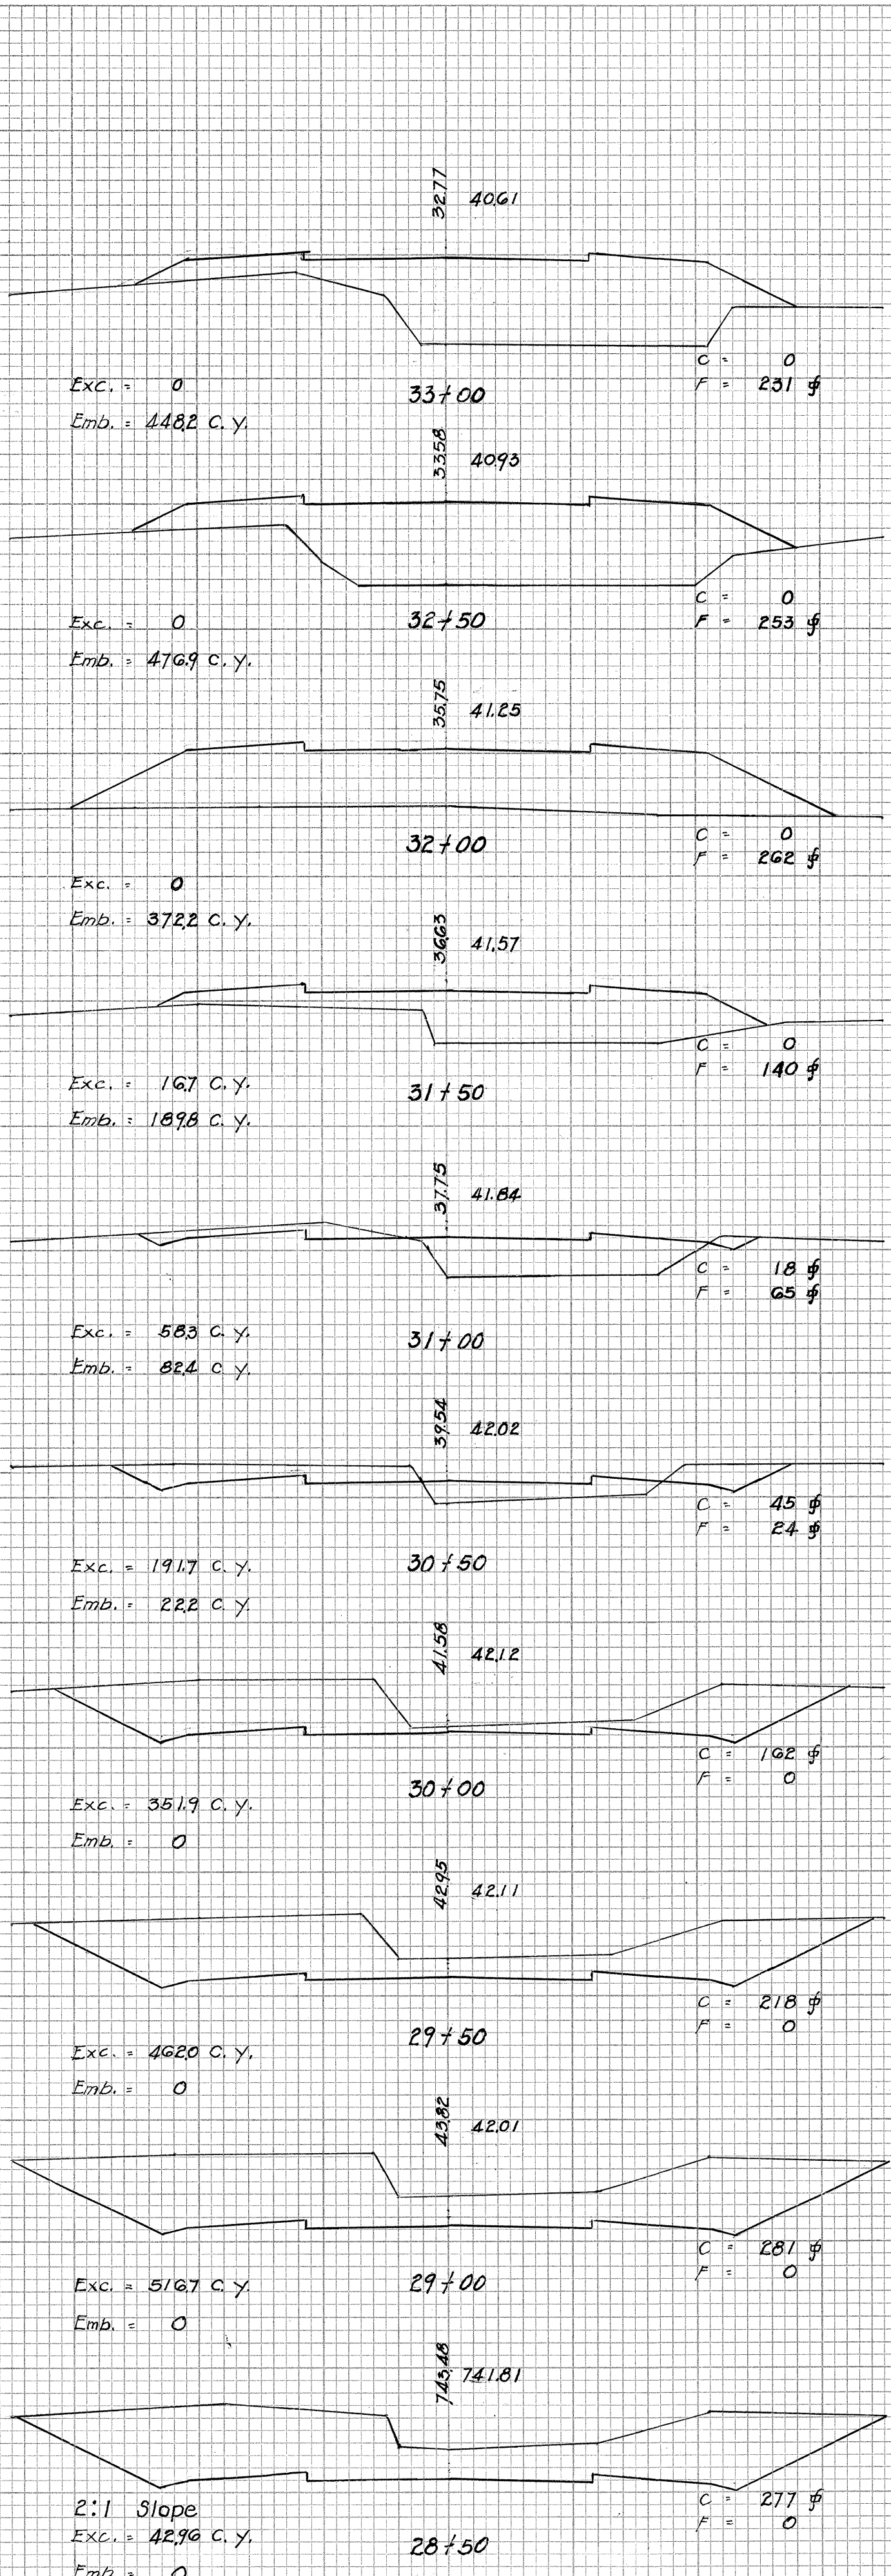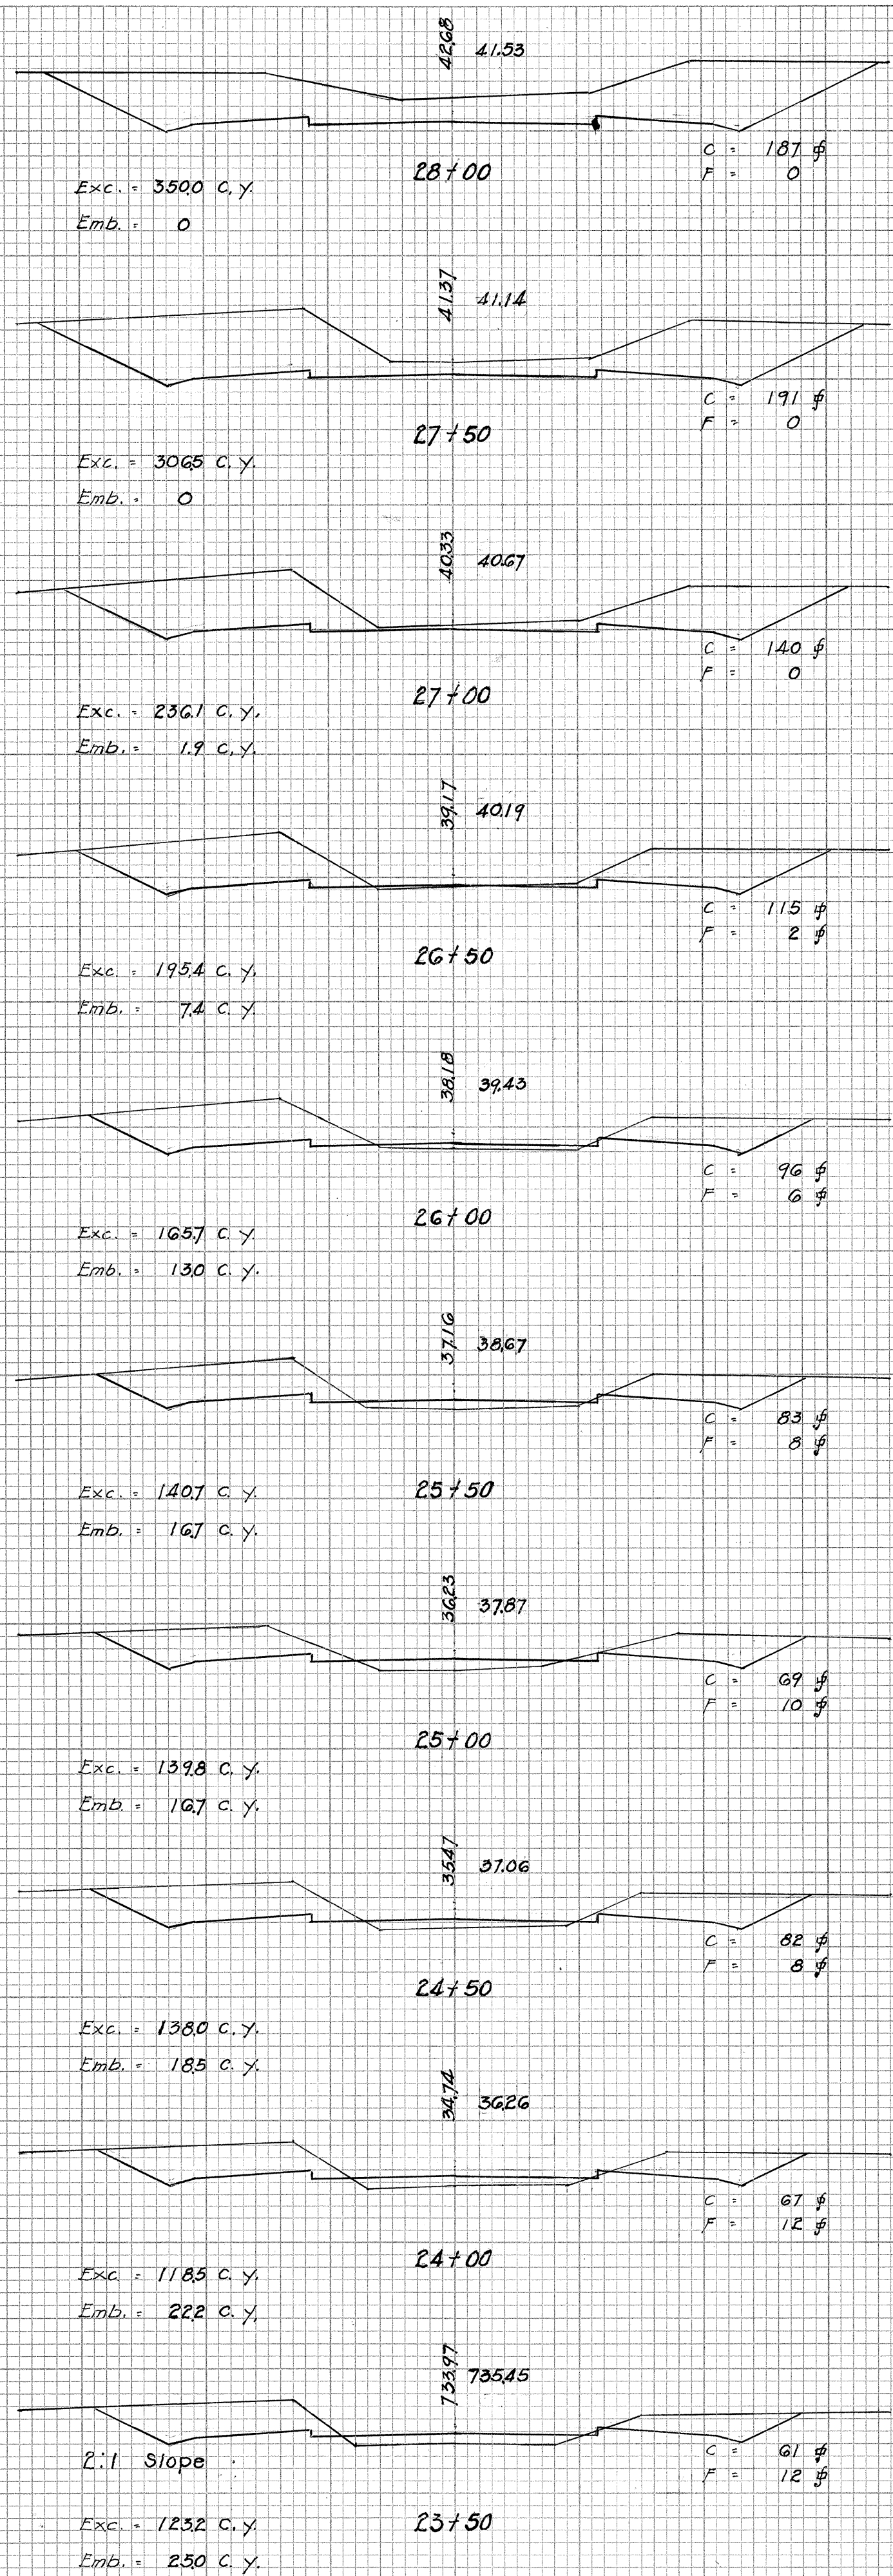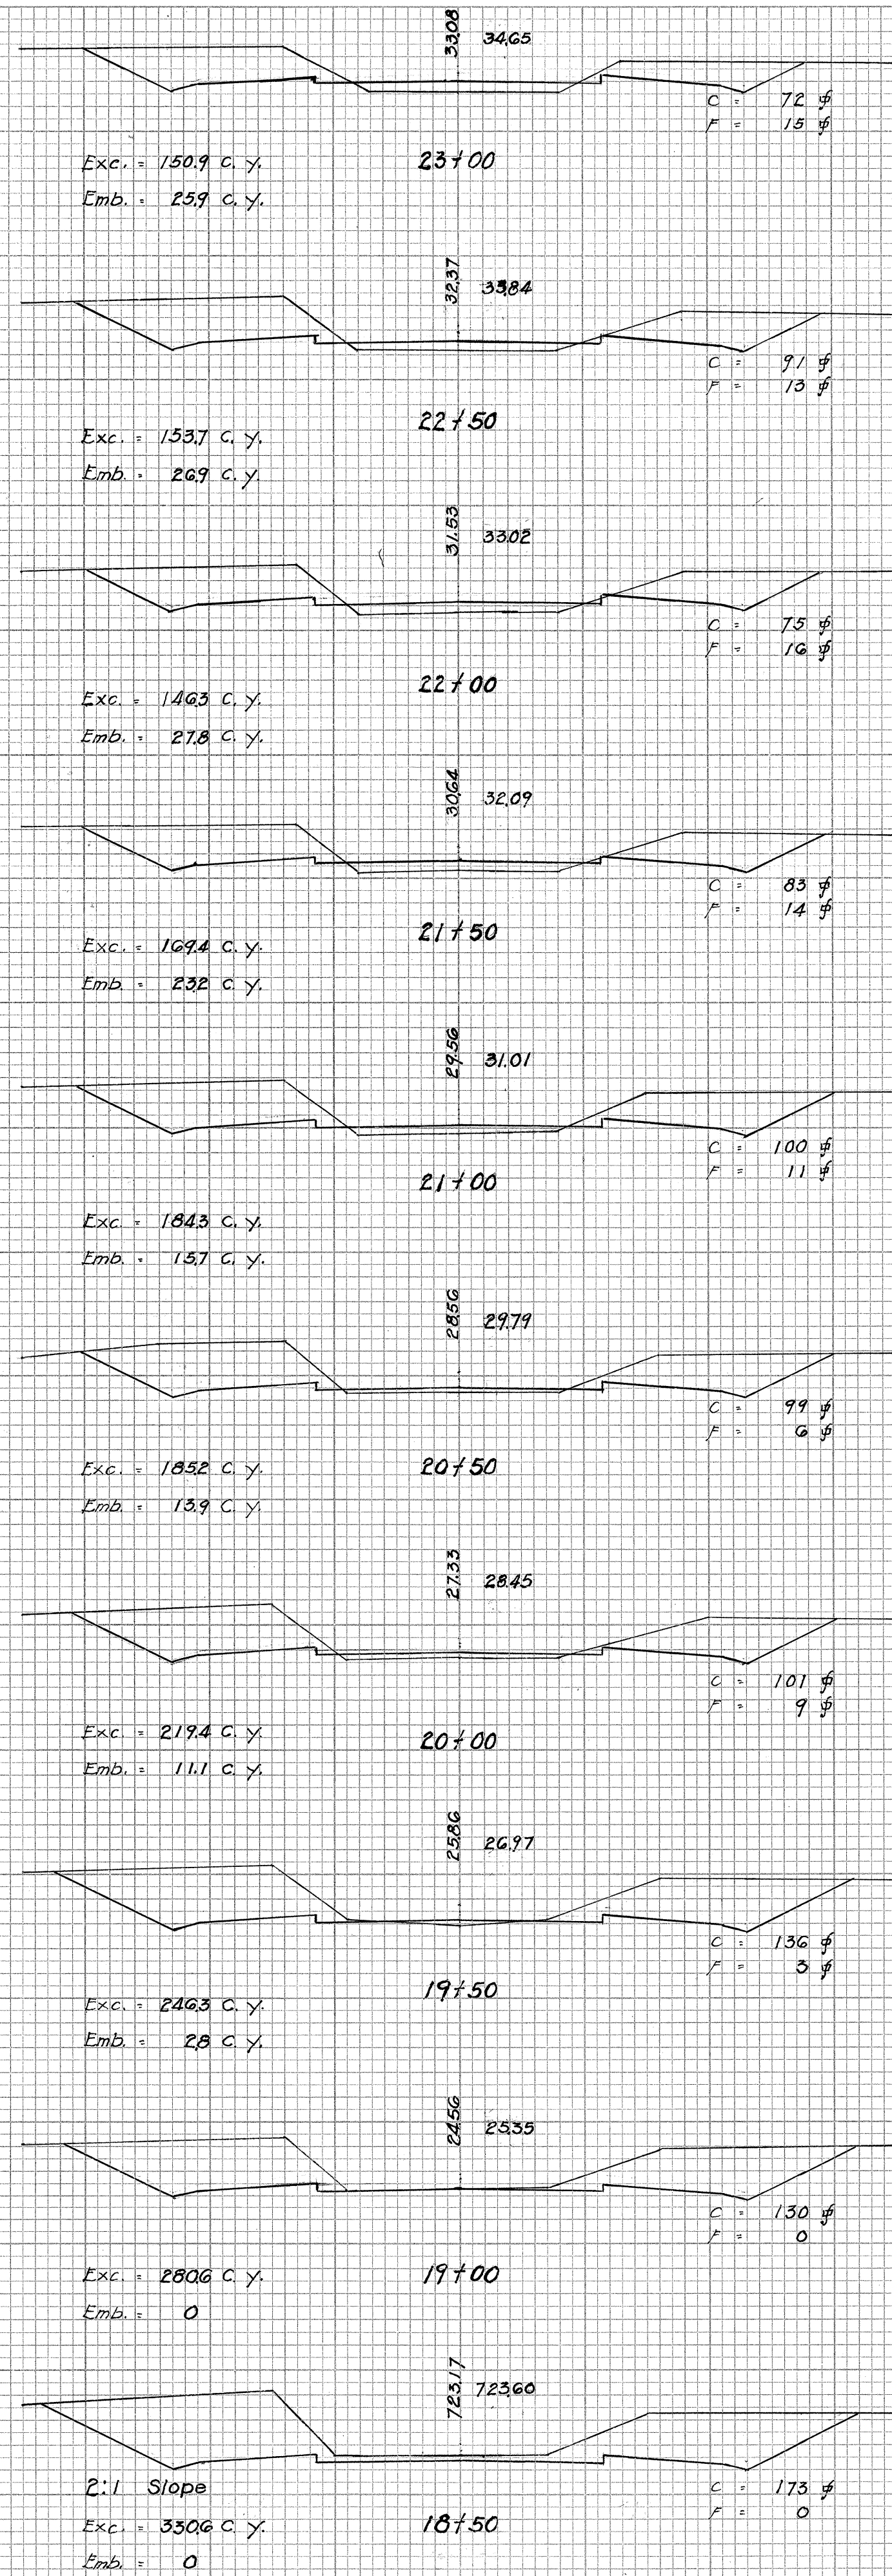

This sheet supercedes Sheet No 5124.12

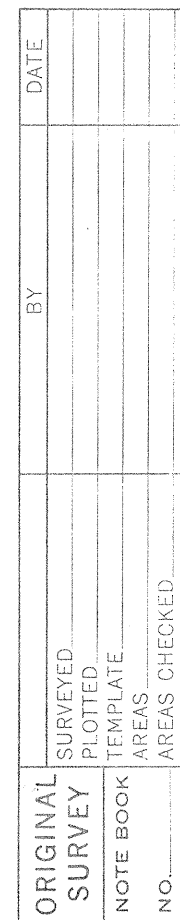

Sections taken at time of stakeout
Feb. 1947

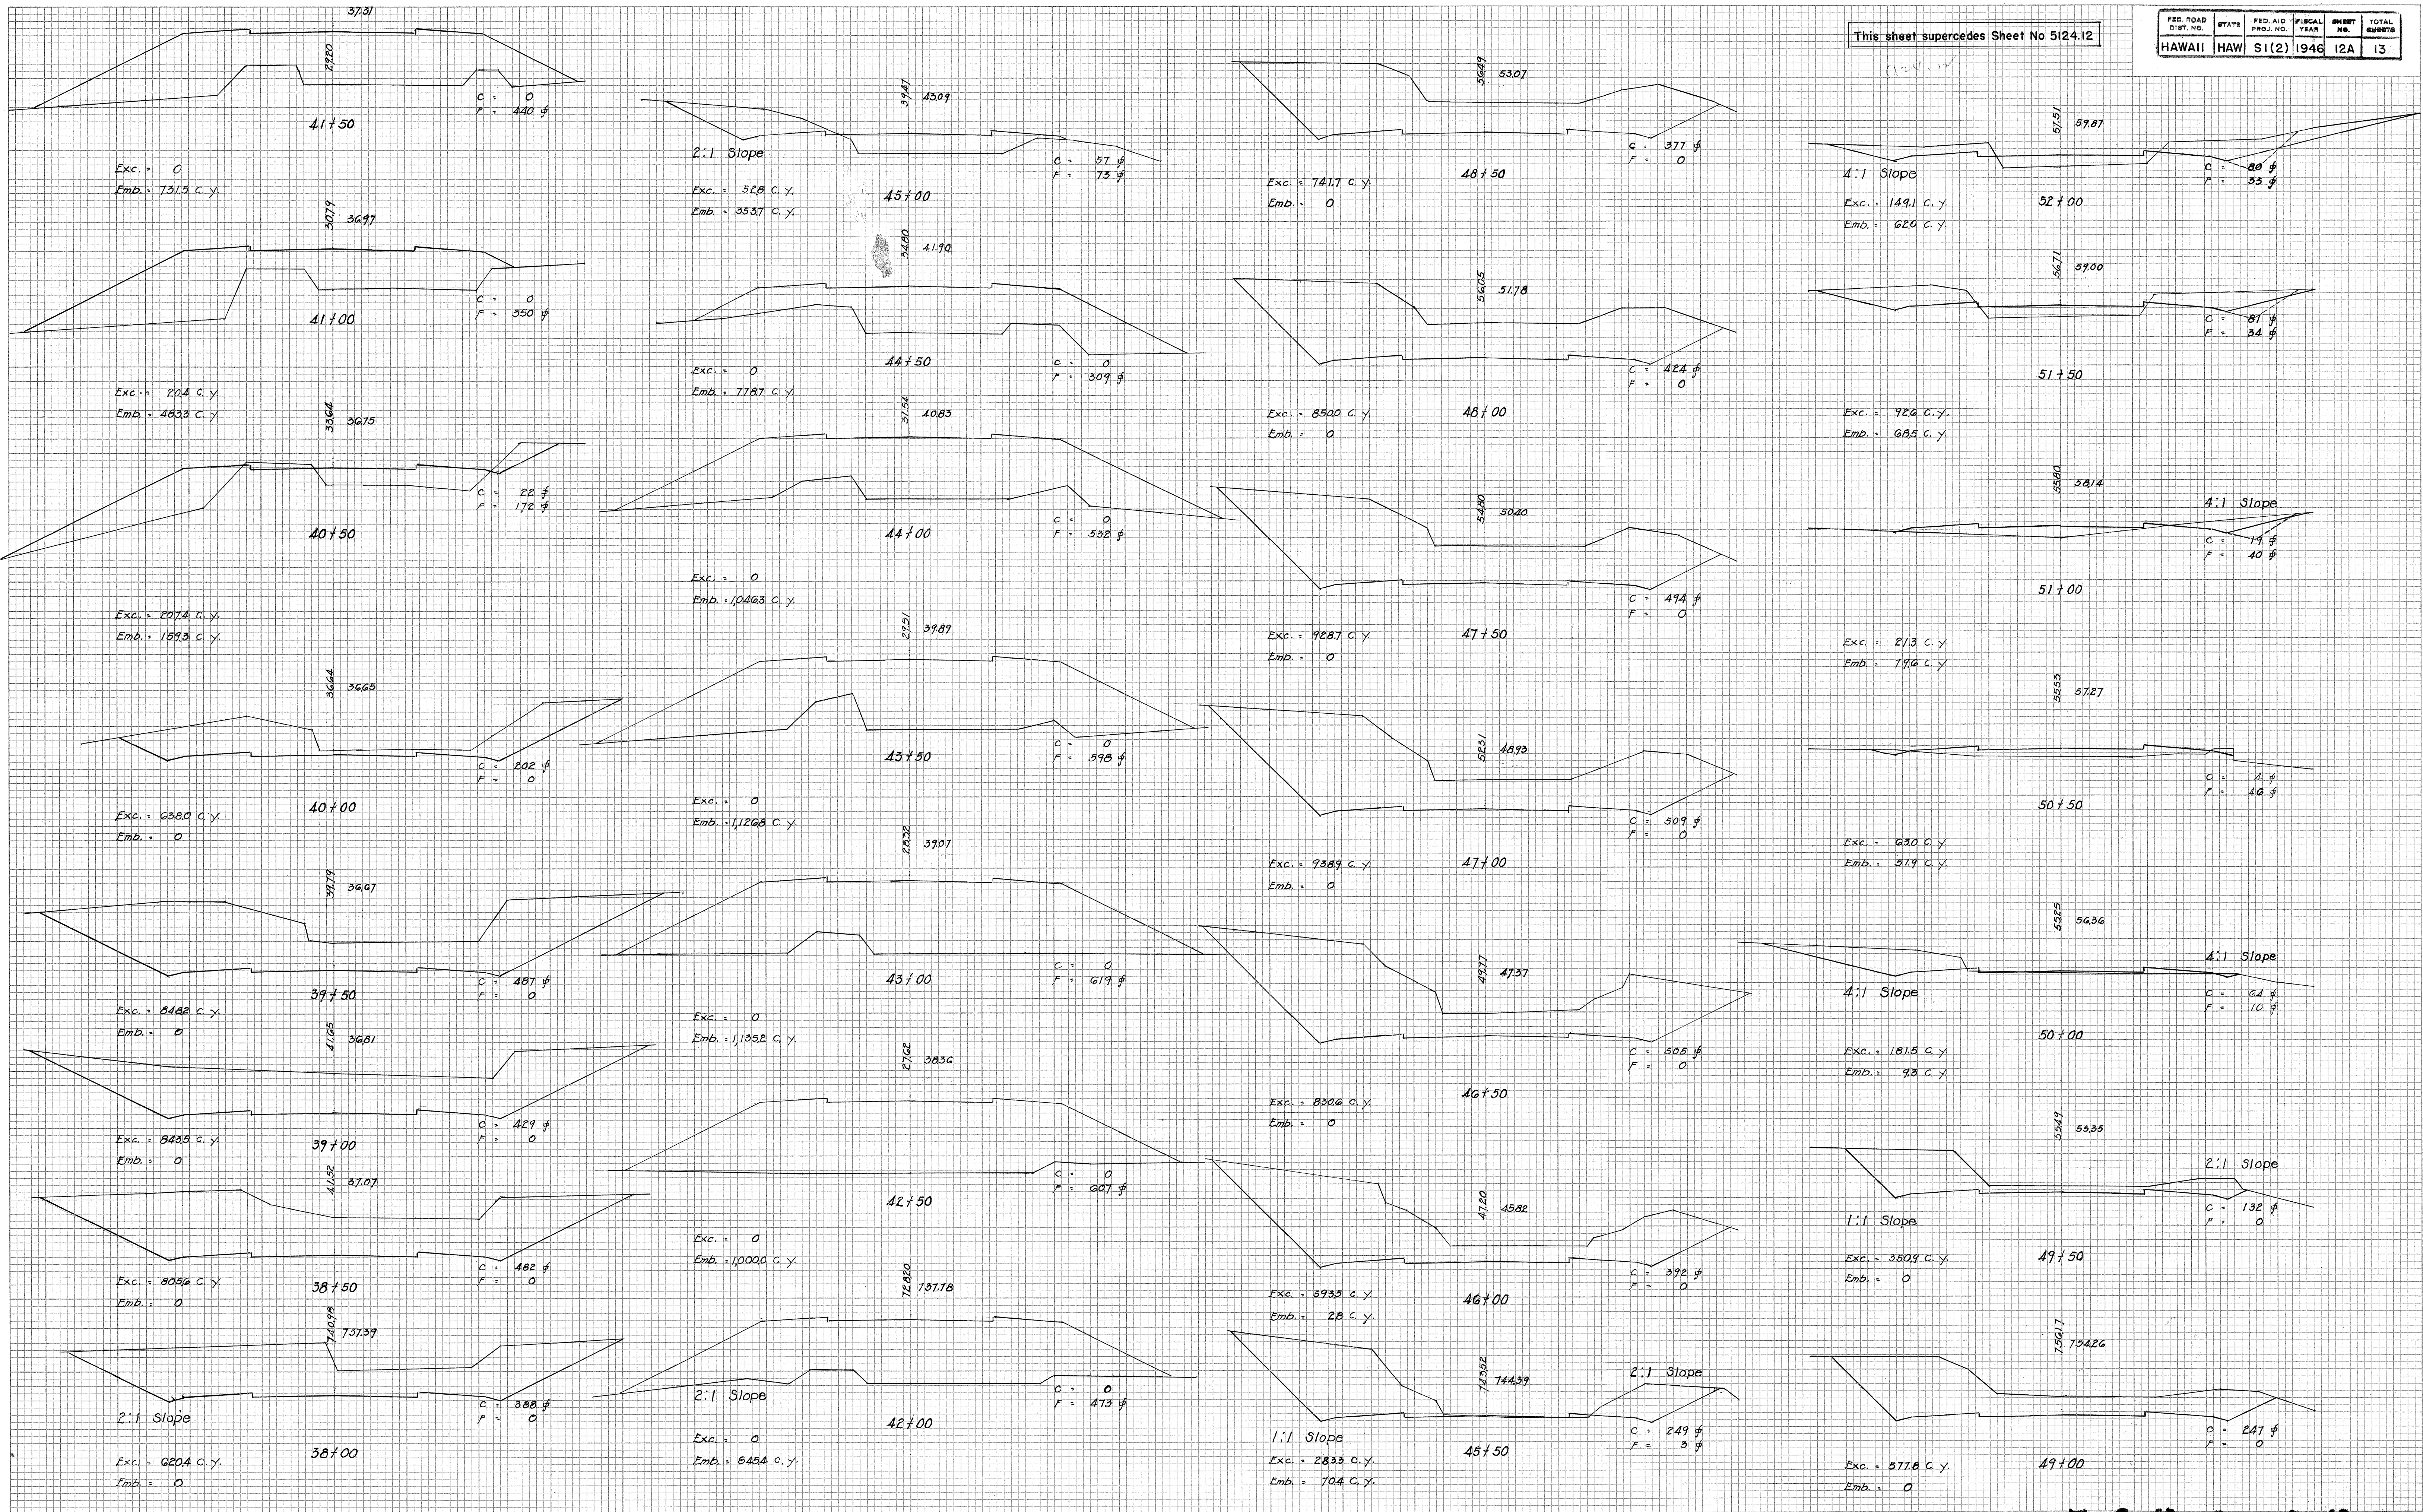

DATE Feb. 1947	BY H. H. H. H.	SURVIVED PLOTTED NOTE BOOK NO.	PLANNED PLOT NO.	CHECKED NO.

DATE Feb. 1947	BY H. H. H. H.	SURVIVED PLOTTED NOTE BOOK NO.	PLANNED PLOT NO.	CHECKED NO.

Sections taken at time of stakeout
Feb. 1947

This sheet supercedes Sheet No 5124.13

FED. ROAD DIST. NO.	STATE	FED. AID PROJ. NO.	FISCAL YEAR	SHEET NO.	TOTAL SHEETS
HAWAII	HAW	S1(2)	1946	13A	13

