




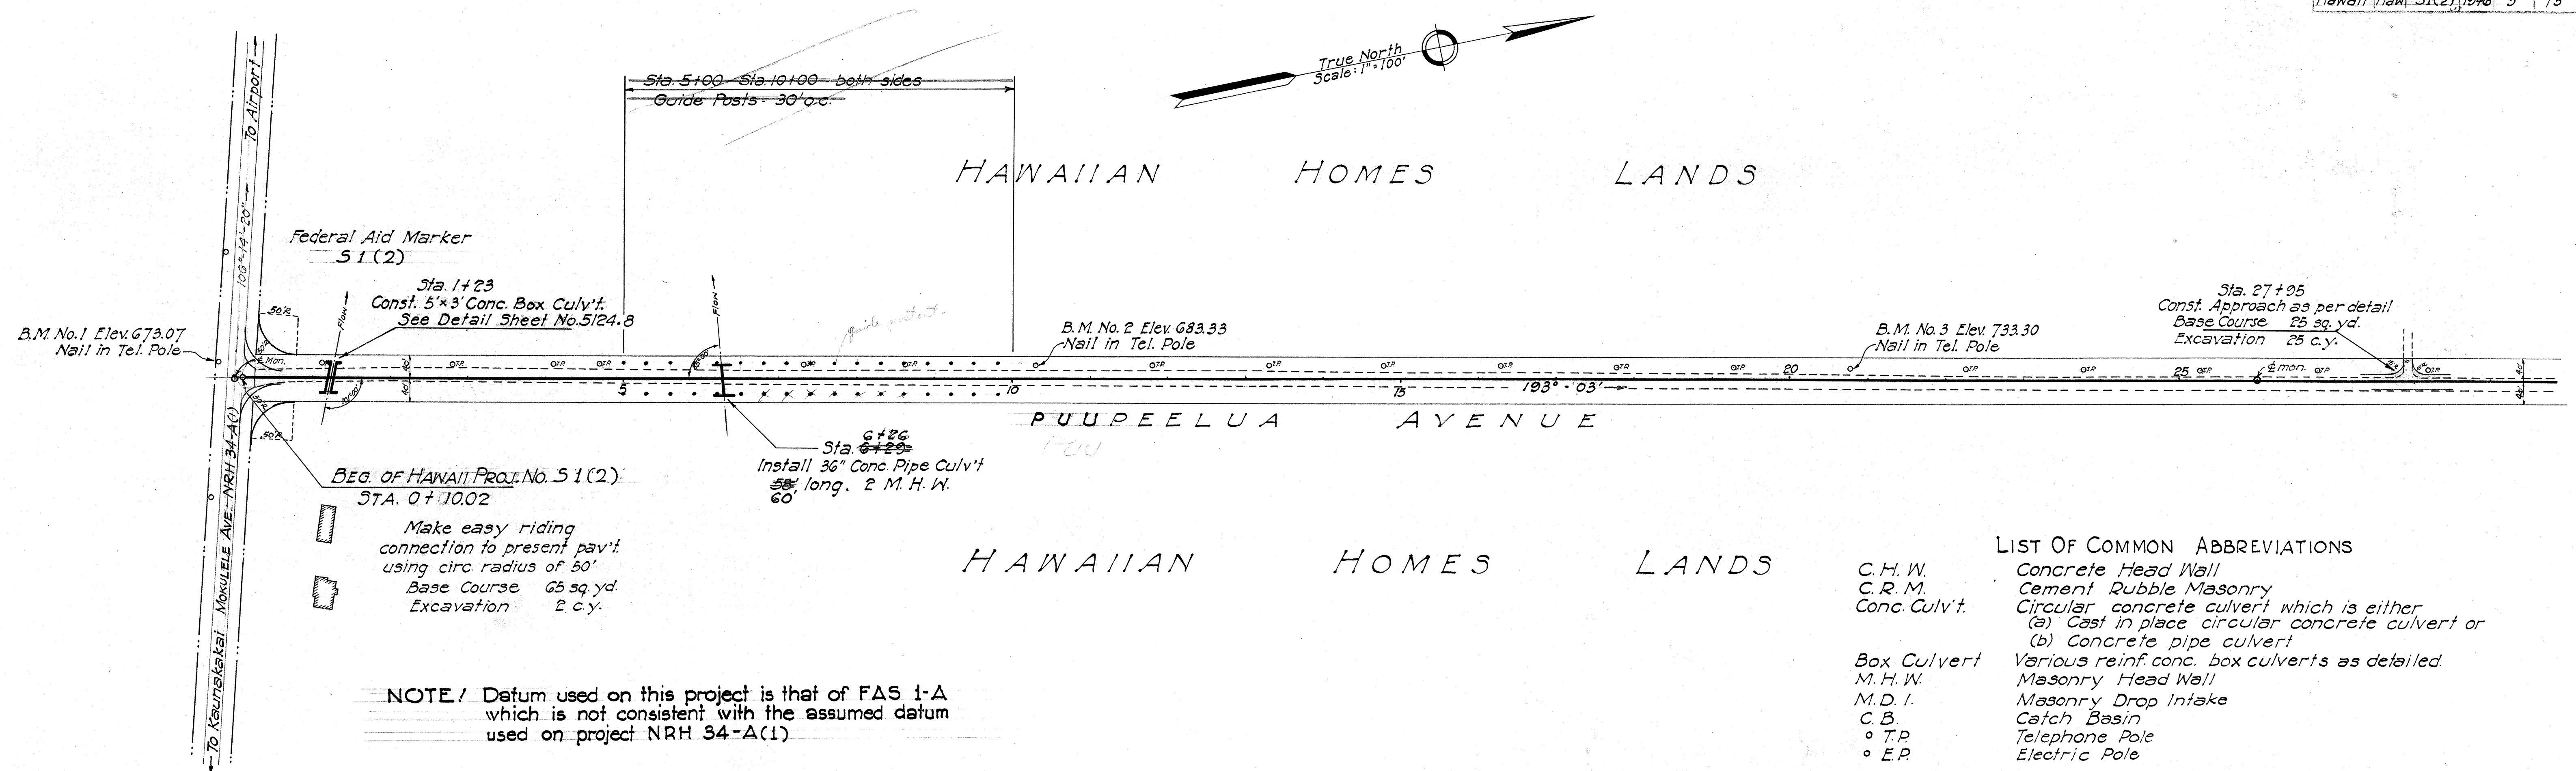

LIST OF COMMON ABBREVIATIONS


C.H.W.	Concrete Head Wall
C.R.M.	Cement Rubble Masonry
Conc. Culv't.	Circular concrete culvert which is either (a) Cast in place circular concrete culvert or (b) Concrete pipe culvert
Box Culvert	Various reinf. conc. box culverts as detailed.
M.H.W.	Masonry Head Wall
M.D.I.	Masonry Drop Intake
C.B.	Catch Basin
• T.P.	Telephone Pole
• E.P.	Electric Pole

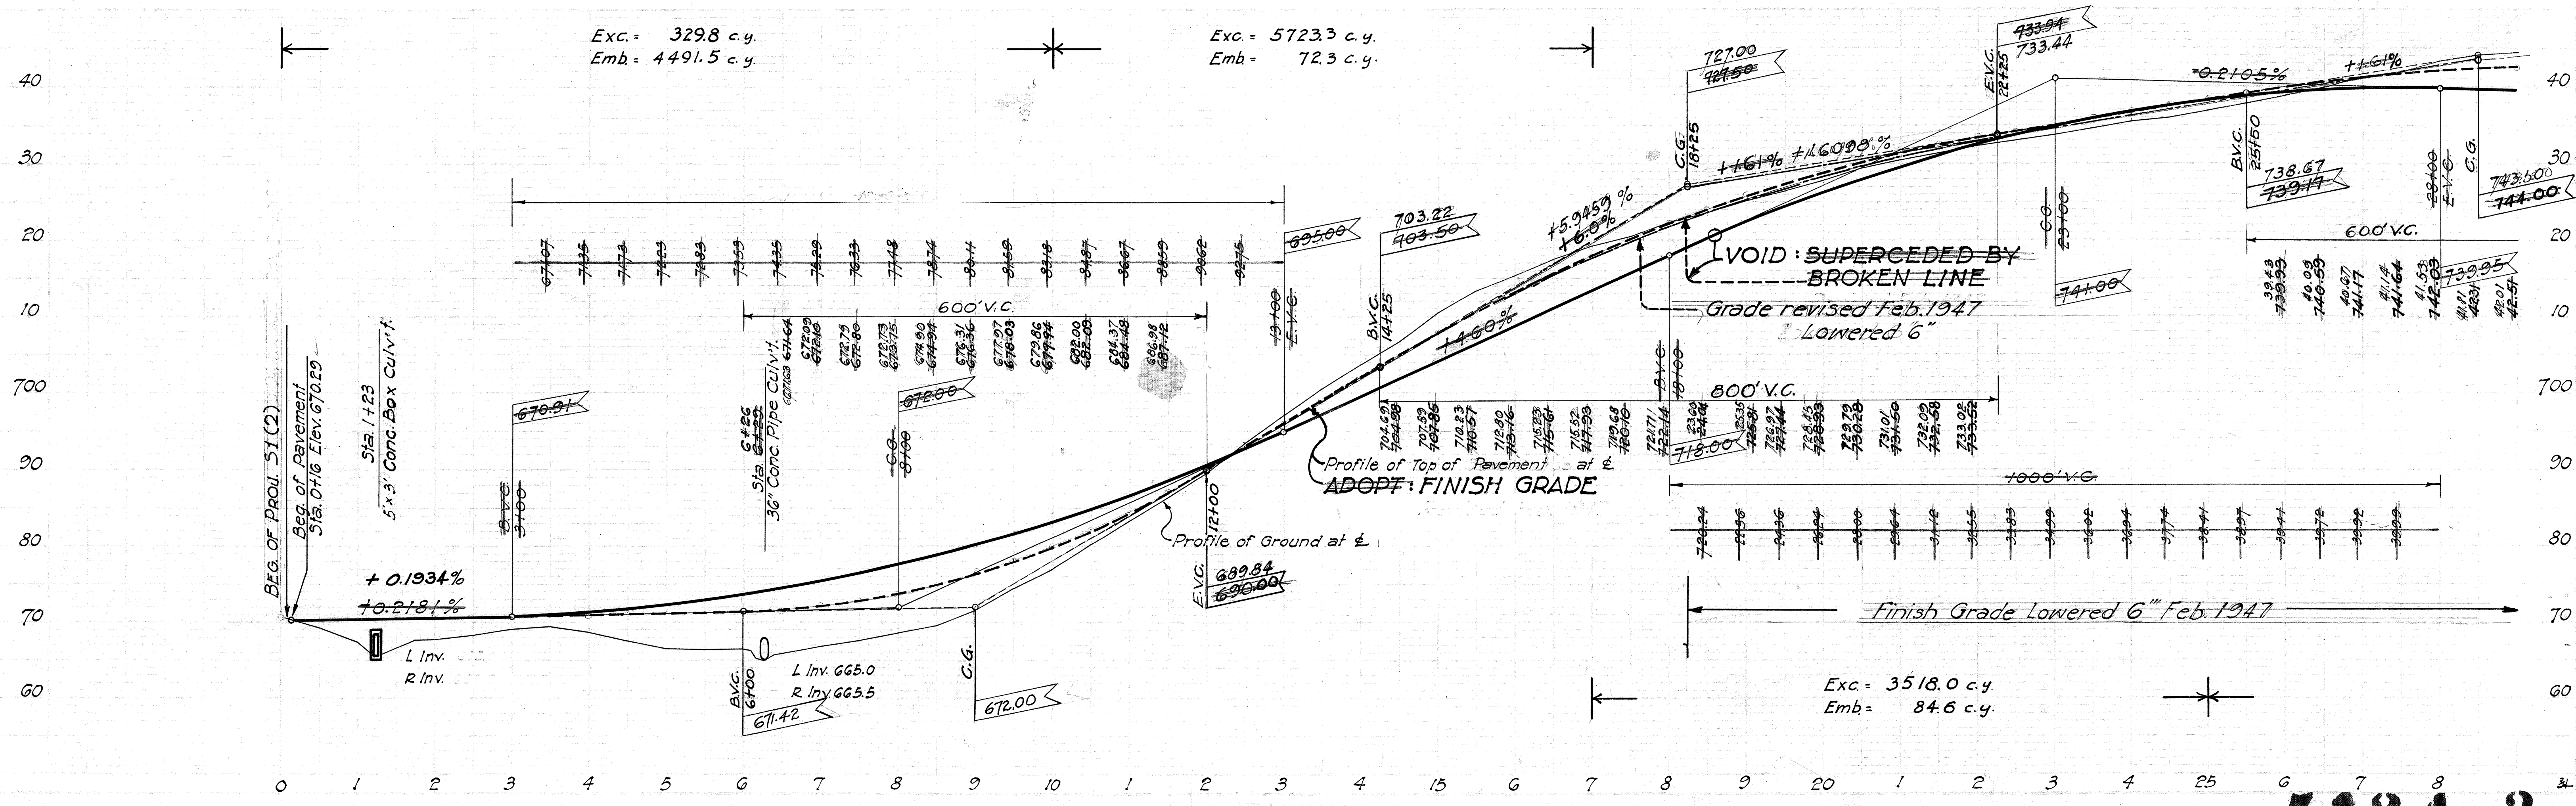


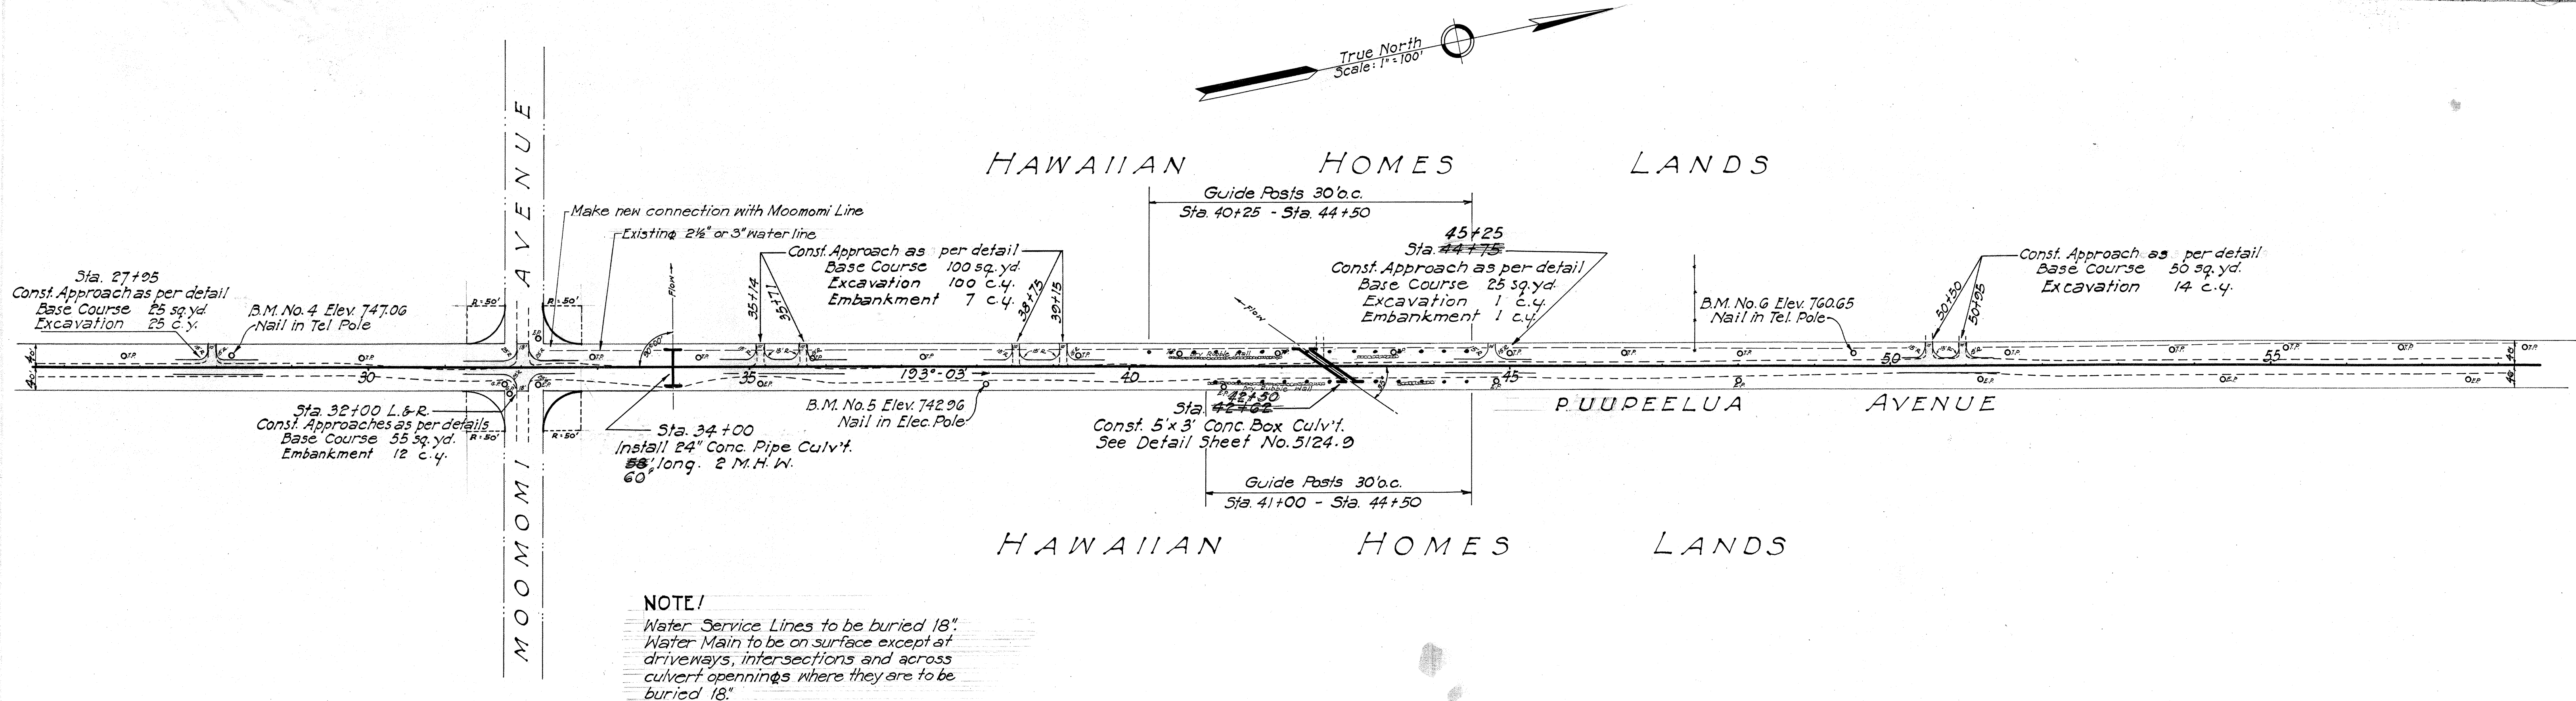


NOTE:
 Water Service Lines to be buried 18".
 Water Main to be on surface except at driveways, intersections and across culvert openings where they are to be buried 18".

Rev. 5-15-46 Existing Pipe Line Data Added 11-8-46

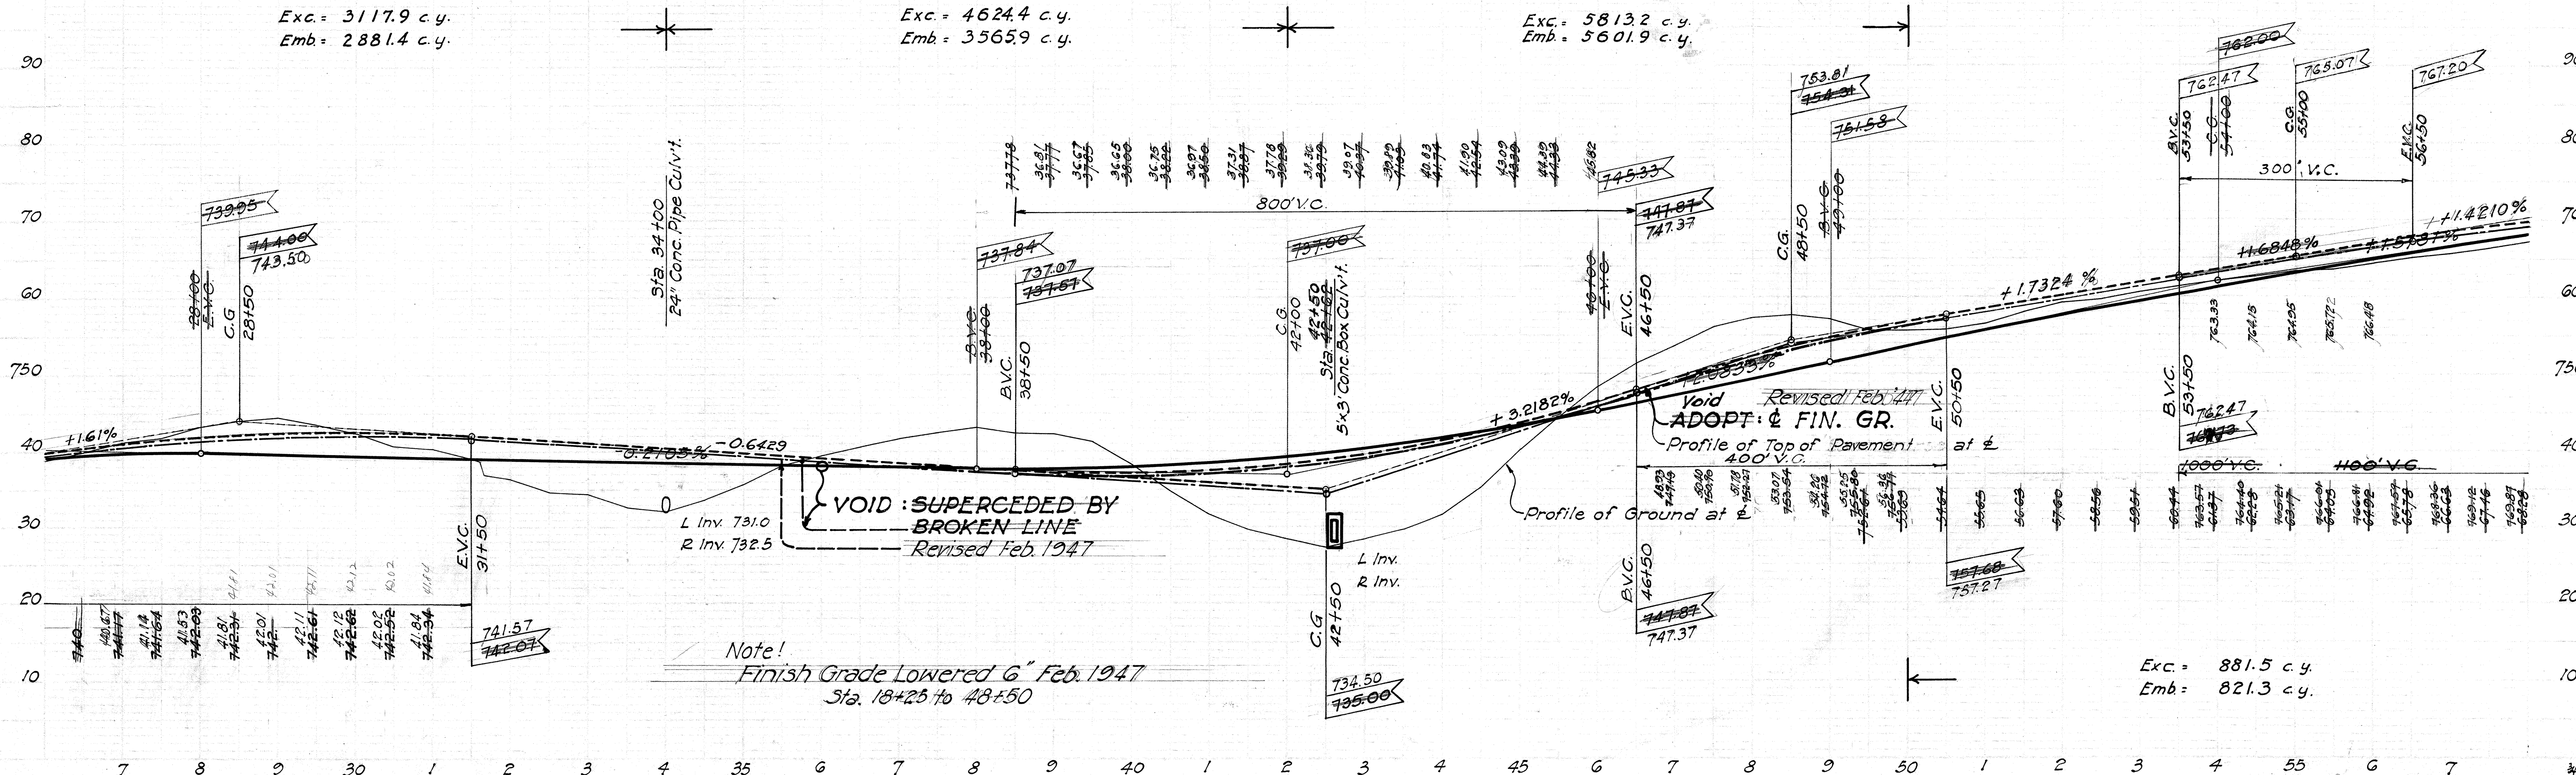

3124.4

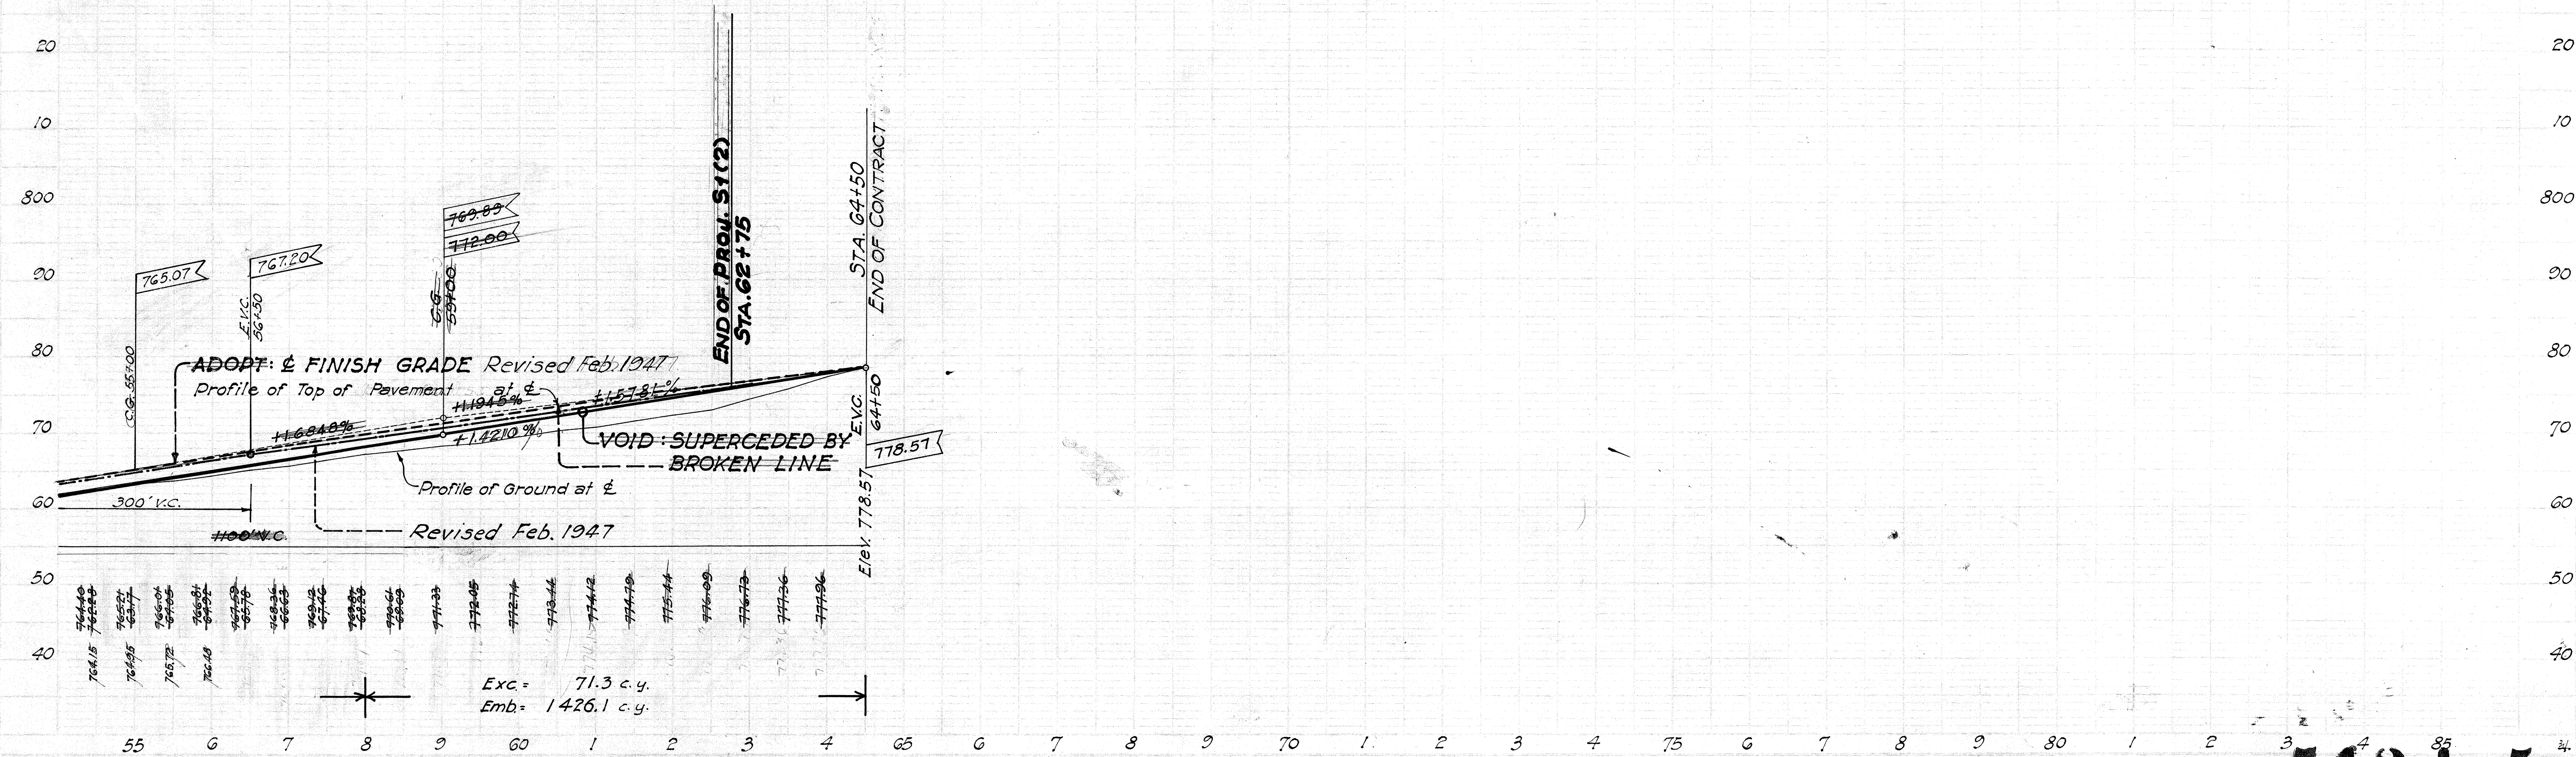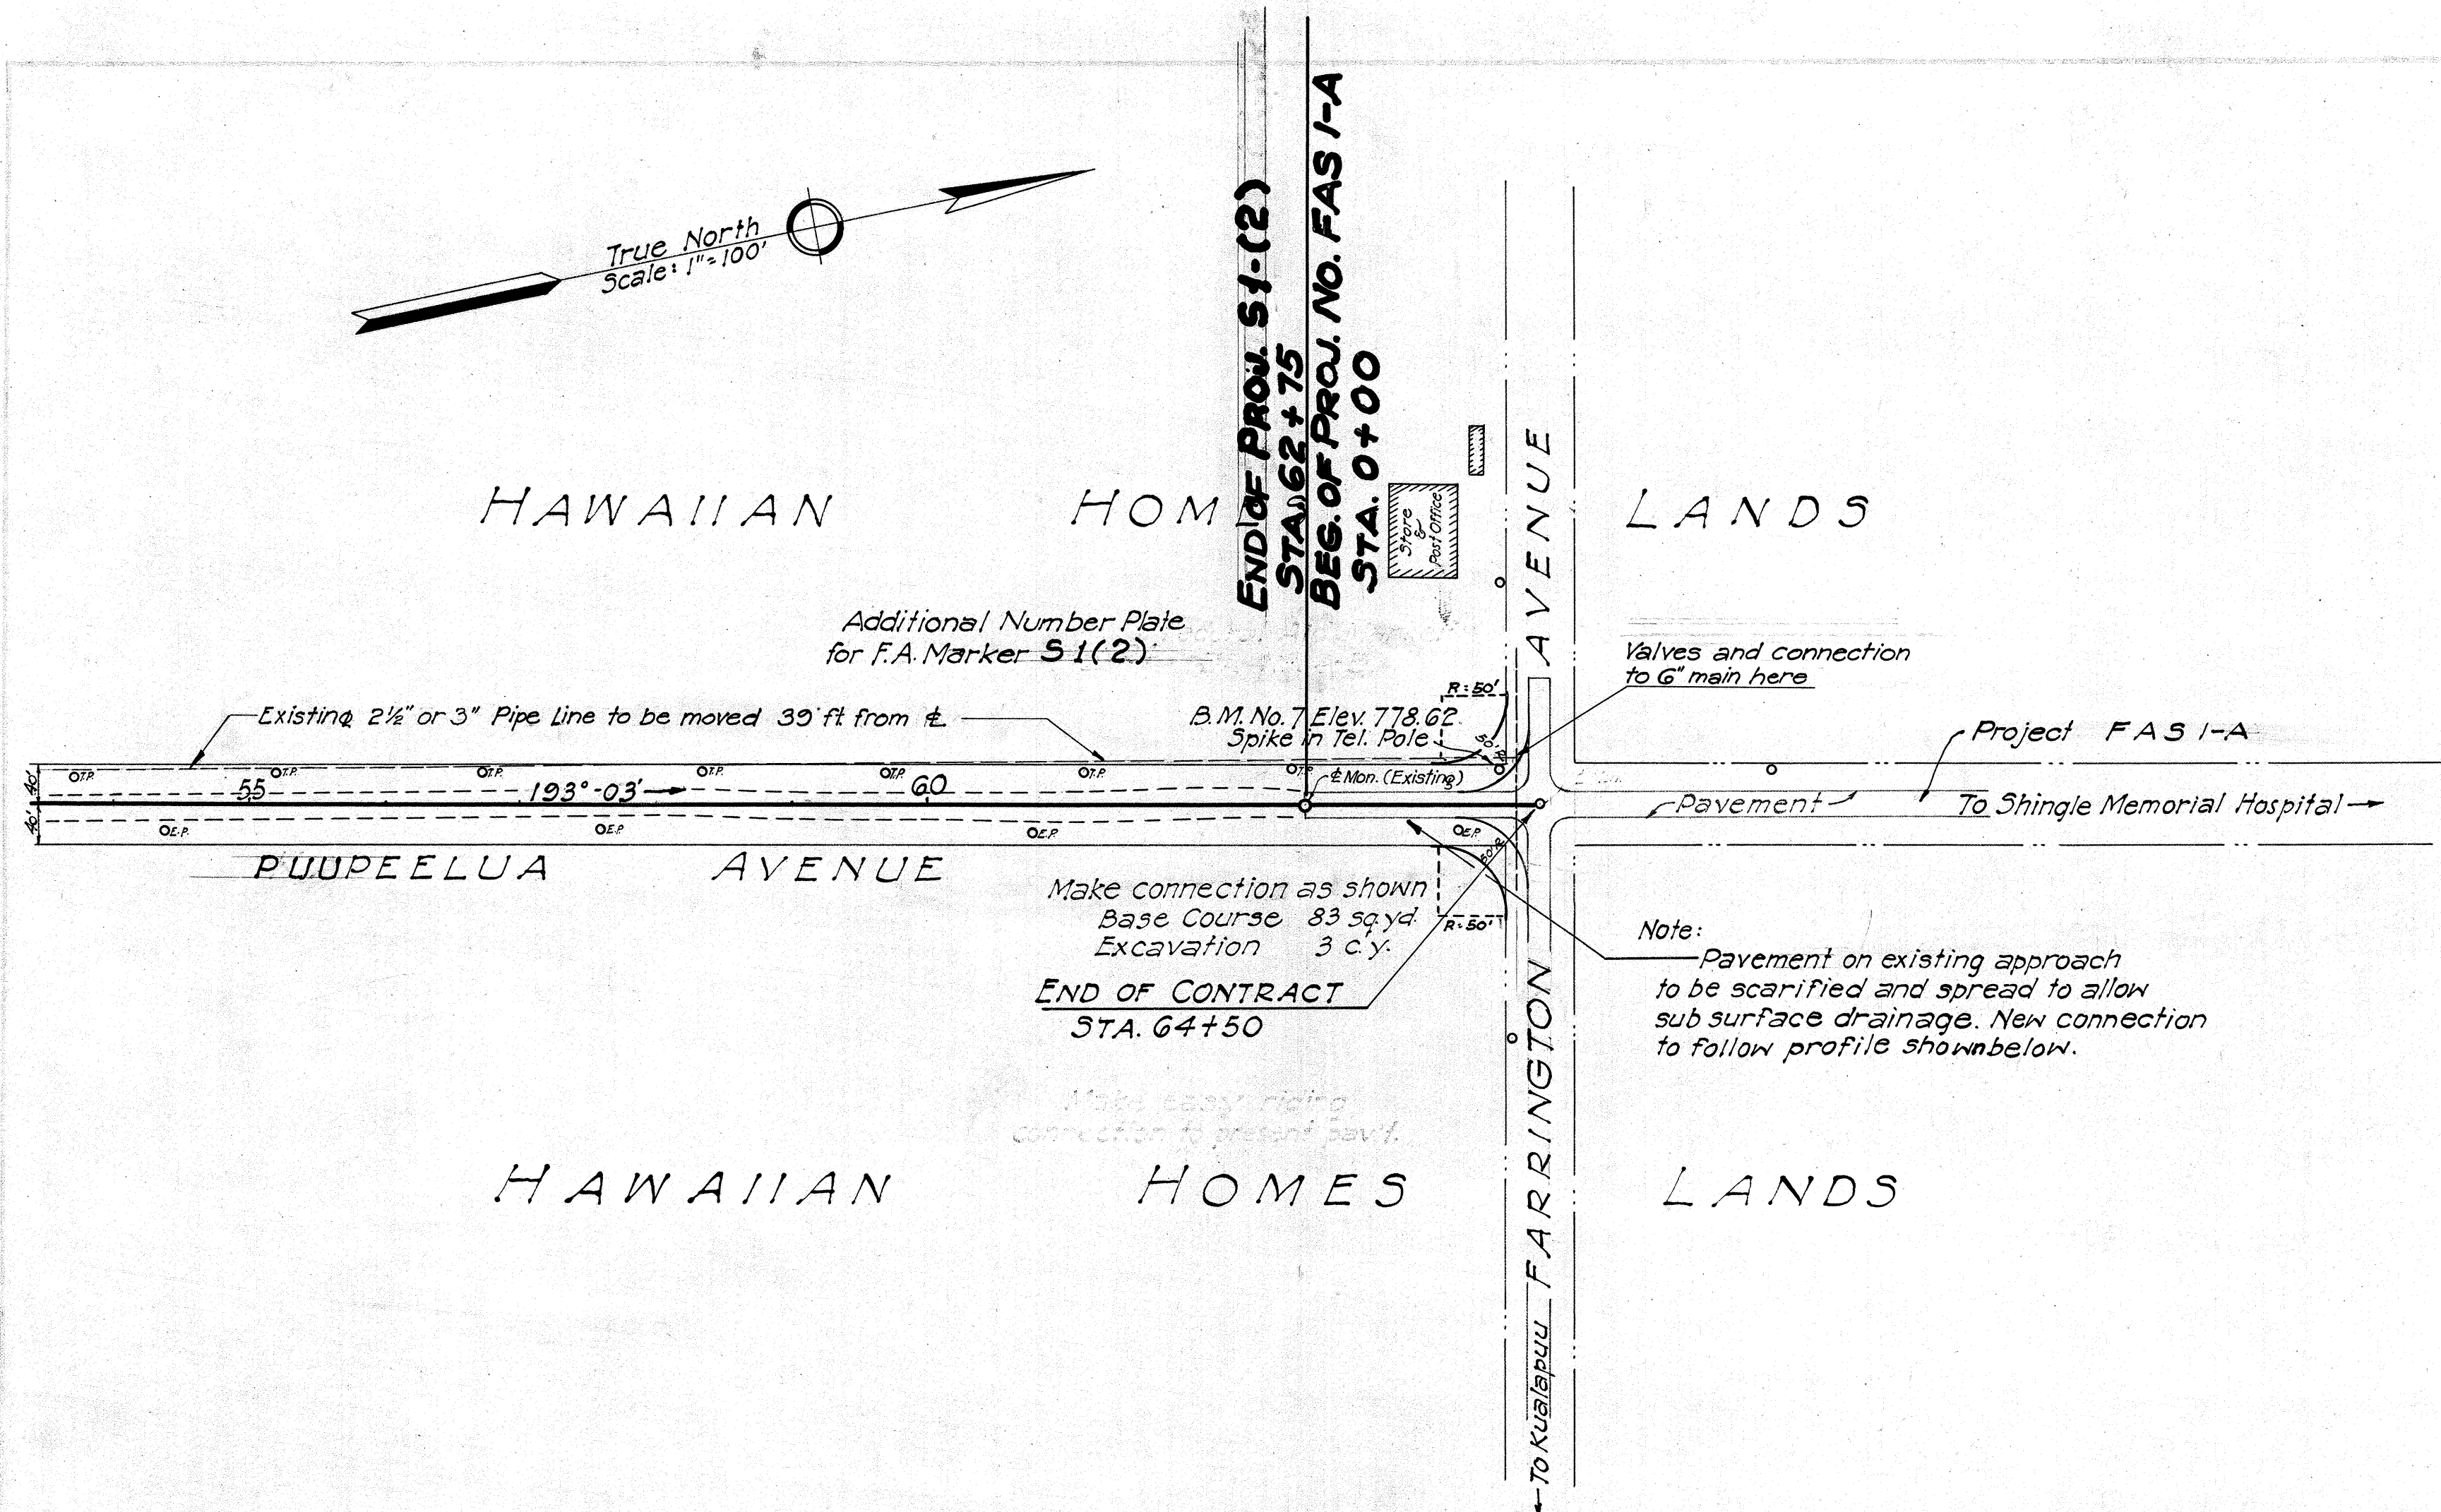

5124.5