

INDEX TO DRAWINGS	
SHEET NO.	DESCRIPTION
1	Title Sheet
2	Typical Road Section
3-5	Plan and Profile
6-7	Standard Details
8-9	Conc. Box Culvert Details
10-13	Cross Section Sheets

All changes made during construction have been shown in red on these tracings and checked by
H. Hayashi
Resident Engineer
Date: 4/16/49

TERRITORY OF HAWAII
TERRITORIAL HIGHWAY DEPARTMENT
HONOLULU, T. H.


PLANS OF
PUUPEELUA AVENUE

FEDERAL AID SECONDARY PROJECT NO. S 1(2)

DISTRICT OF MOLOKAI
ISLAND OF MOLOKAI

SCALE

PLAN 1 IN. = 100 FT.
PROFILE HOR. 1 IN. = 100 FT.
VER. 1 IN. = 10 FT.
CROSS SECTIONS 1 IN. = 10 FT.

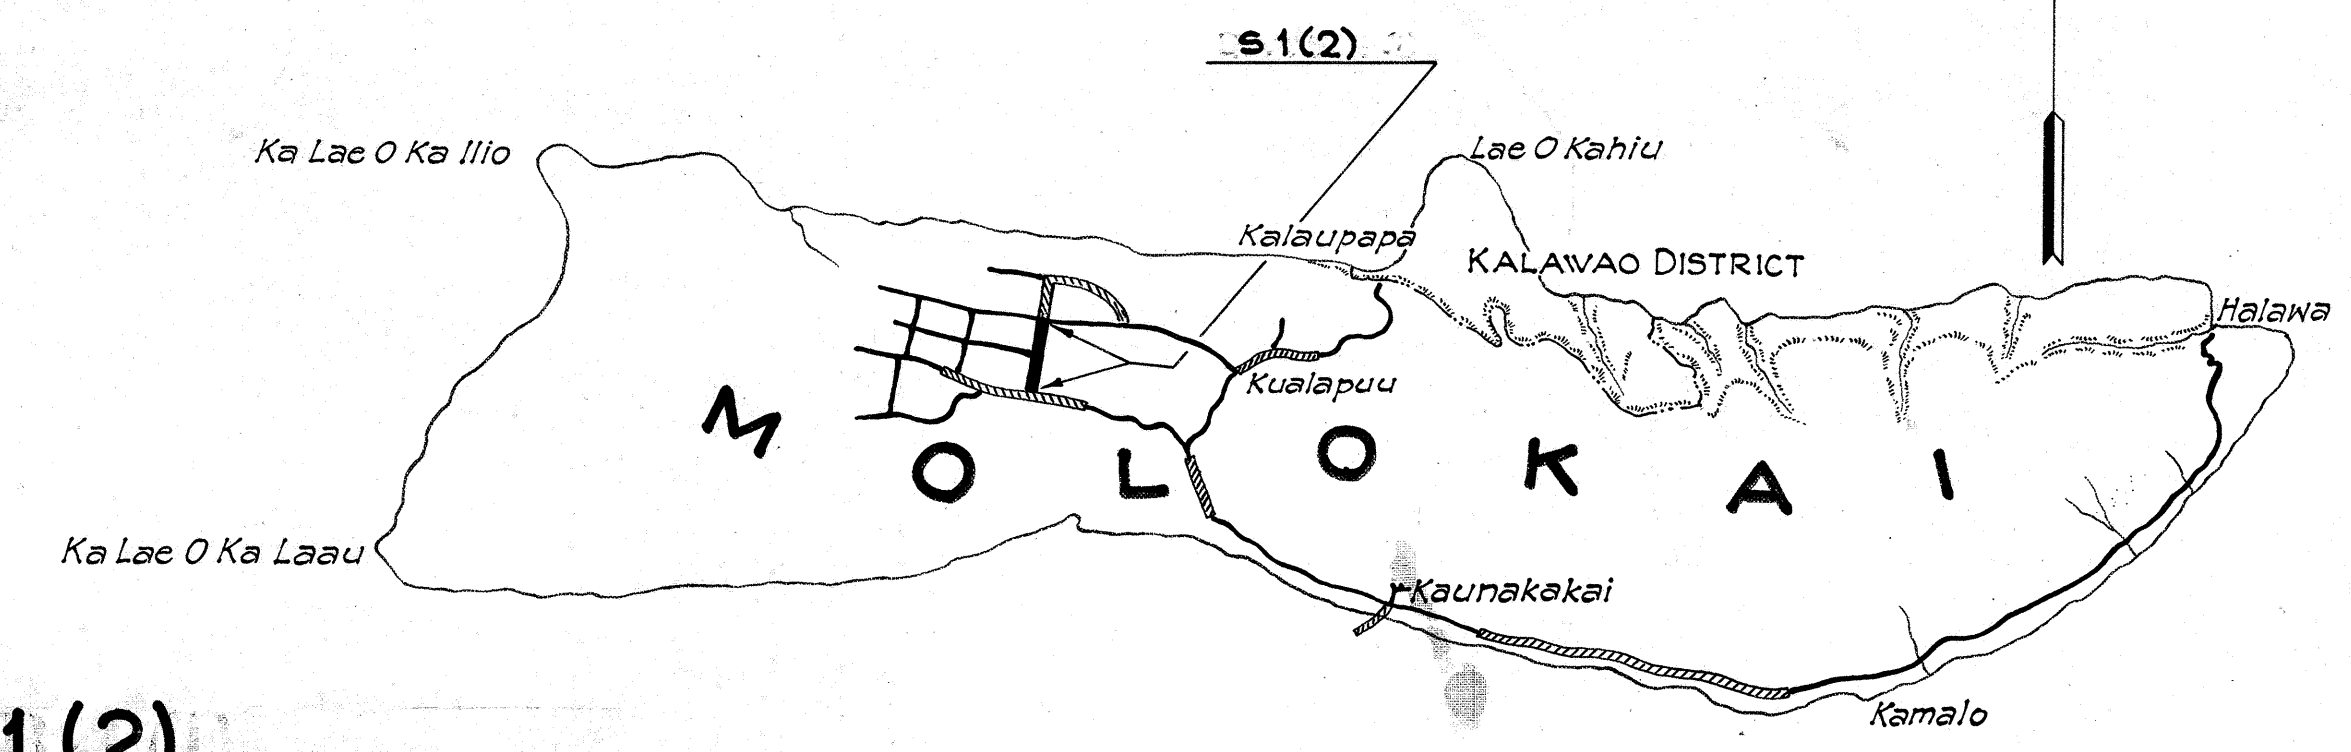


LOCATION MAP

Federal Aid Project previously constructed

CONVENTIONAL SIGNS

Present Road -----
Center Line -----
Pipe Culvert -----
Concrete Box Culvert -----

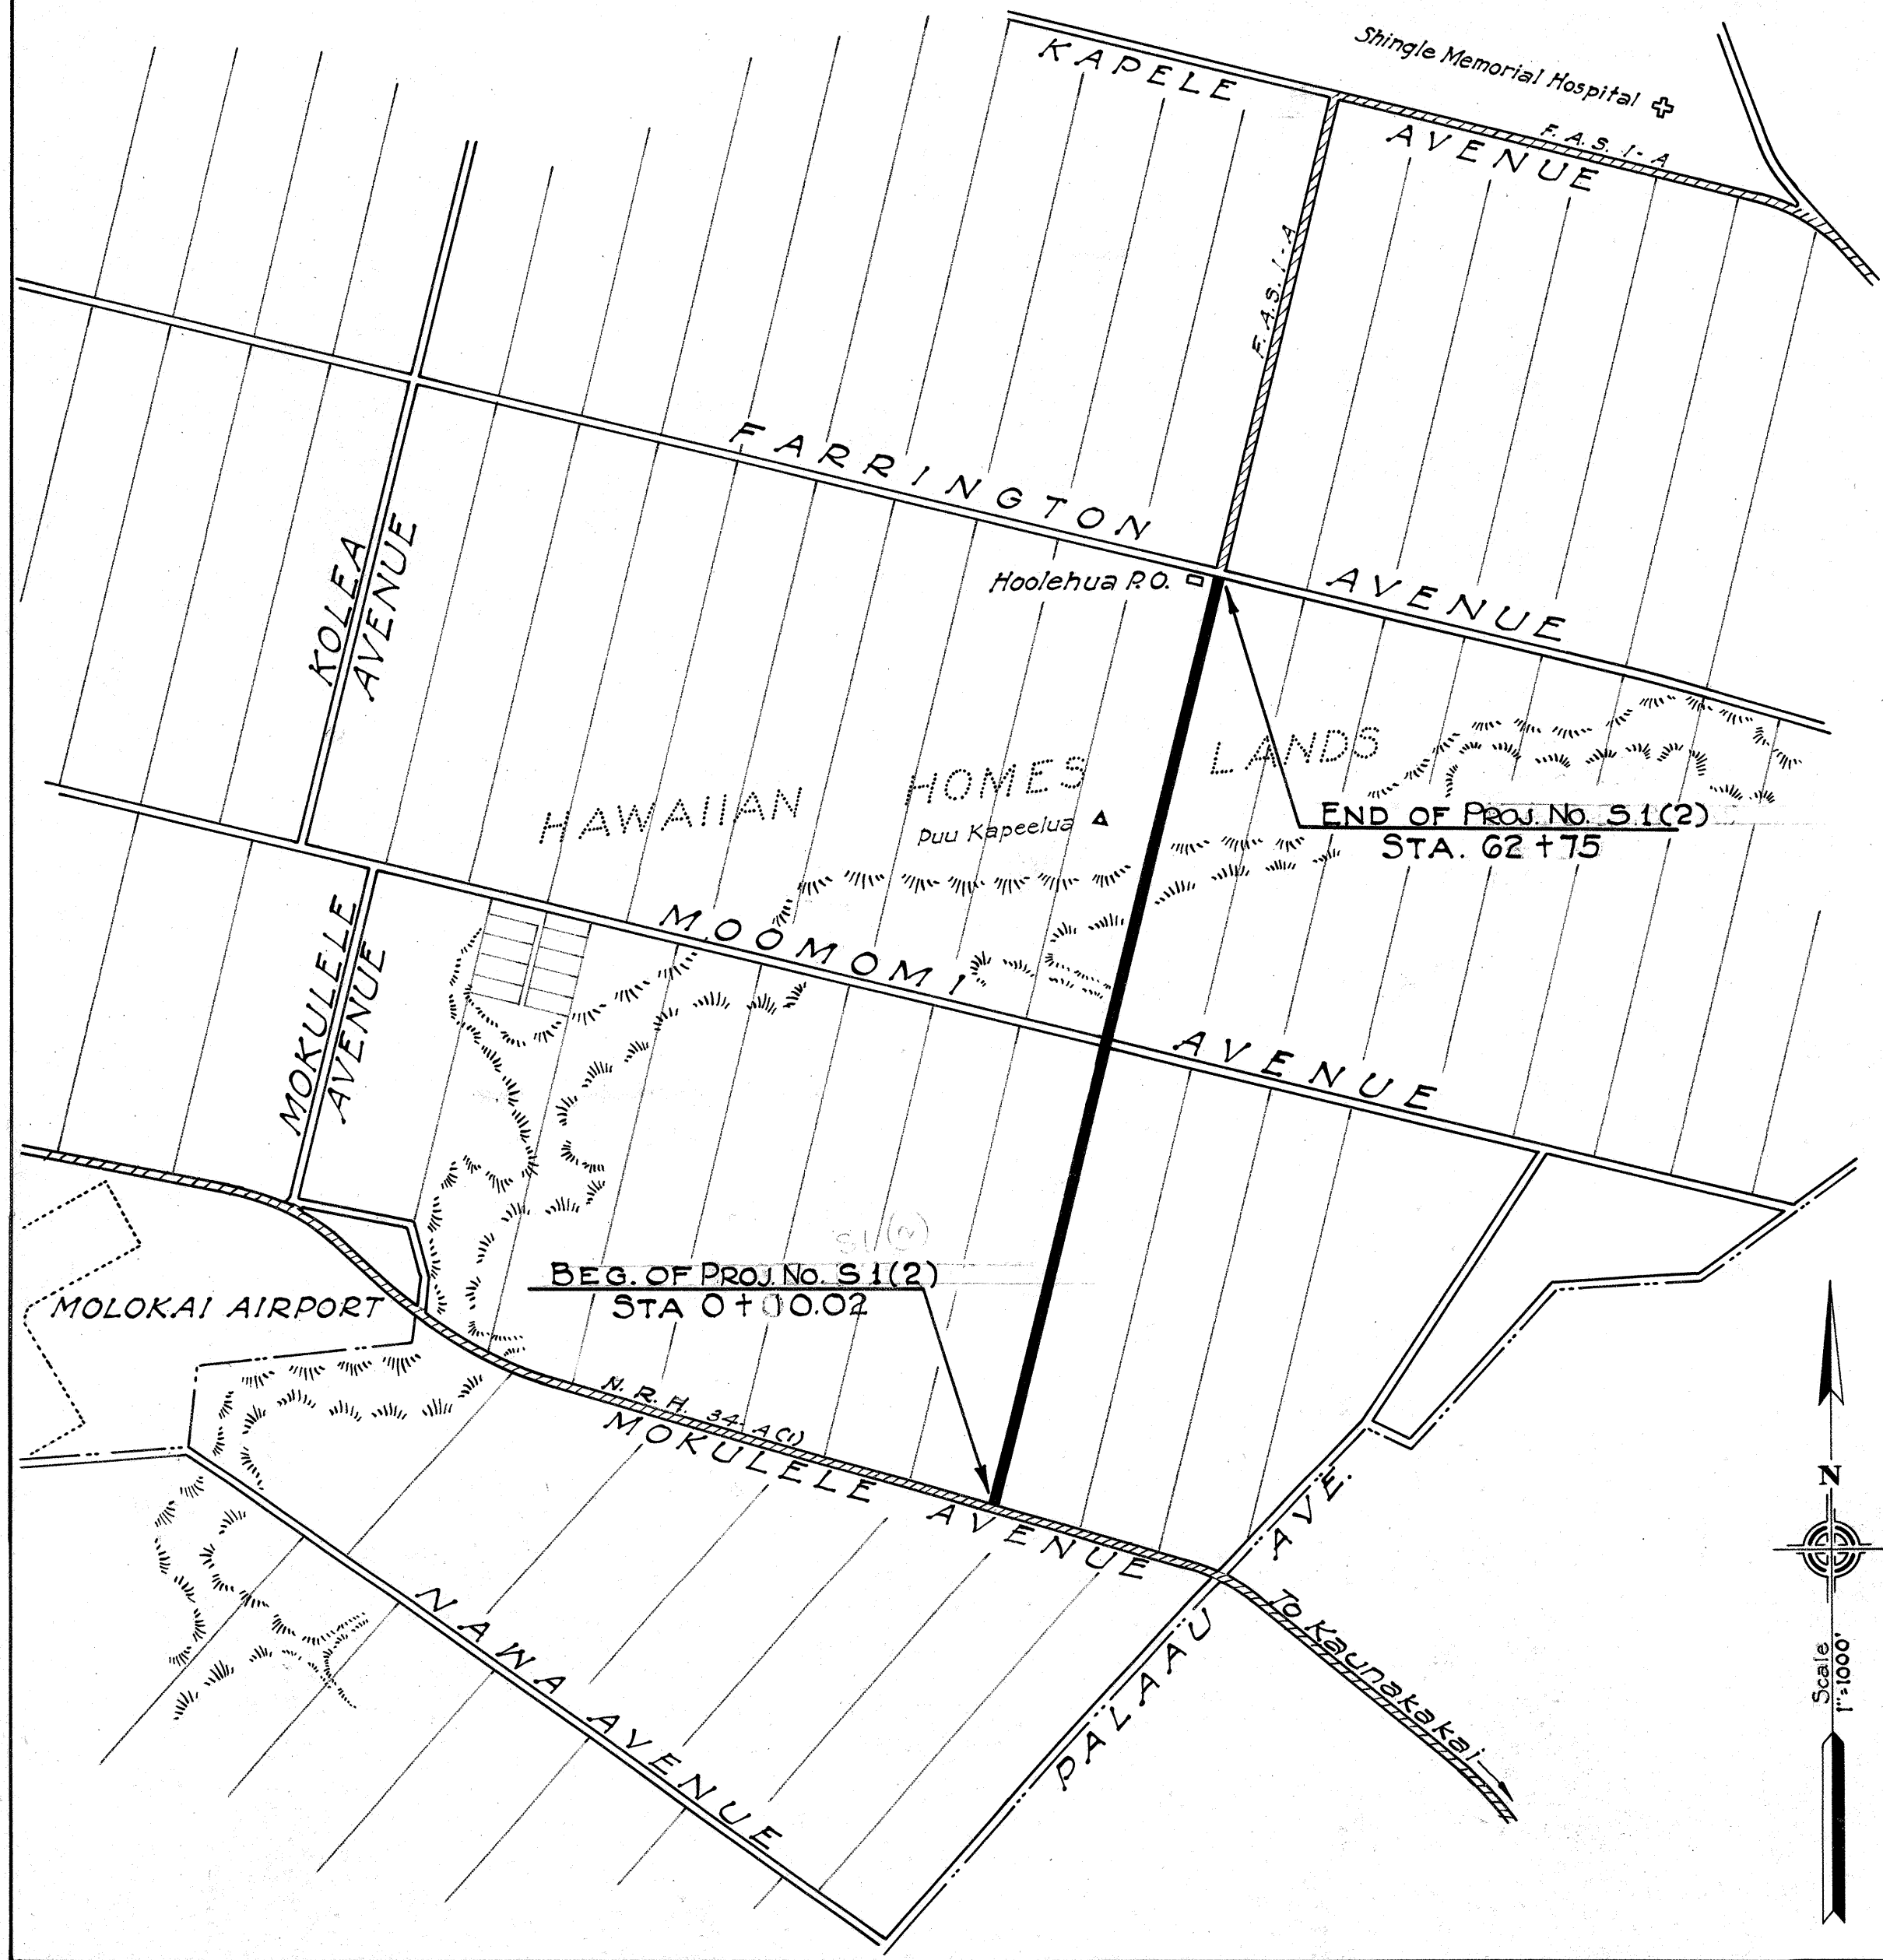

LAYOUT OF PROJECT

GROSS & NET LENGTH 1.186 MILES

Approved
B. F. Rush
Date: 5/22/46
Territorial Highway Engineer

Recommended for Approval
[Signature]
DISTRICT ENGINEER
Public Roads Administration
Federal Works Agency

Approved
[Signature]
DIVISION ENGINEER
Public Roads Administration
Federal Works Agency