
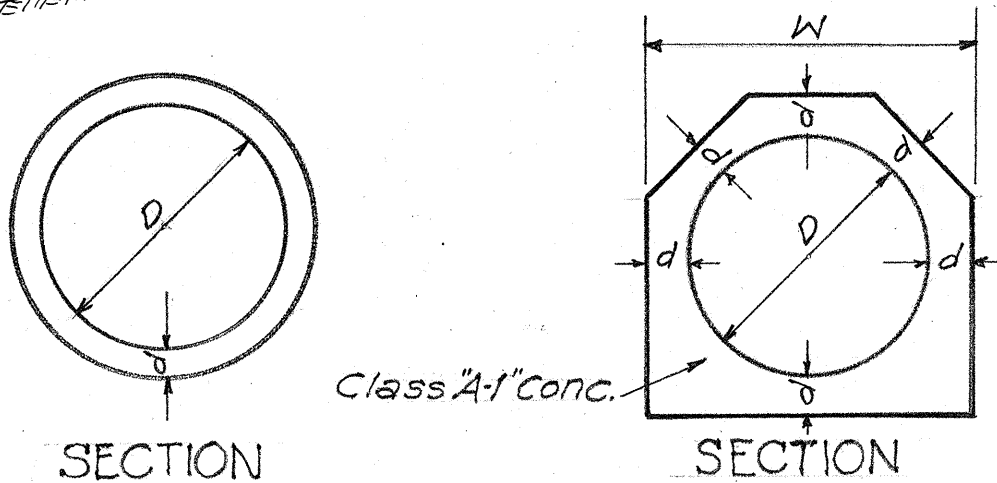
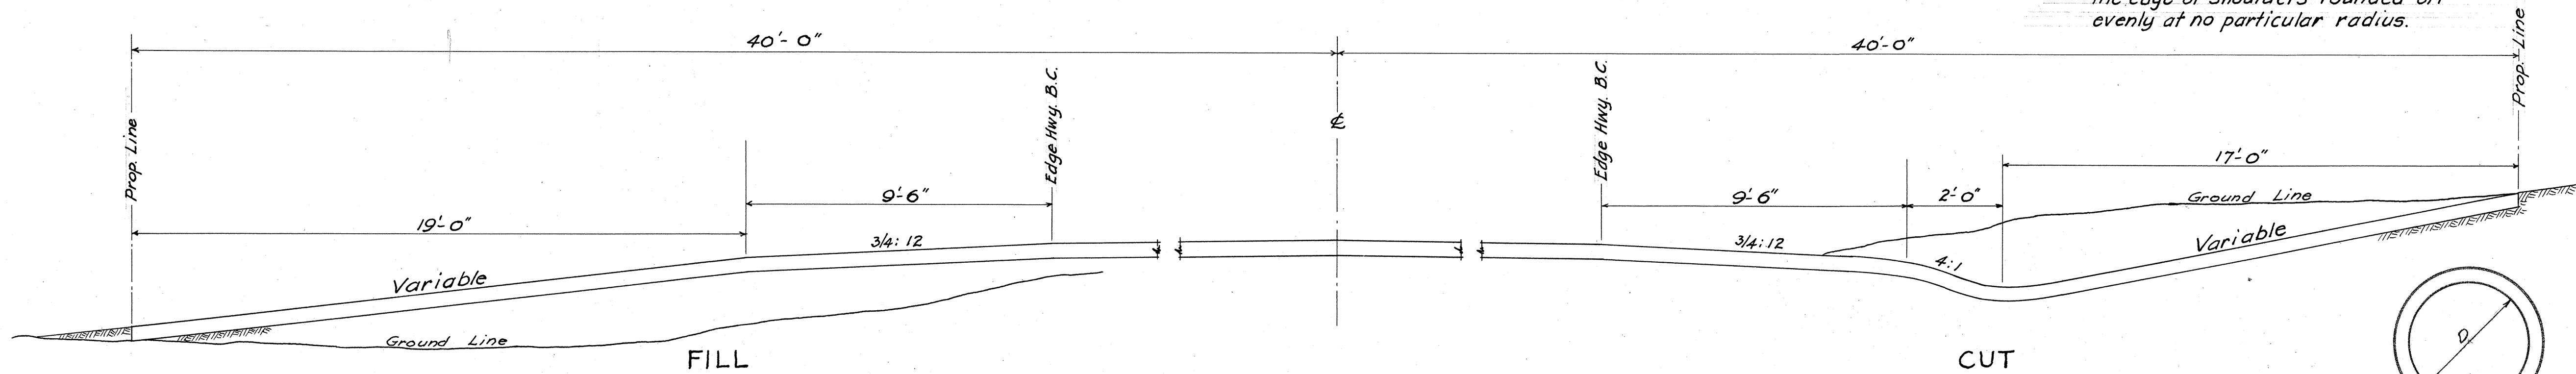


FED. ROAD DIST. NO.	STATE	FED. AID PROJ. NO.	FISCAL YEAR	SHEET NO.	TOTAL SHEETS
Hawaii	Haw.	DA-WR41	1944	2	13
Hawaii	Haw.	DA-WC68	1944	2	16
Hawaii	Haw.	SI (2)	1946	2	13

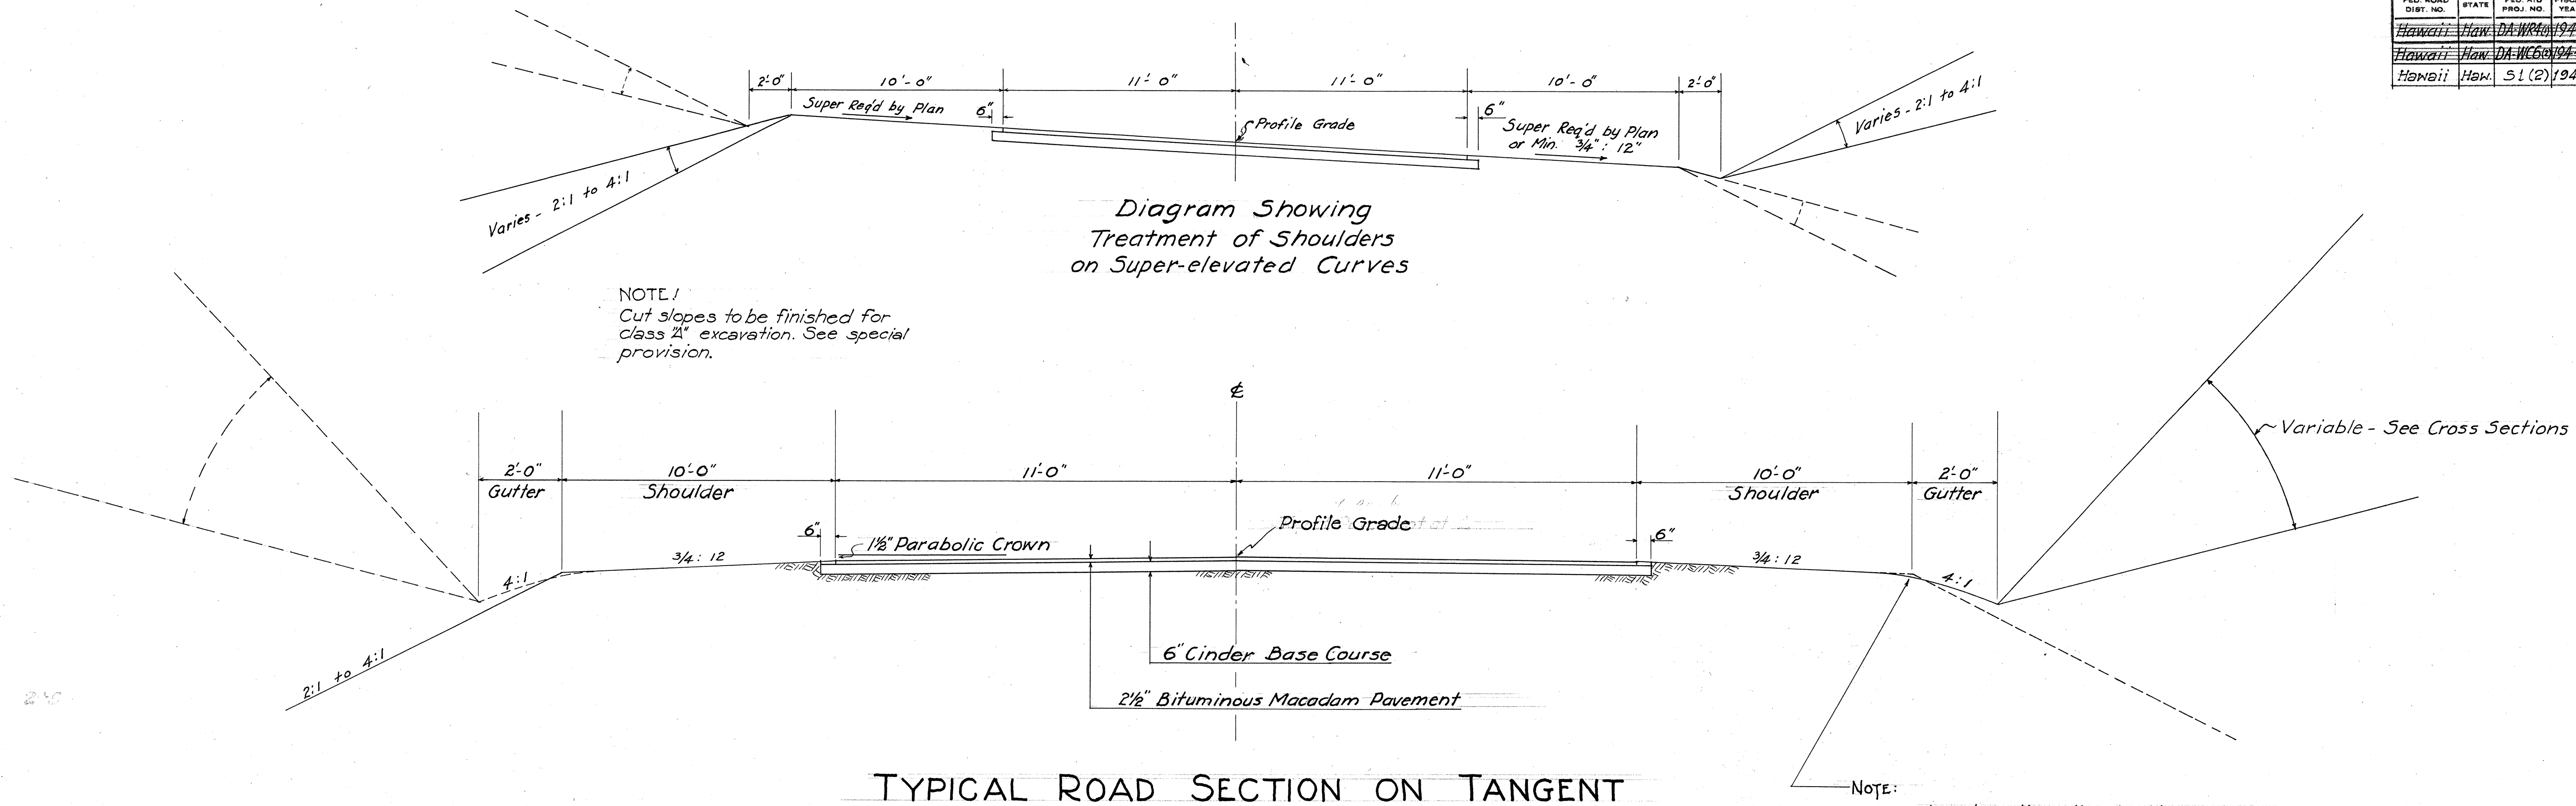


CONC. PIPE CULVERT

Note: Thickness "d", reinforcing, and concrete used are to conform with the approved design as provided by the Specifications.

D	d	W	Cu. Yd. per ft.
18"	4"	2'-2"	0.11
24"	4 1/2"	2'-9"	0.14
30"	5"	3'-4"	0.19
36"	5 1/2"	3'-11"	0.26

CAST-IN-PLACE CONC. CULVERT

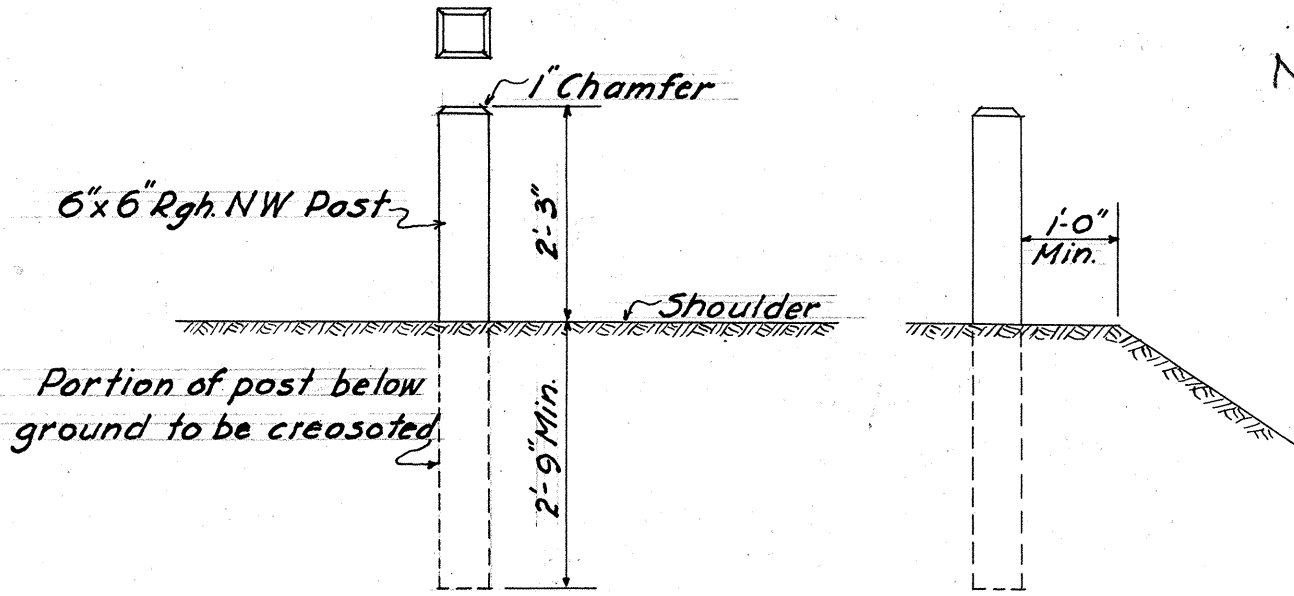

TERRITORIAL HIGHWAY DEPARTMENT

TERRITORY OF HAWAII

TYPICAL SECTIONS

MOLOKAI AIRPORT ROAD	DA - WC 6 (2)
KAREELUA AVE.	DA - WR 4 (1)
PUUPEELUA AVE.	SI (2)