



FED. ROAD DIST. NO.	STATE	FED. AID PROJ. NO.	FISCAL YEAR	SHEET NO.	TOTAL SHEETS
HAWAII	HAW.	5-0480(C)	1965	4	31


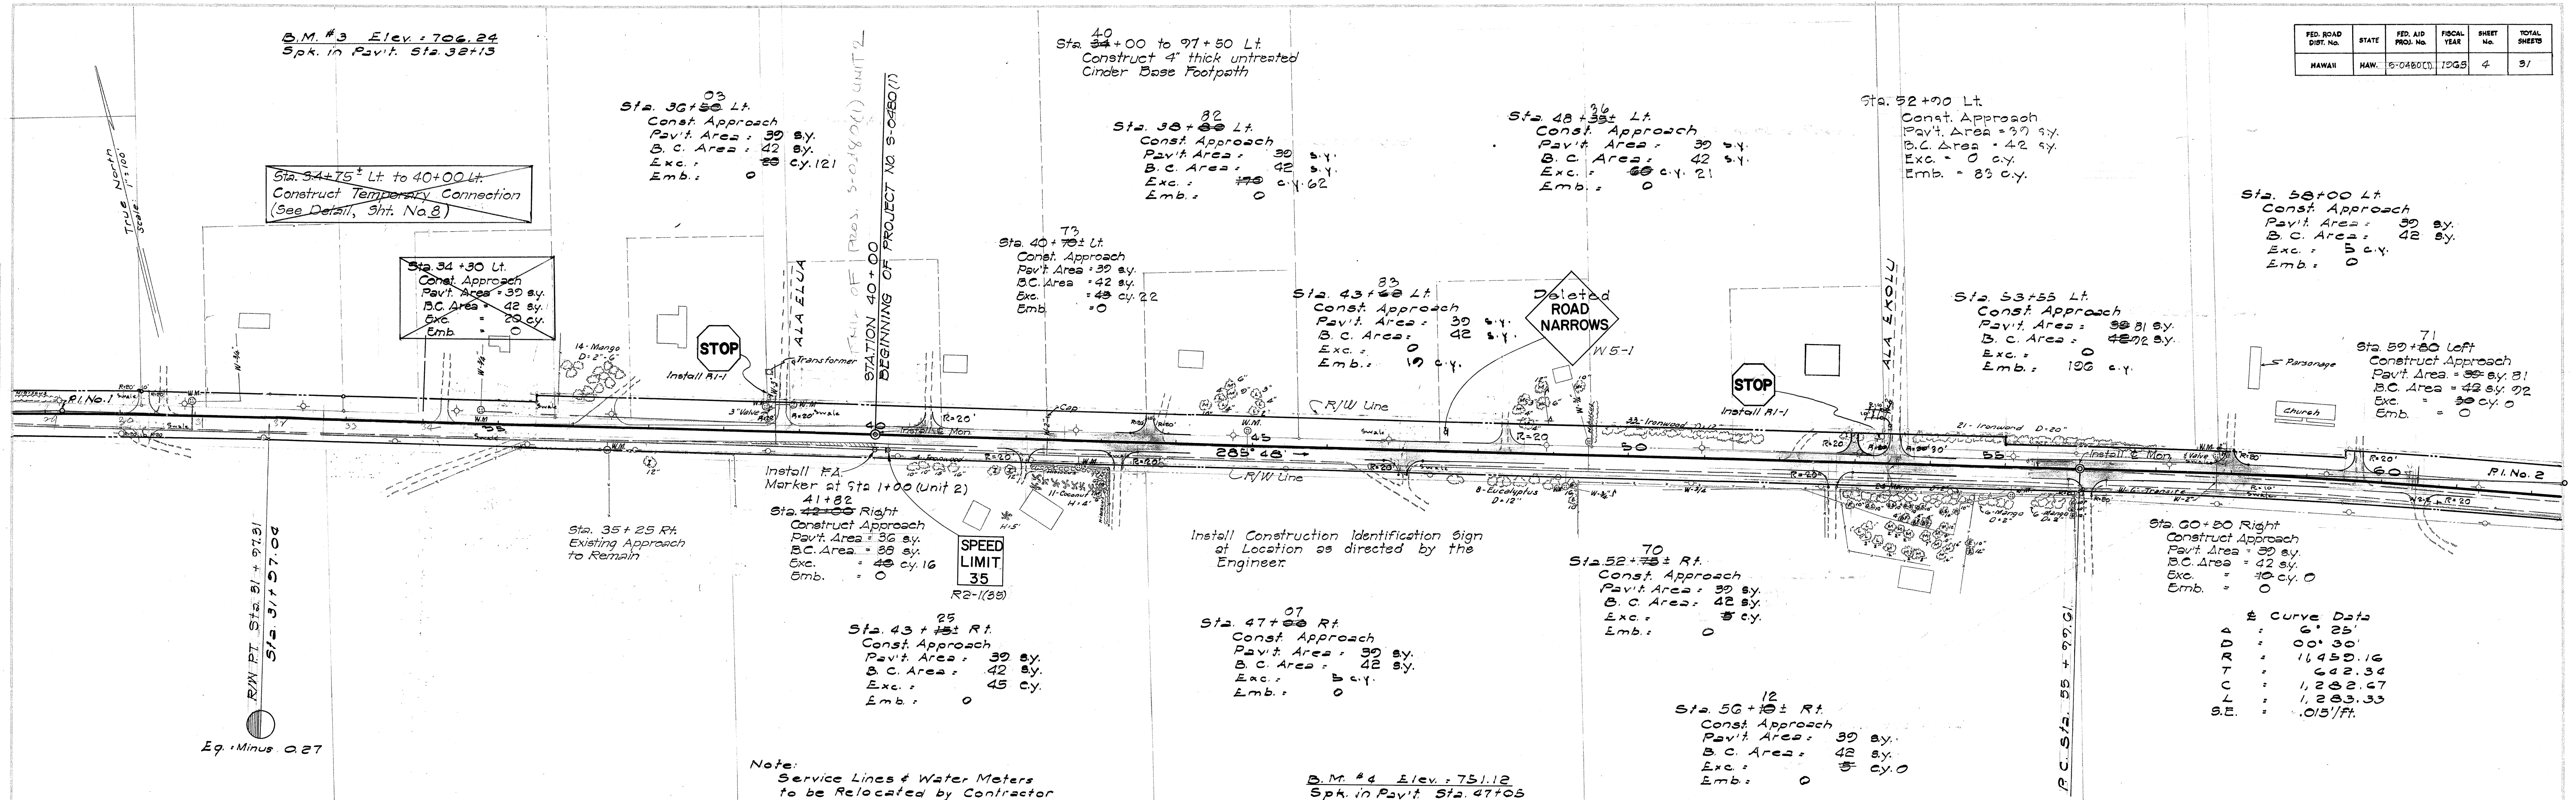


GENERAL NOTES-

- Roadway Azimuths referred to Middle Hill.
- B.M.'s are referred to mean sea level.
- Install & Monuments along & of Rdwy. and as staked out by the Engineer.
- Electrical and Telephone Utilities will be relocated by respective owners.
- All Exposed Water Pipes crossing roadway section shall be buried. Final Location for crossing roadway shall be as directed by the Engineer. Contractor to verify in field all Existing Water Pipe sizes and their location.
- All existing cesspools within the R/W shall be backfilled with suitable material. Payment to be incidental to roadway excavation.
- Two (2) Construction Identification Signs required.
- All existing pavement within the R/W between Sta. 40+00 & 128+80 shall be scarified to a depth of six (6) inches. Payment to be incidental to roadway excavation.
- All driveway locations are approximate. Exact locations to be determined by the Engineer in the field.
- All existing signs and markers that are not to be incorporated in the completed highway, shall be removed and stockpiled by the Contractor as directed by the Engineer. (Payment shall be incidental to the various items of the contract).

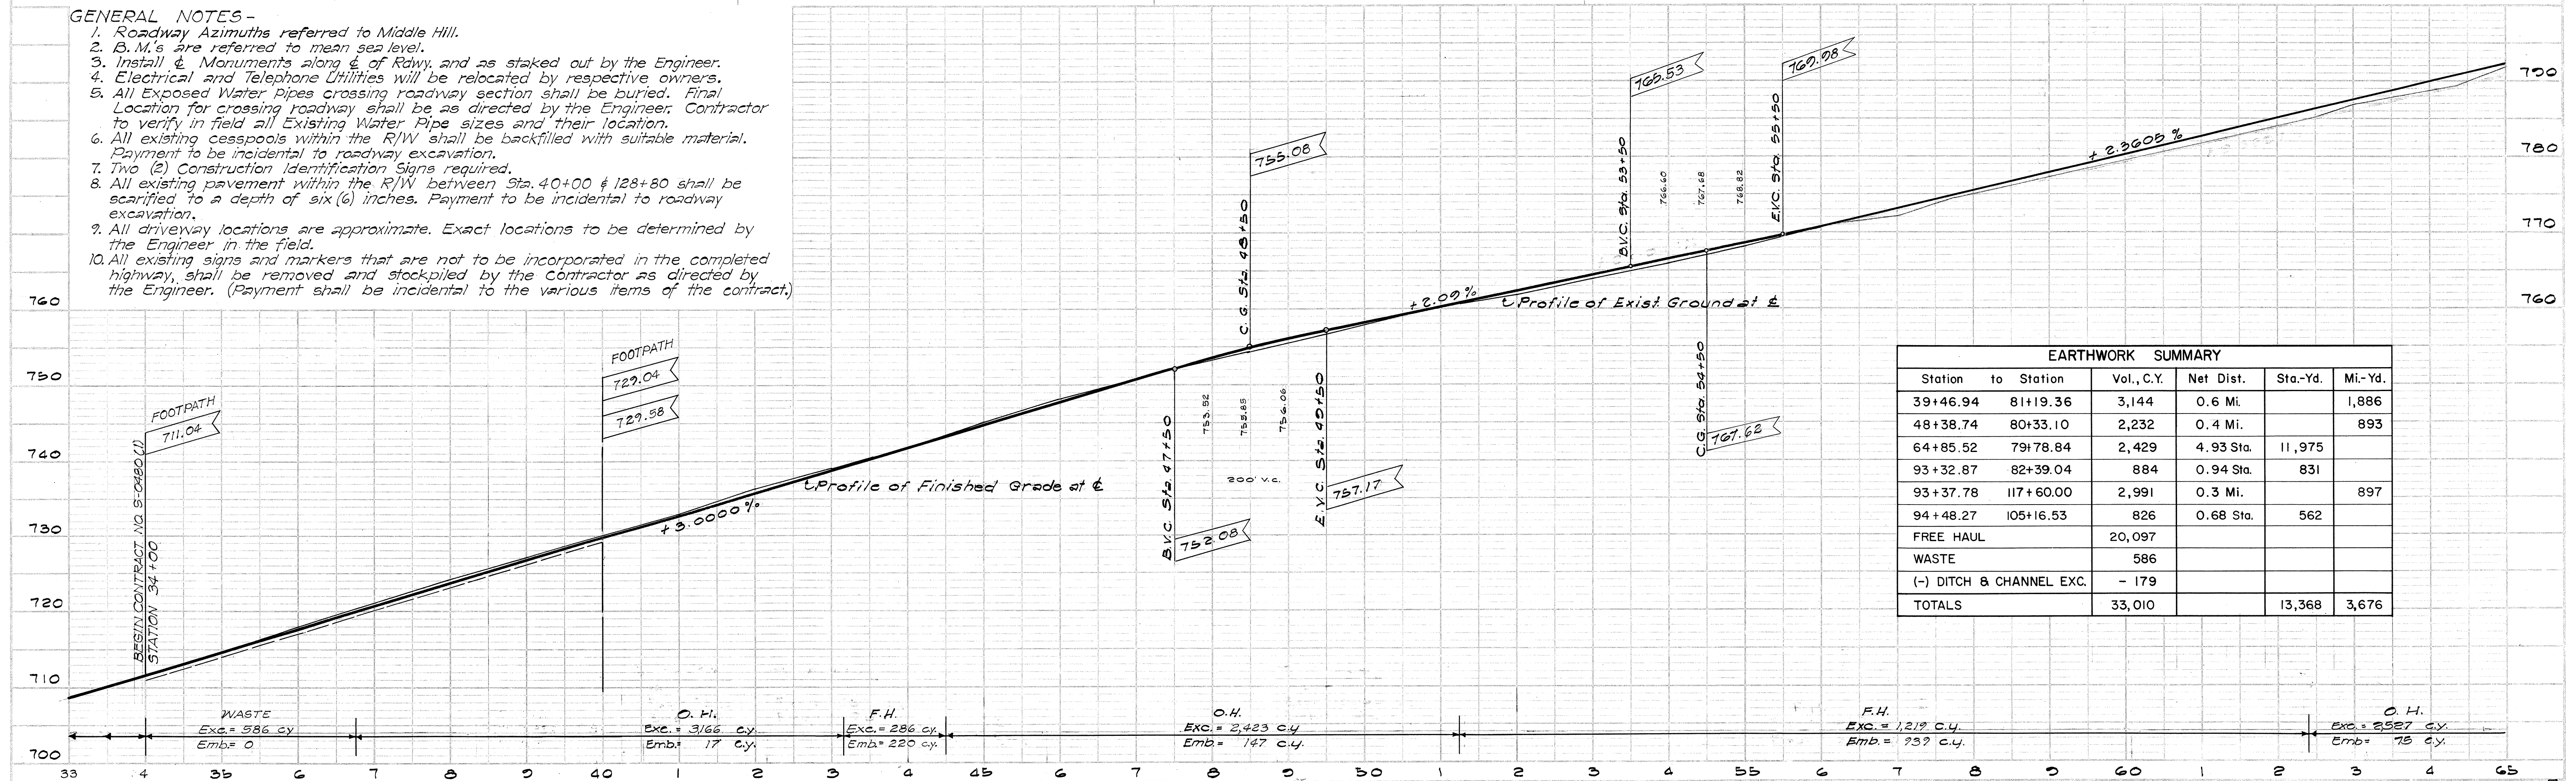

FED. ROAD DIST. NO.	STATE	FED. AID PROJ. NO.	FISCAL YEAR	SHEET NO.	TOTAL SHEETS
HAWAII	HAW.	9-0480(1)	1963	5	31

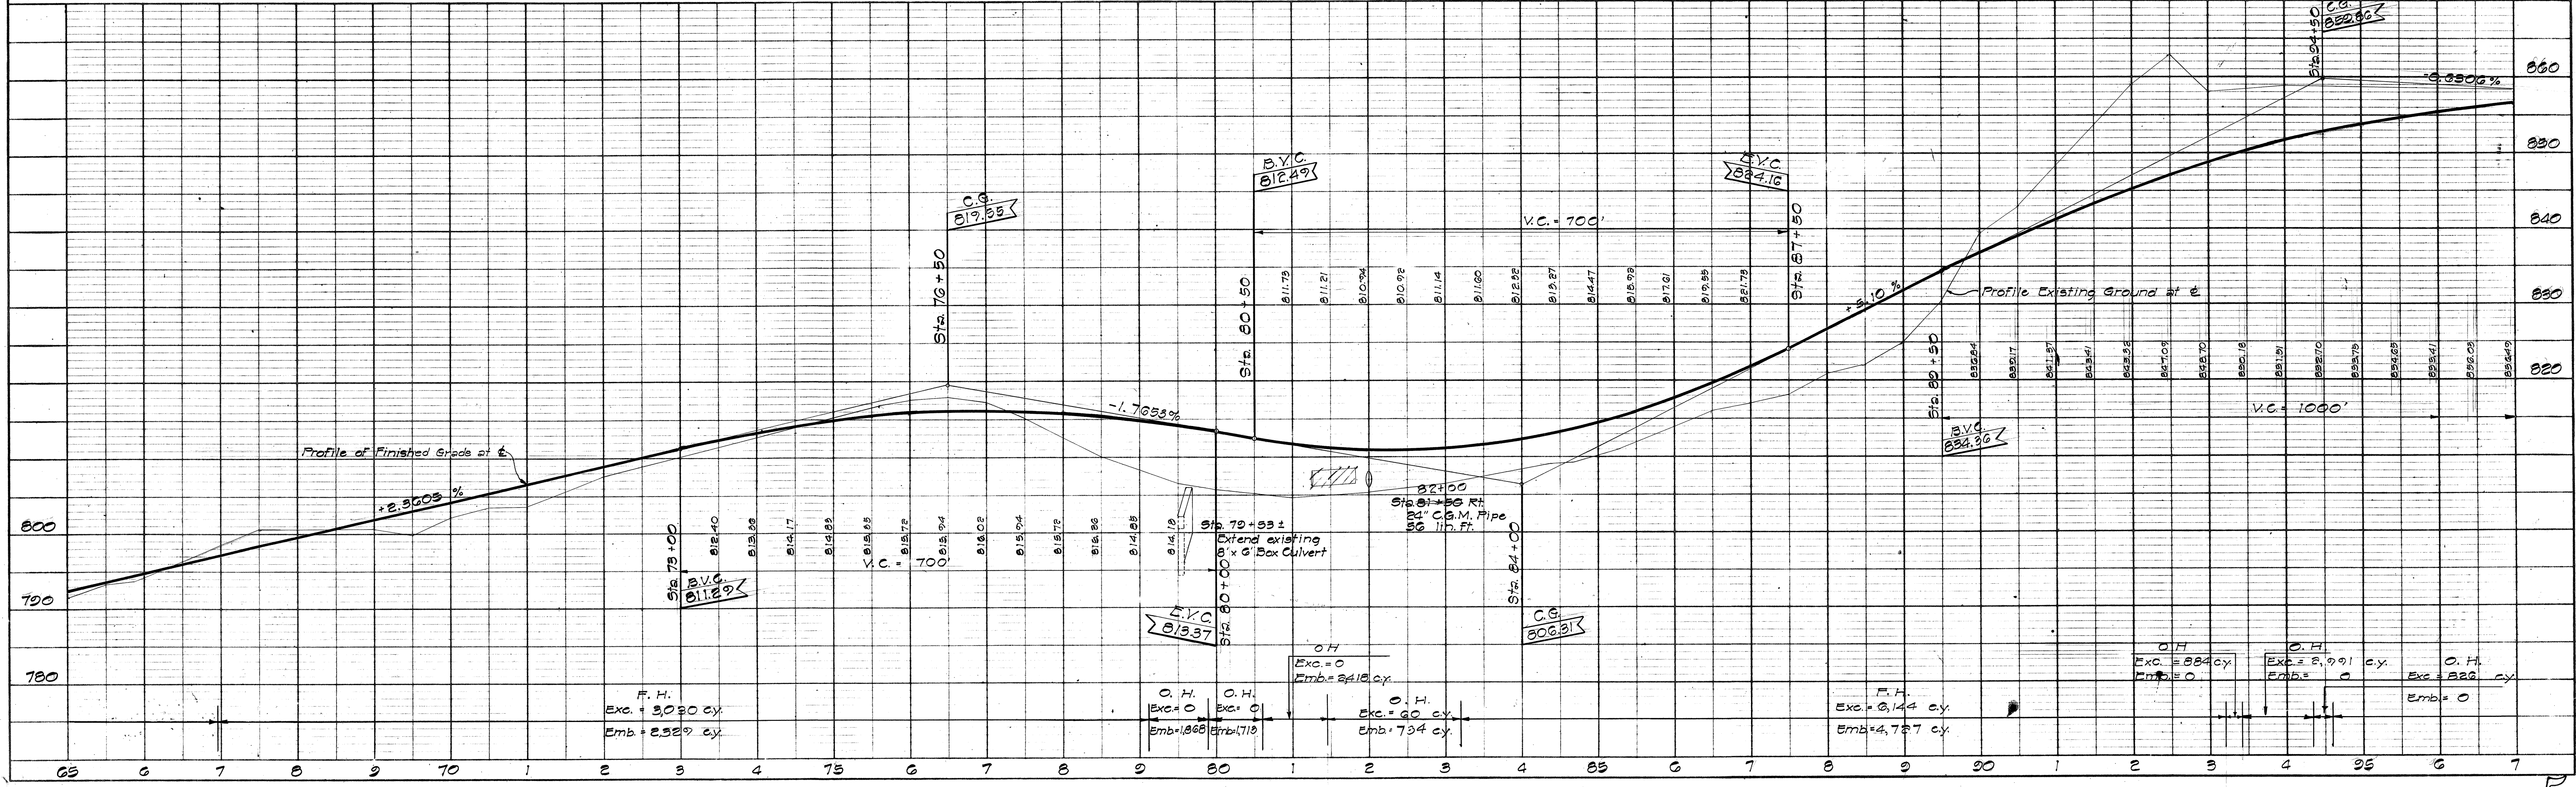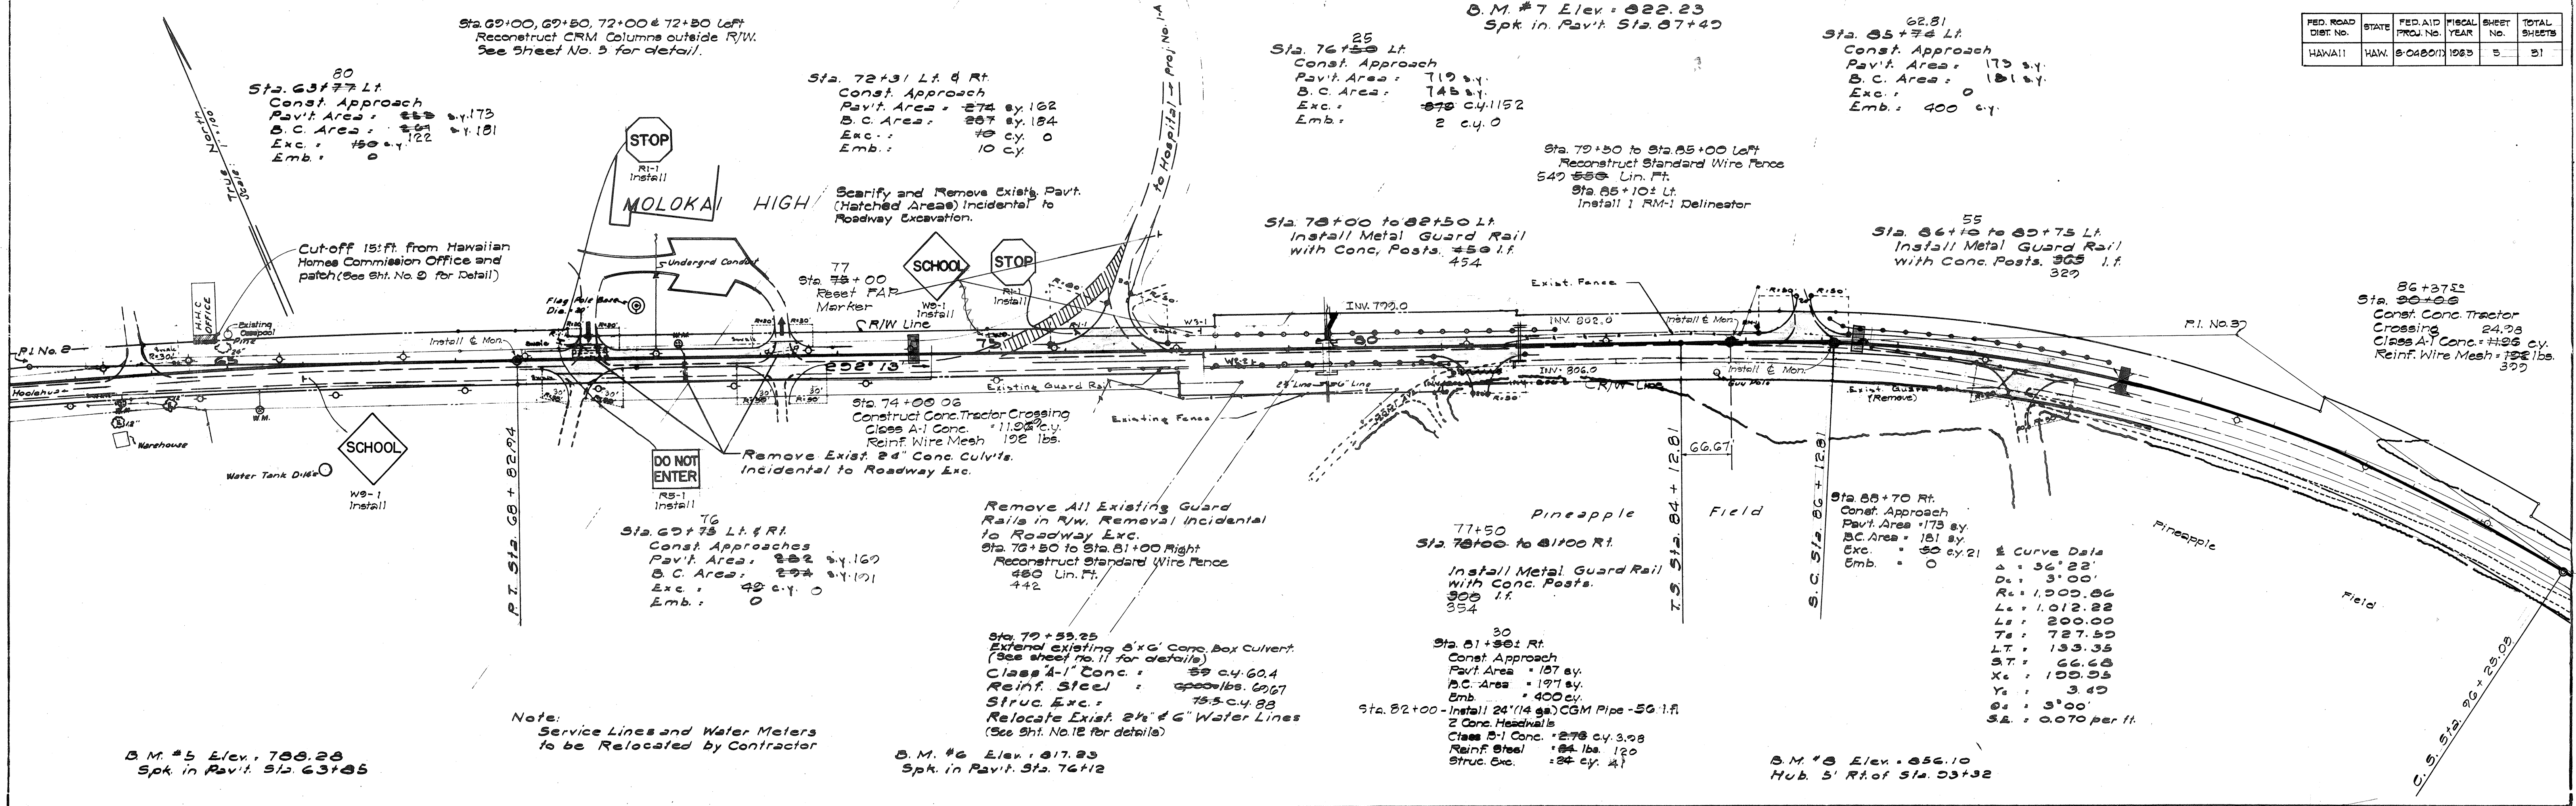

FED. ROAD DIST. No.	STATE	FED. AID PROJ. No.	FISCAL YEAR	SHEET No.	TOTAL SHEETS
HAWAII	HAW.	50480(1)	1965	6	31

