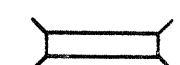
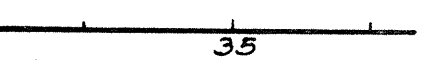
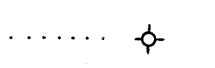
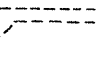
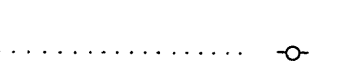
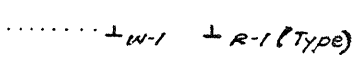
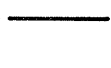


INDEX TO DRAWINGS	
SHEET NO.	DESCRIPTION
1	TITLE SHEET
2 - 3	TYPICAL SECTION
4 - 6	PLAN & PROFILE
7	BORROW PIT PLAN
8	APPROACH DETAILS
9	ALTERATION TO H.H.C. BLDG.
10	SEWER SYSTEM
11 - 15	CULVERT DETAILS
16 - 20	STANDARD DETAILS
21 - 31, 31A	CROSS SECTIONS

CONVENTIONAL SIGNS USED	
Bridge	
Centerline	
Centerline Monument	
Circular Pipe Culvert	
Electric Pole	
Existing Road	
Fences	
Telephone Pole	
Warning & Regulatory Signs	
Boundary Line	

STATE OF HAWAII

DEPARTMENT OF TRANSPORTATION

HIGHWAYS DIVISION

HONOLULU, HAWAII

"AS BUILT"

PLANS OF

A PORTION OF

FARRINGTON AVENUE


FEDERAL AID PROJECT NO. S-0480 (I)

DISTRICT OF MOLOKAI

COUNTY OF MAUI

ISLAND OF MOLOKAI


SCALES	
PLAN	1 IN. = 100 FT.
PROFILE	HOR. 1 IN. = 100 FT.
	VER. 1 IN. = 10 FT.
CROSS SECTION	HOR. 1 IN. = 10 FT.
	VER. 1 IN. = 10 FT.

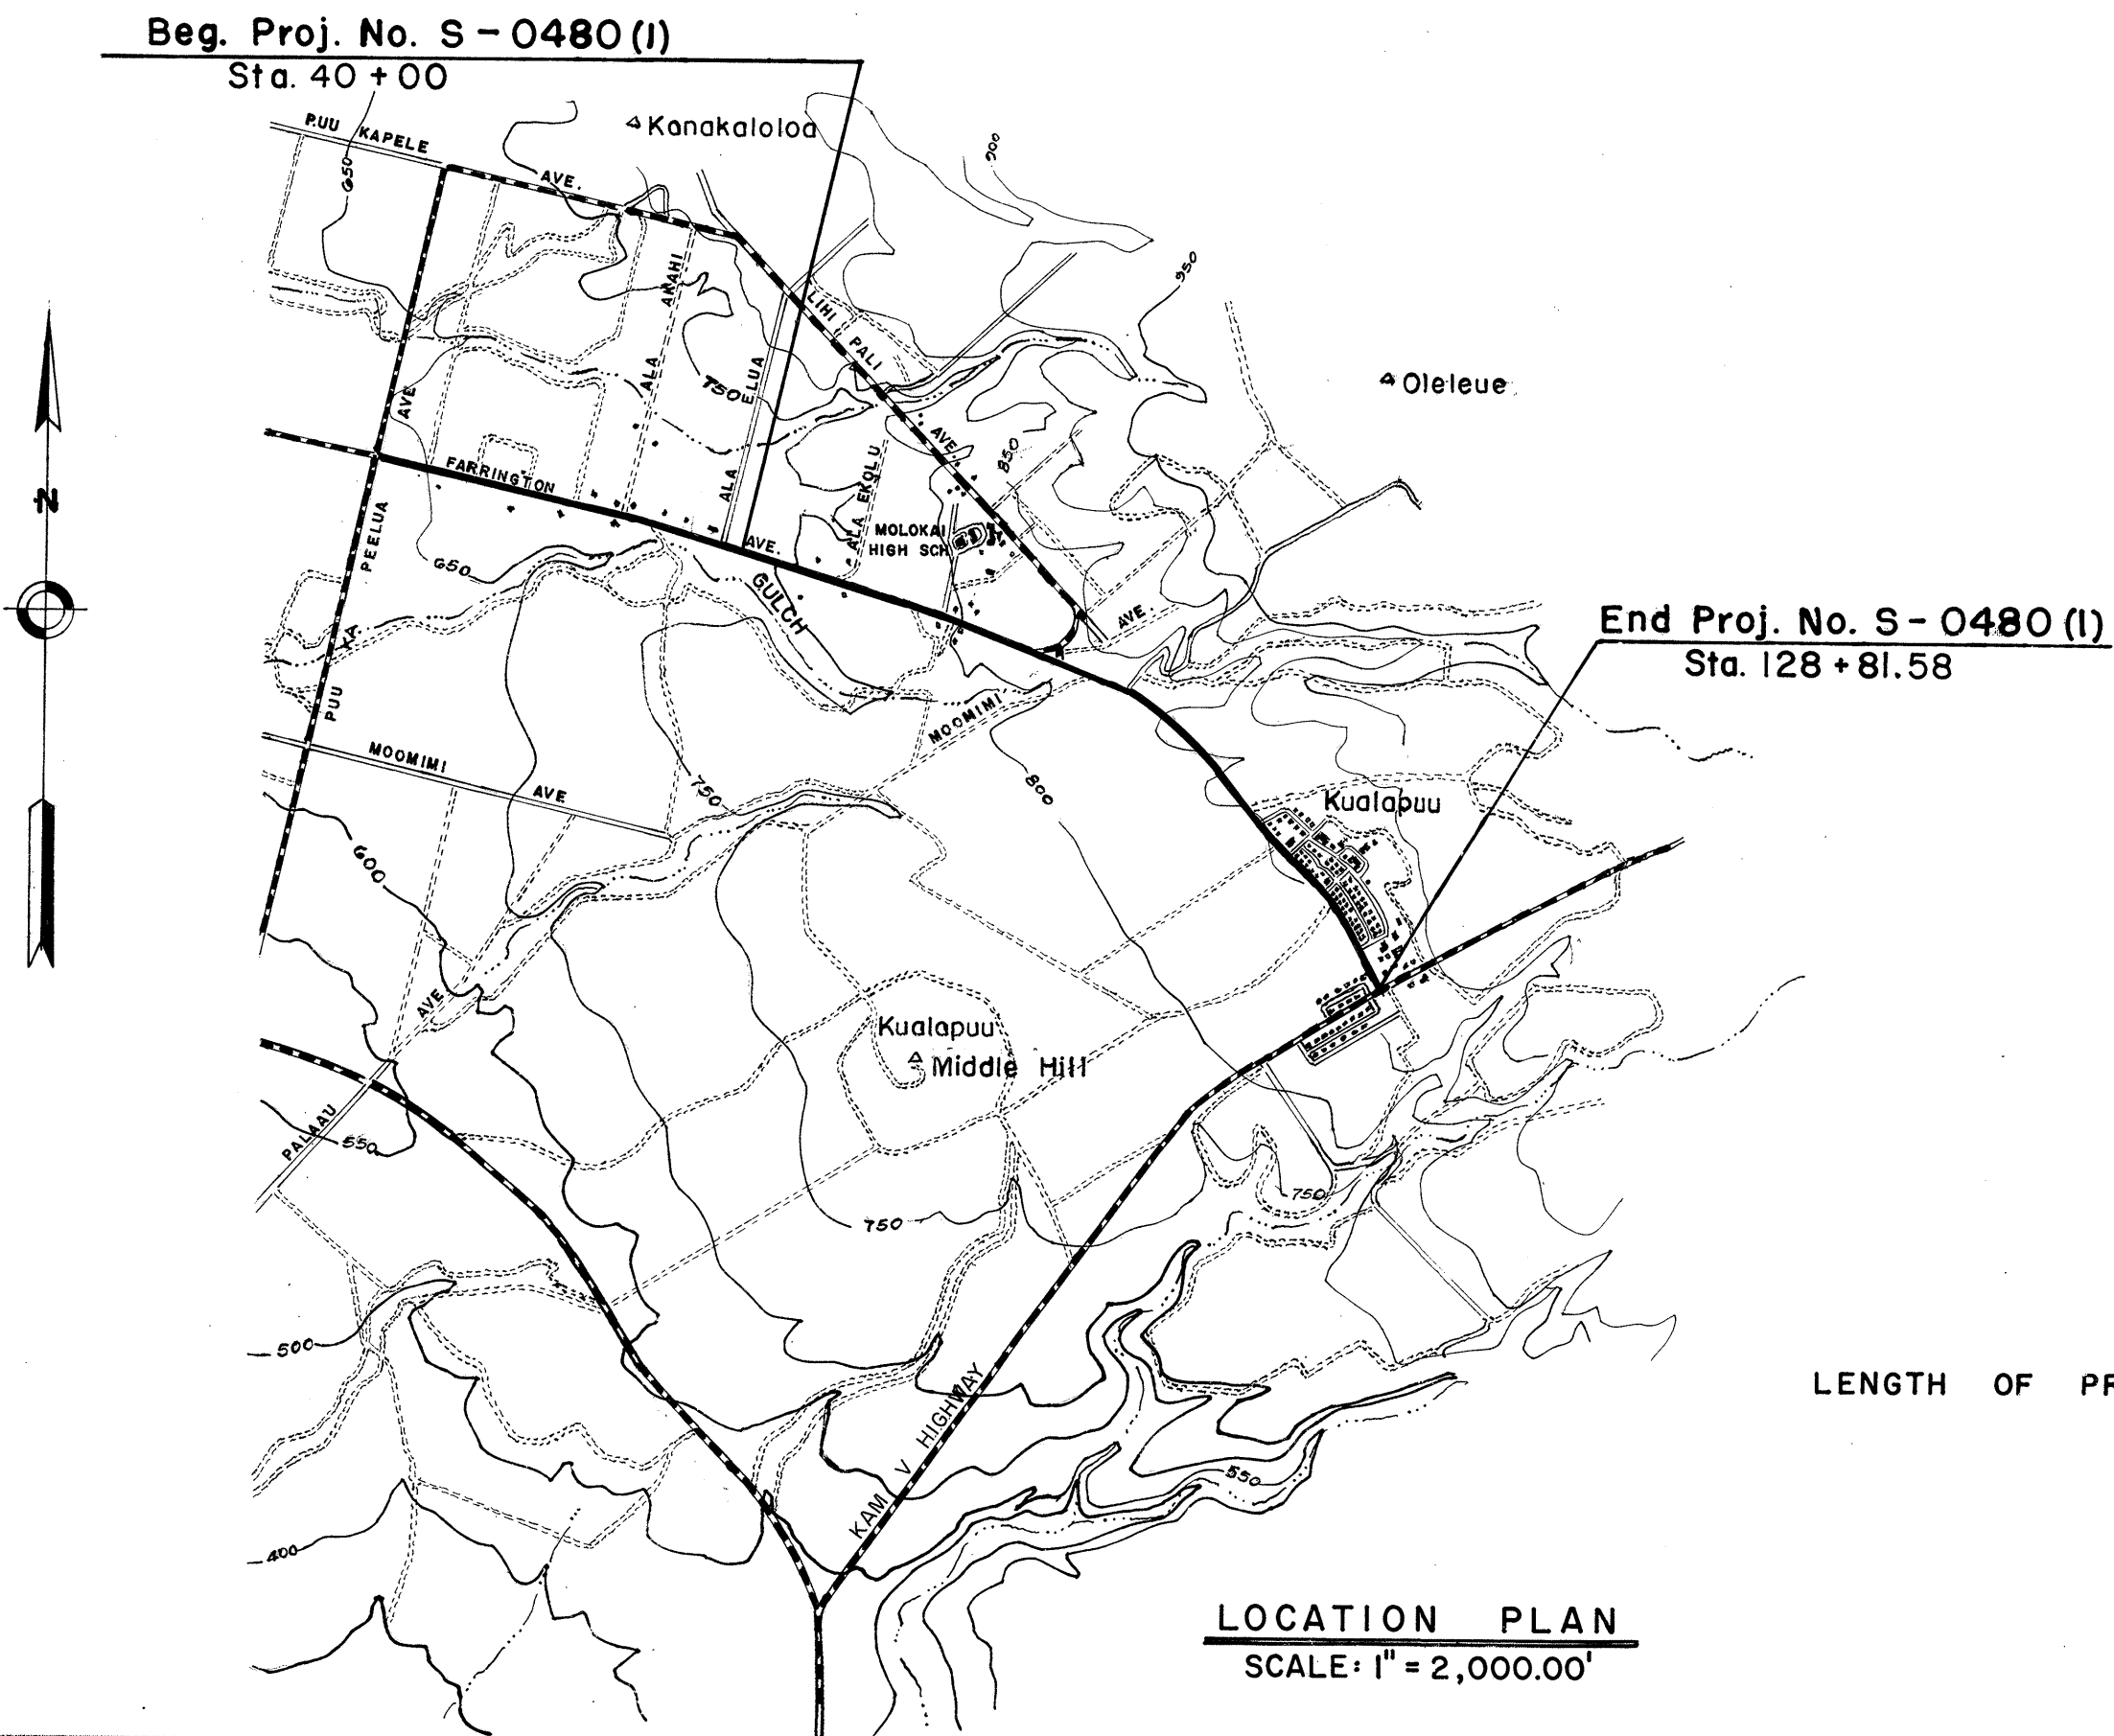

LENGTH OF PROJECT = 1.682 Miles

LOCATION PLAN

SCALE: 1" = 2,000.00'

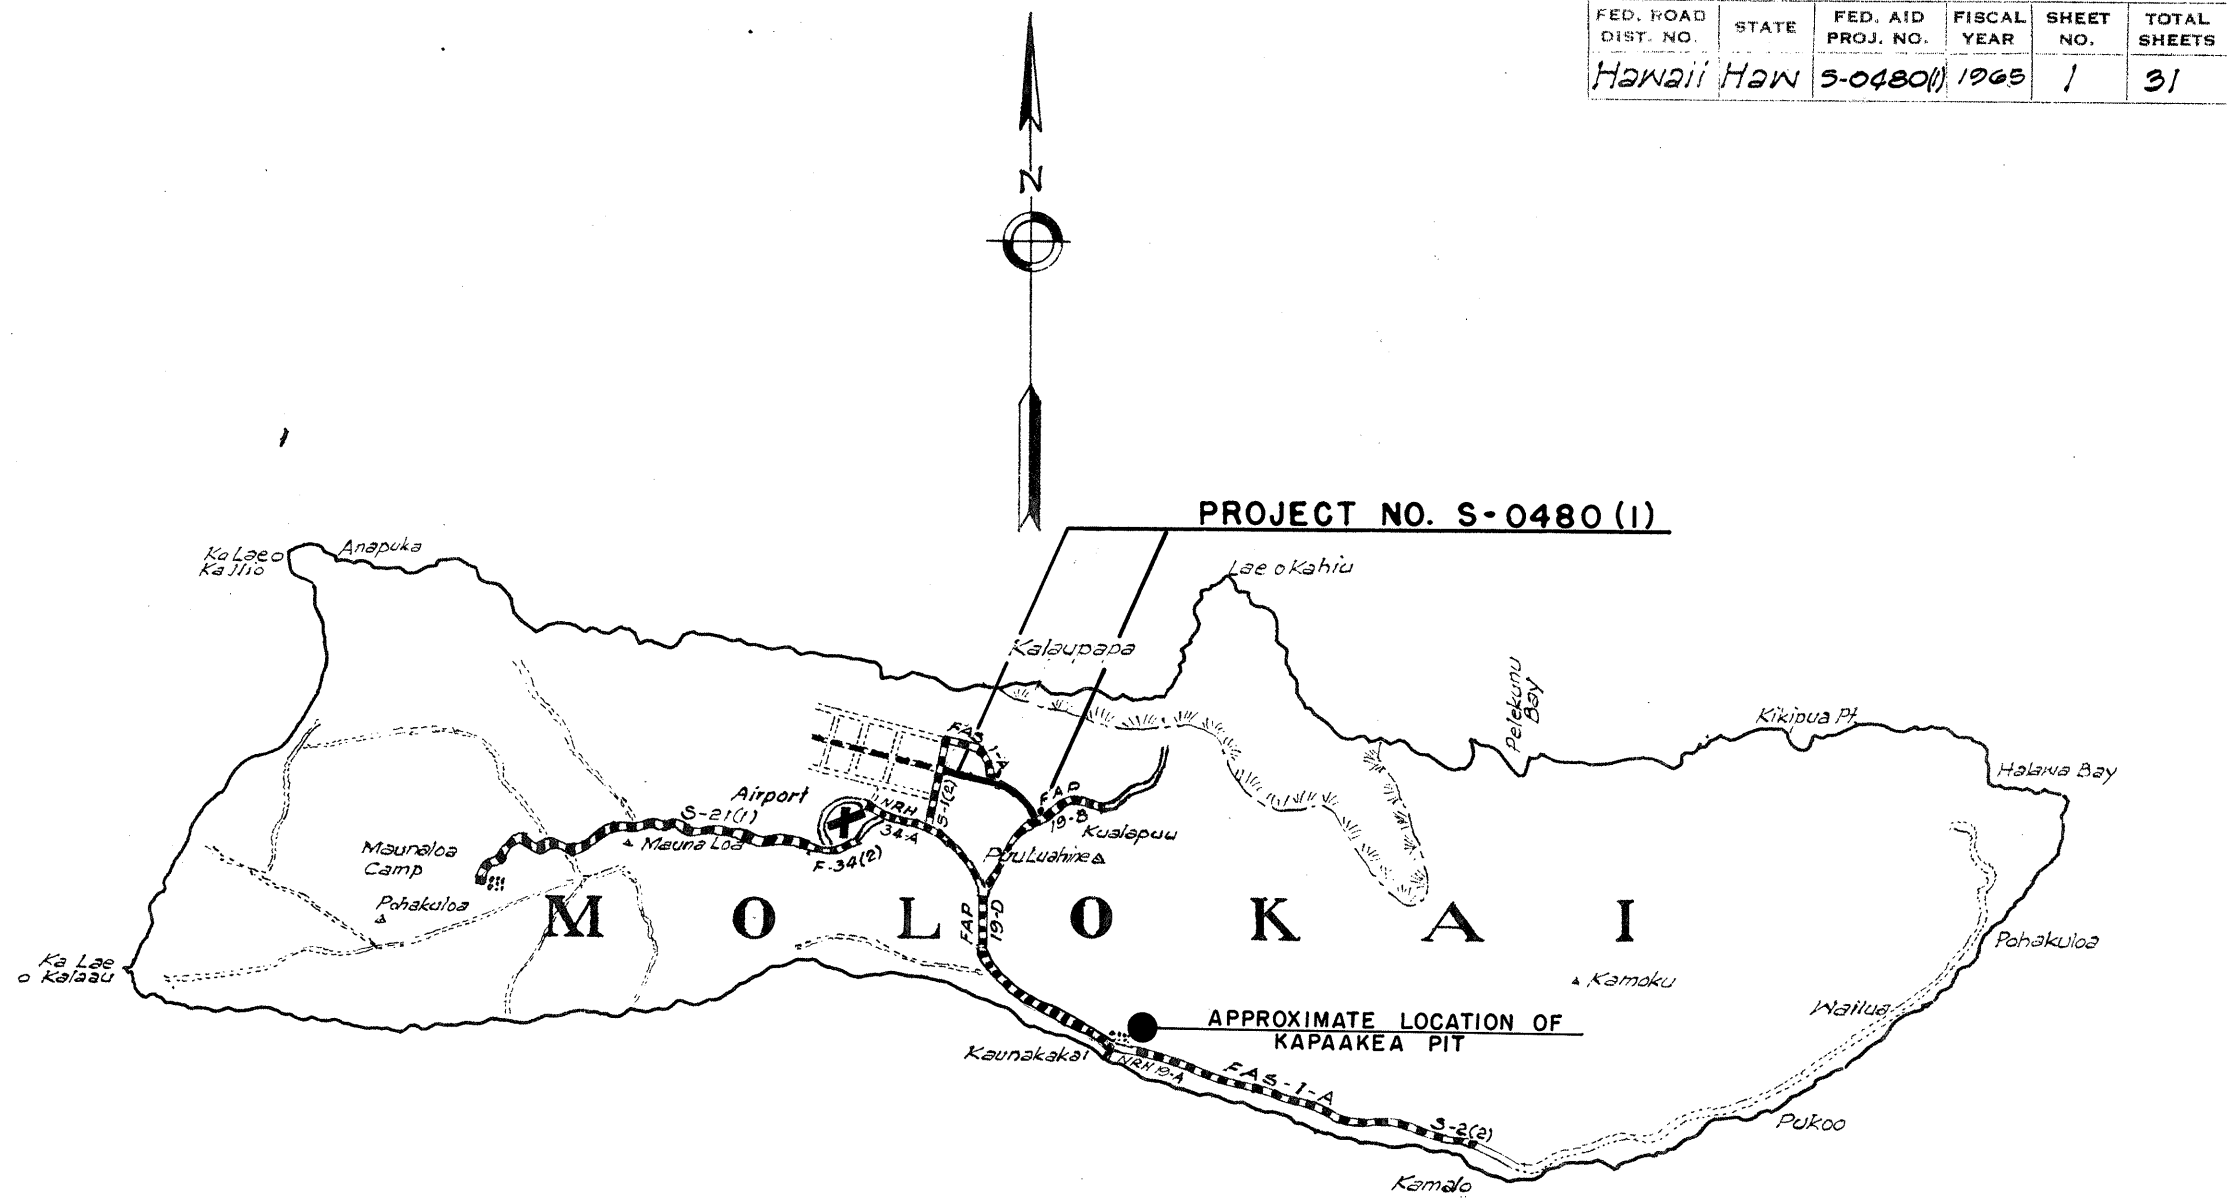

LOCATION MAP

FEDERAL AID PROJECTS PREVIOUSLY CONSTRUCTED OR UNDER CONSTRUCTION

DESIGN CLASSIFICATION

ADT	1962 = 750
ADT	1982 = 1240
DHV	12 %
D	60/40
T	20 %
V	60 M.P.H.

NOTE:

ALL CHANGES MADE DURING CONSTRUCTION

HAVE BEEN NOTED IN RED ON THESE

SHEETS AND CHECKED BY:

Patrick M. Muelken

PROJECT ENGINEER

May 12, 1967

DATE

APPROVED: *[Signature]* DATE *11 Jan 68*

DIRECTOR: DEPARTMENT OF TRANSPORTATION

DEPARTMENT OF COMMERCE

BUREAU OF PUBLIC ROADS

APPROVED: *[Signature]*

DIVISION ENGINEER DATE