

FINAL SURVEY	SURVEYED	DATE
NO.	BY	

ORIGINAL SURVEY	SURVEYED	DATE
NO.	BY	

Exc = 50
Emb = 97

Exc = 60
Emb = 107

Exc = 57
Emb = 97

Exc = 62
Emb = 65

Exc = 65
Emb = 46

Exc = 50
Emb = 27

Exc = 47
Emb = 15

Exc = 26
Emb = 4

Exc = 43
Emb = 8

Exc = 26
Emb = 10

Exc = 25
Emb = 25

Exc = 32
Emb = 44

Exc = 34
Emb = 63

Exc = 41
Emb = 88

Exc = 44
Emb = 102

Exc = 139
Emb = 15

Exc = 164
Emb = 15

Exc = 131
Emb = 7

Exc = 138
Emb = 7

Exc = 133
Emb = 8

Exc = 88
Emb = 9

Exc = 63
Emb = 9

C = 95
F = 12

C = 82
F = 4

C = 60
F = 4

C = 80
F = 4

C = 55
F = 5

C = 40
F = 5


C = 28
F = 5

o - DENOTES APPROXIMATE LOCATION OF EXIST. 6" TRANSITE PIPE (TO REMAIN)

FINAL	SURVEY	DATE
SURVEY	PLOTTED	
NOTE BOOK	PLATE	
NO.	AREAS CHECKED	




ORIGINAL	SURVEY	DATE
SURVEY	PLOTTED	
NOTE BOOK	PLATE	
NO.	AREAS CHECKED	

FED. ROAD DIST. NO.	STATE	FED. AID PROJ. NO.	FISCAL YEAR	SHEET NO.	TOTAL SHEETS
HAWAII	HAW.	UNIT 2	1965	19	19

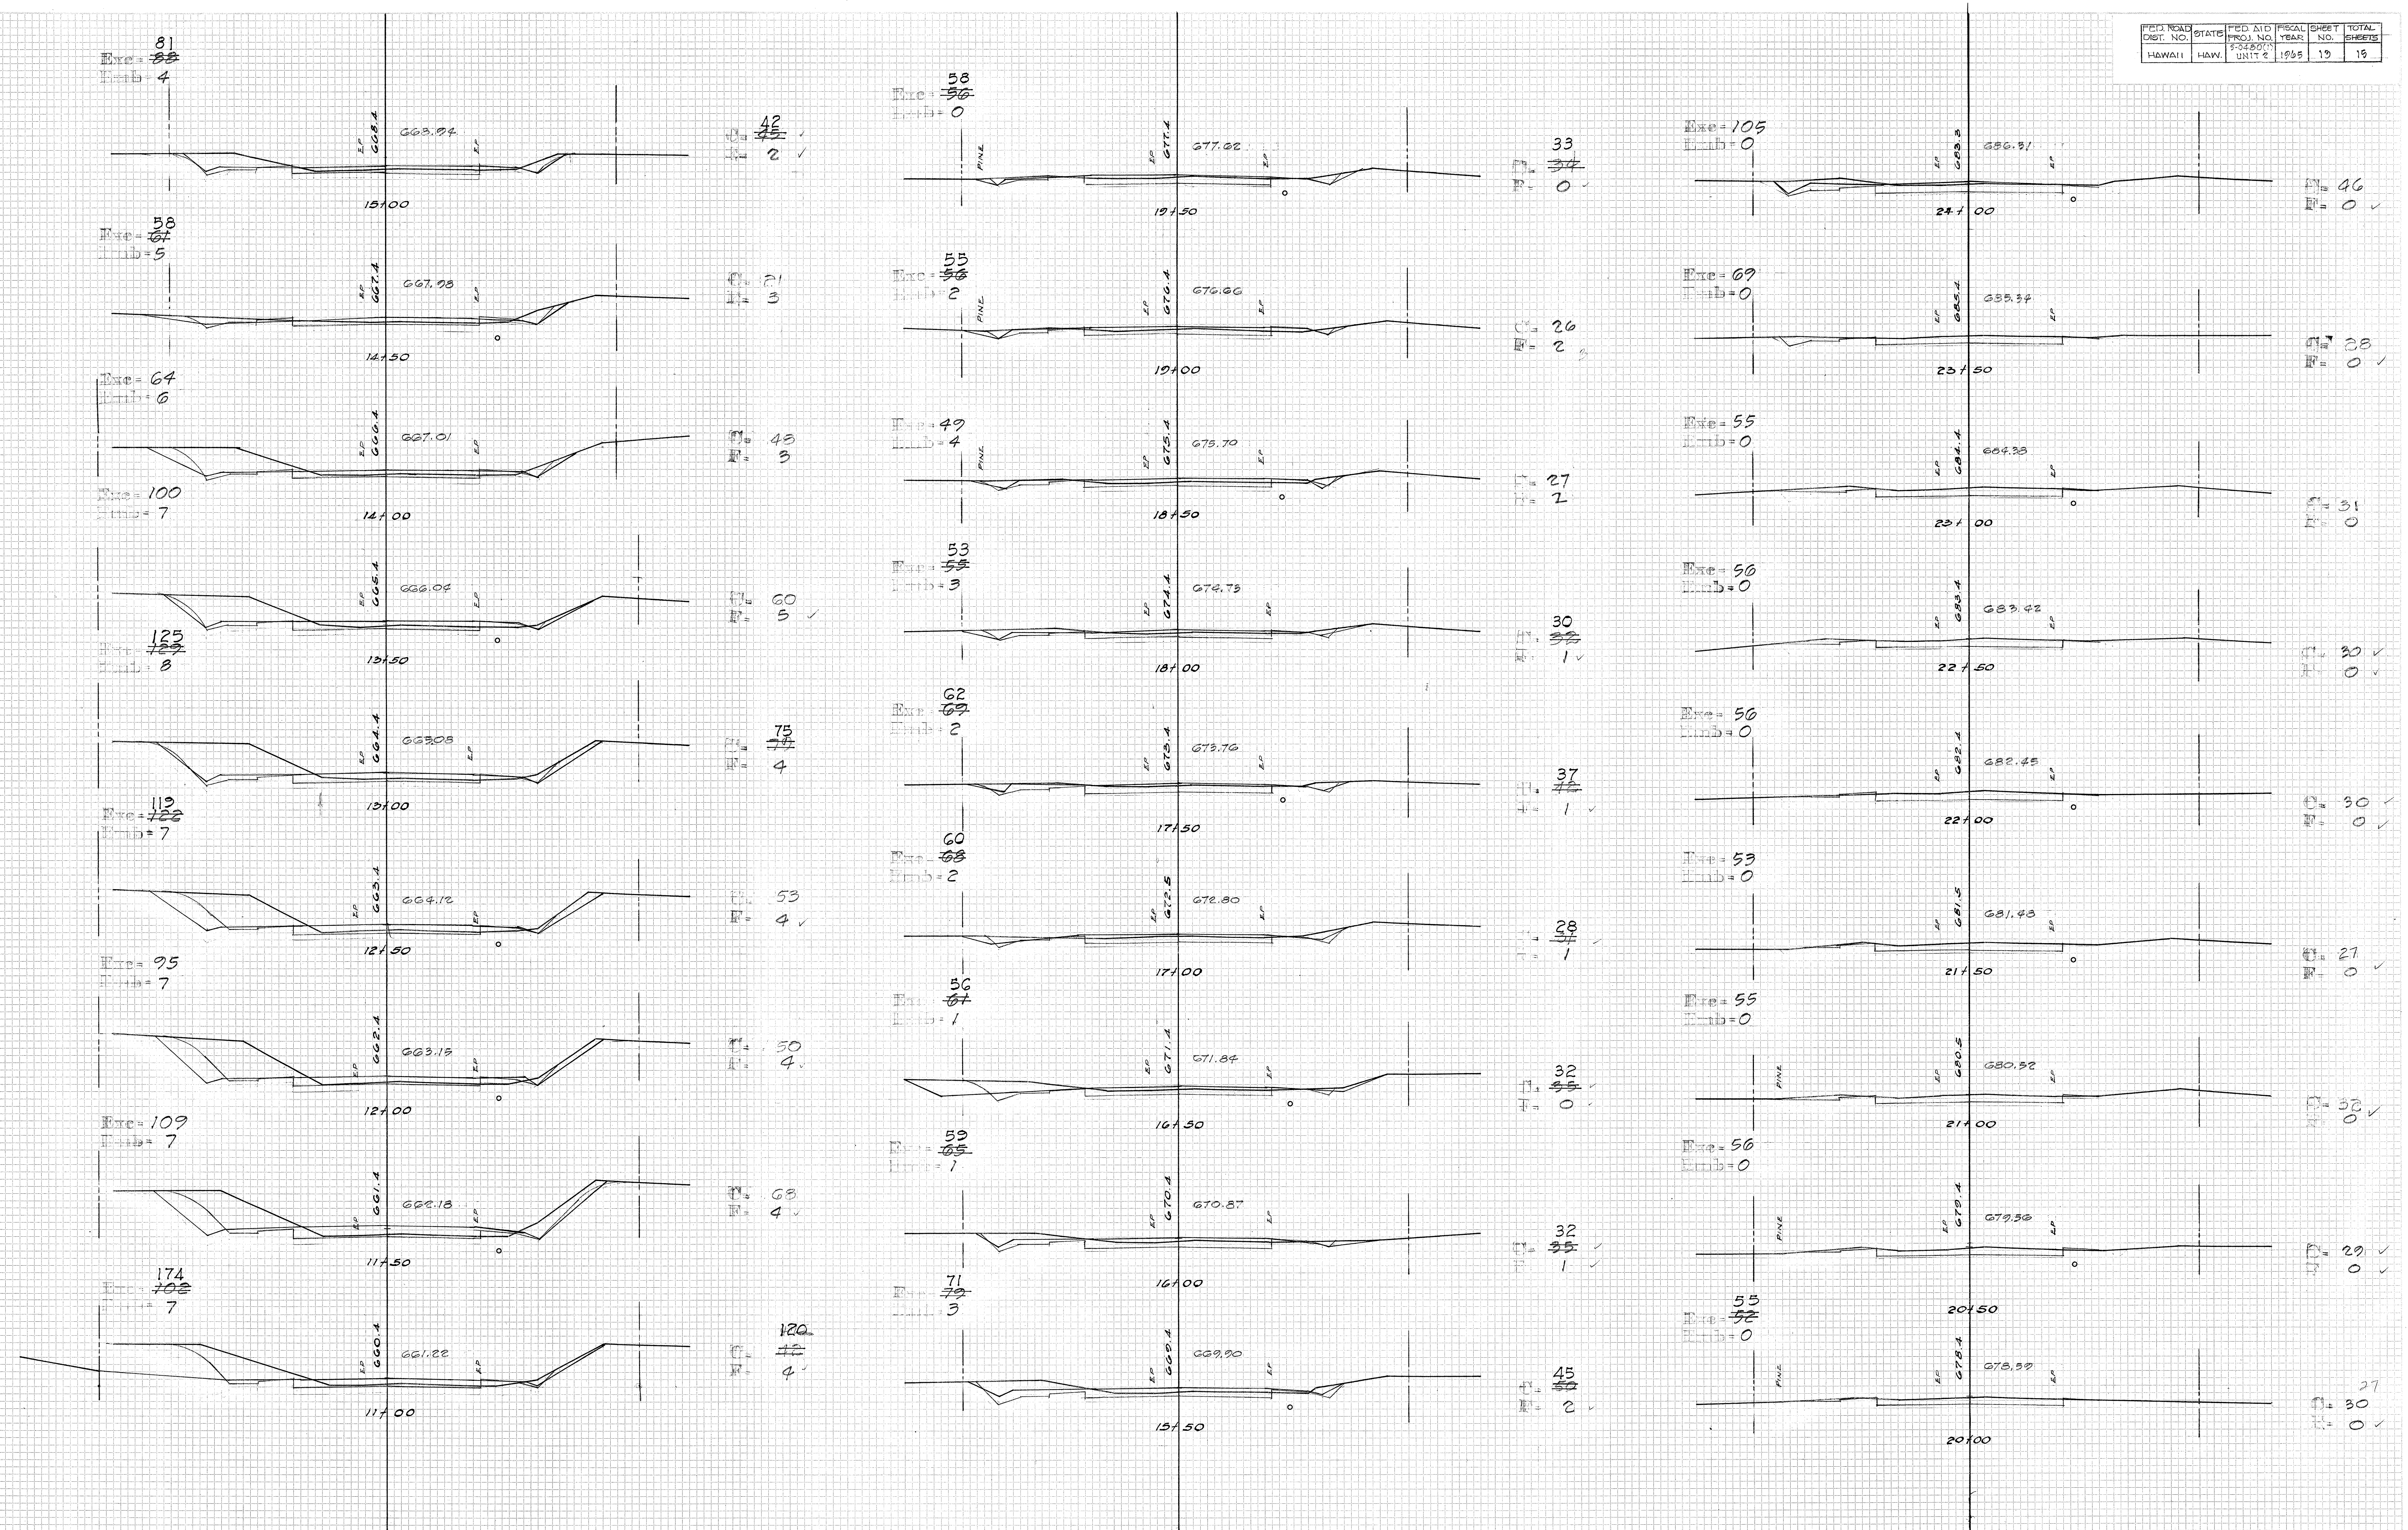


DATE	BY
DATE	BY
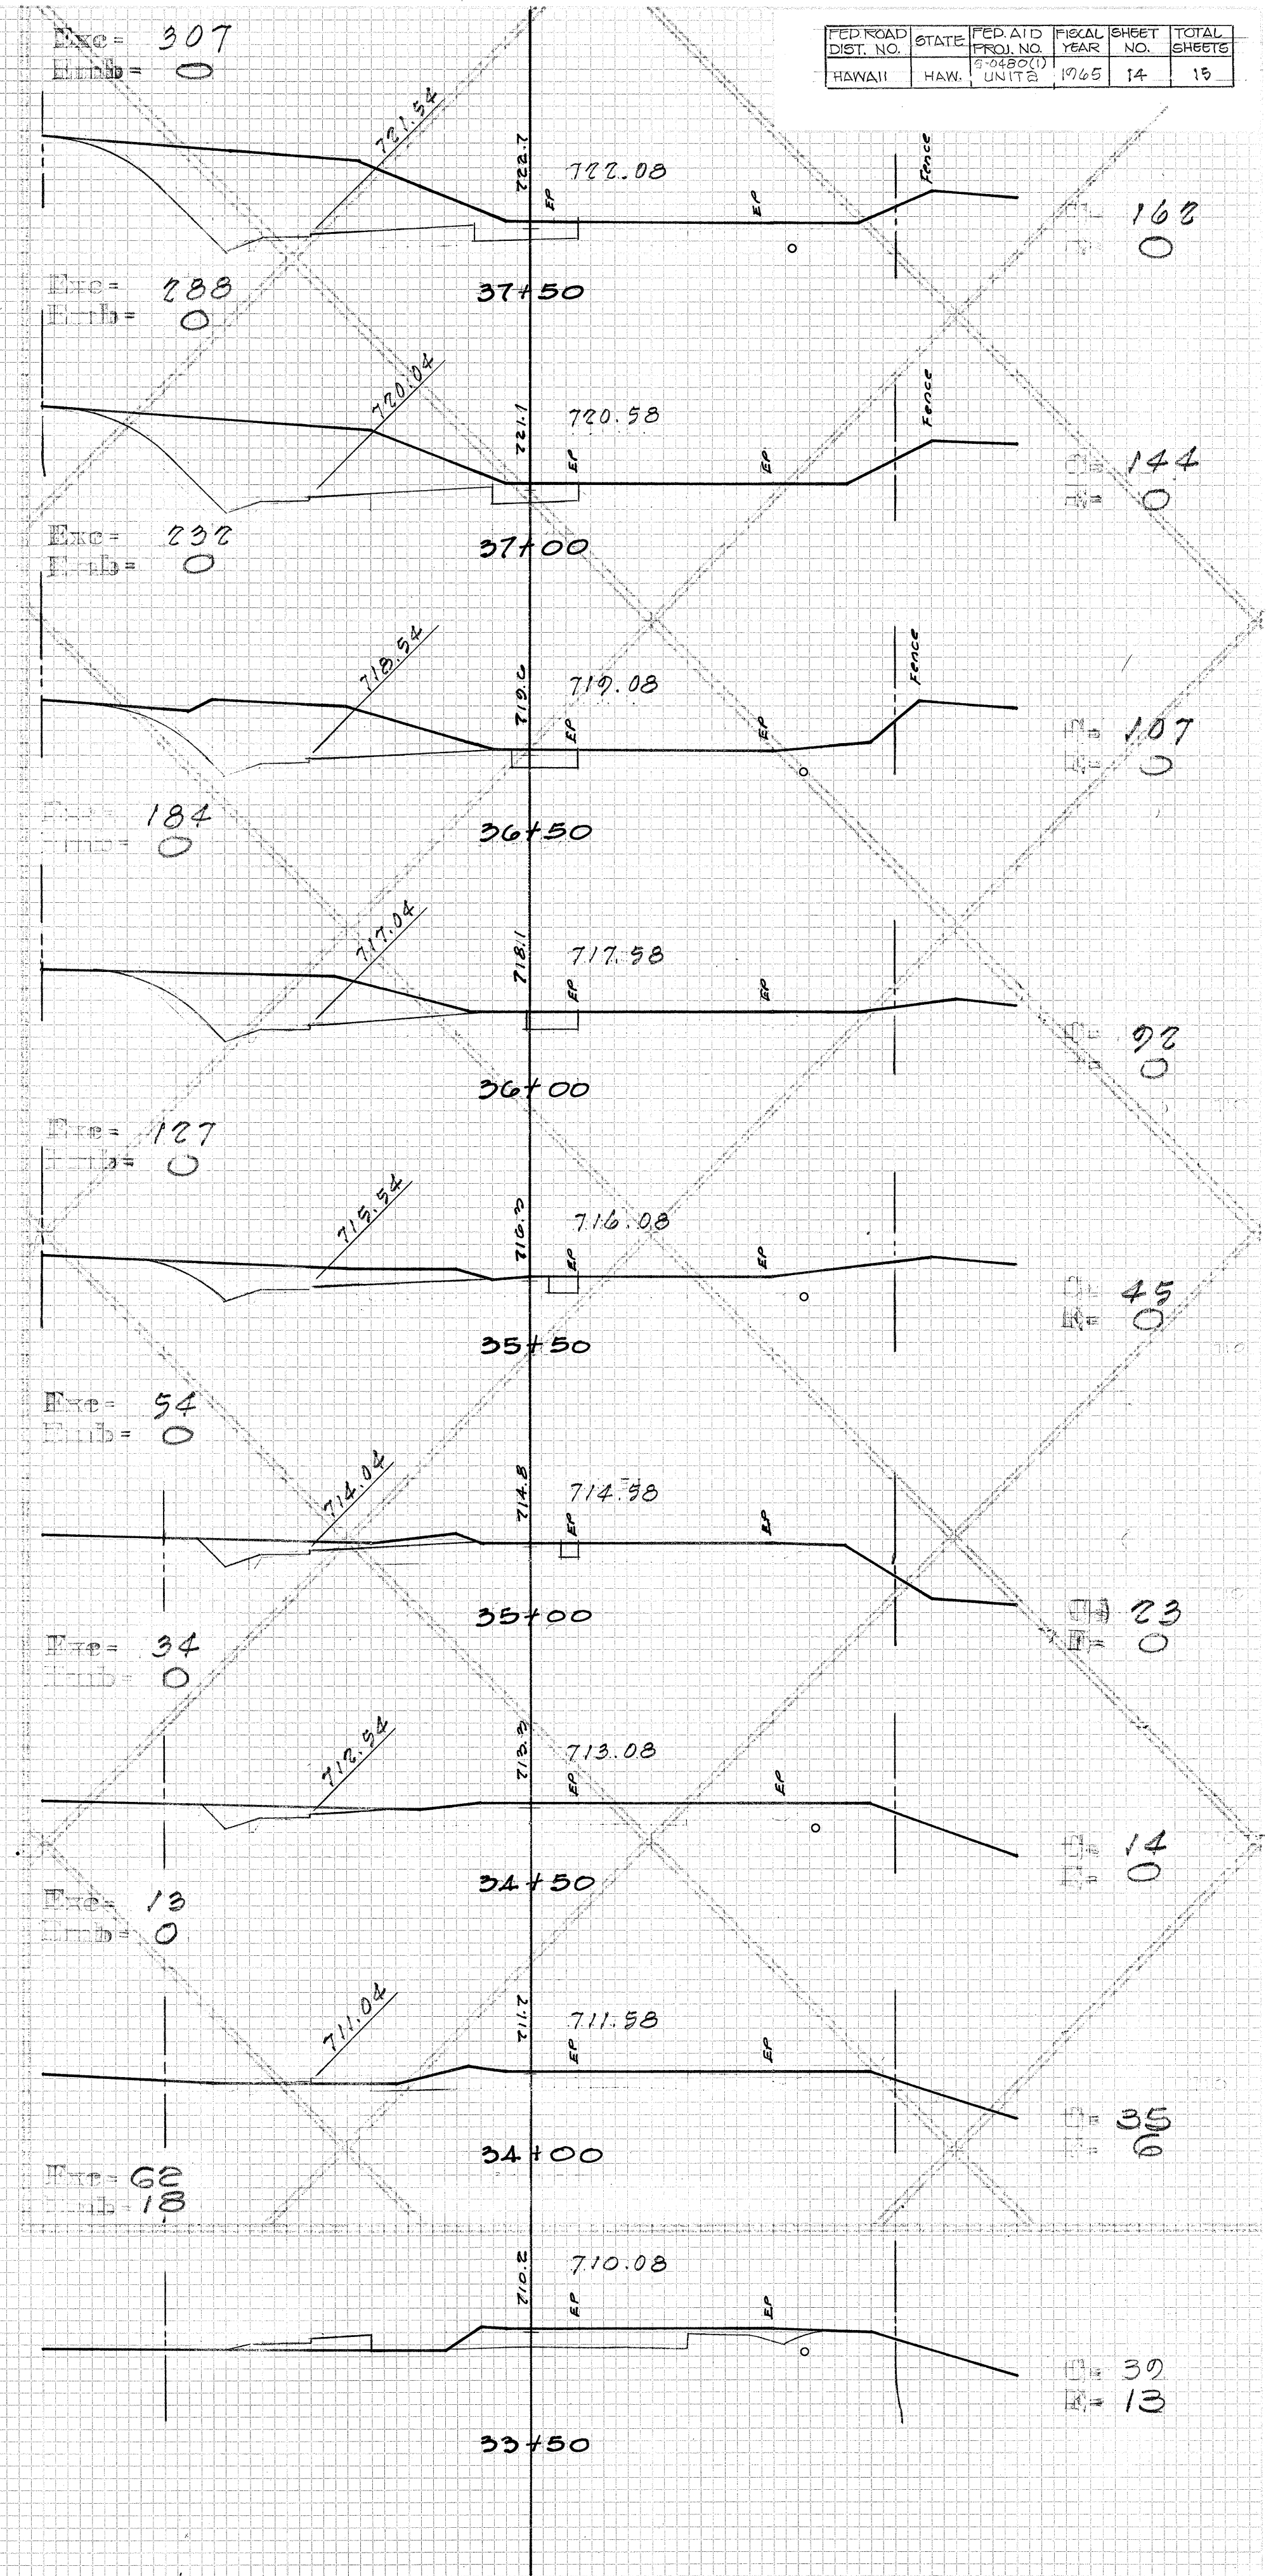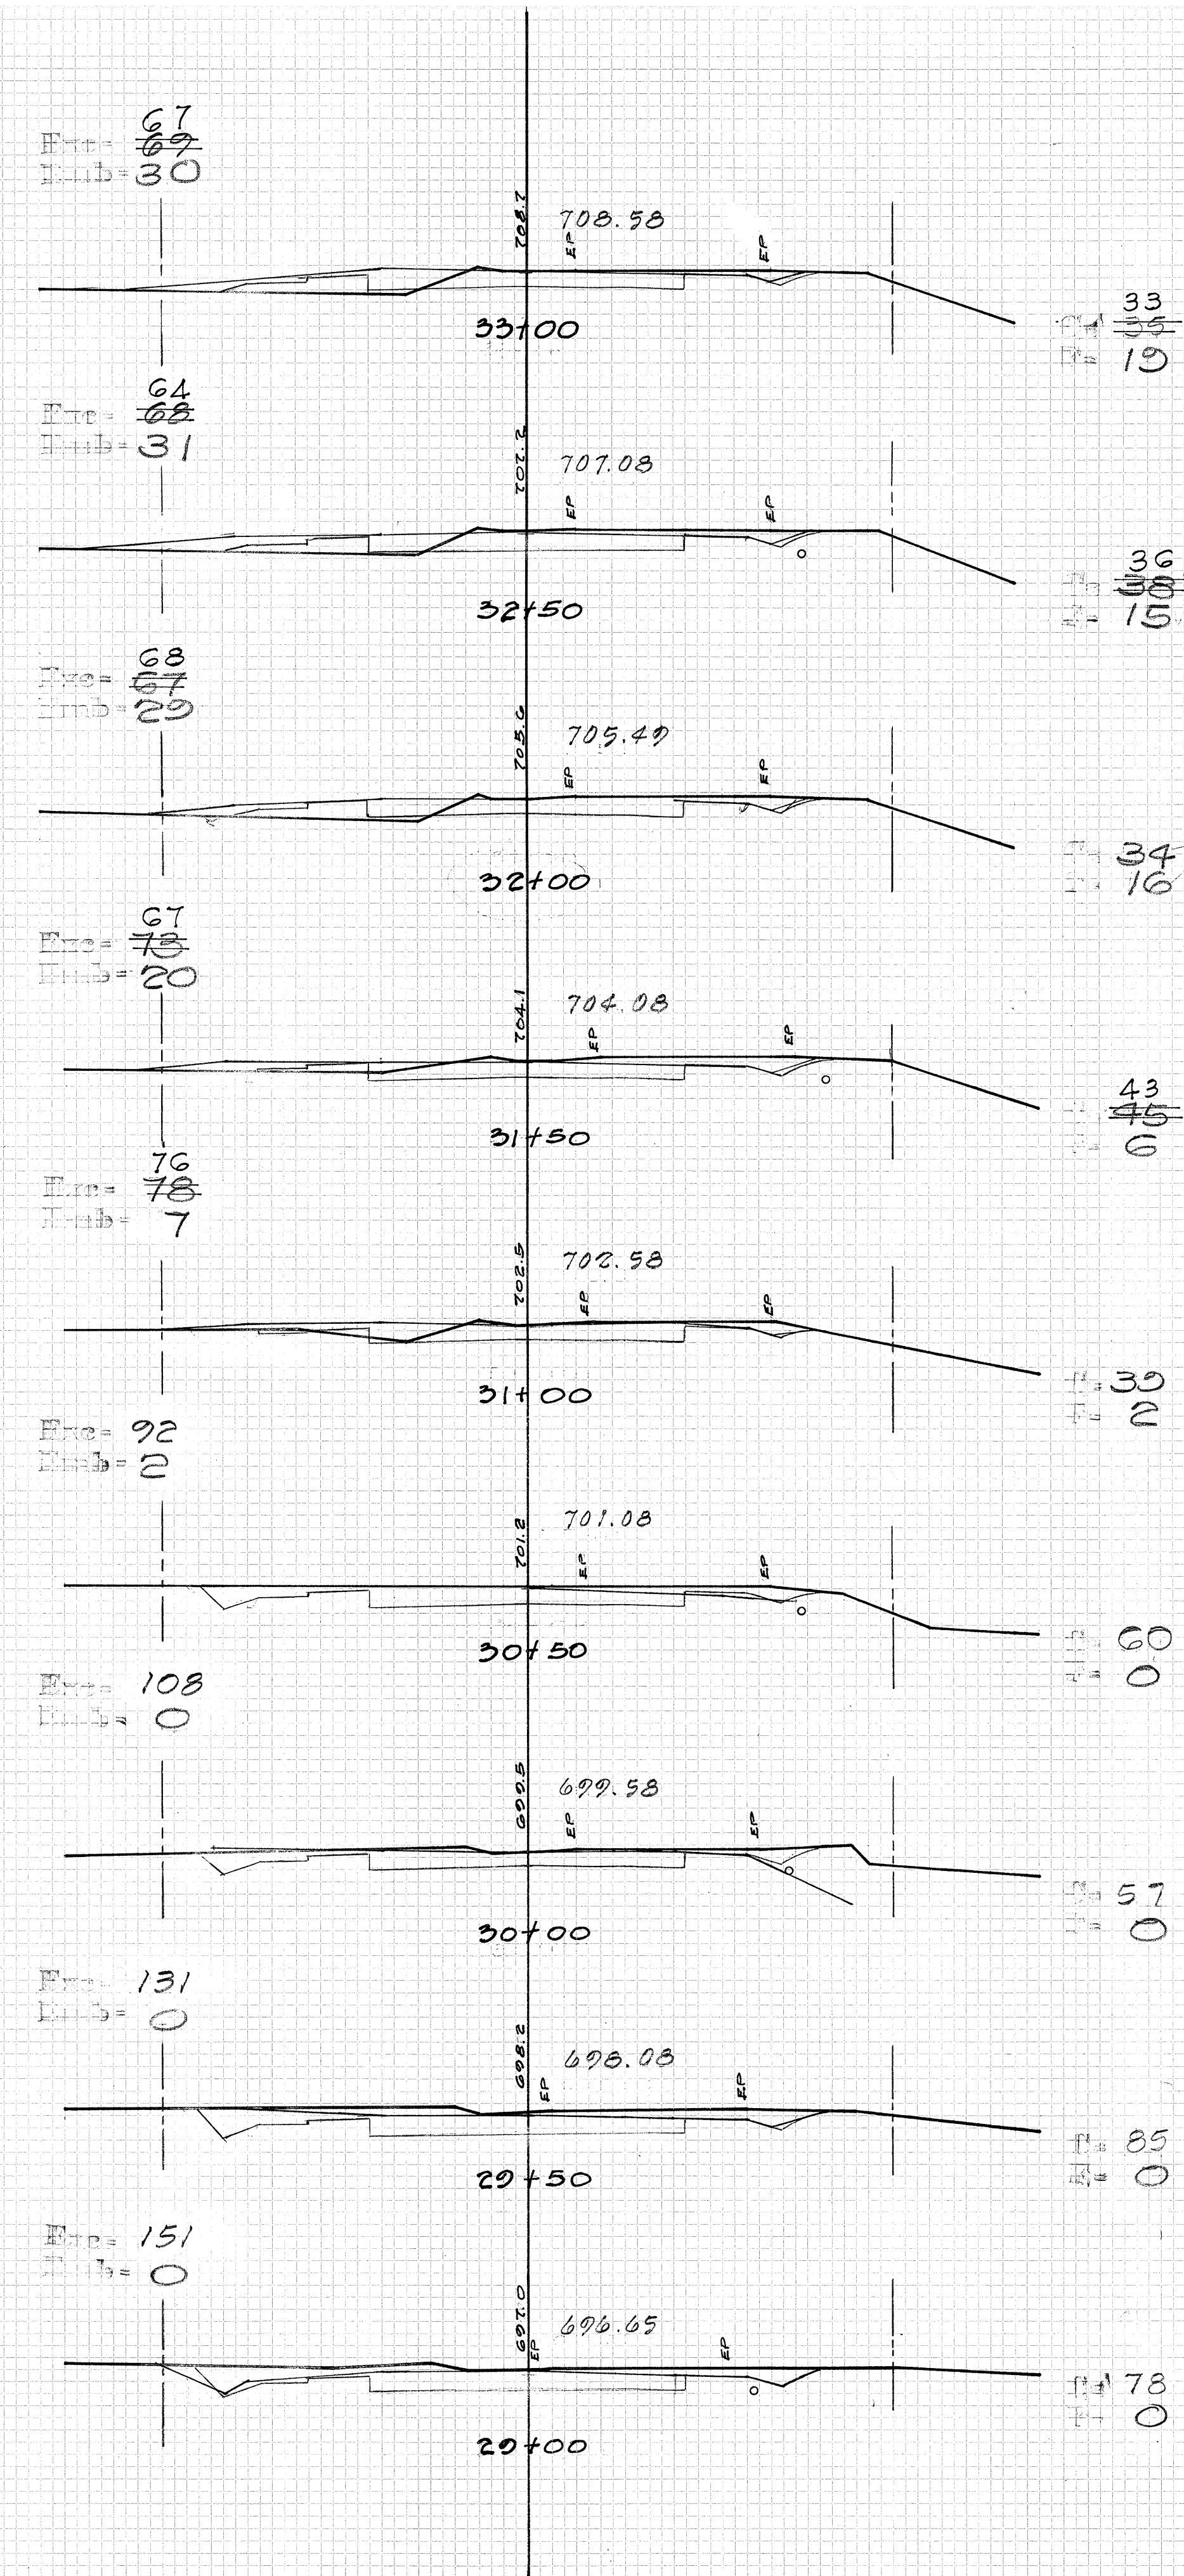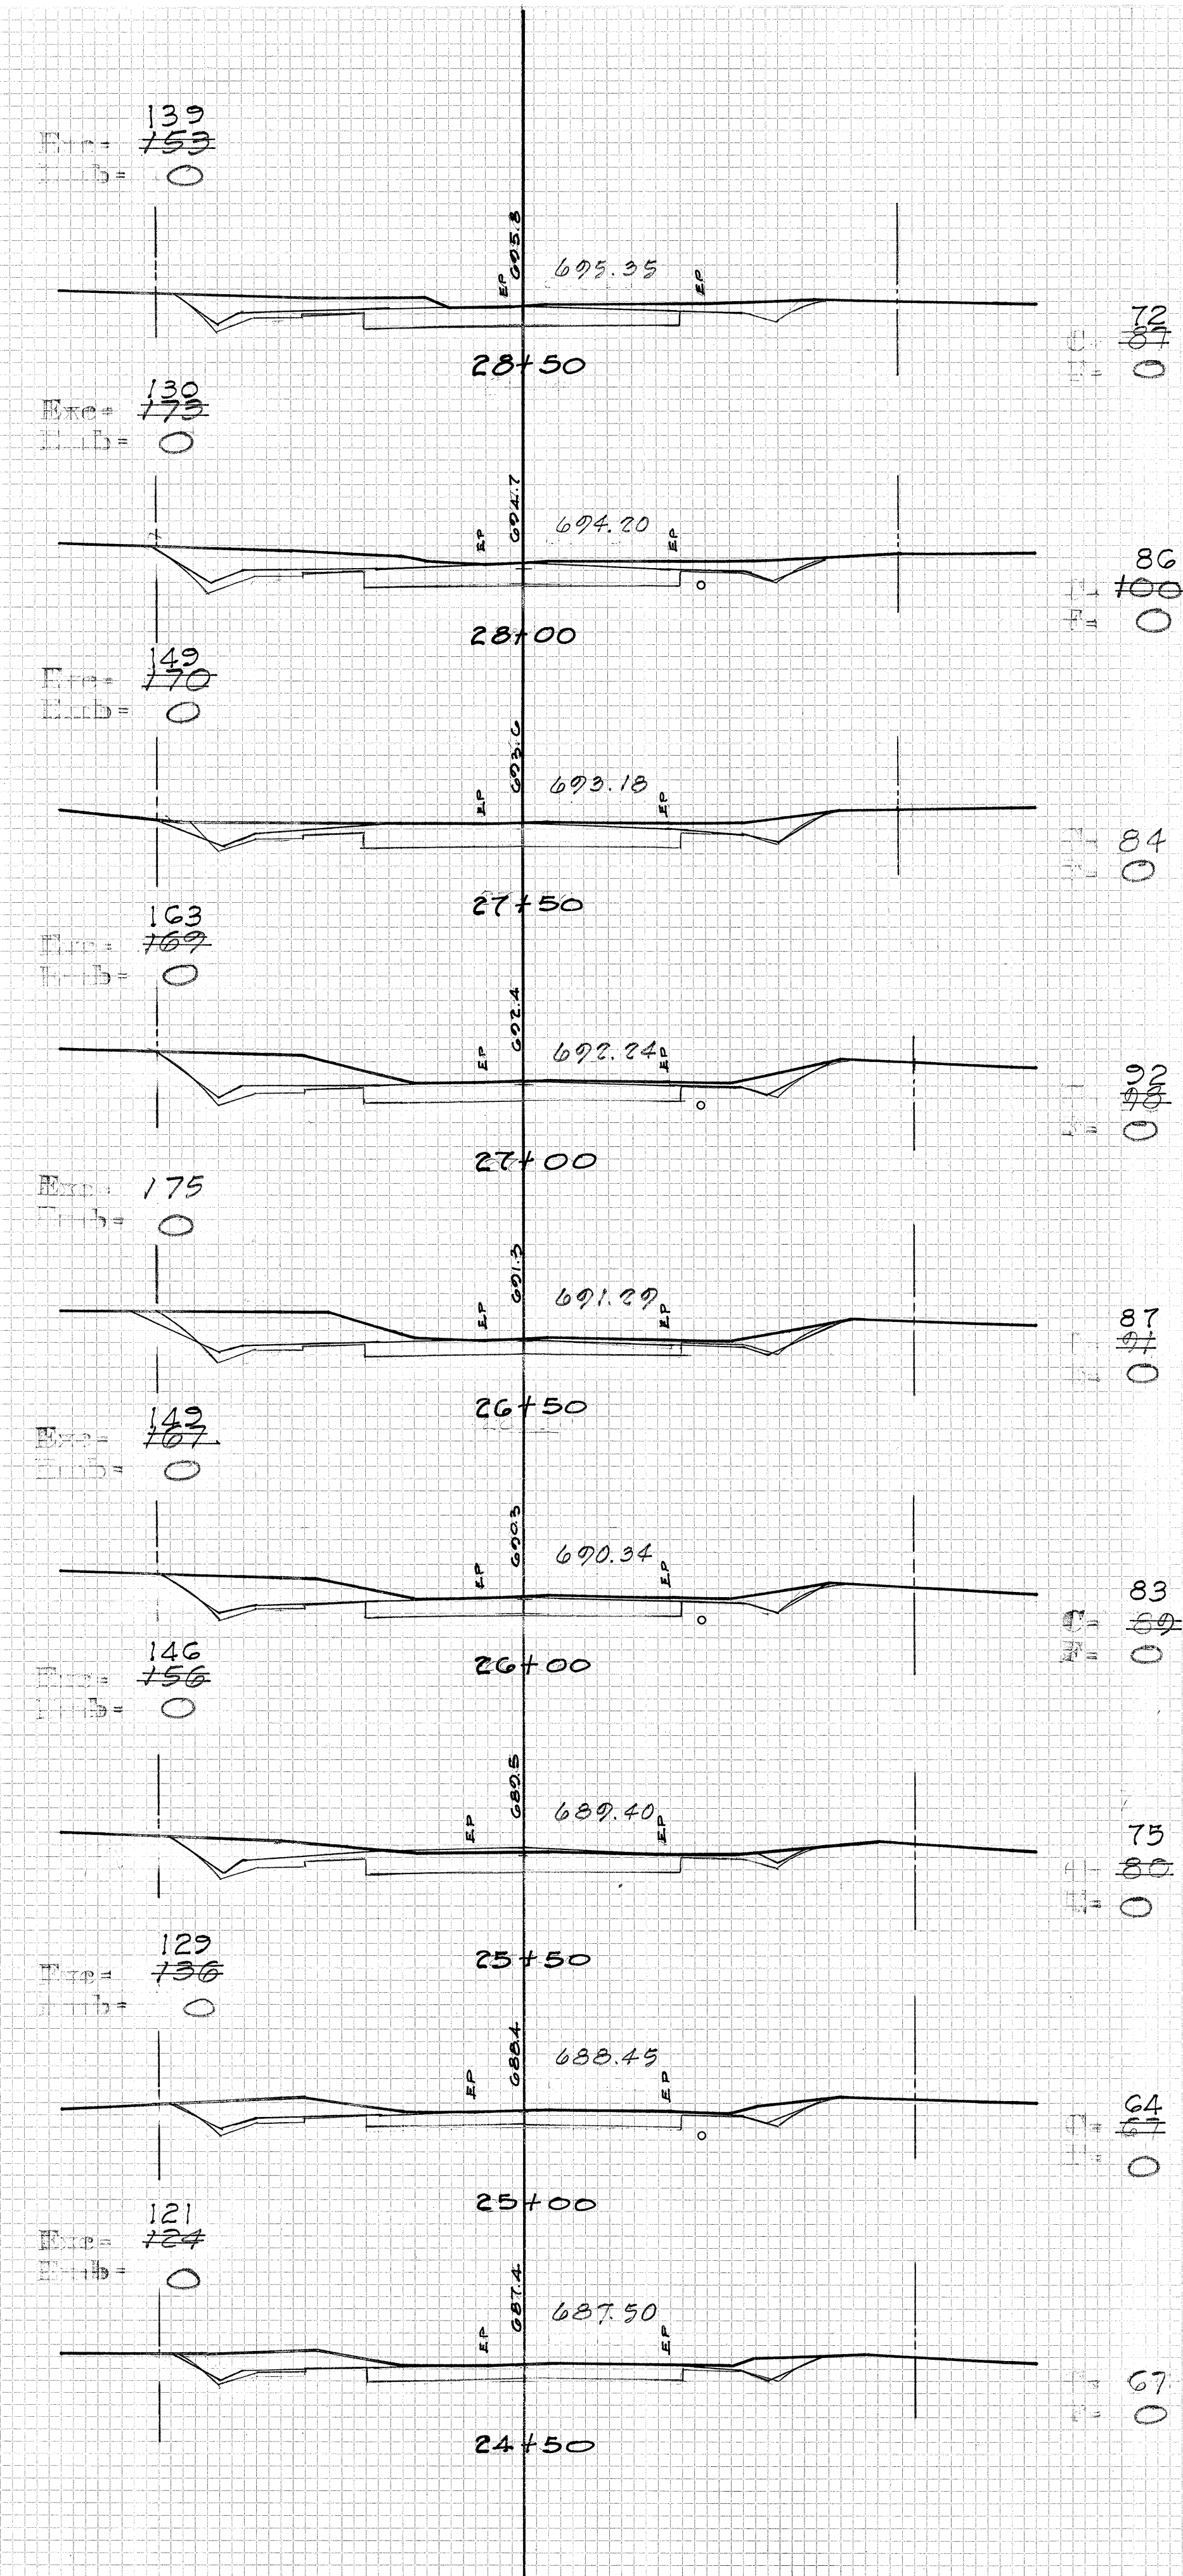

FED. ROAD DIST. NO.	STATE	FED. AID PROJ. NO.	FISCAL YEAR	SHEET NO.	TOTAL SHEETS
HAWAII	HAW.	UNITS	1965	14	19


Exc. = 106
Emb. = 0

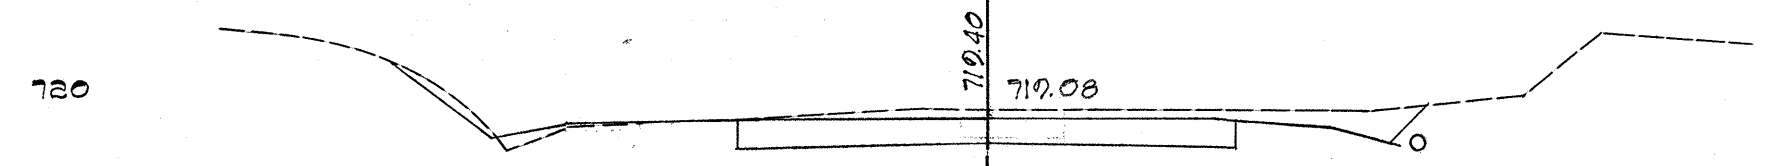

36 + 50

C = 56
F = 0


Exc. = 106
Emb. = 0

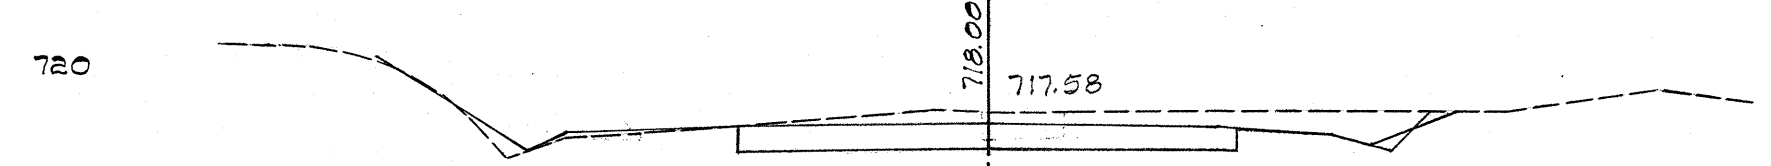

36 + 00

C = 59
F = 0


Exc. = 100
Emb. = 0

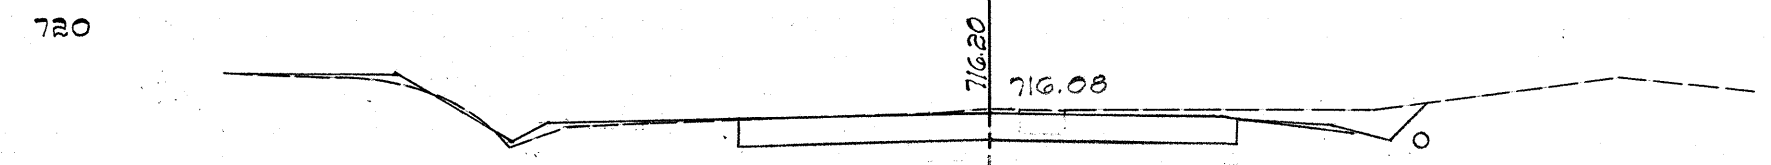

35 + 50

C = 49
F = 0


Exc. = 89
Emb. = 0

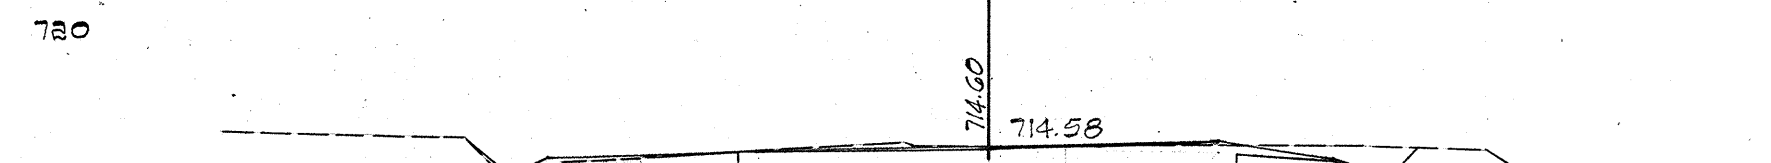

35 + 00

C = 47
F = 0


Exc. = 94
Emb. = 0

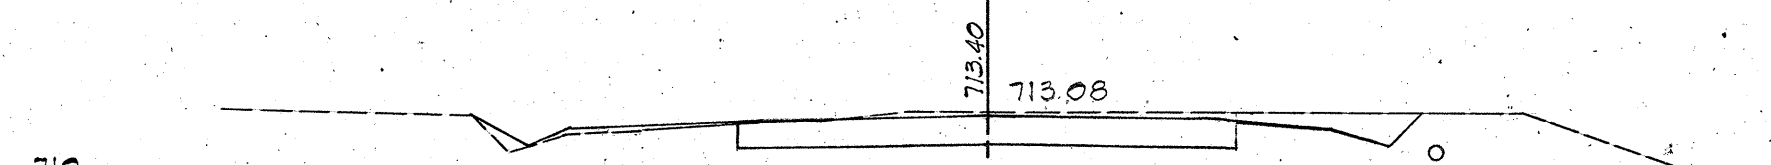

34 + 50

C = 54
F = 0

Exc. = 90
Emb. = 4

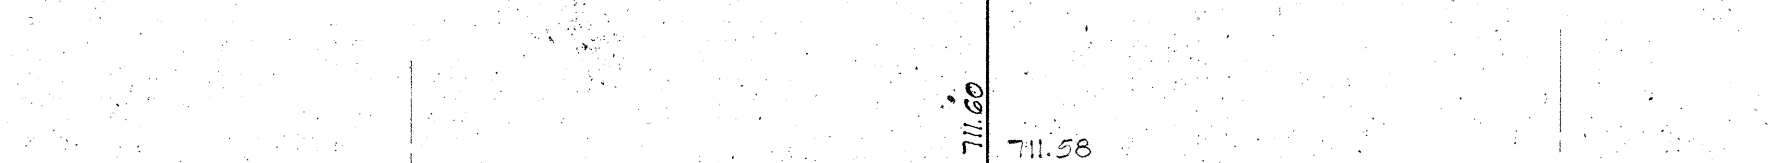


34 + 00

C = 43
F = 4

Exc. = 76
Emb. = 16

FED. ROAD DIST. NO.	STATE	FED. AID PROJ. NO.	FISCAL YEAR	SHEET NO.	TOTAL SHEETS
5-348900	HAWAII	UNIT 2	1965	15	15


Exc. = 80
Emb. = 0

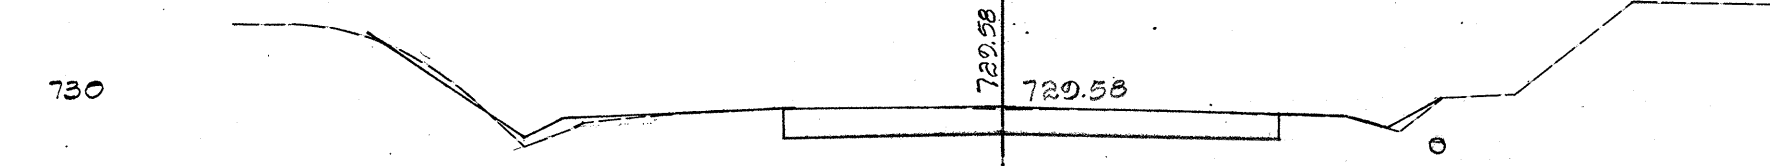

40 + 00

C = 53
F = 0


Exc. = 103
Emb. = 0

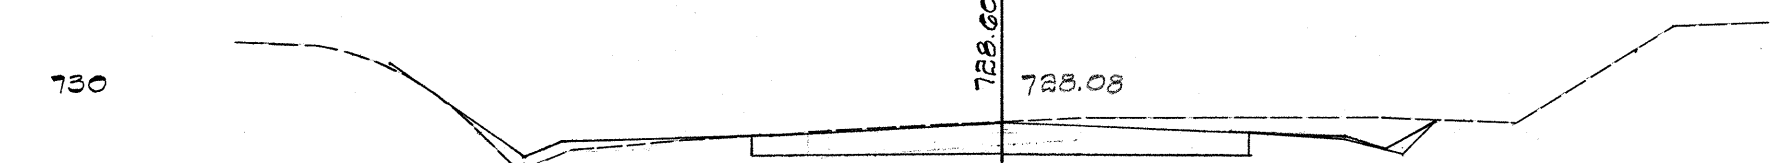

39 + 50

C = 55
F = 0


Exc. = 720 / 111
Emb. = 0

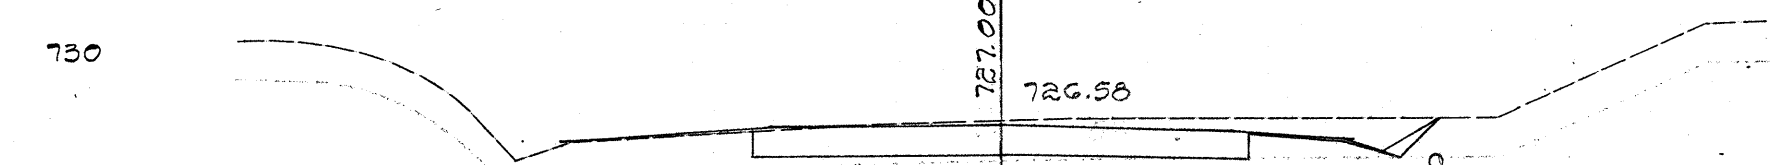

39 + 00

C = 58
F = 0

Exc. = 112
Emb. = 0

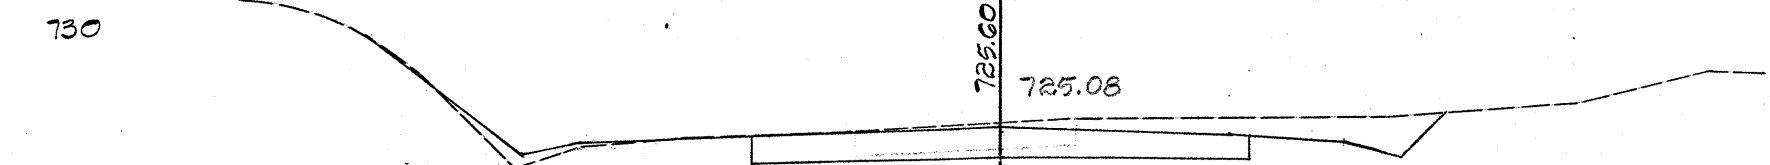

38 + 50

C = 62
F = 0

Exc. = 107
Emb. = 0



38 + 00

C = 59
F = 0

Exc. = 106
Emb. = 0



37 + 50

C = 57
F = 0

Exc. = 106
Emb. = 0



37 + 00

C = 58
F = 0