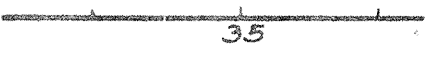
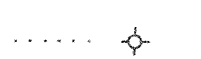


INDEX TO DRAWINGS	
SHEET NO.	DESCRIPTION
1	TITLE SHEET
2	TYPICAL SECTION
3 - 4	PLAN & PROFILE
5	BORROW PIT PLAN
6	MISCELLANEOUS DETAILS
7	DESTINATION SIGN DETAILS
8 - 11	STANDARD DETAILS
12 - 15	CROSS SECTIONS


CONVENTIONAL SIGNS USED	
Bridge	
Centerline	 3.5
Centerline Monument	 2 Mon.
Circular Pipe Culvert	
Electric Pole	
Existing Road	
Fences	
Telephone Pole	
Warning & Regulatory Signs	 1/4" 1/4" (Type)
Boundary Line	

STATE OF HAWAII
DEPARTMENT OF TRANSPORTATION
HIGHWAYS DIVISION
HONOLULU, HAWAII

"AS BUILT" PLANS OF
A PORTION OF
FARRINGTON AVENUE
FEDERAL AID PROJECT NO. S-0480 (I)
UNIT 2


DISTRICT OF MOLOKAI
COUNTY OF MAUI
ISLAND OF MOLOKAI

SCALES	
PLAN	1 IN. = 100 FT.
PROFILE	HOR. 1 IN. = 100 FT.
	VER. 1 IN. = 10 FT.
CROSS SECTION	HOR. 1 IN. = 10 FT.
	VER. 1 IN. = 10 FT.

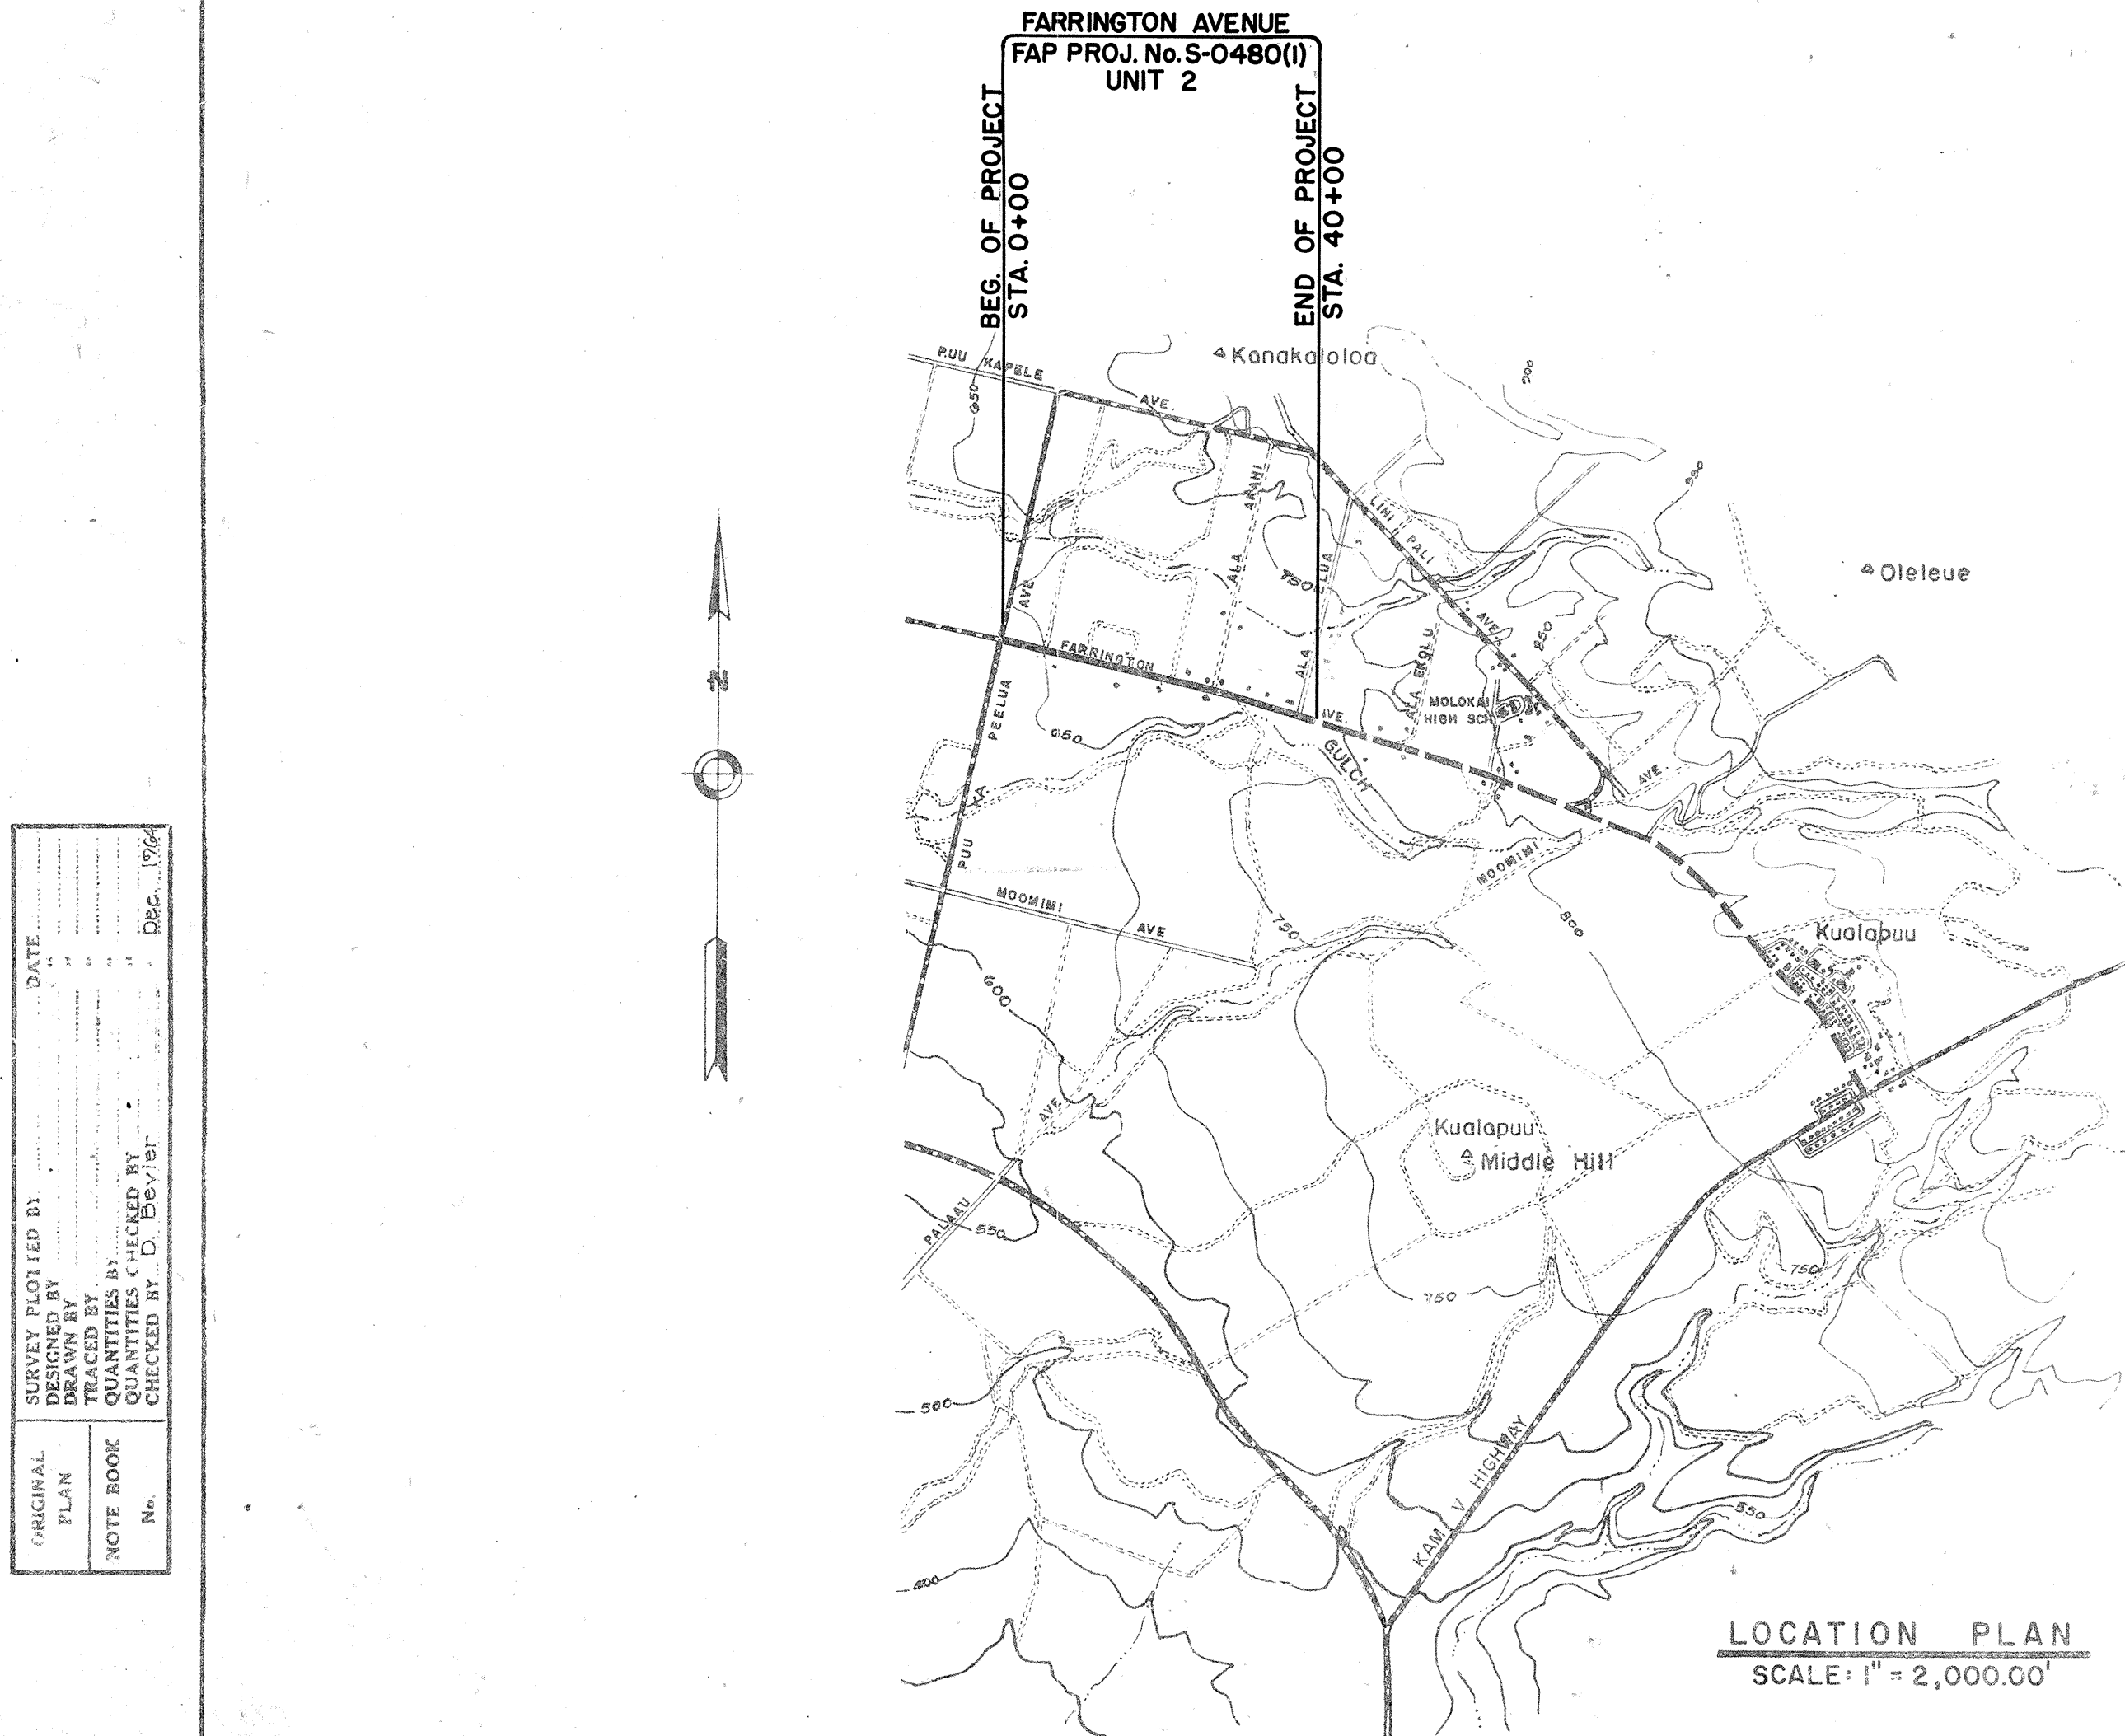

LENGTH OF PROJECT = 0.758 Miles

LOCATION PLAN
SCALE: 1" = 2,000.00'

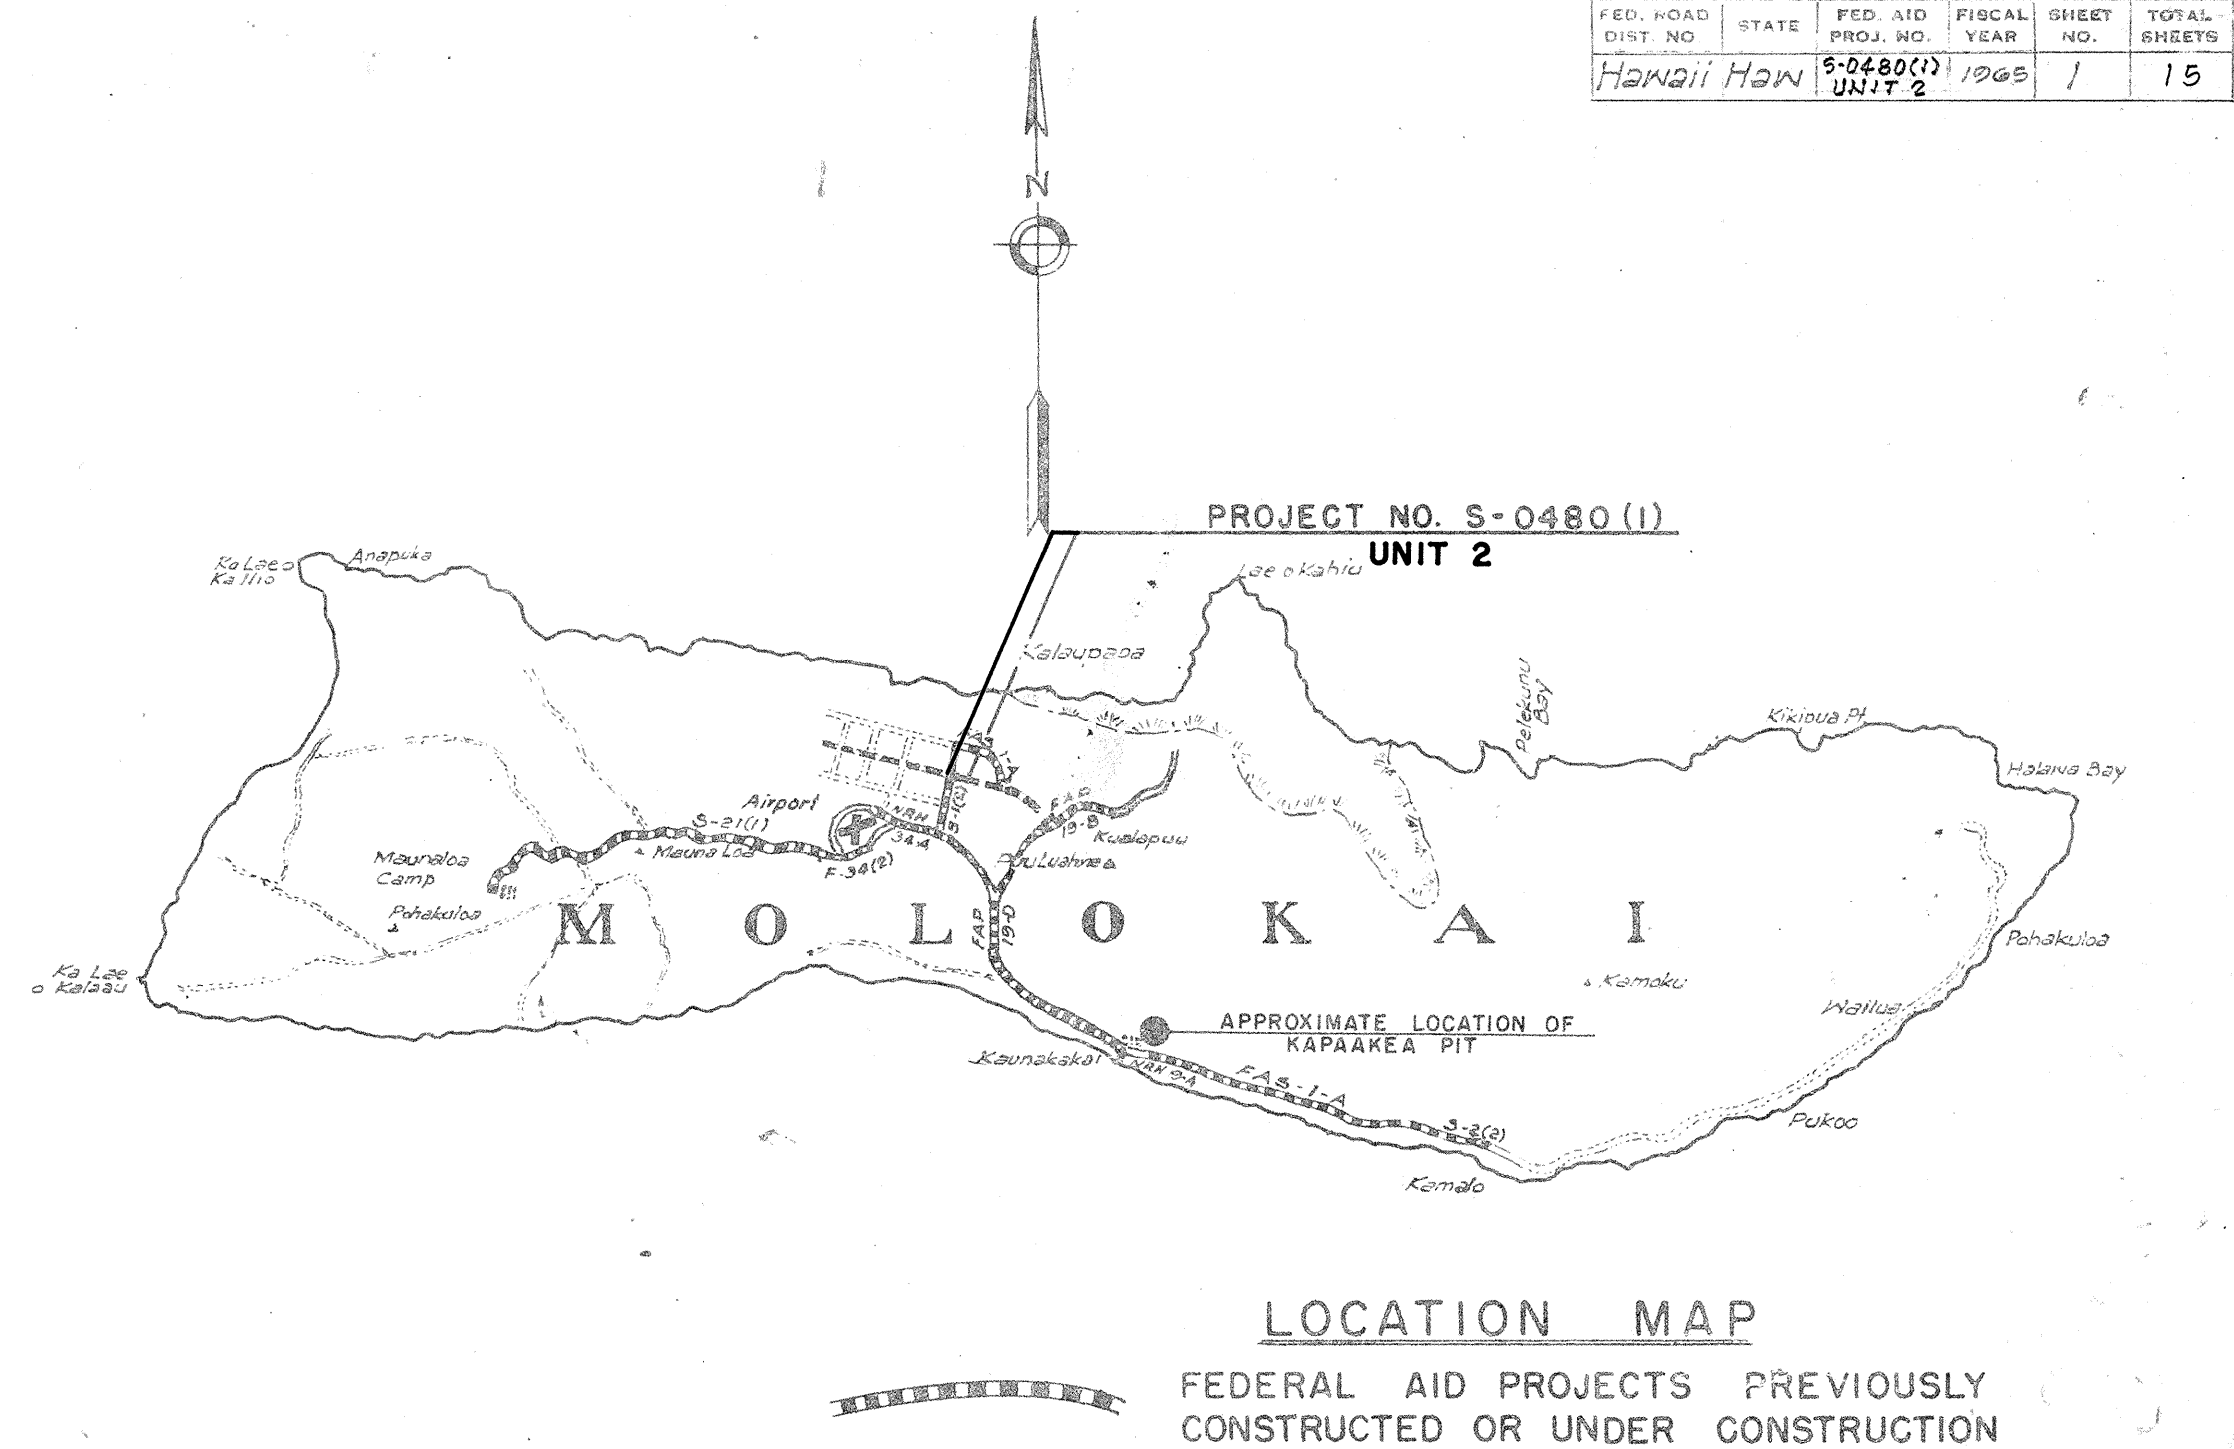

DESIGN CLASSIFICATION

ADT	1964 = 990
ADT	1982 = 1240
DHV	12 %
D	60/40
T	20 %
V	60 M.P.H.

NOTE:
ALL CHANGES MADE DURING
CONSTRUCTION HAVE BEEN
NOTED IN RED ON THESE
TRACINGS AND CHECKED BY:

Patrick Shuckman
PROJECT ENGINEER
May 12, 1967
DATE

APPROVED: DATE *12 Aug 65*
Luis Ontaneda
DIRECTOR, DEPARTMENT OF TRANSPORTATION

DEPARTMENT OF COMMERCE
BUREAU OF PUBLIC ROADS
APPROVED: *John B. Dalton* *8/30/65*
DIVISION ENGINEER DATE