


UNIT "A" _____
DESIGNED BY _____

R. Mikami _____
P. S. & E. BY _____


548-7534 _____
PHONE _____

11/20/81 _____
DATE _____

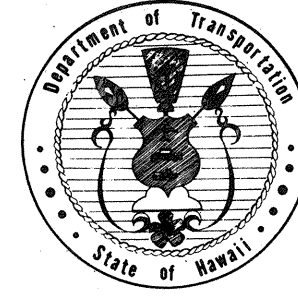


PLANS OF


PROJECT NO. HWY-M-01-82M

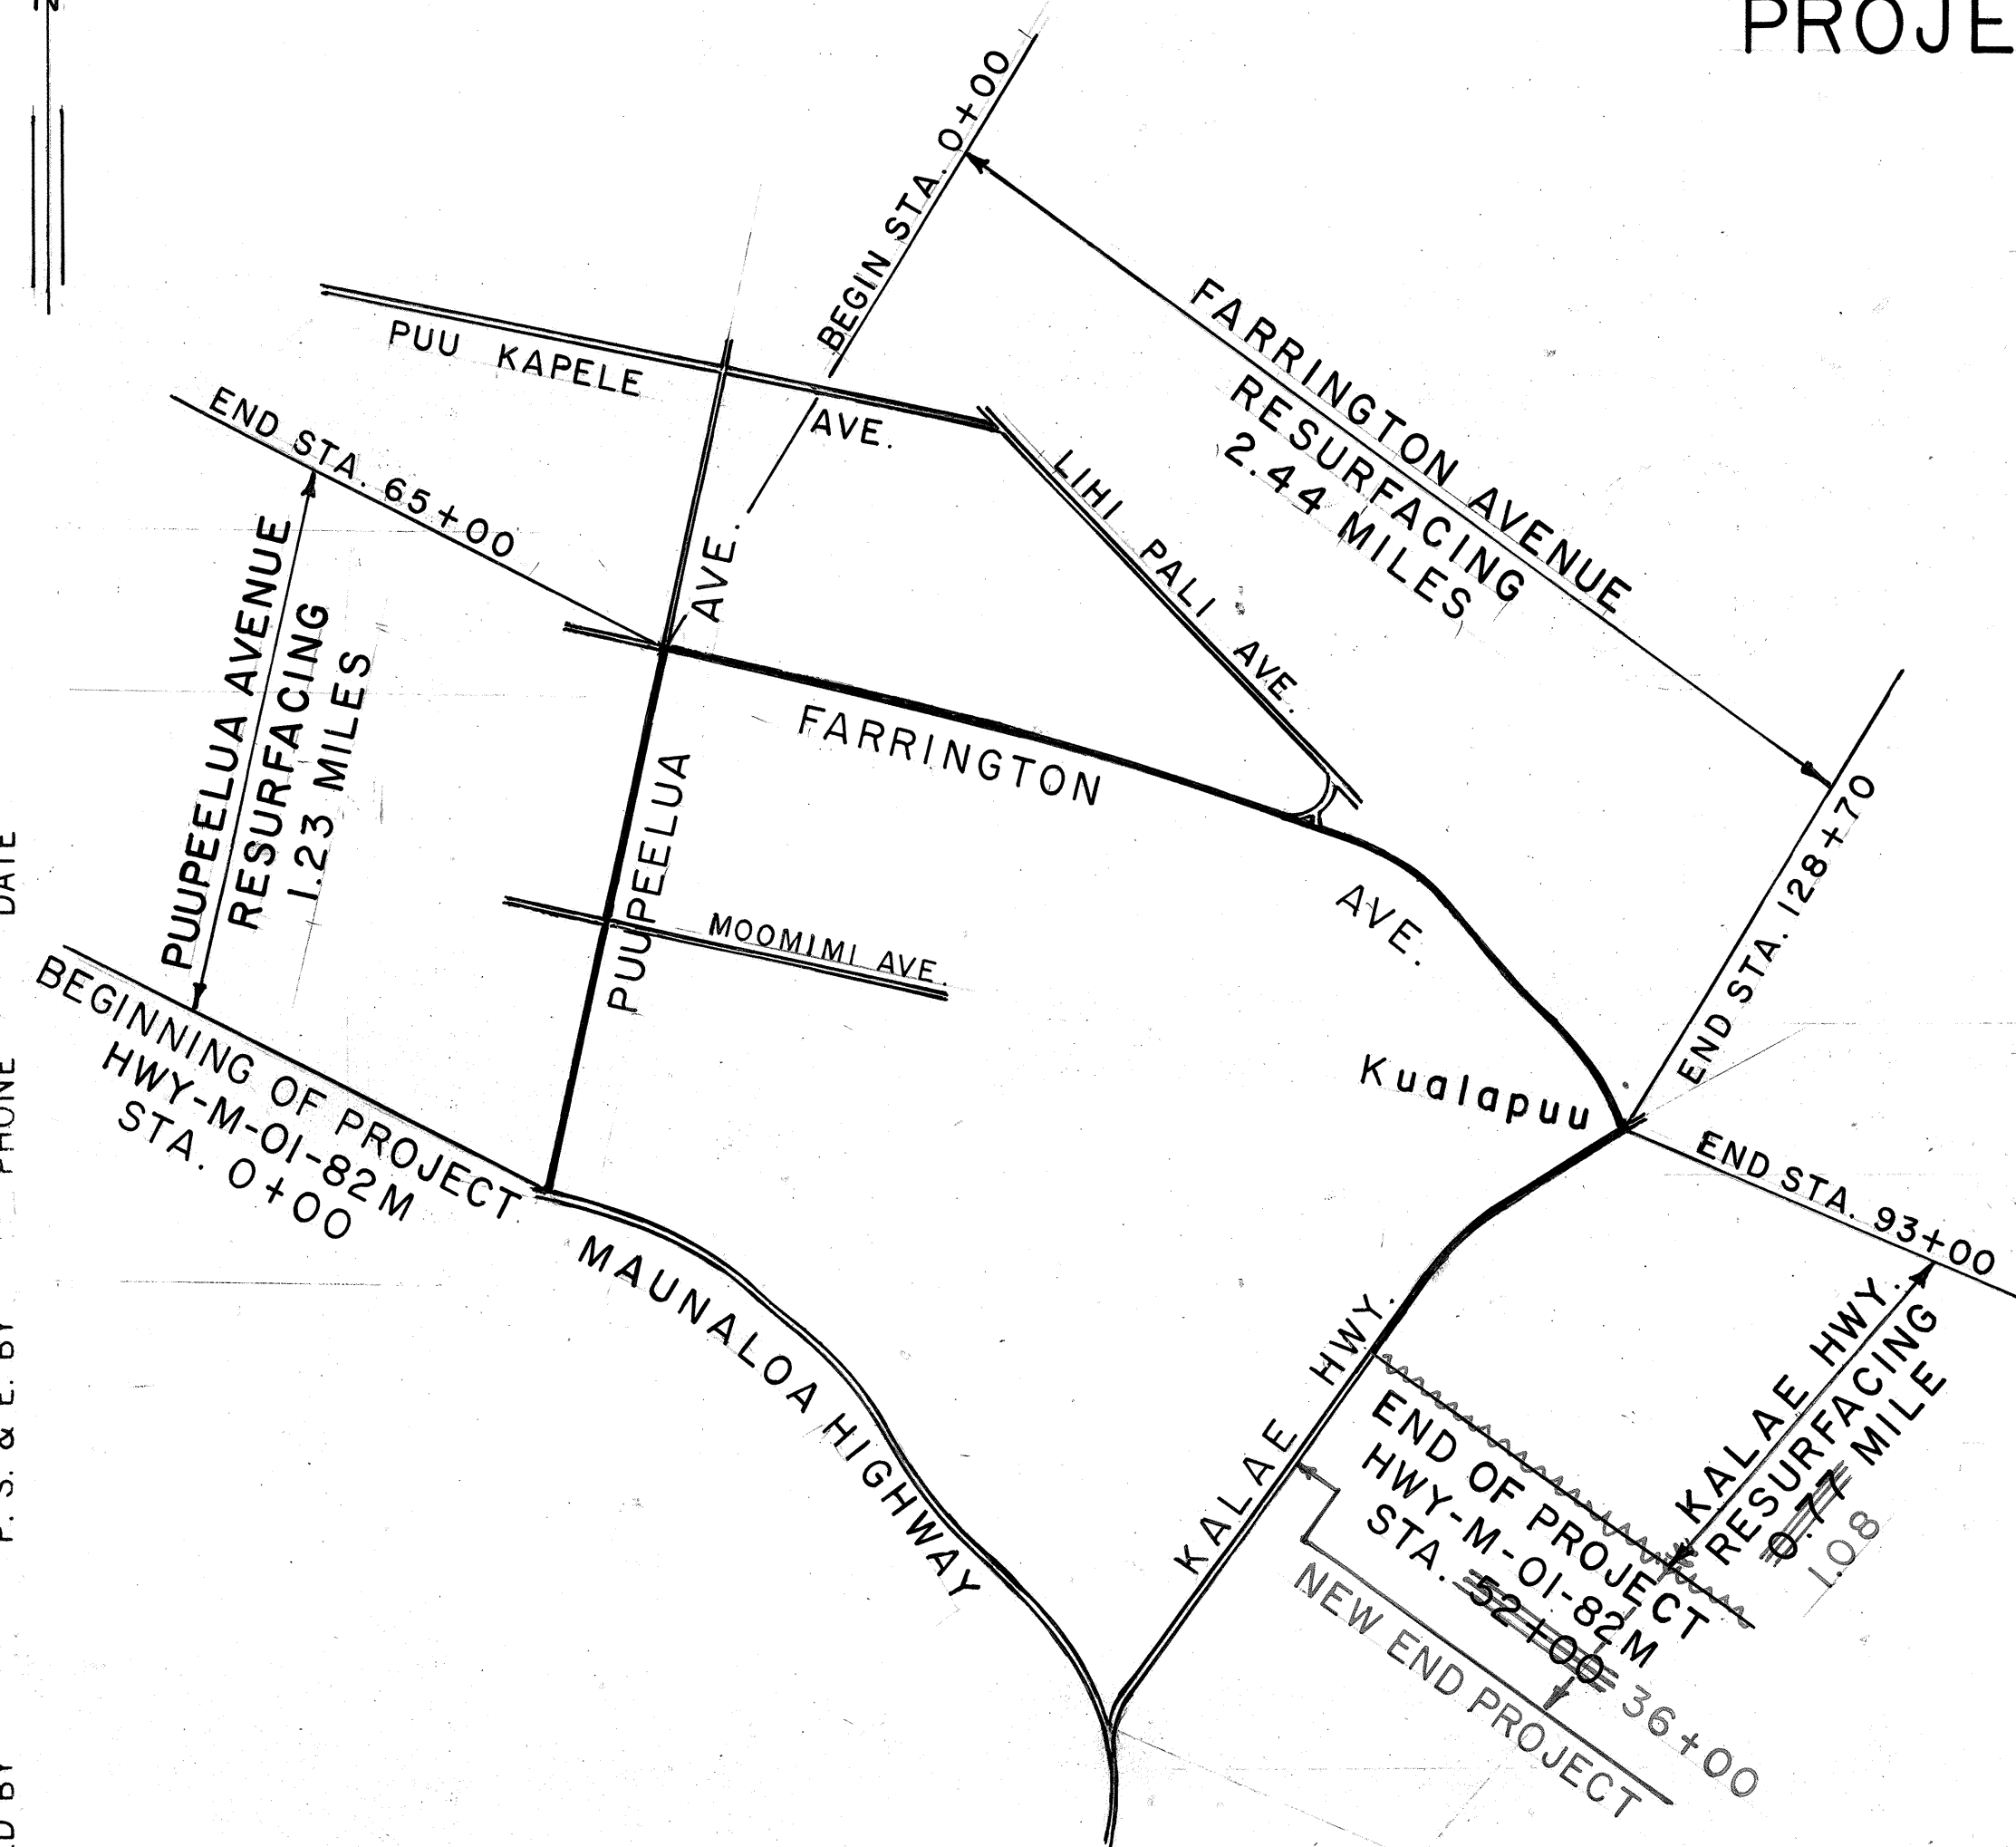DISTRICT OF MOLOKAI
ISLAND OF MOLOKAI

LOCATION PLAN
SCALE: 1" = 2000'

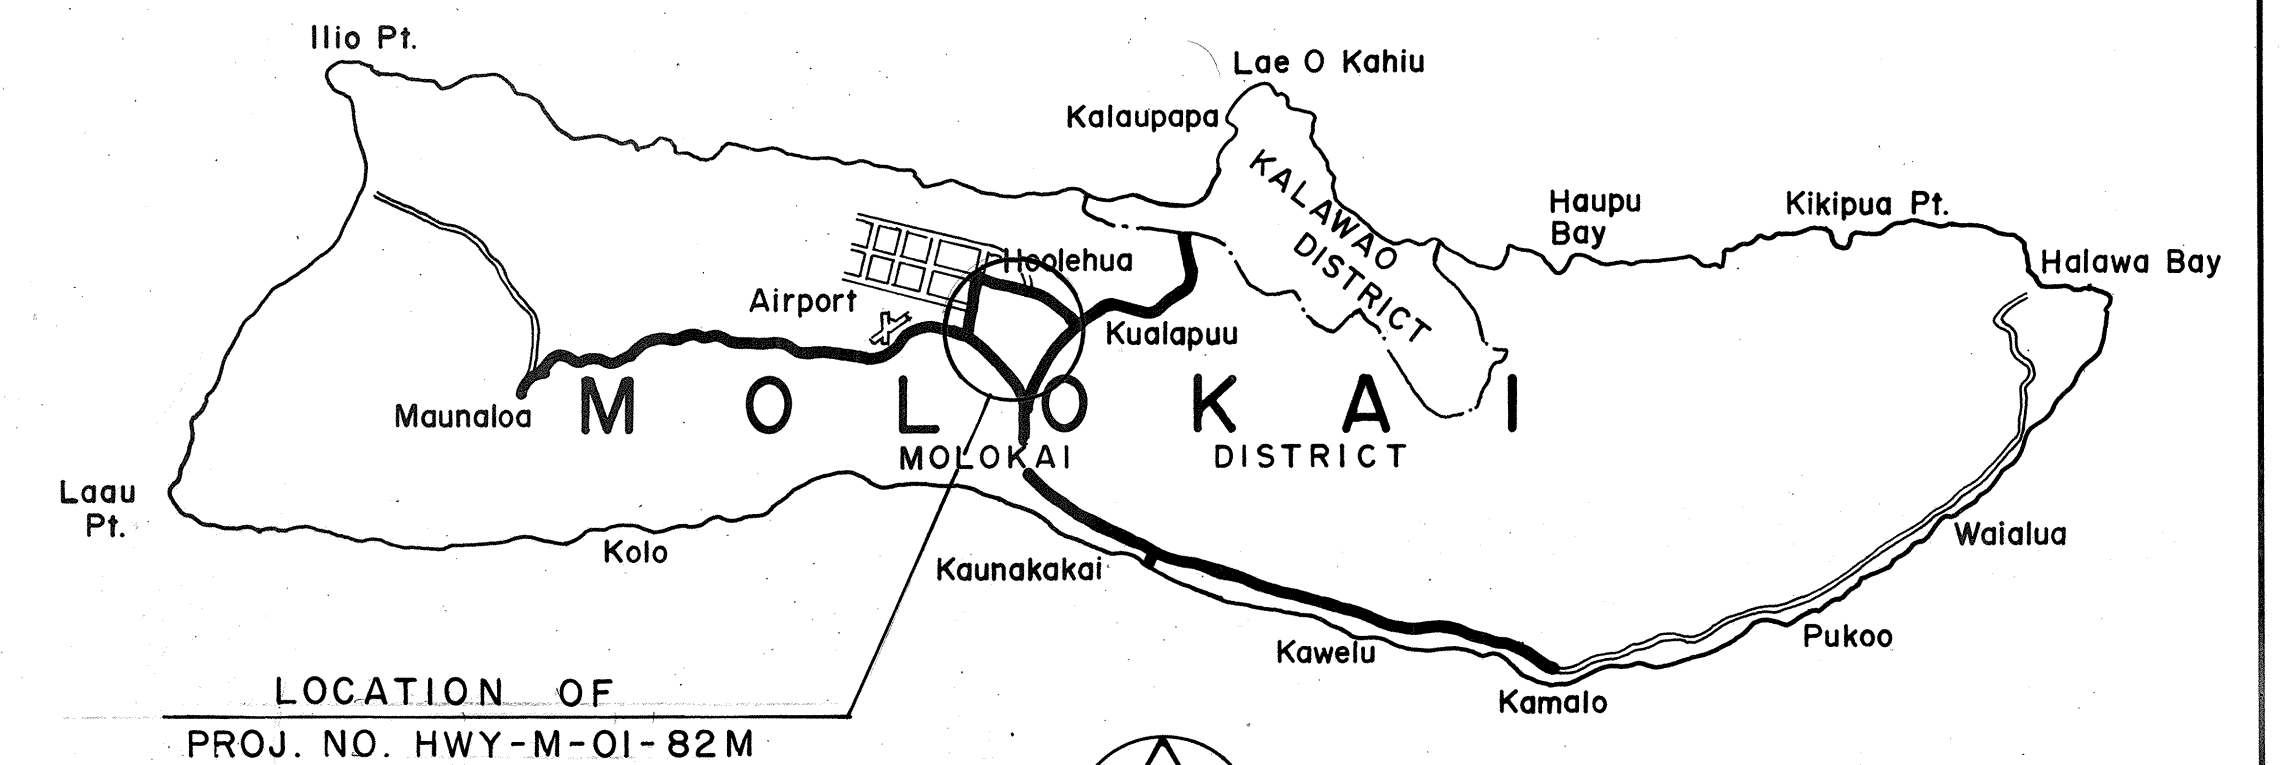

LOCATION OF
PROJ. NO. HWY-M-01-82M

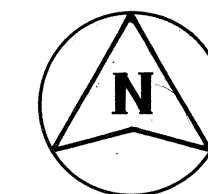

4 0 4 8

SCALE IN MILES

FEDERAL AID PROJECTS PREVIOUSLY CONSTRUCTED
OR UNDER CONSTRUCTION

ALL CHANGES MADE DURING CONSTRUCTION HAVE
BEEN INCORPORATED ON THESE PLANS IN RED
EXCEPT CHANGES IN THE ORIGINAL THEORETICAL
QUANTITIES. FOR ACTUAL QUANTITIES, REFER TO
PROJECT LEDGER AND/OR COMPUTATION BOOK.

Manuel J. Silva
RESIDENT ENGINEER

21 April 82
DATE

DEPARTMENT OF TRANSPORTATION
STATE OF HAWAII

APPROVED:

James R. Carras 4/20/81
DIR. OF TRANSPORTATION DATE