

FED. ROAD DIST. NO.	STATE	PROJ. NO.	FISCAL YEAR	SHEET NO.	TOTAL SHEETS
HAWAII	HAW.	480A-01-83	1984	3	10

LEGEND
 Existing Footpath

Sta. 0+30 ± Lt.
 Begin resurfacing existing footpath
 For detail see Plan Sht. No. 2.

True North
 Scale: 1"=100'

M.L. P.C. STA. 26+47.31

PLAN

True North
 Scale: 1"=100'

M.L. P.C. STA. 26+47.31

ALA ELUA ST.

ALA EKOLU ST.

M.L. P.C. STA. 55+99.61

PLAN

R=11,459.16
 PT. 515.31+97.31
 515.31+97.04

True North
 Scale: 1"=100'

M.L. P.C. STA. 55+99.61

Molokai High School

Sta. 75+85 ± Lt.
 End resurfacing
 existing footpath

LIHI PALI AVE.

To Kualapuu

PLAN

R=11,459.16
 PT. 515.31+97.31
 515.31+97.04



STATE OF HAWAII
 DEPARTMENT OF TRANSPORTATION
 LAND TRANSPORTATION FACILITIES DIVISION

PLAN-FARRINGTON AVE.
 FARRINGTON AVE. & PUUPEELUA AVE.
 SAFETY IMP. AT VAR. LOCATIONS
 PROJ. NO. 480A-01-83
 Scale: As Shown Date: Nov, 1983
 SHEET NO. 1 OF 2 SHEETS

ORIGINAL PLAN	SURVEY PLOTTED BY	DATE
DESIGNED BY	DRAWN BY	
NOTED BY	CHECKED BY	
NO.		

PLAN	DATE	BY
NOTED		
ALIGNED		
CHECKED		
NO.		

PROFILE	DATE	BY
NOTED		
GRADES CHECKED		
B.M. NOTED		
STRUCTURE NOTATIONS CHKD		
NO.		

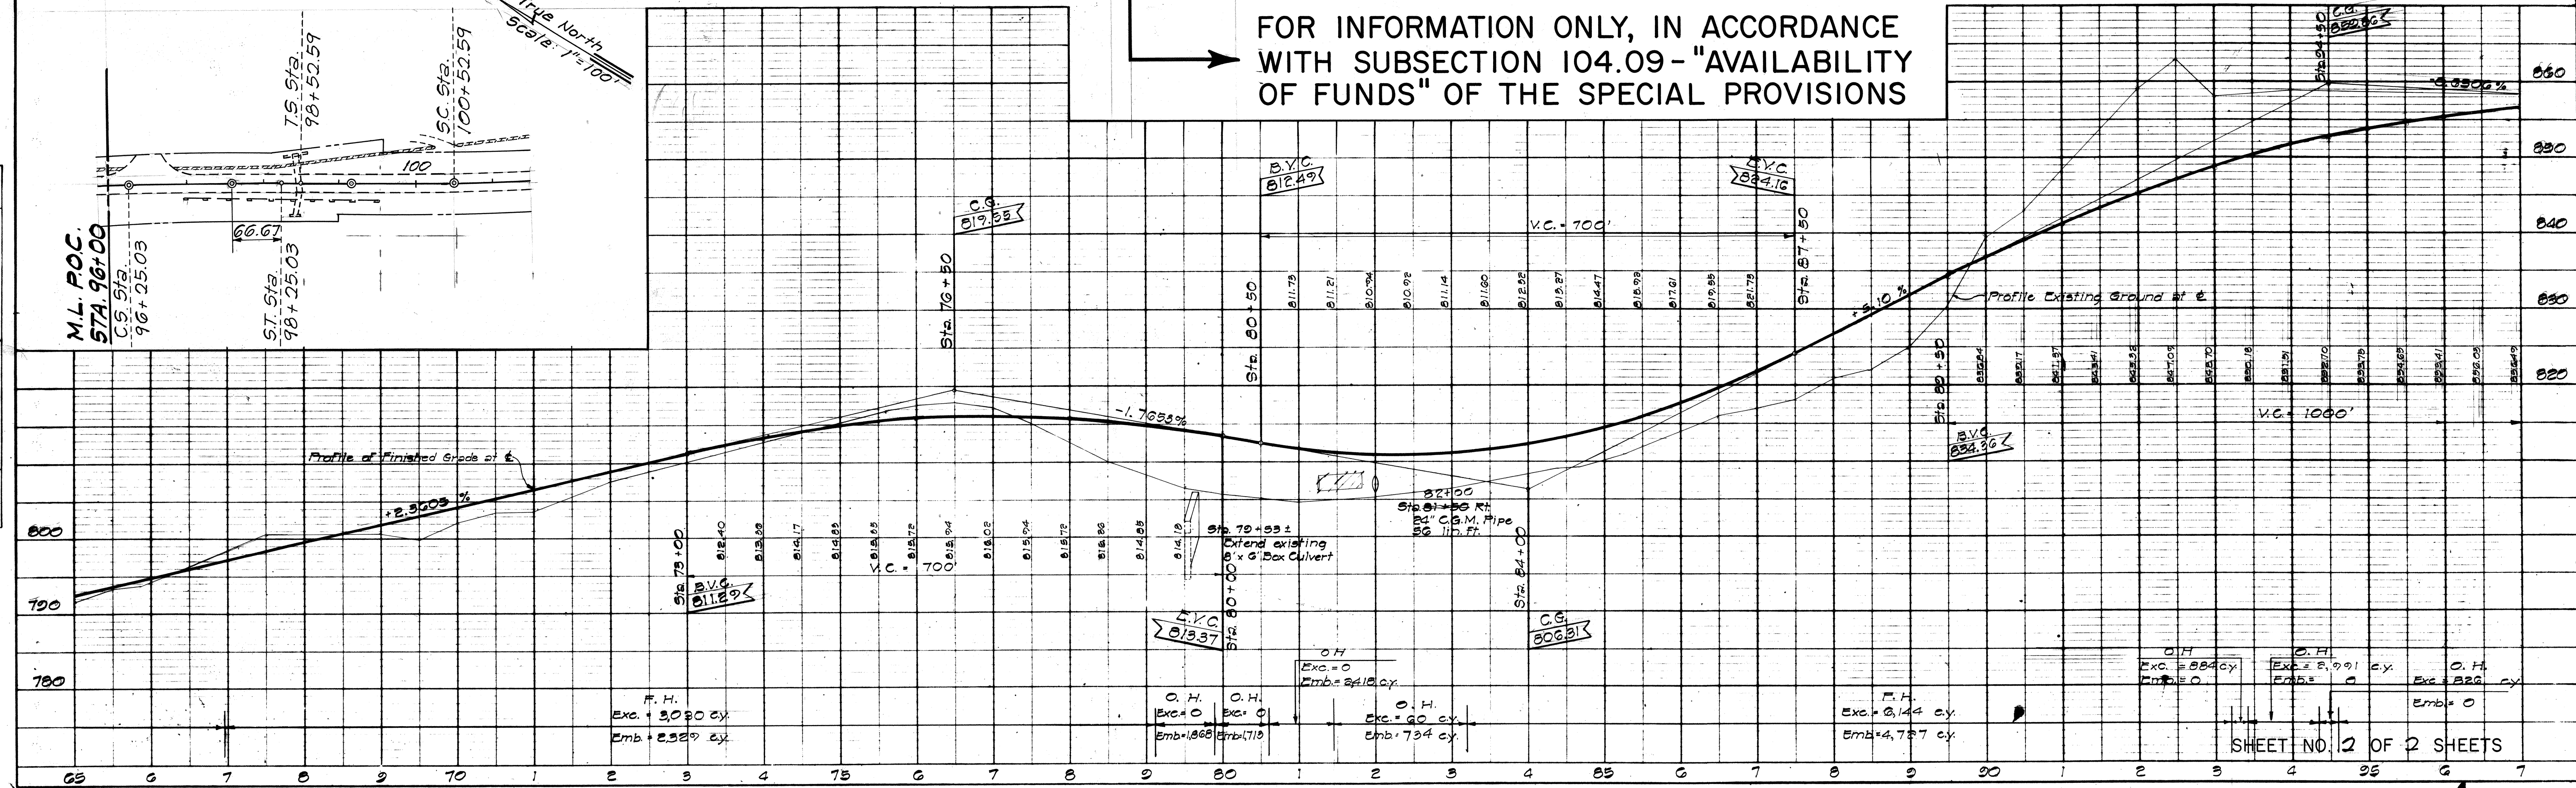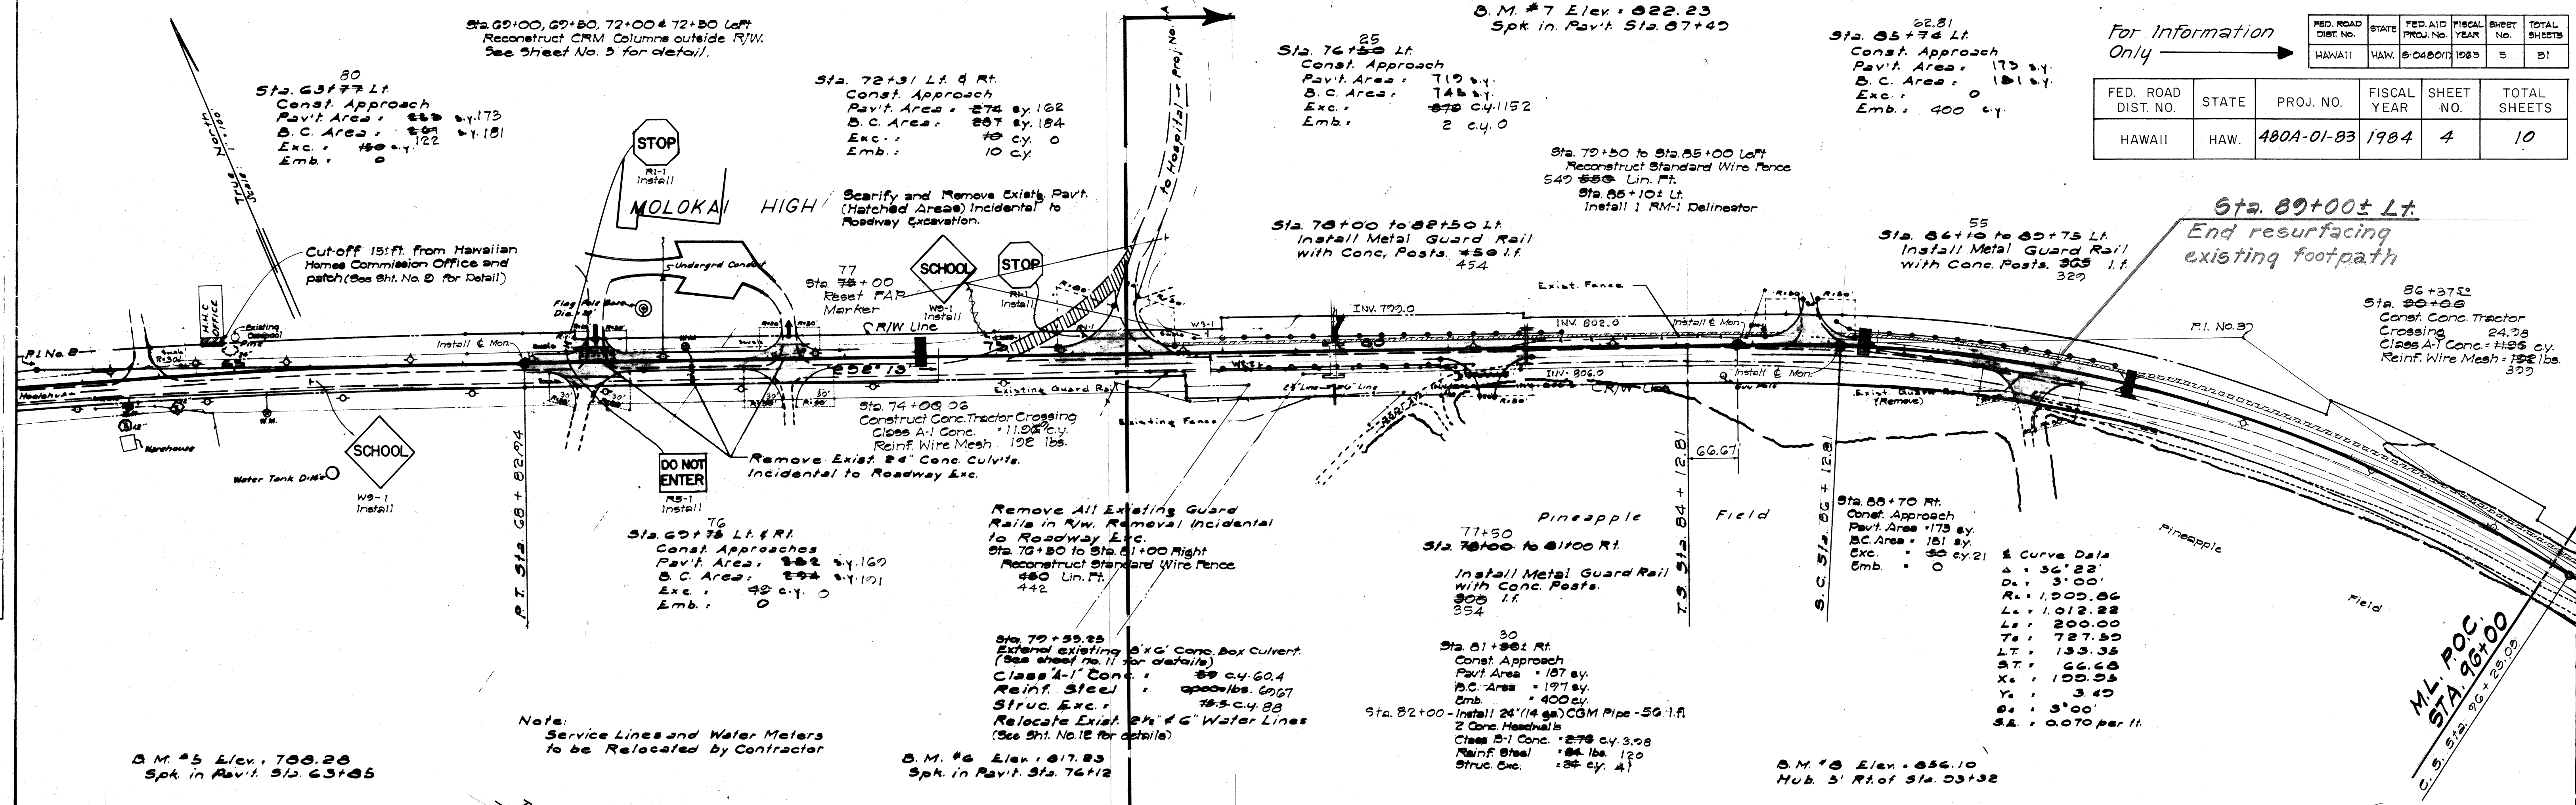

FOR INFORMATION ONLY, IN ACCORDANCE WITH SUBSECTION 104.09 - "AVAILABILITY OF FUNDS" OF THE SPECIAL PROVISIONS

FED. ROAD DIST. NO.	STATE	PROJ. NO.	FISCAL YEAR	SHEET NO.	TOTAL SHEETS
HAWAII	HAW.	480A-01-83	1984	4	10

SHEET NO. 2 OF 2 SHEETS