

FED. ROAD DIST. NO.	STATE	PROJ. NO.	FISCAL YEAR	SHEET NO.	TOTAL SHEETS
HAWAII	HAW.	480A-01-83	1984	2	10

61+07 64+25
~~Sta. 61+07 to Sta. 62+95 Lt. &~~
~~Sta. 62+95 to Sta. 64+25 Lt.~~
Construct 225± L.F. Bituminous Sidewalk. For detail see this sheet.

318

True North
Scale: 1"=100'

44+50
Sta. 40+25± to Sta. 45+00± Lt.
Install 475± L.F. New Metal Guard Rail,
Type 3, Single with Steel Post and
Spacer Block.
Install Type "F" and Type "C" Flares.

Type "C" Flare
Type "F" Flare
Type "C" Flare
Type "F" Flare


PUUPEELUA AVENUE

PLAN

46+33
Sta. 40+75± to Sta. 46+25± Rt.
Install 450± L.F. New Metal Guard Rail,
Type 3, Single with Steel Post and
Spacer Block.
Install Type "C" and Type "F" Flares.


GENERAL NOTES

1. The scope of work for this project consists of installation of guard rail and construction of a bituminous sidewalk on Puupeelua Avenue; and resurfacing the existing footpath on Farrington Avenue.
2. The Contractor shall notify the State, in writing, two weeks prior to starting construction.
3. The Contractor's attention is directed to Subsections 104.04 "Maintenance of Traffic" and 104.09 "Availability of Funds" and to Section 645 "Traffic Control" of the Special Provisions.
4. Clearing and grubbing of the existing footpath on Farrington Avenue shall be done by State Forces prior to starting resurfacing.
5. The existing footpath shall be resurfaced with 1" Asphalt Concrete Pavement, Mix No. I, unless otherwise directed by the Engineer. The exact limits of resurfacing shall be determined in the field by the Engineer.

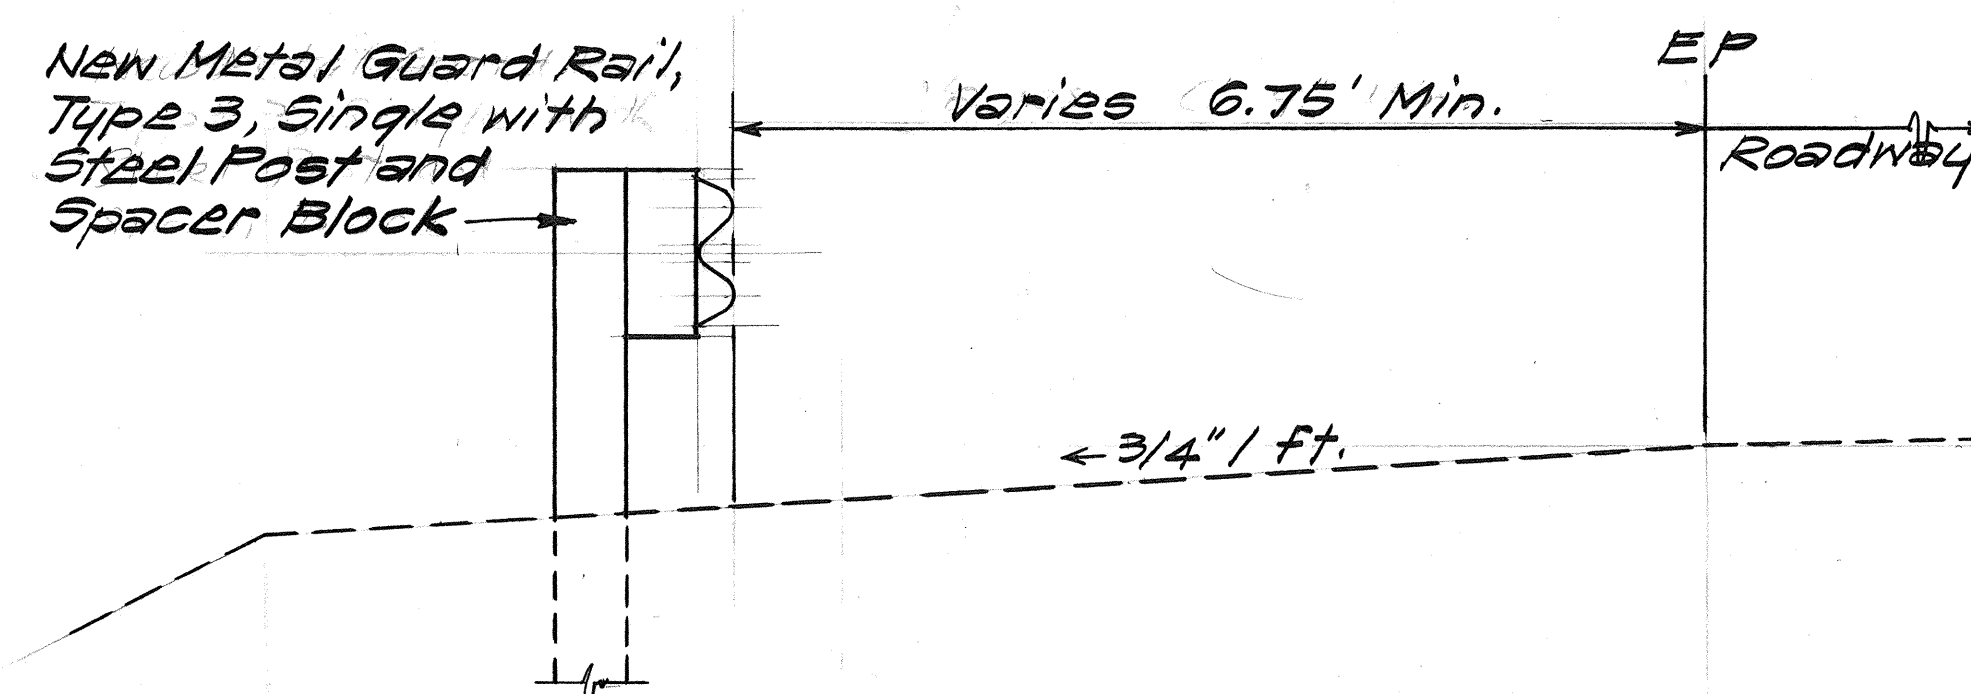


GUARD RAIL DETAIL PUUPEELUA AVENUE

Scale: 3/4"=1'-0"

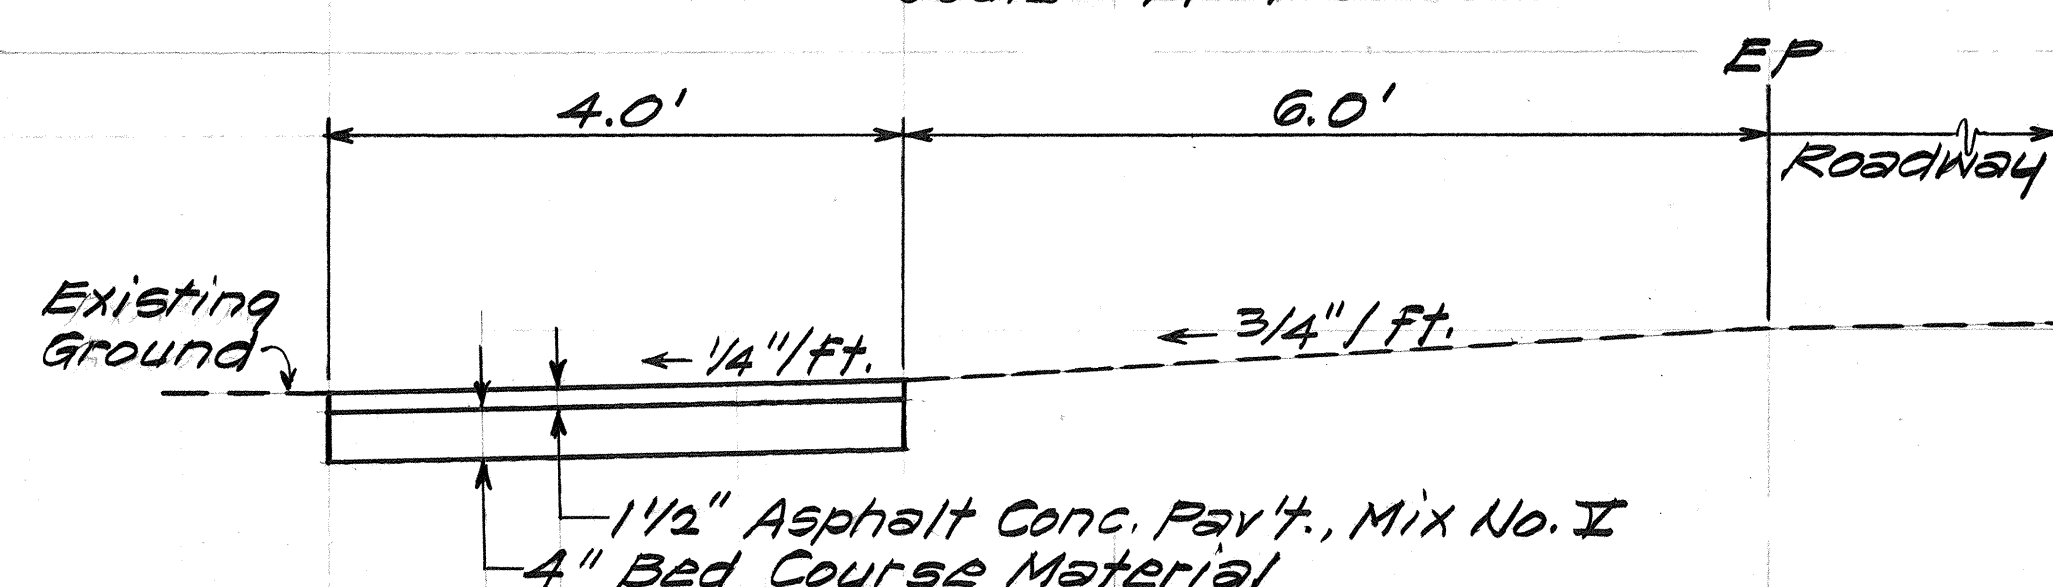

BITUMINOUS SIDEWALK DETAIL PUUPEELUA AVENUE

Scale: 3/4"=1'-0"

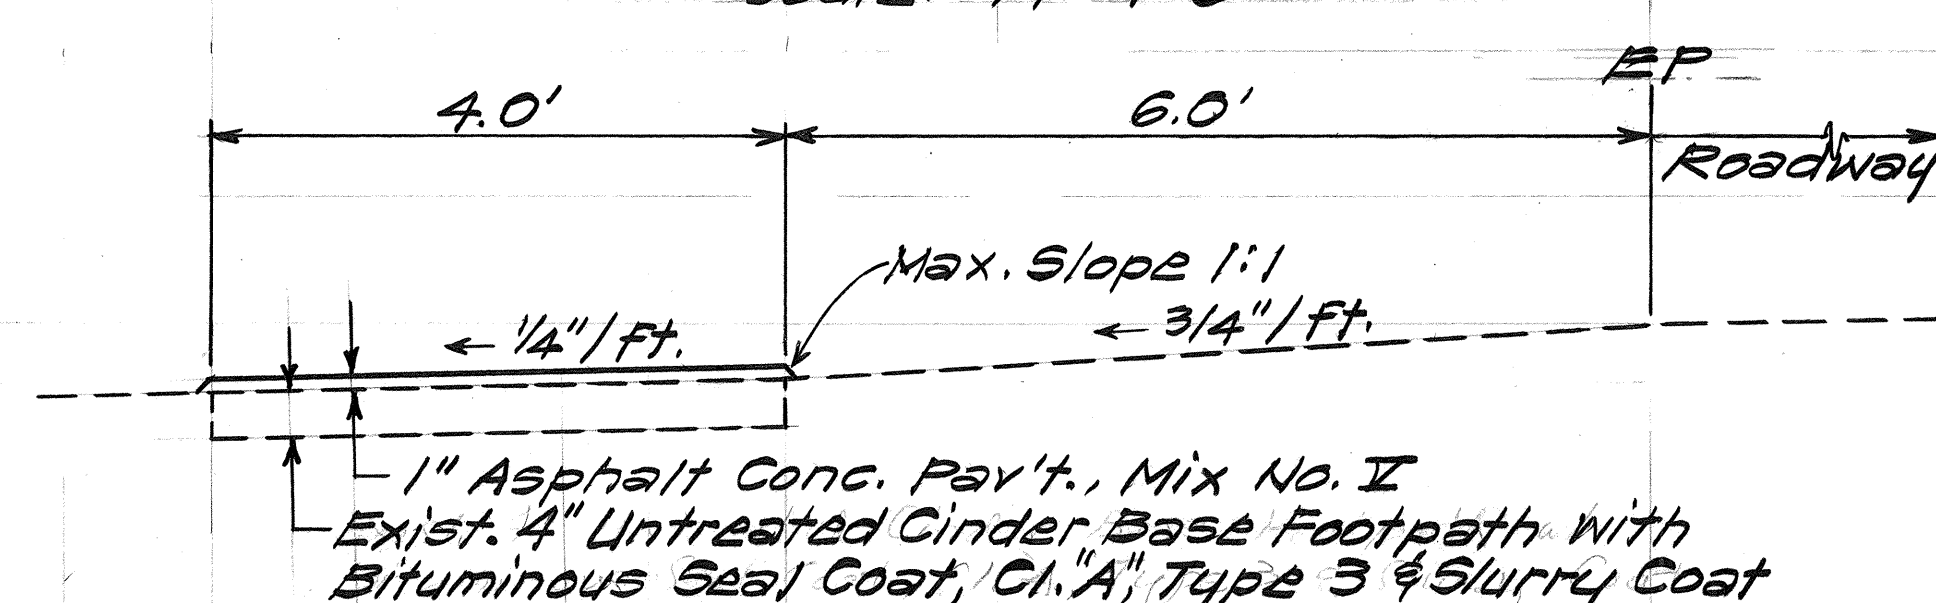

RESURFACING OF EXIST. FOOTPATH DETAIL FARRINGTON AVENUE

Scale: 3/4"=1'-0"

ORIGINAL PLAN	DATE
SURVEY PLOTTED BY	
DRAWN BY	
DESIGNED BY	
CHECKED BY	
NO.	

STATE OF HAWAII DEPARTMENT OF TRANSPORTATION LAND TRANSPORTATION FACILITIES DIVISION	
PLAN-PUUPEELUA AVE.	
GENERAL NOTES & DETAILS	
FARRINGTON AVE. & PUUPEELUA AVE.	
SAFETY IMP. AT VAR. LOCATIONS	
PROJ. NO. 480A-01-83	
Scale: As Shown	Date: Nov, 1983
SHEET NO. 1 OF 1 SHEETS	