
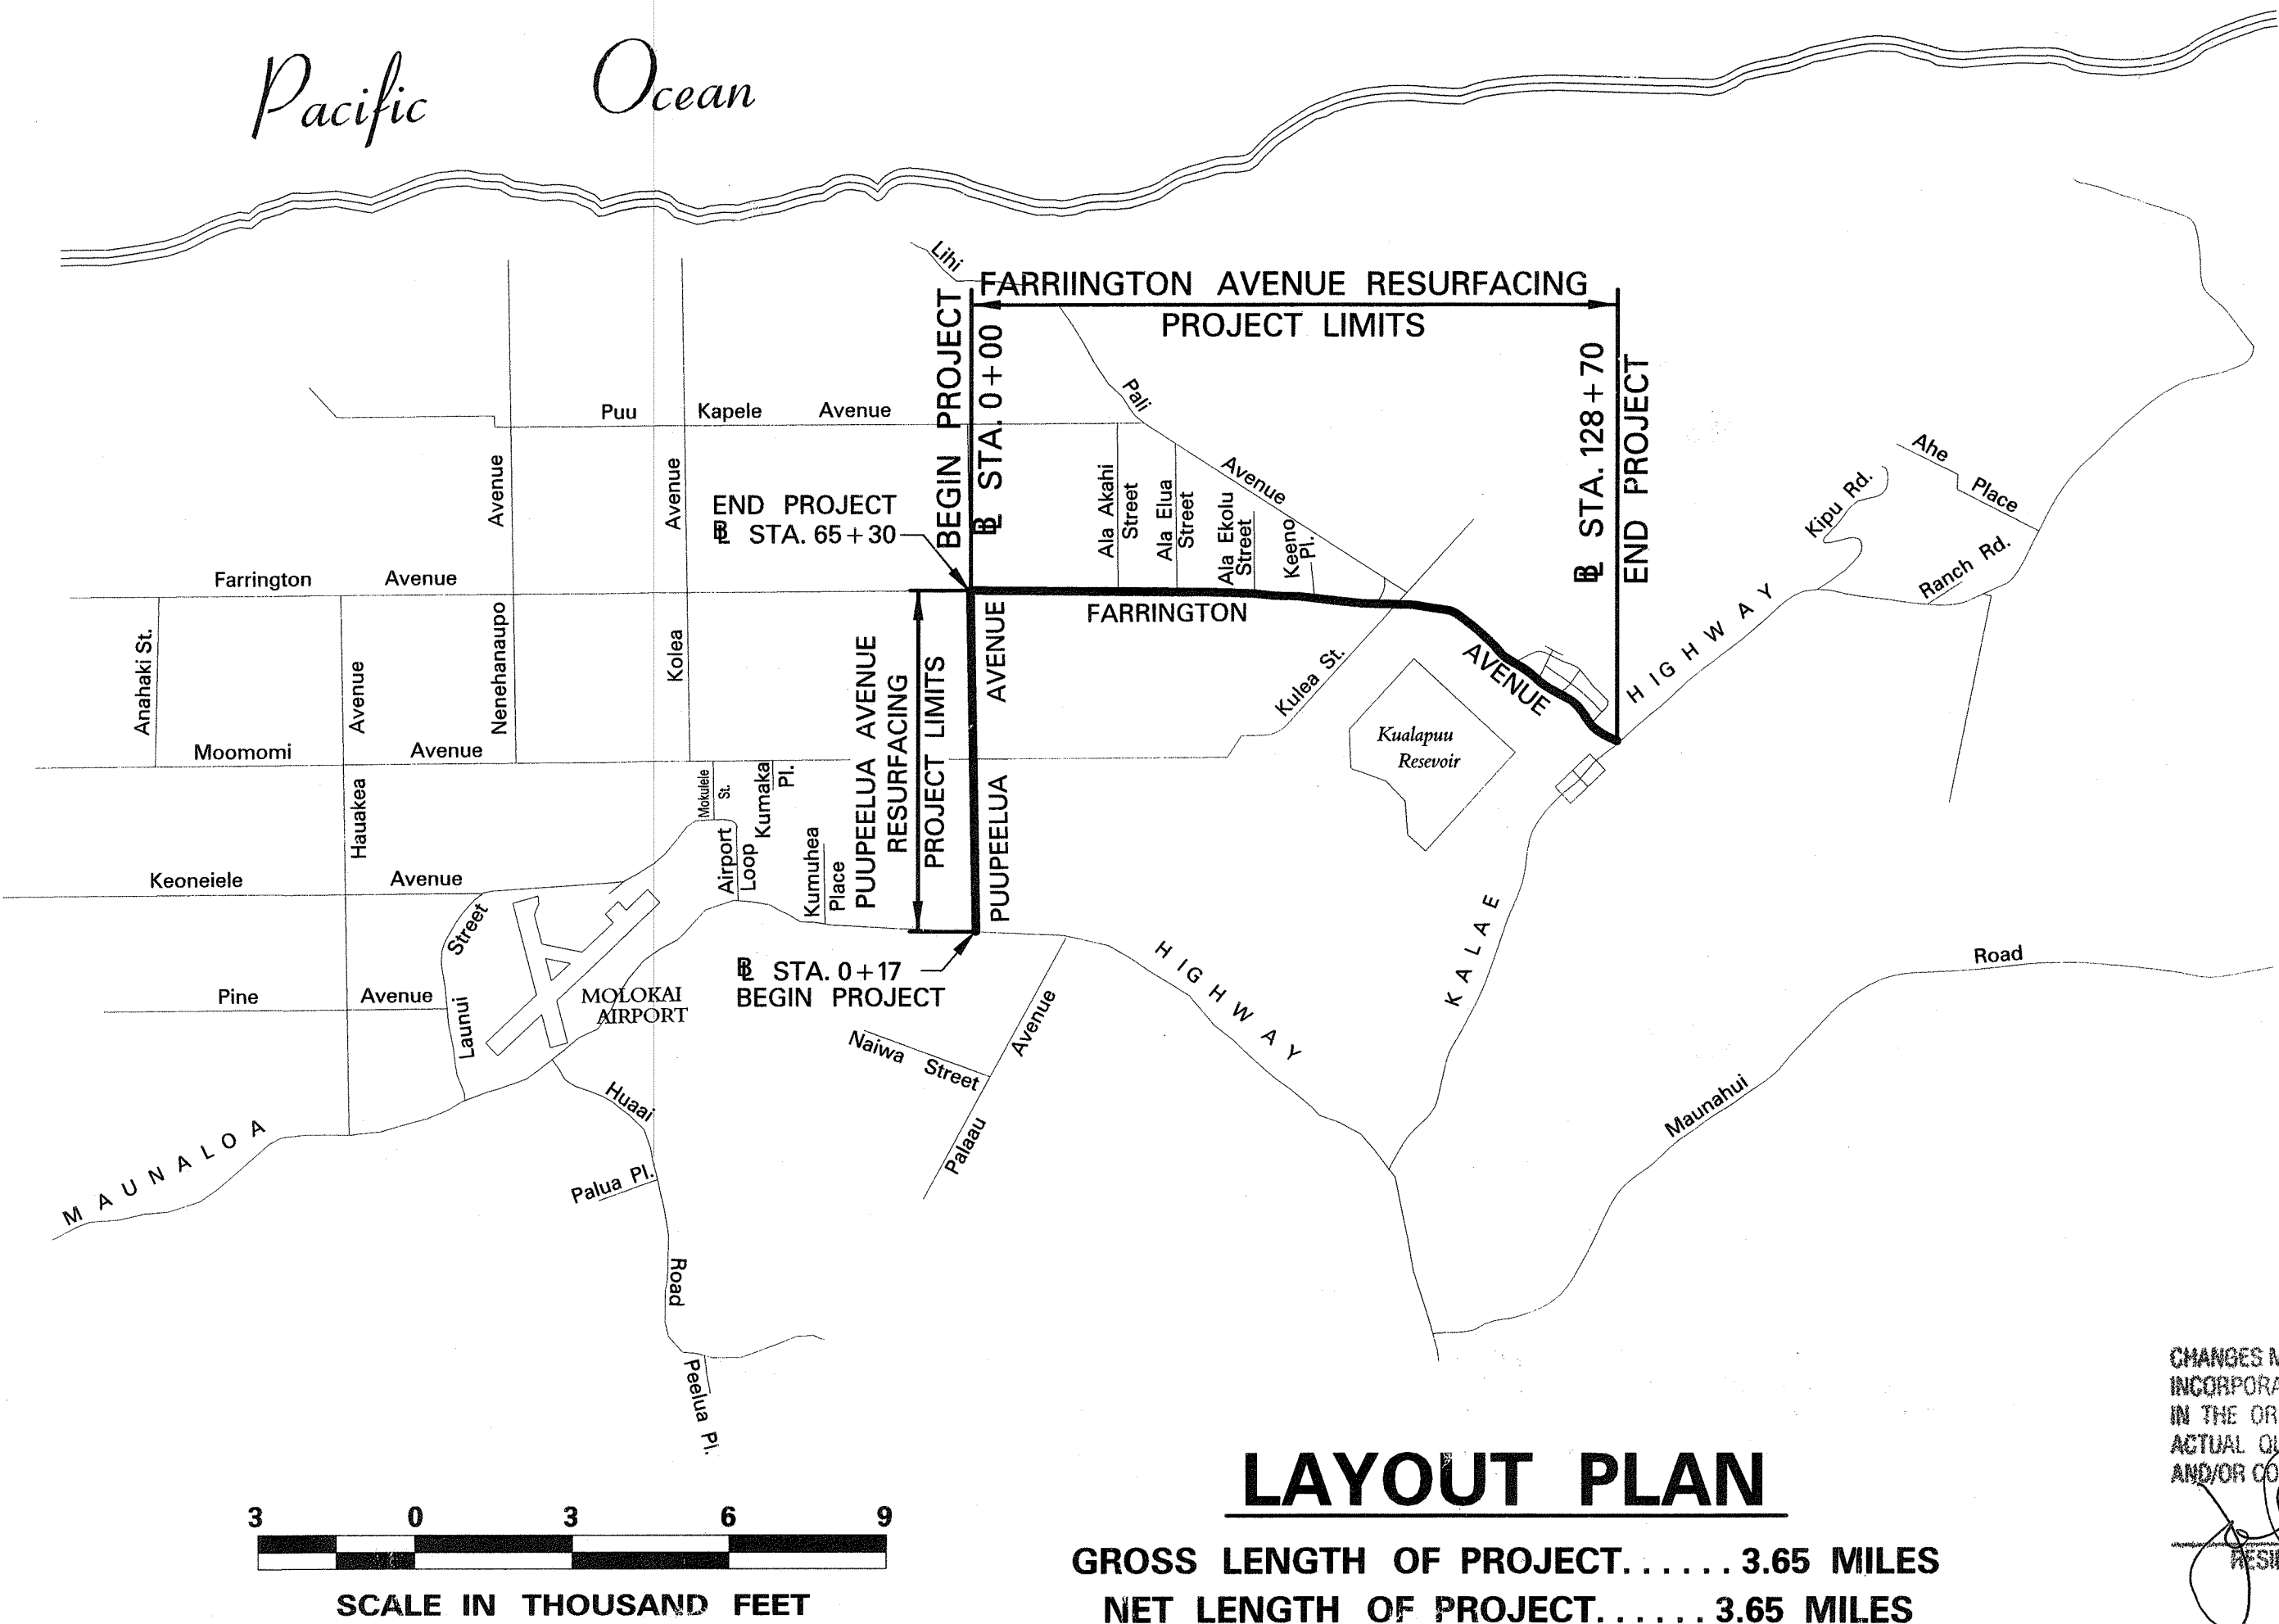
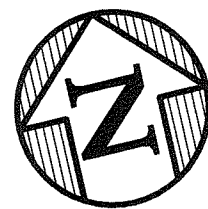
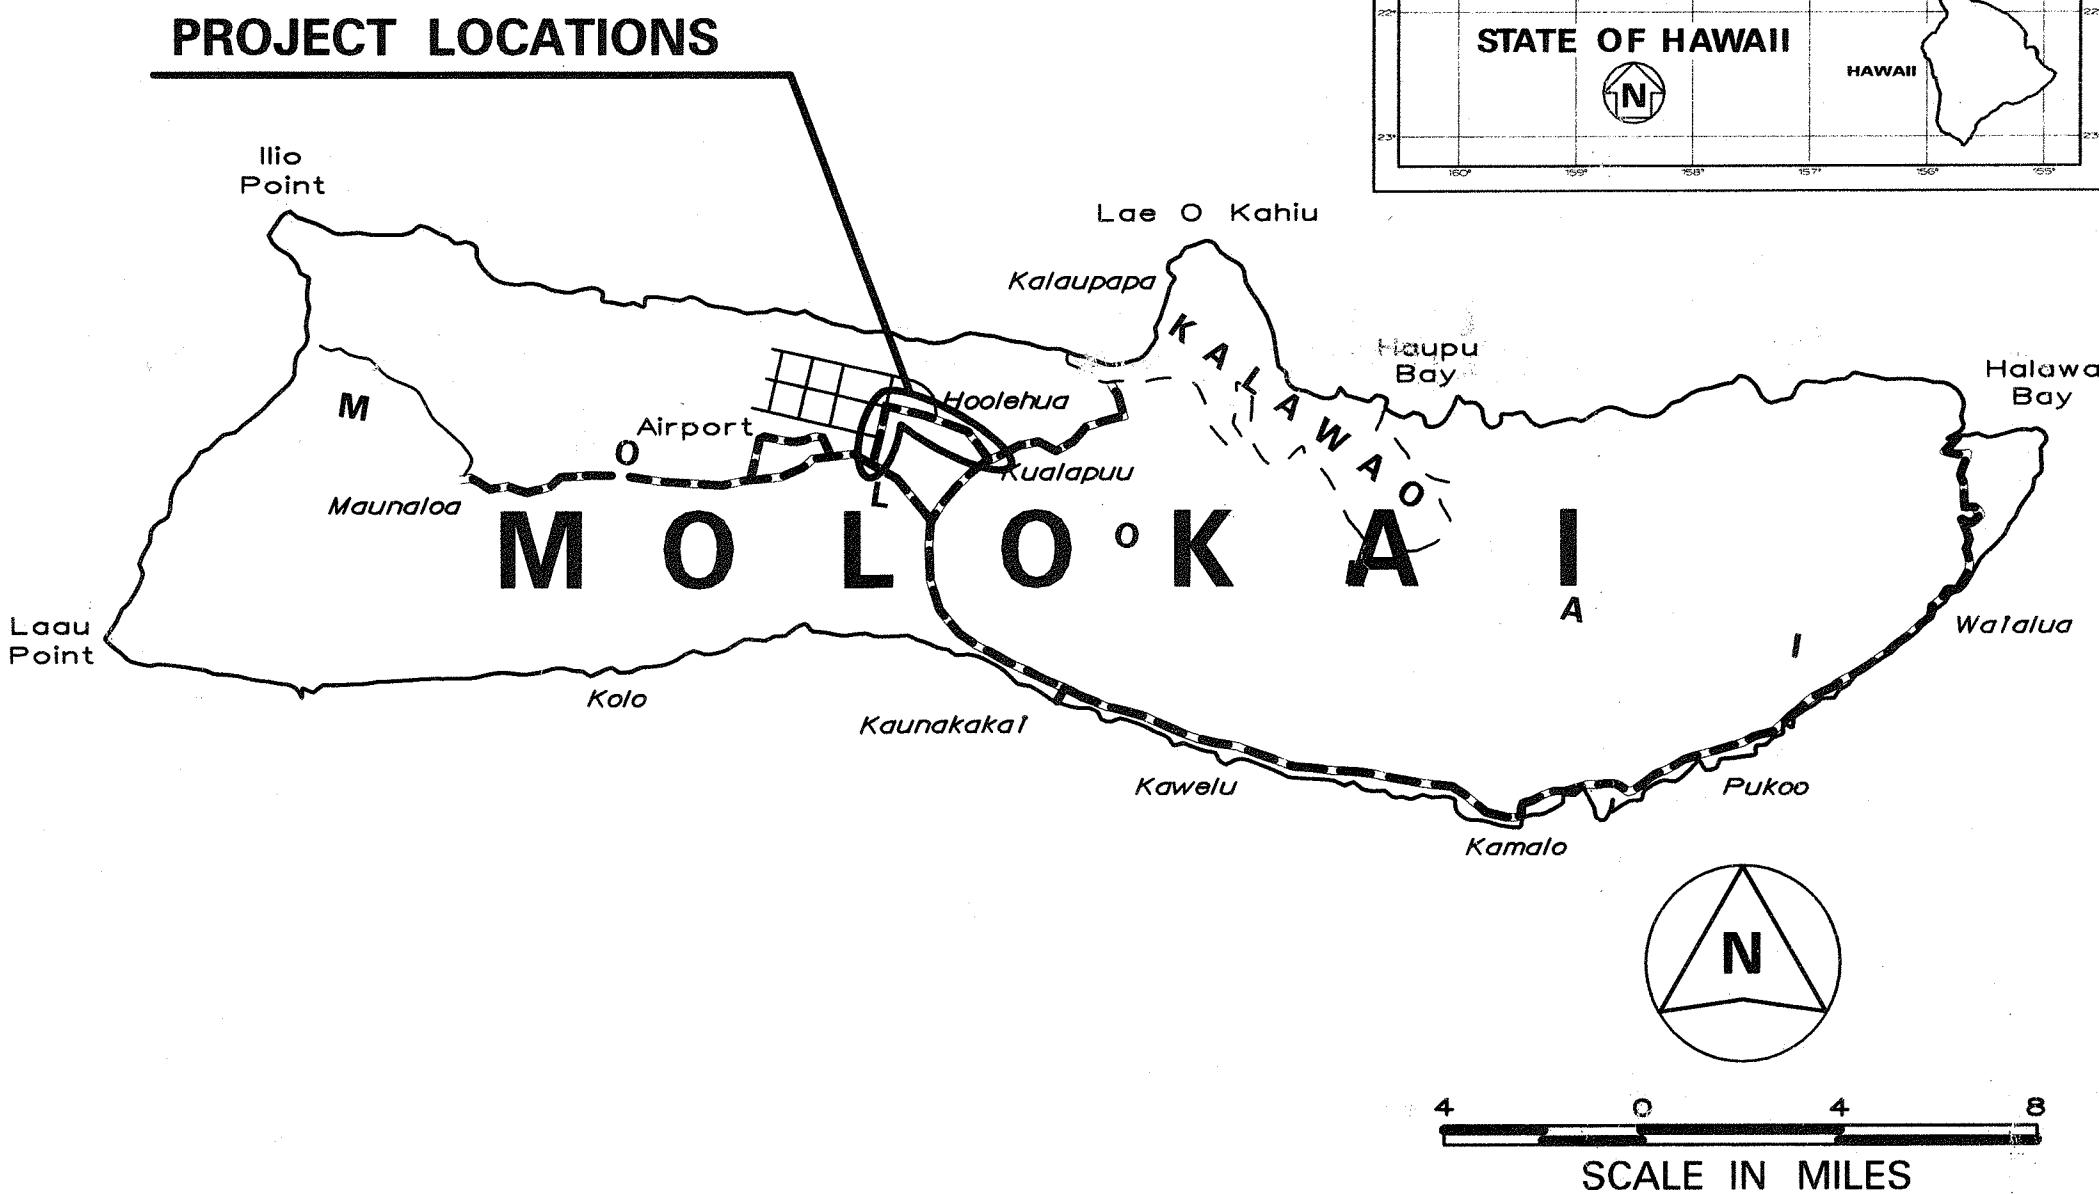


INDEX TO DRAWINGS	
SHEET NO.	DESCRIPTION
1	TITLE SHEET
2	STANDARD PLANS SUMMARY
3	GENERAL NOTES AND LEGEND
4 - 5	WATER POLLUTION & EROSION CONTROL NOTES
6 - 7	TYPICAL SECTIONS AND DETAILS
8 - 9	GUARDRAIL DETAILS
10 - 11	CURB RAMP DETAILS
12 - 20	ROADWAY PLANS
21 - 22	DRAINAGE PLAN AND DETAILS
23	PAVEMENT MARKING LEGEND, DETAILS AND NOTES
24	WORK ZONE SIGNING PLAN, NOTES AND DETAILS
25 - 26	SIGN PANEL LAYOUT AND NOTES
27 - 35	SIGNING AND PAVEMENT MARKING PLANS

STATE OF HAWAII
DEPARTMENT OF TRANSPORTATION
HIGHWAYS DIVISION
HONOLULU, HAWAII
"AS-BUILT"
PLANS FOR
**PUUPEELUA AVENUE RESURFACING
MAUNALOA HIGHWAY TO FARRINGTON AVENUE
AND
FARRINGTON AVENUE RESURFACING
PUUPEELUA AVENUE TO KALAE HIGHWAY
FEDERAL-AID PROJECT NO. ARR-0480(3)**

DISTRICT OF MOLOKAI
ISLAND OF MOLOKAI

FED. ROAD DIST. NO.	STATE	FED. AID PROJ. NO.	FISCAL YEAR	SHEET NO.	TOTAL SHEETS
HAWAII	HAW.	ARR-0480(3)	2009	1	35

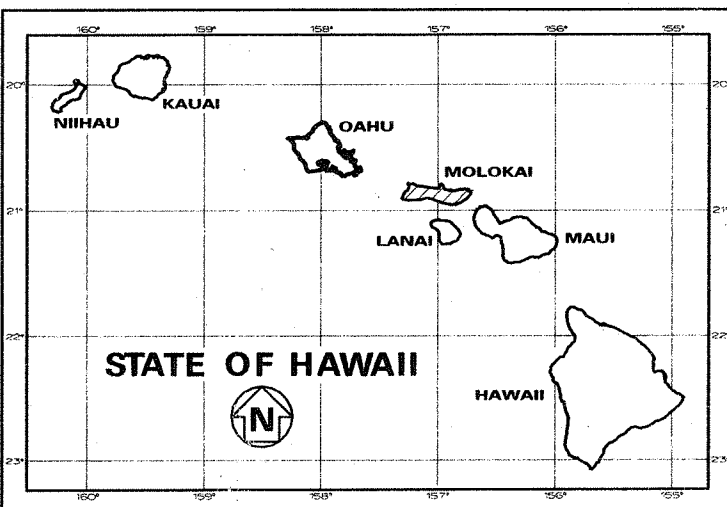

----- FEDERAL AID PROJECTS PREVIOUSLY CONSTRUCTED OR UNDER CONSTRUCTION

FARRINGTON AVENUE MILE POST 0.00 TO MILE POST 2.44
PUUPEELUA AVENUE MILE POST 2.44 TO MILE POST 3.65

DESIGN DESIGNATION		
TRAFFIC DATA	FARRINGTON AVE. KALAE HWY. TO PUUPEELUA AVE.	PUUPEELUA AVE. FARRINGTON AVE. TO MAUNALOA HWY.
ADT (2009)	2,400	1,500
ADT (2019)	2,600	1,600
DHV	360	160
DESIGN K	14.0	10.0
DESIGN D	70/30	60/40
DESIGN T	5.0	5.5
T24	3.0	2.0

LAYOUT PLAN
GROSS LENGTH OF PROJECT..... 3.65 MILES
NET LENGTH OF PROJECT..... 3.65 MILES

CHANGES MADE DURING CONSTRUCTION HAVE BEEN INCORPORATED ON THESE PLANS EXCEPT CHANGES IN THE ORIGINAL THEORETICAL QUANTITIES. FOR ACTUAL QUANTITIES, REFER TO PROJECT LEDGER AND/OR COMPUTATION BOOK.

[Signature] 7/13/10
RESIDING ENGINEER DATE

DEPARTMENT OF TRANSPORTATION
STATE OF HAWAII
APPROVED: *[Signature]* 8/25/09
DIR. OF TRANSPORTATION DATE

DESIGNED BY _____ HWY-M MANAGED BY _____ FEB. 2009 DATE
873-3535 PHONE