


FINAL SURVEY
NOTE BOOK
NO.

ORIGINAL SURVEY
NOTE BOOK
NO.

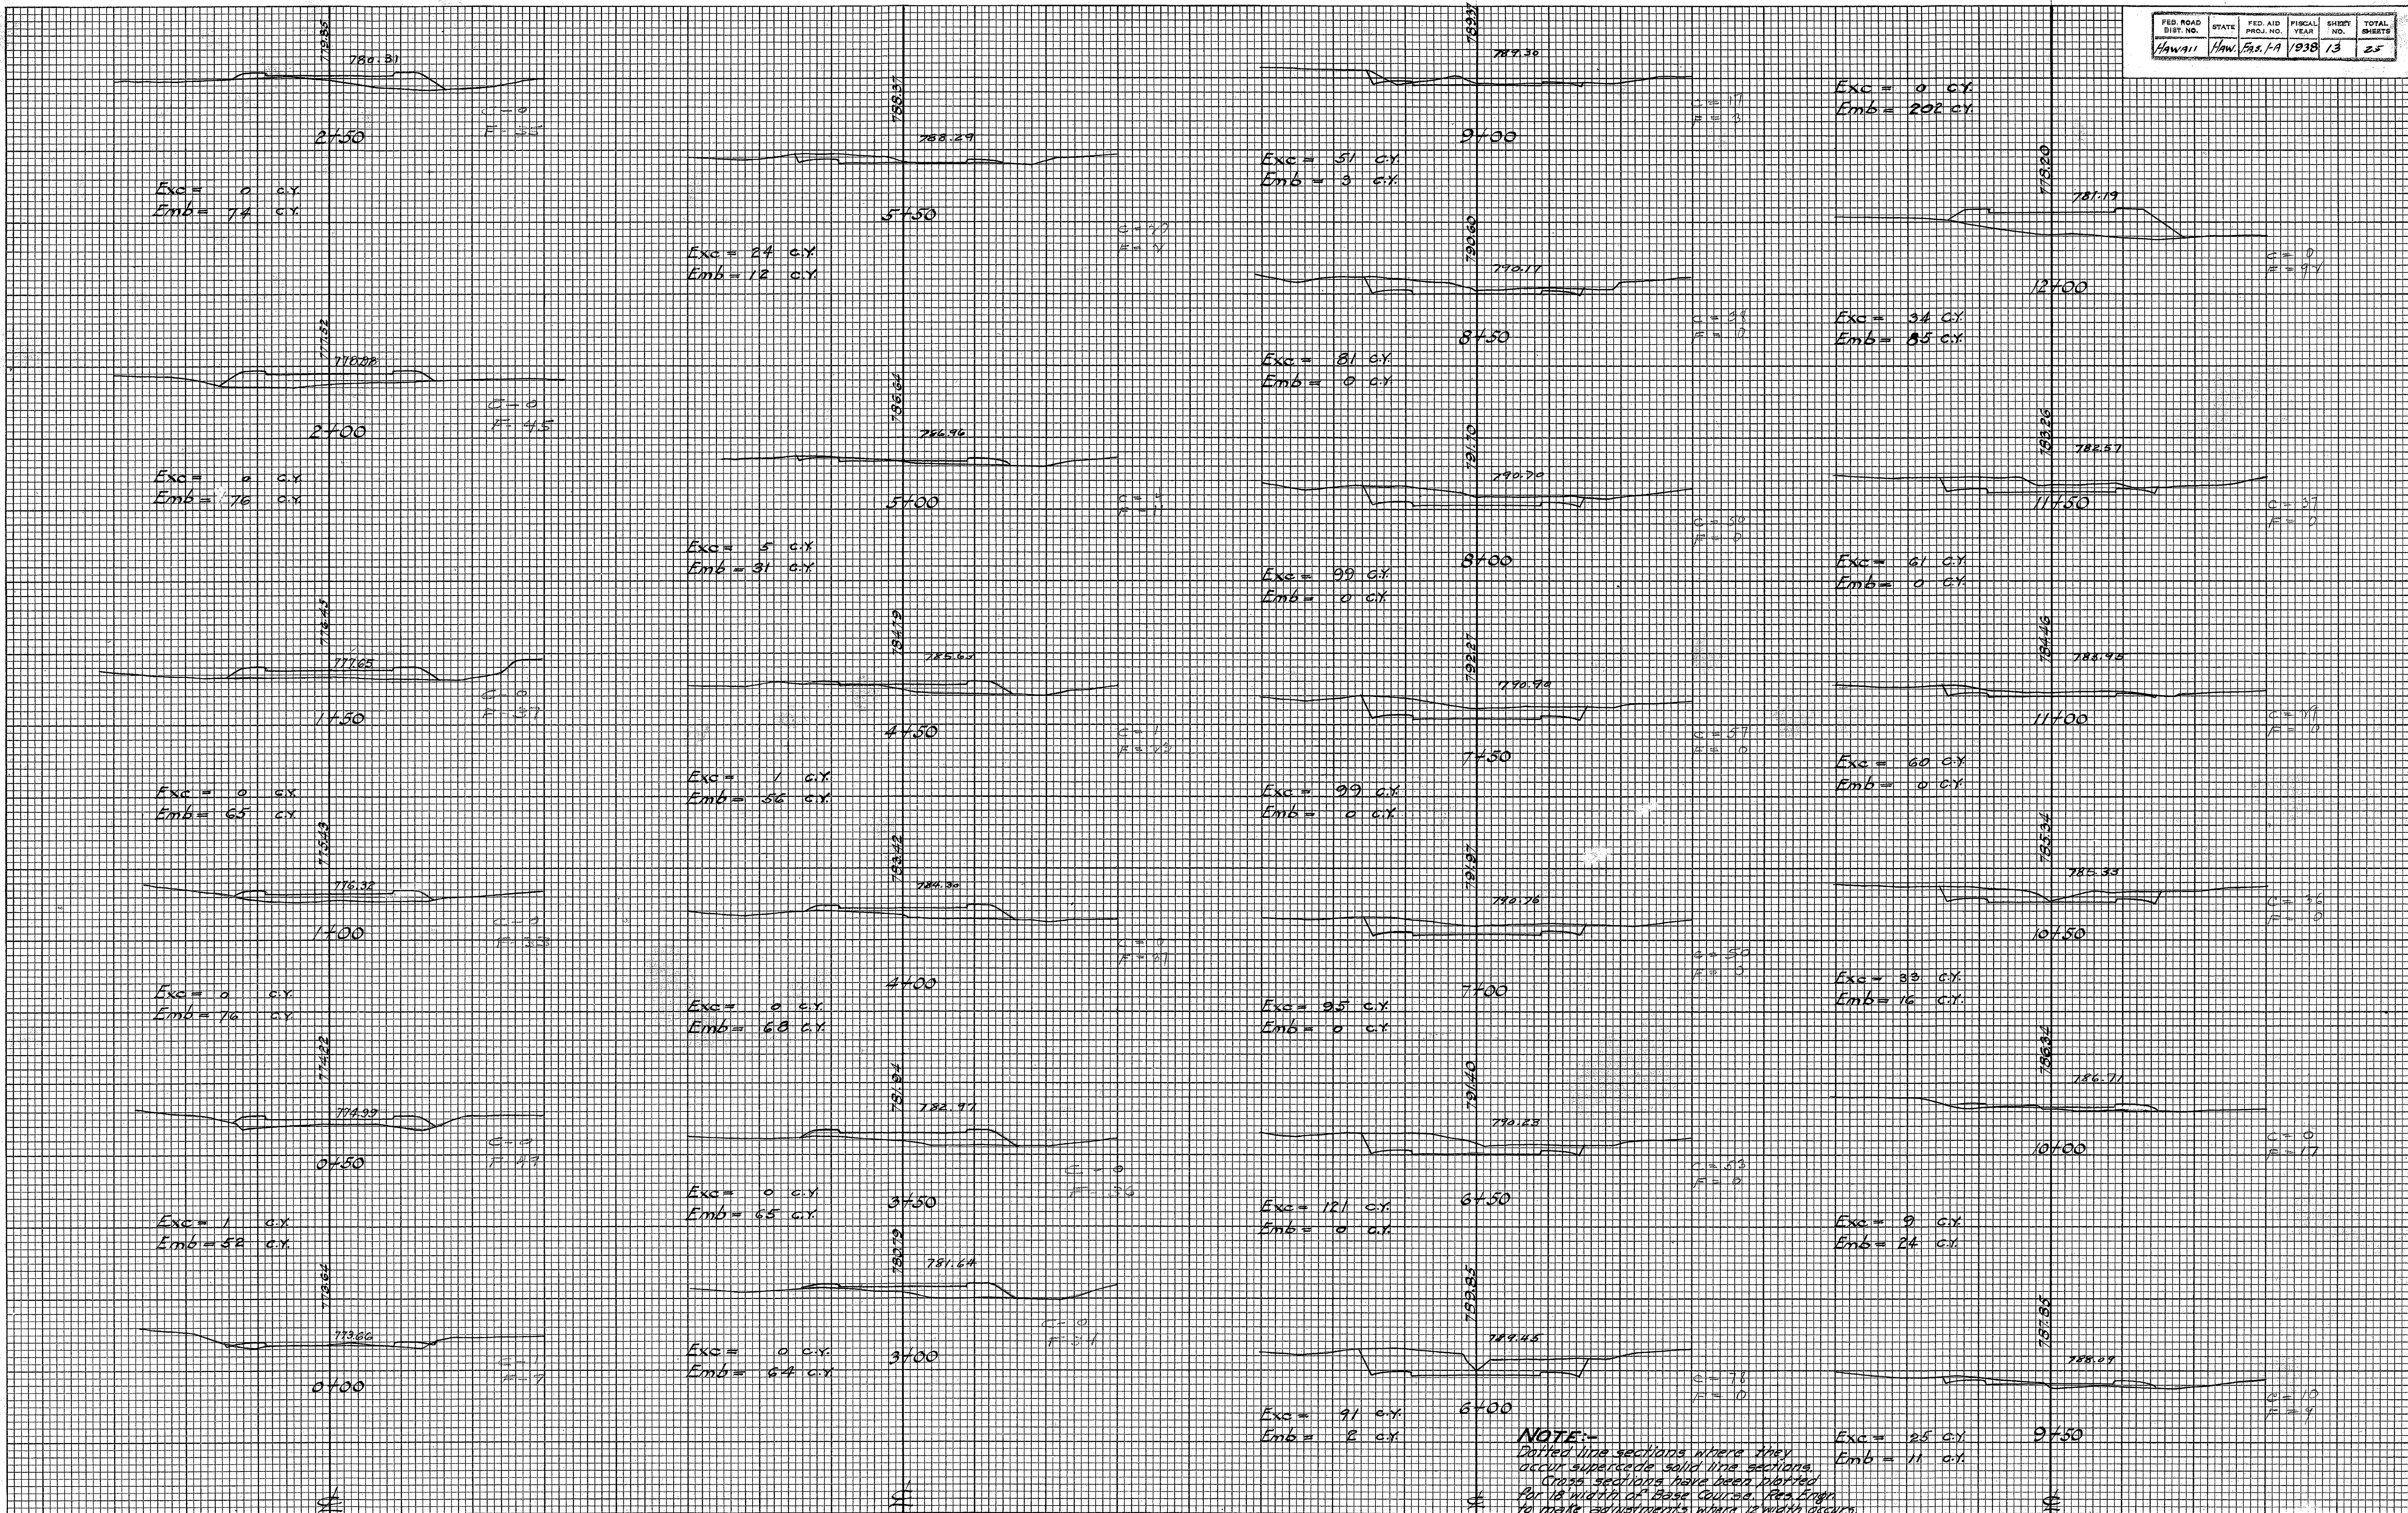

NOTE:-
Dotted line sections where they occur supersede solid line sections.
Cross sections have been plotted for 12' width of Base Course. Res. Eng. to make adjustments where 12' width occurs.

FINAL SURVEY
NOTE BOOK
NO.


DATE
BY


SURVEYED
TEMPLATE
AREAS
CHECKED

ORIGINAL SURVEY
NOTE BOOK
NO.

DATE
BY


SURVEYED
TEMPLATE
AREAS
CHECKED

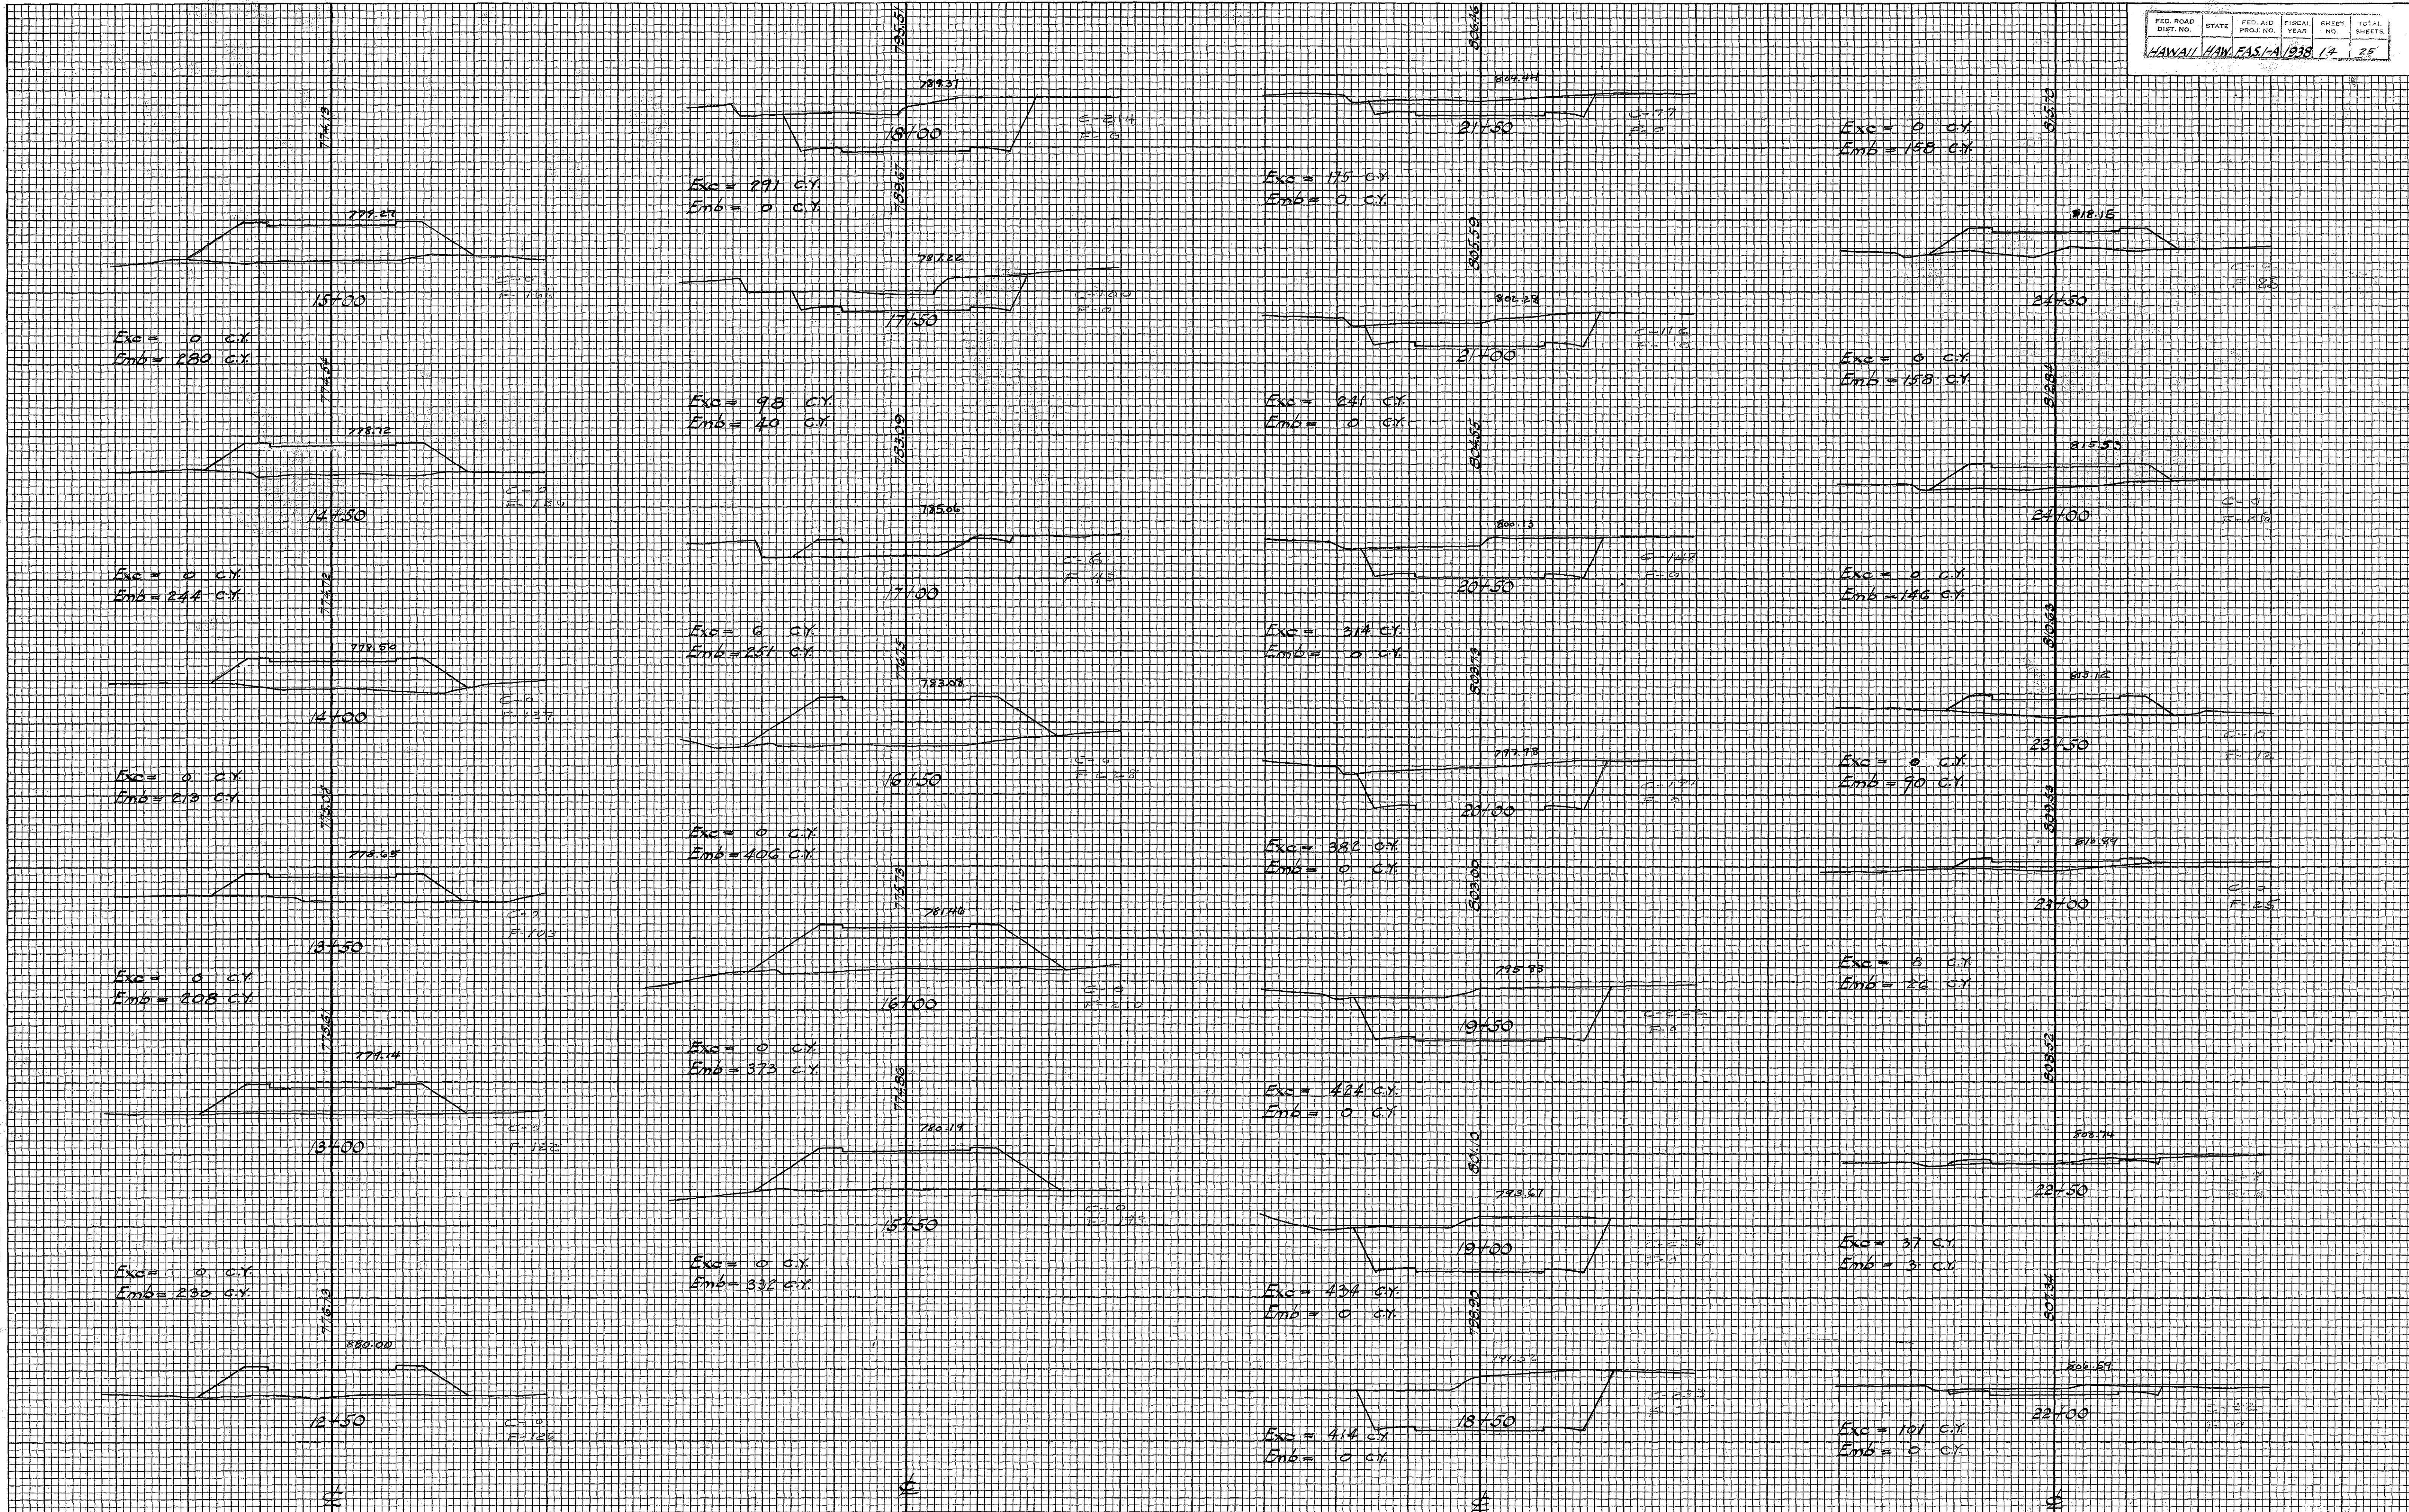

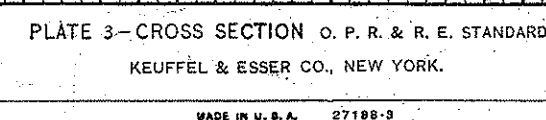


DATE	BY	NO.
FINAL SURVEY	SURVEYED	PLOTTED
	NOTE BOOK	TEMPLATE
	NO.	AREAS CHECKED

DATE	BY	NO.
ORIGINAL SURVEY	SURVEYED	PLOTTED
	NOTE BOOK	TEMPLATE
	NO.	AREAS CHECKED

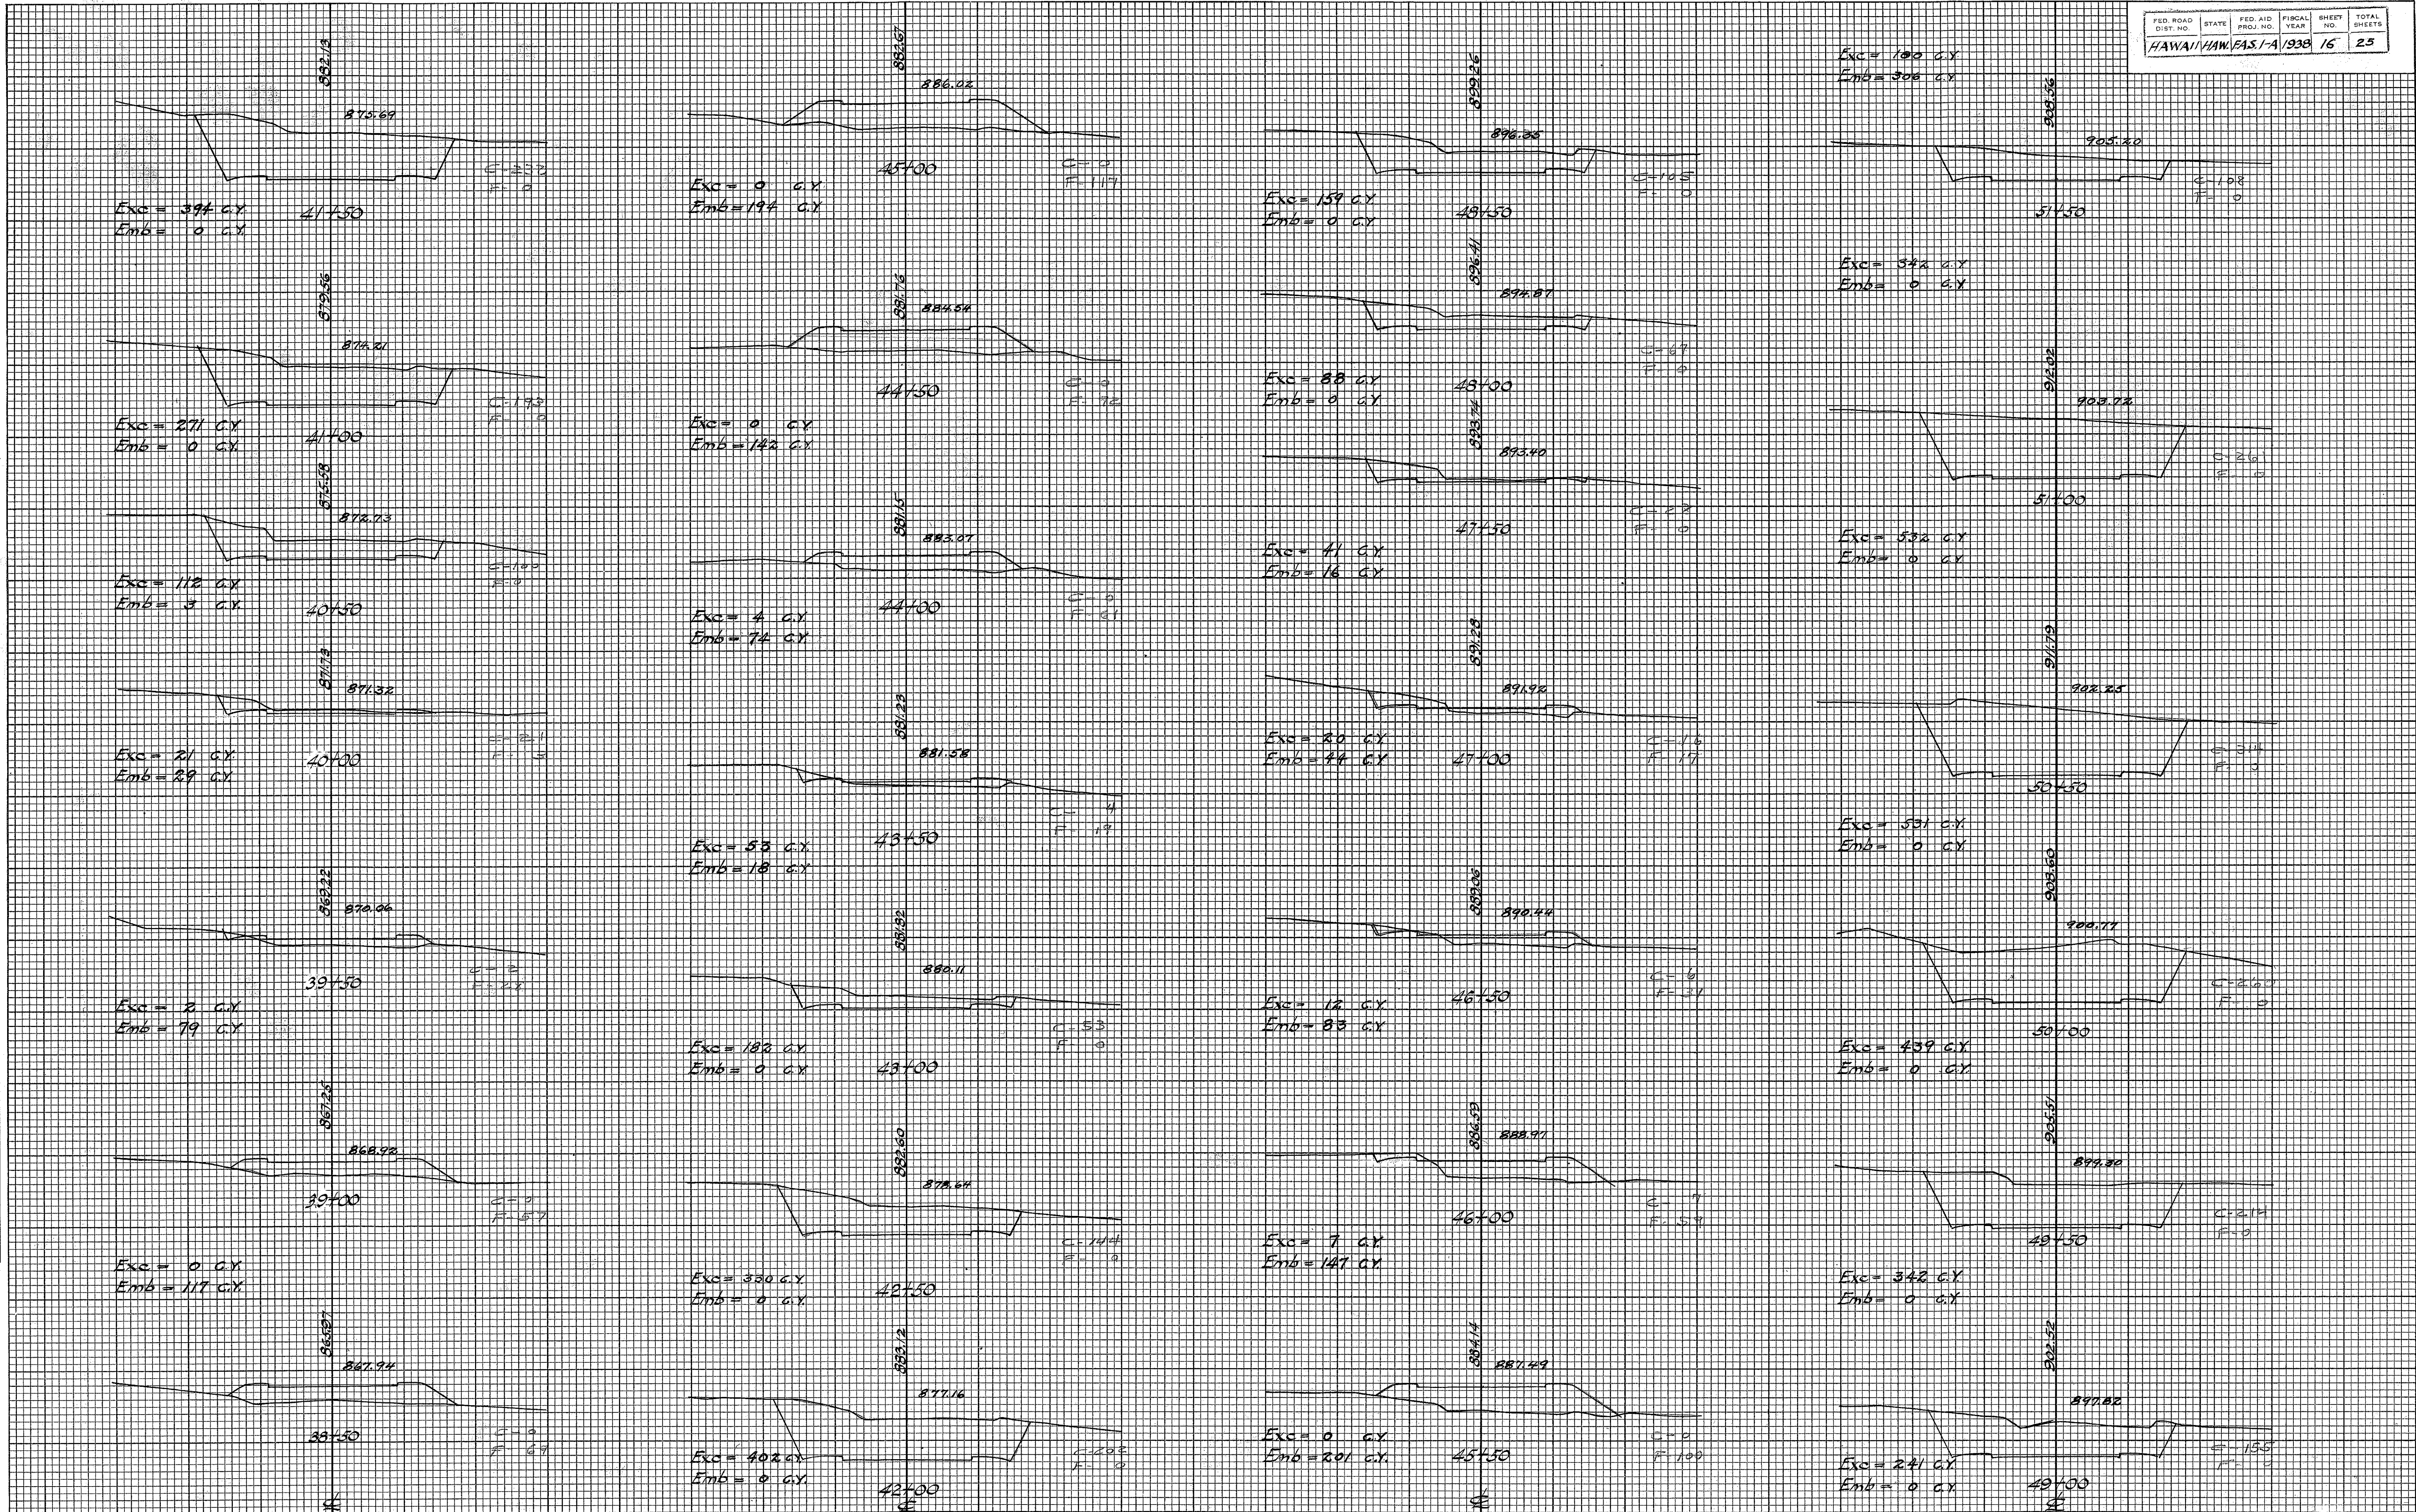


FINAL SURVEY	SURVEYED	DATE
NOTE BOOK	PLOTTED	BY
NO.	TEMPERATURE	
	AREAS CHECKED	

ORIGINAL SURVEY	SURVEYED	DATE
NOTE BOOK	PLOTTED	BY
NO.	TEMPERATURE	
	AREAS CHECKED	

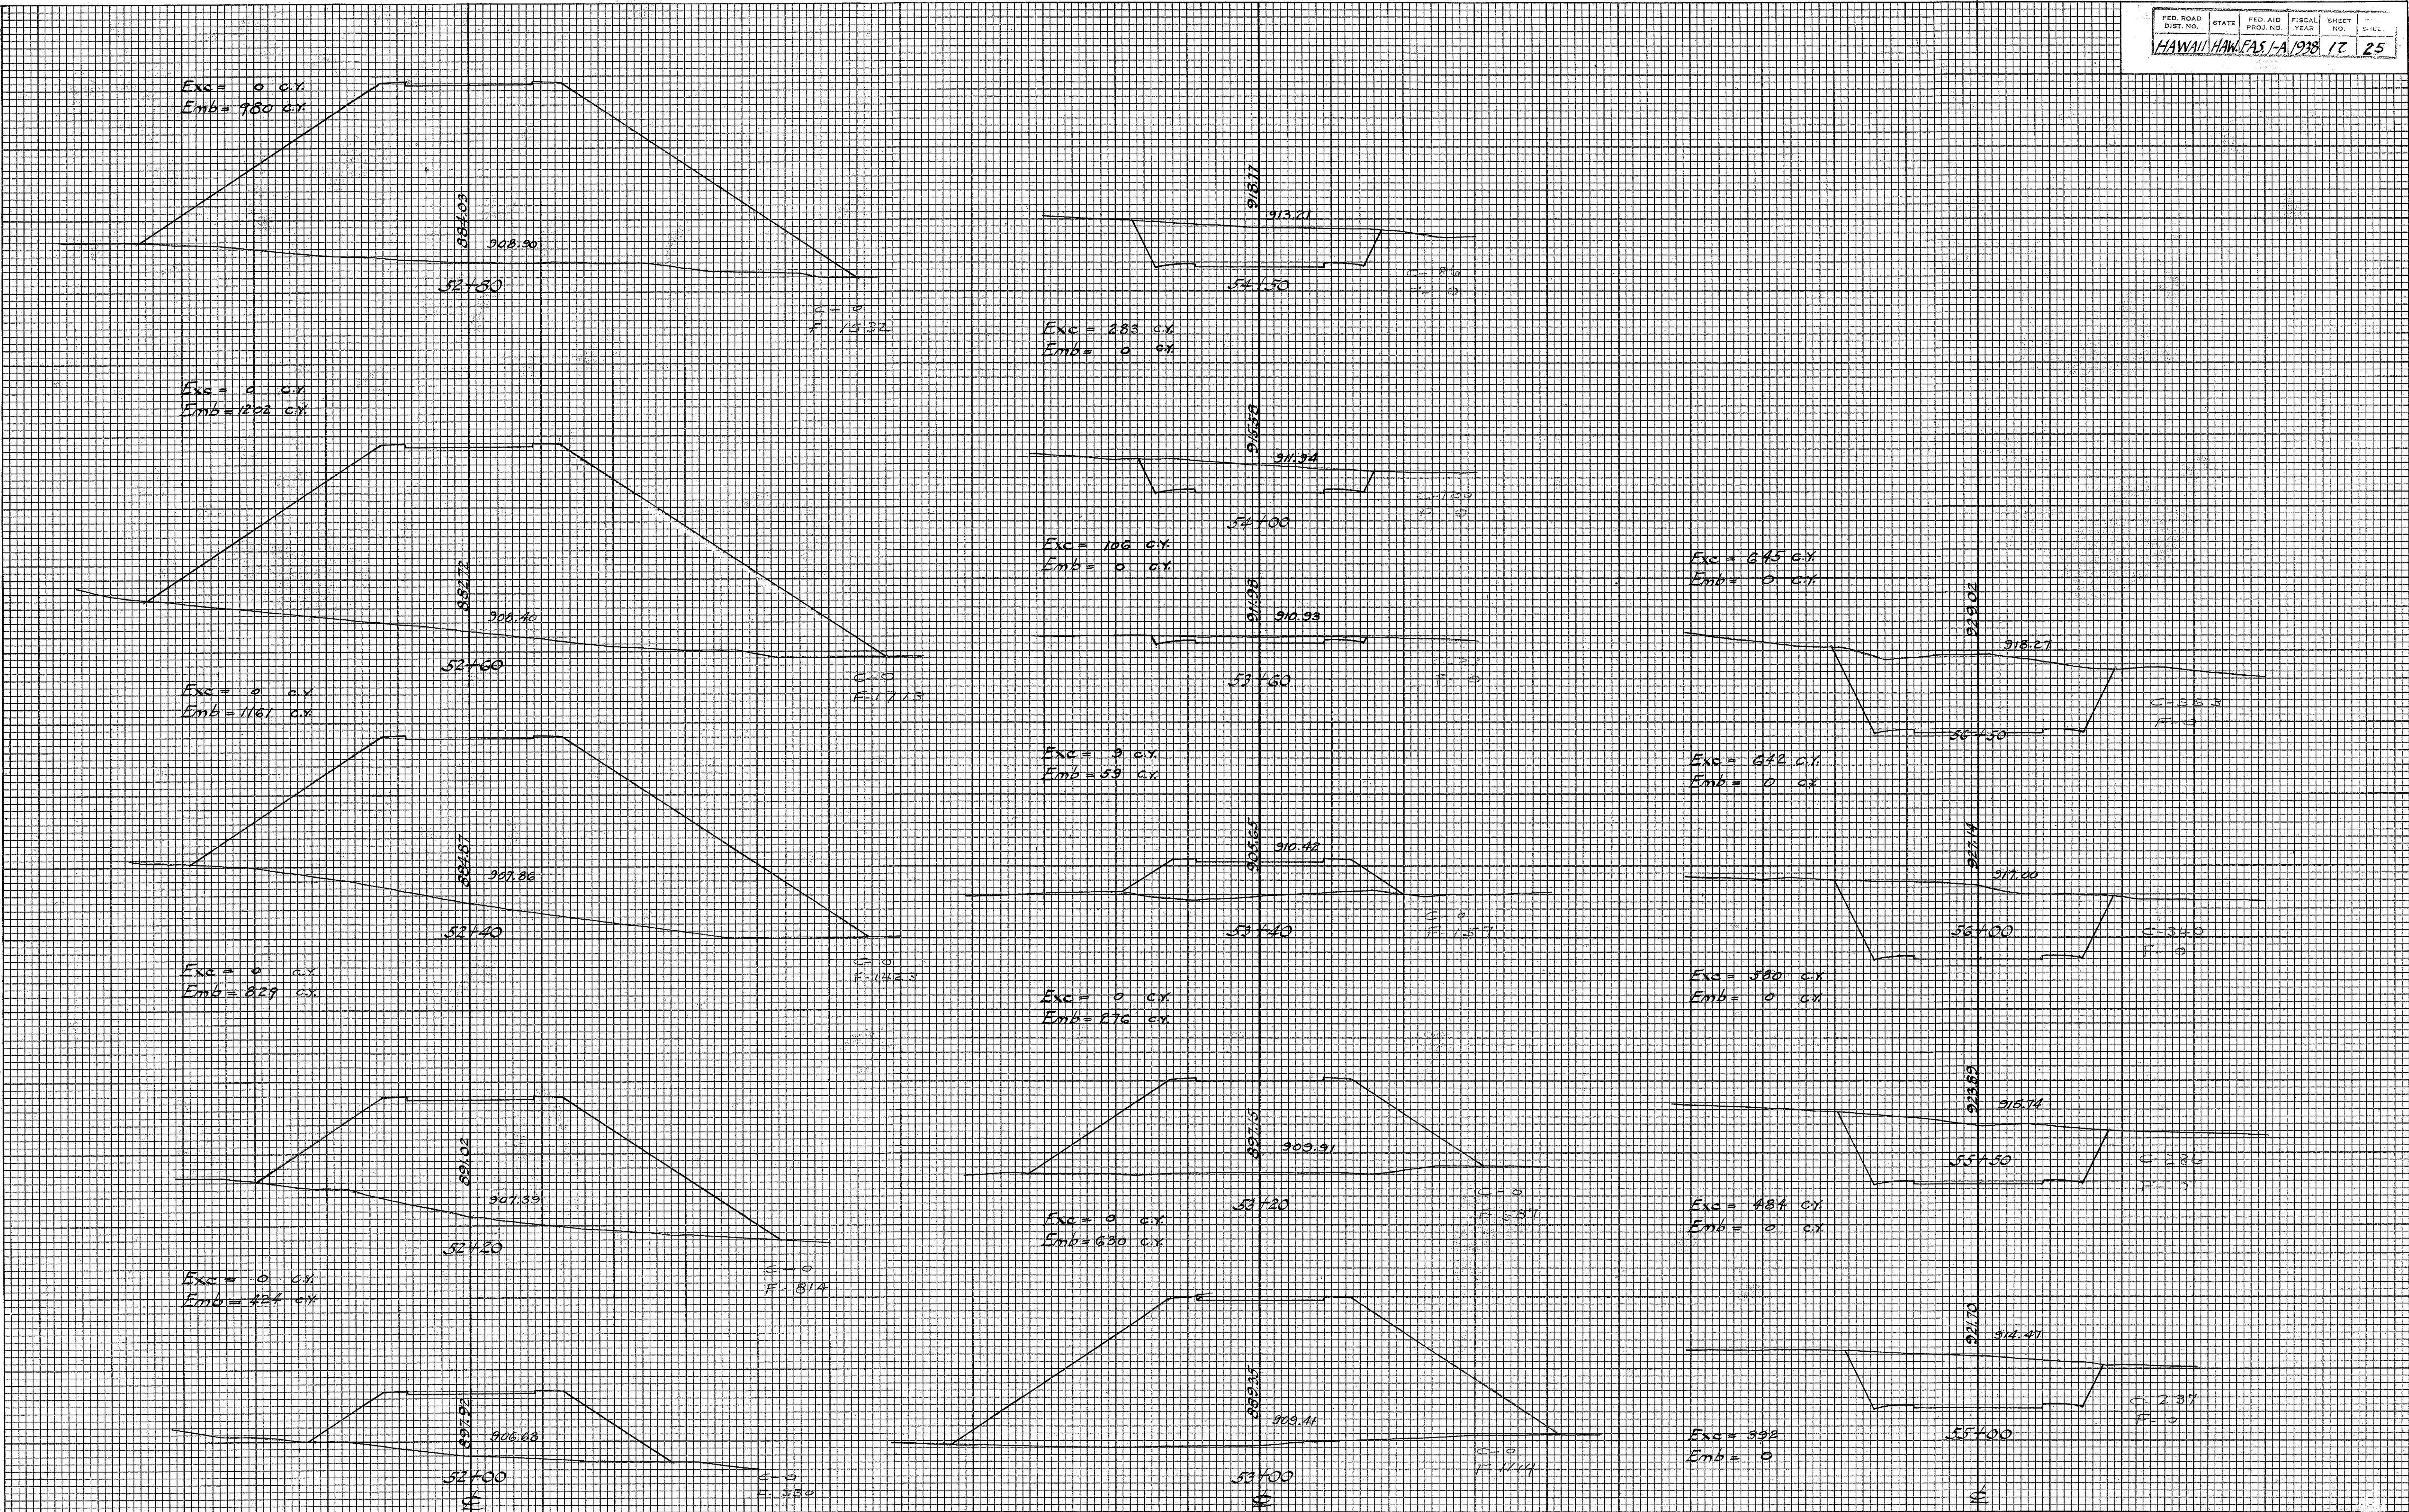


FINAL SURVEY	SURVEYED	DATE
	PLANNED	BY
	NOTE BOOK	NO.
	AREAS CHECKED	

ORIGINAL SURVEY	SURVEYED	DATE
	PLANNED	BY
	NOTE BOOK	NO.
	AREAS CHECKED	

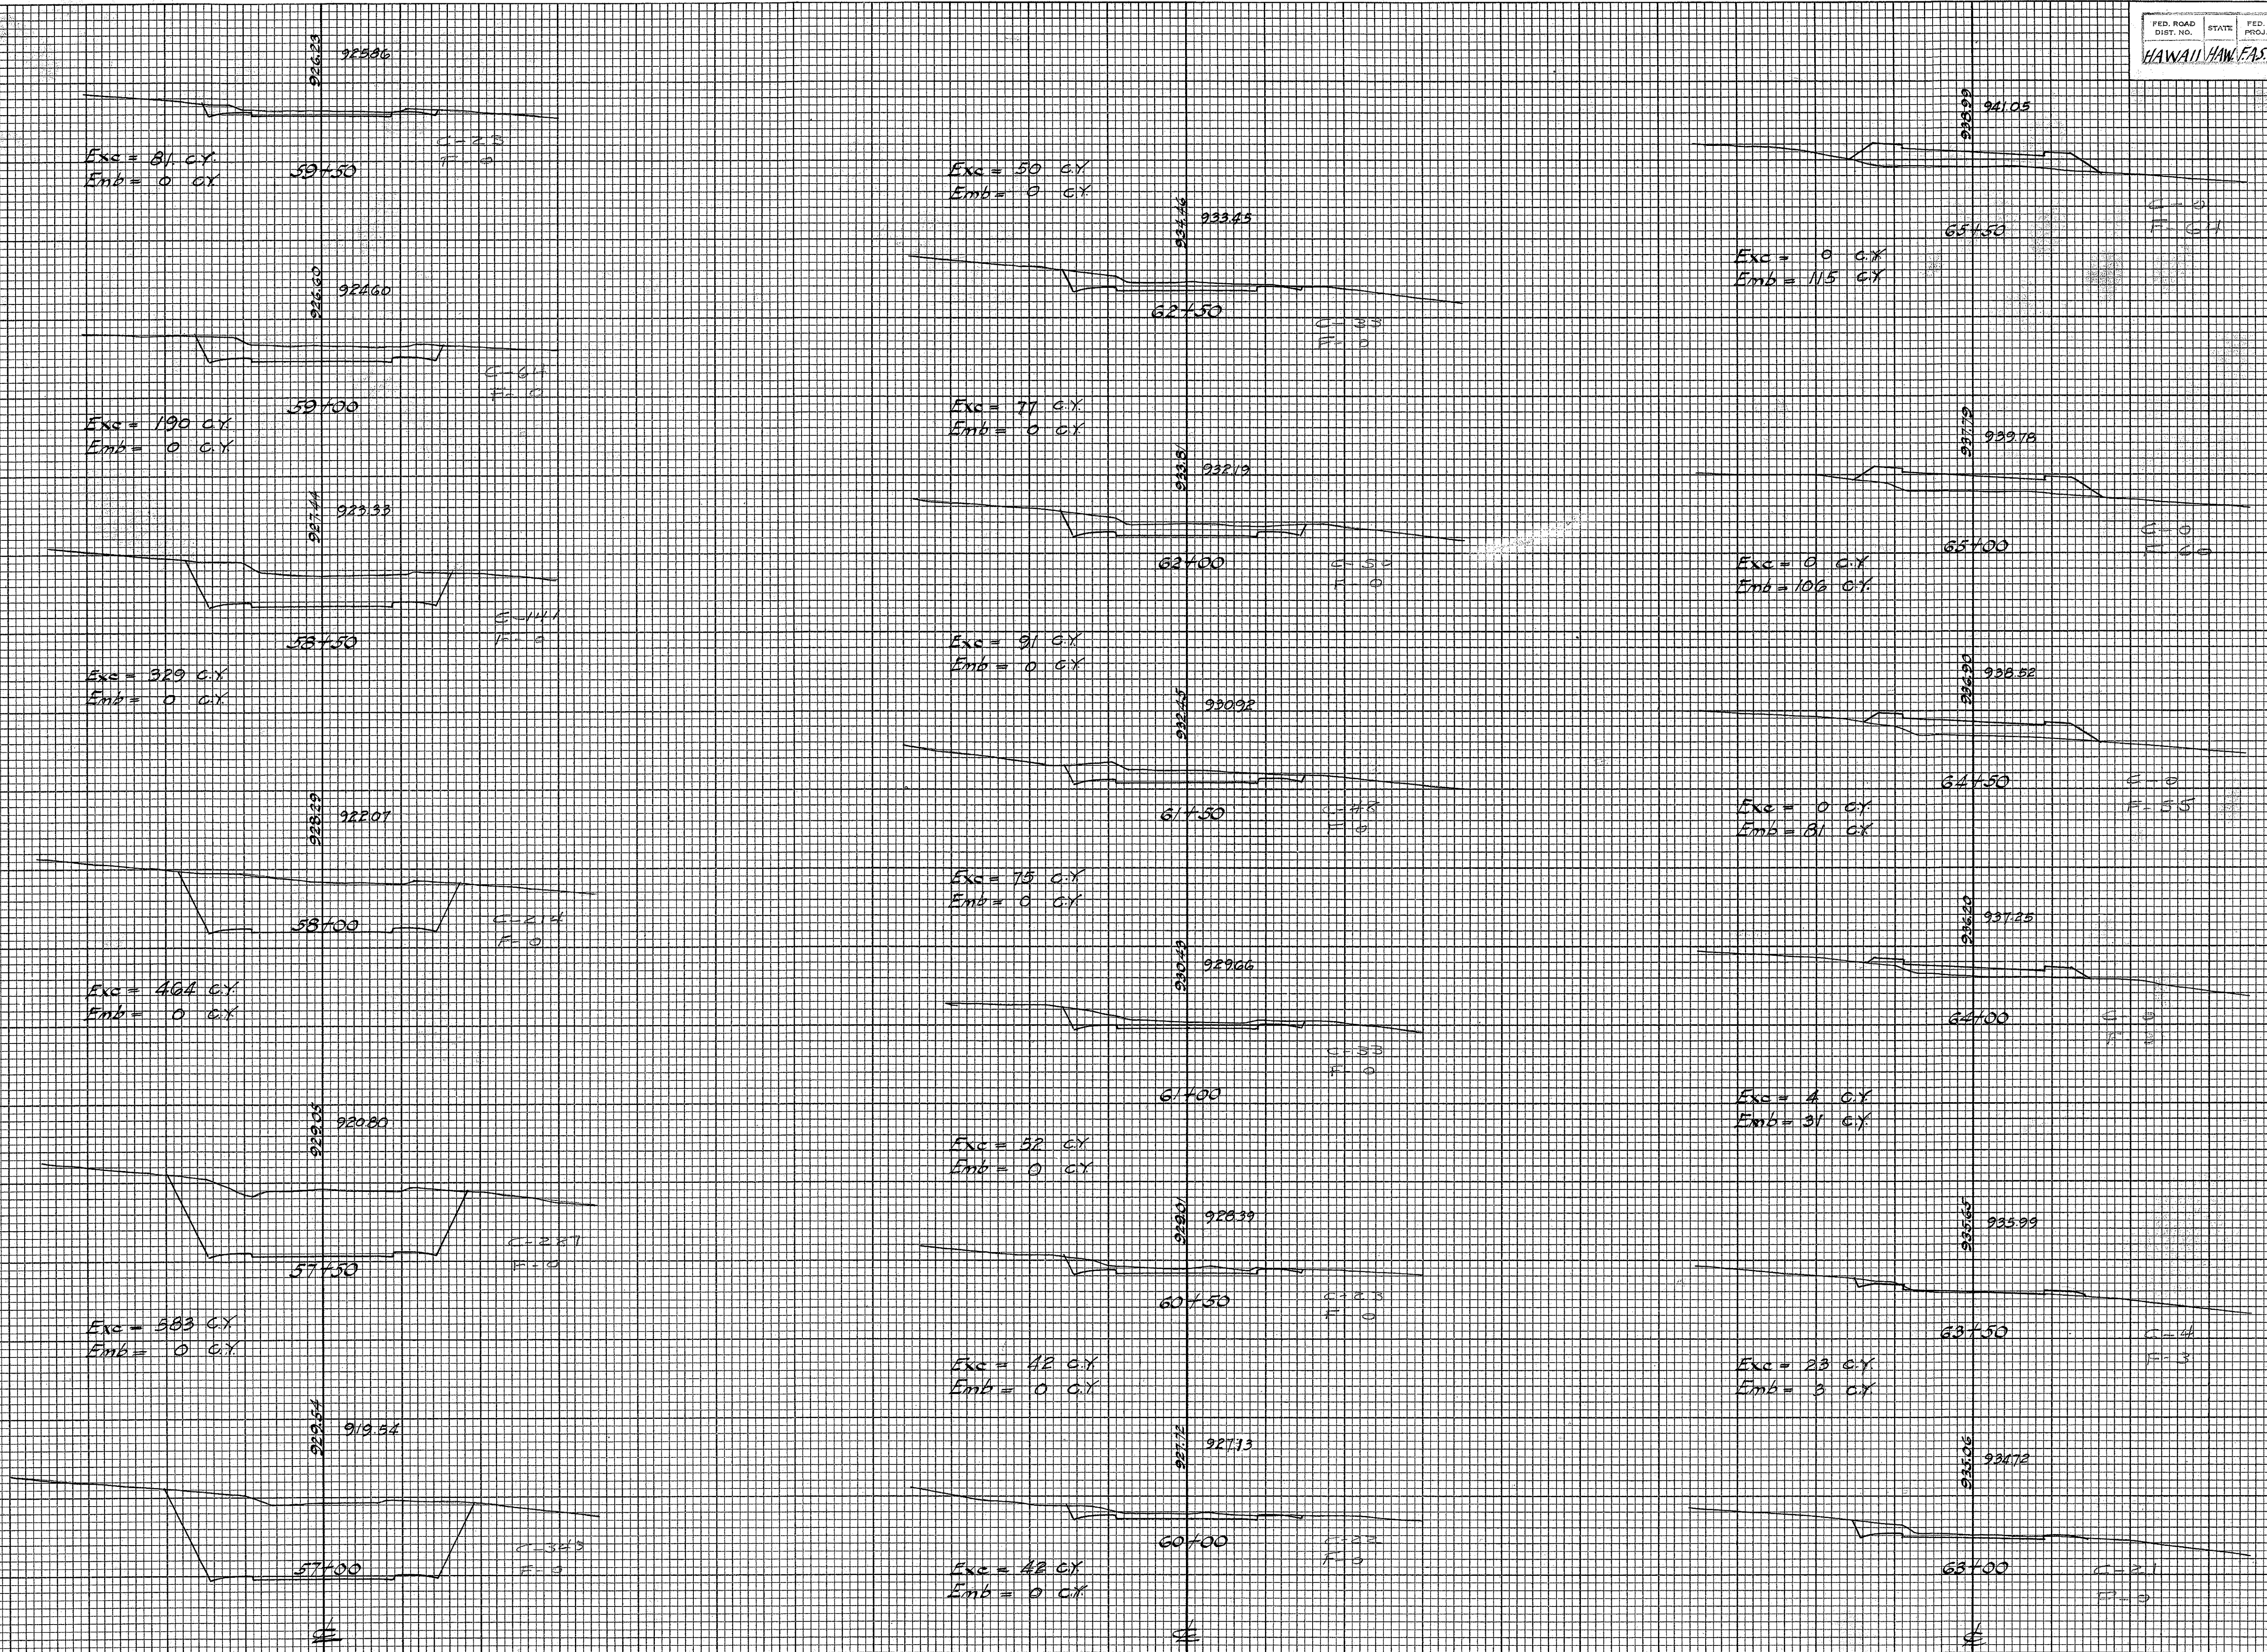


FINAL SURVEY	SURVEYED	DATE
NOTE BOOK	PLOTTED	BY
NO.	AREAS CHECKED	


ORIGINAL SURVEY	SURVEYED	DATE
NOTE BOOK	PLOTTED	BY
NO.	AREAS CHECKED	

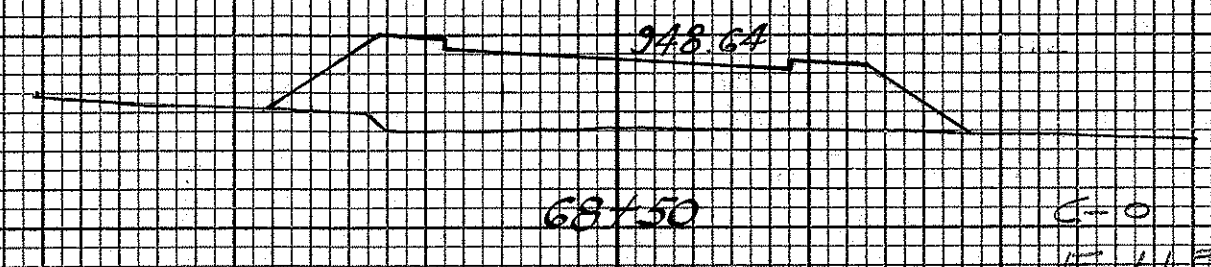


Exc = 0 cy
Emb = 224 cy

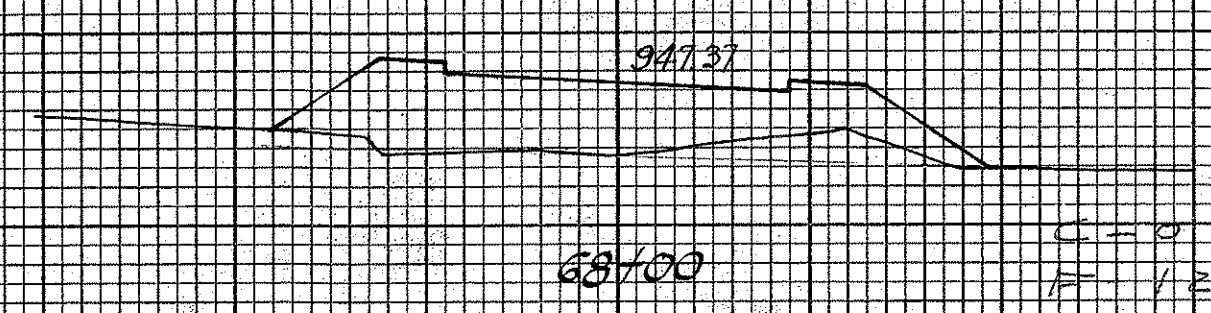


Exc = 0 cy
Emb = 222 cy

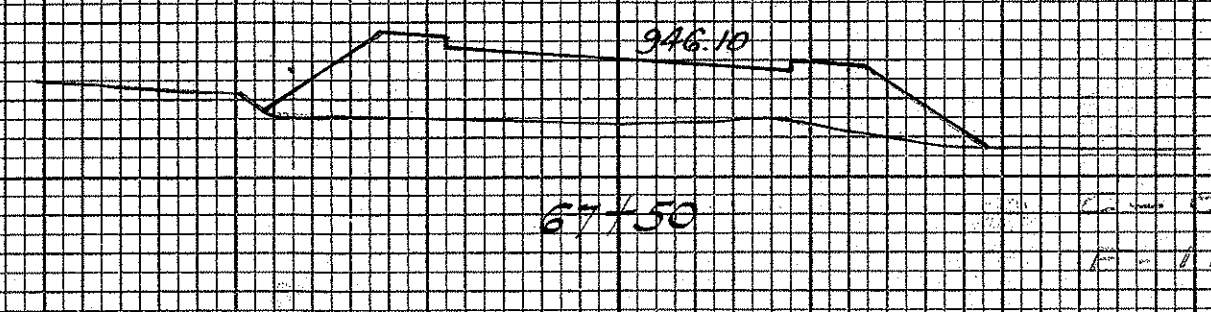


Exc = 0 cy
Emb = 221 cy

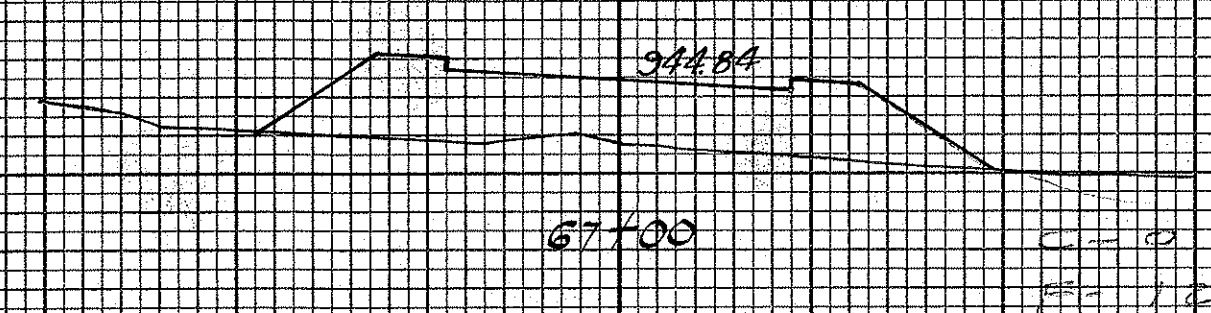


Exc = 0 cy
Emb = 219 cy

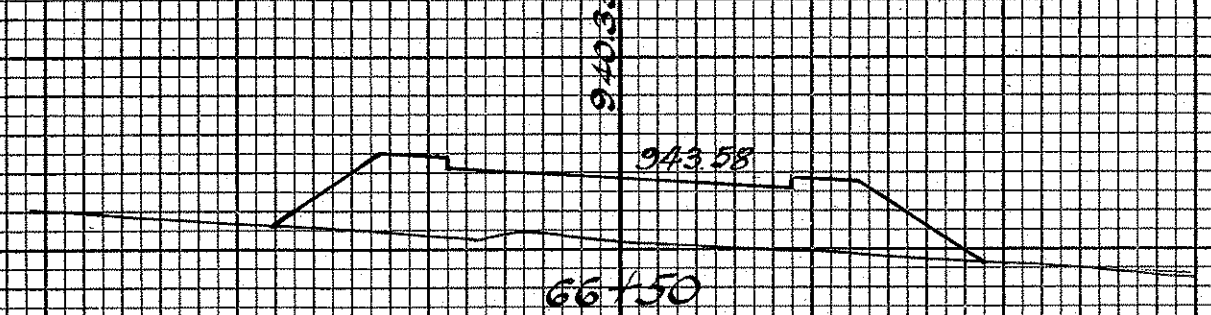


Exc = 0 cy
Emb = 185 cy

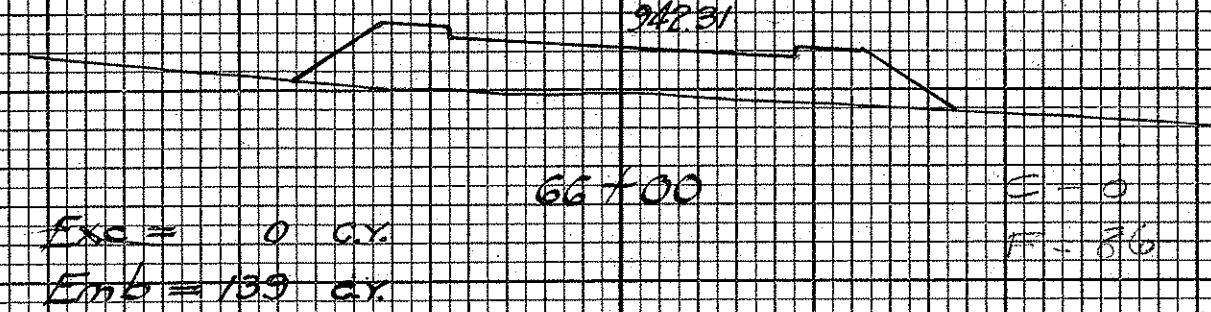


Exc = 0 cy
Emb = 189 cy

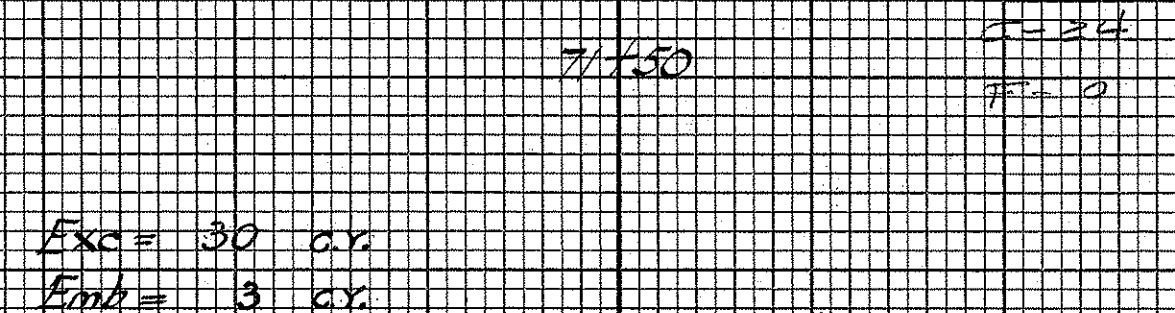


Exc = 30 cy
Emb = 3 cy

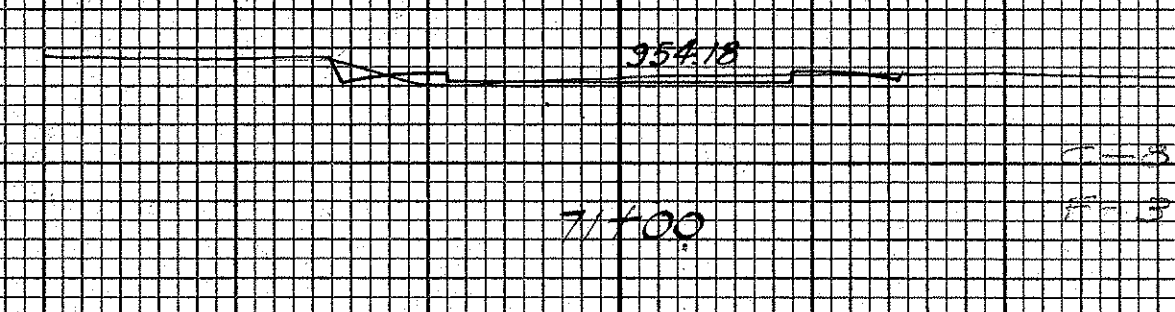


Exc = 9 cy
Emb = 14 cy

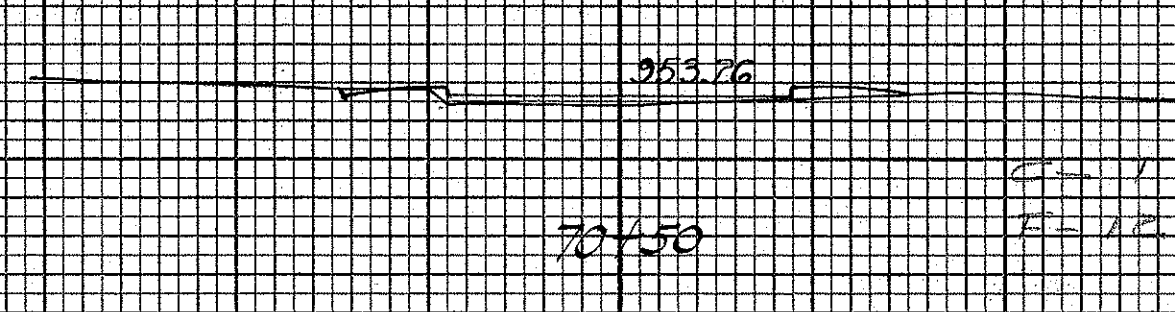


Exc = 1 cy
Emb = 27 cy

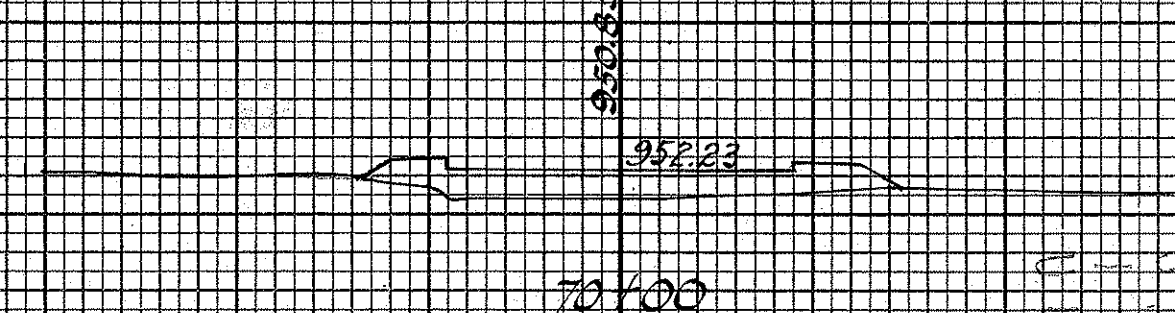

Exc = 0 cy
Emb = 108 cy

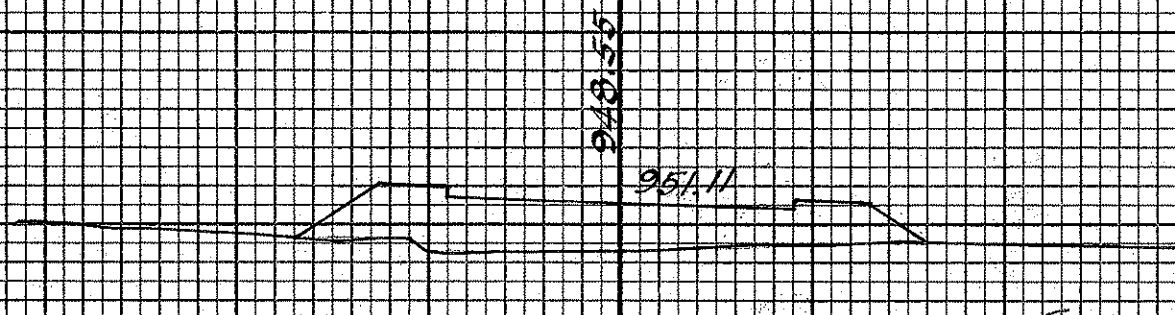


Exc = 0 cy
Emb = 167 cy

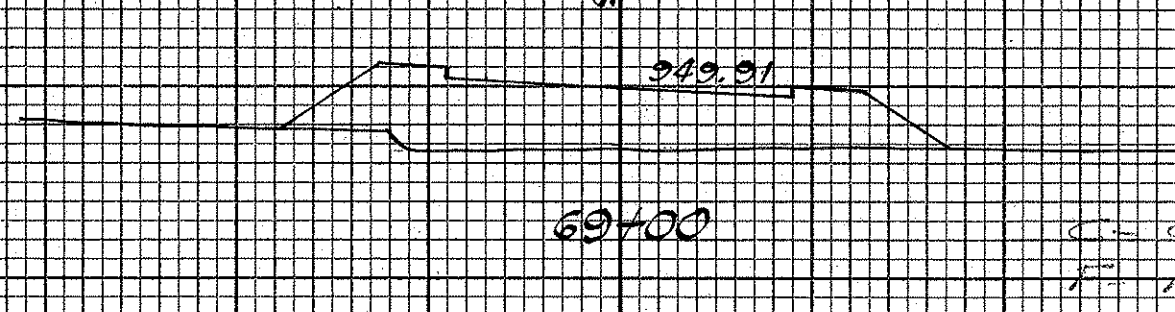


Exc = 0 cy
Emb = 205 cy


Exc = 19 cy
Emb = 3 cy

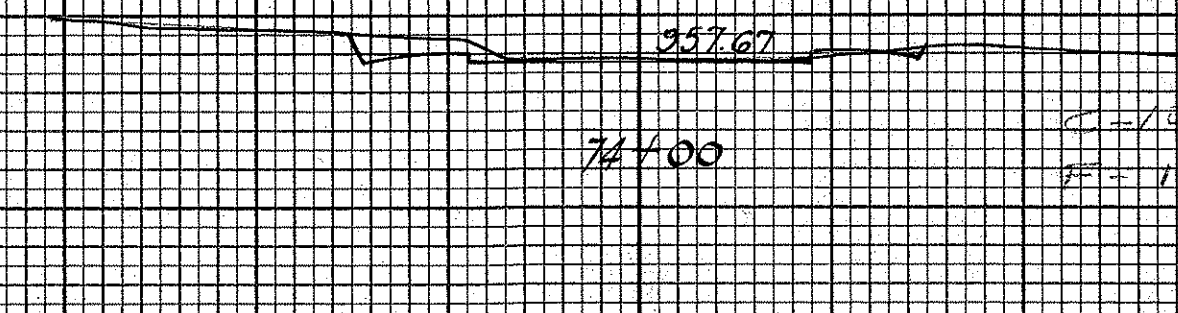


Exc = 21 cy
Emb = 1 cy

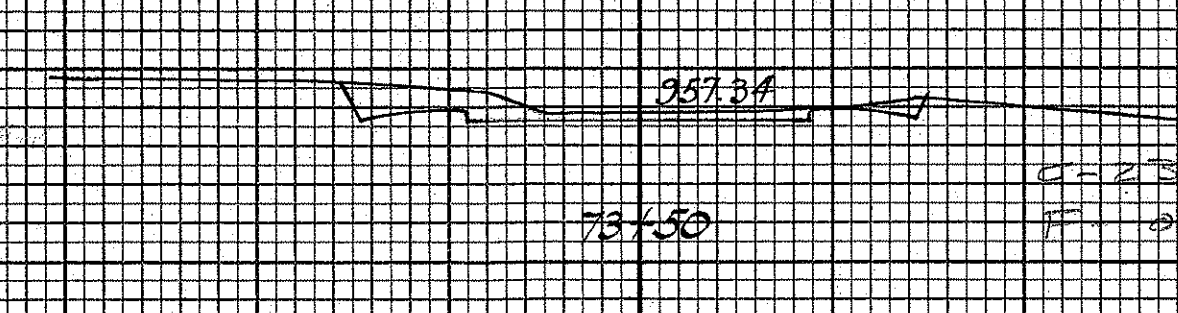


Exc = 47 cy
Emb = 0 cy

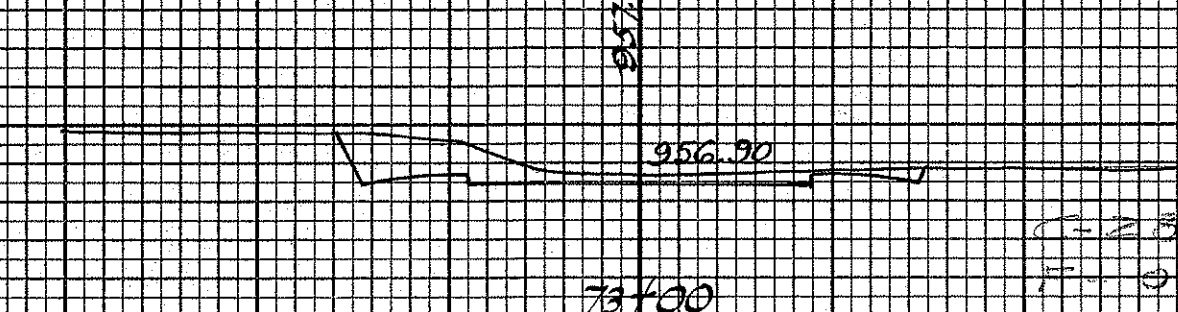

Exc = 36 cy
Emb = 0 cy

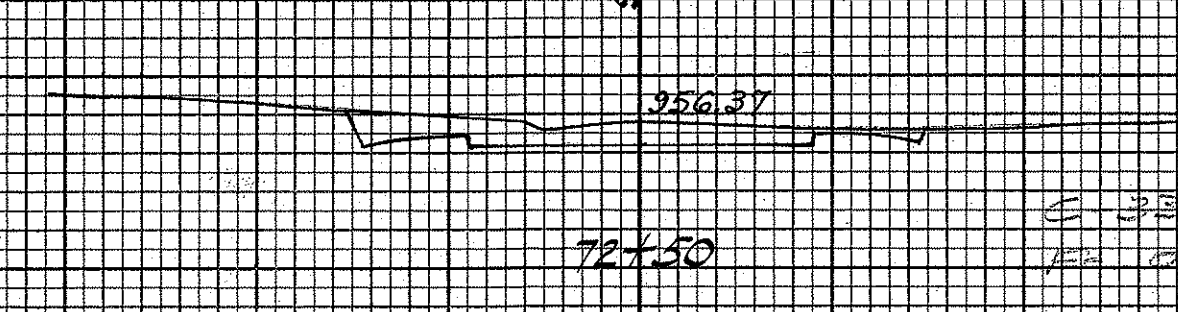

Exc = 60 cy
Emb = 0 cy

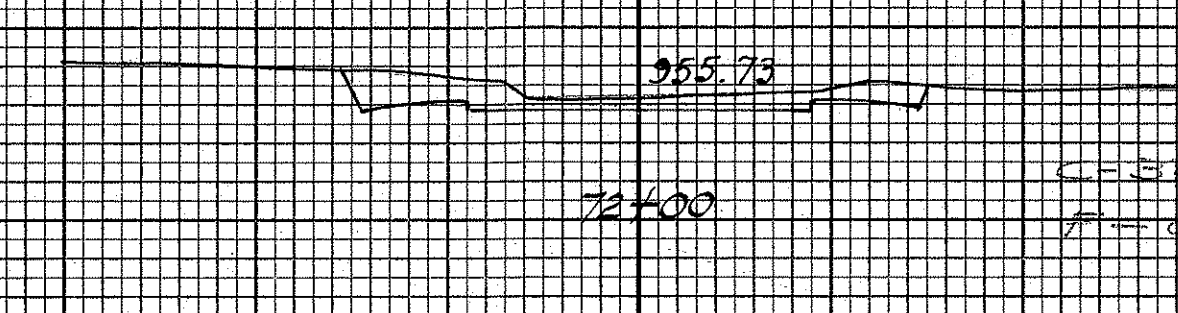

Exc = 52 cy
Emb = 0 cy

FINAL
SURVEY
NOTE BOOK
NO.

DATE
BY

SURVEYED
PLOTTED
CHECKED
AREAS CHECKED

ORIGINAL
SURVEY
NOTE BOOK
NO.

DATE
BY

SURVEYED
PLOTTED
CHECKED
AREAS CHECKED

FED. ROAD
DIST. NO.
HAWAII


STATE
HAWAII

FED. AID
PROJ. NO.
HAWAII

FISCAL
YEAR
1938


SHEET
NO.
20

25

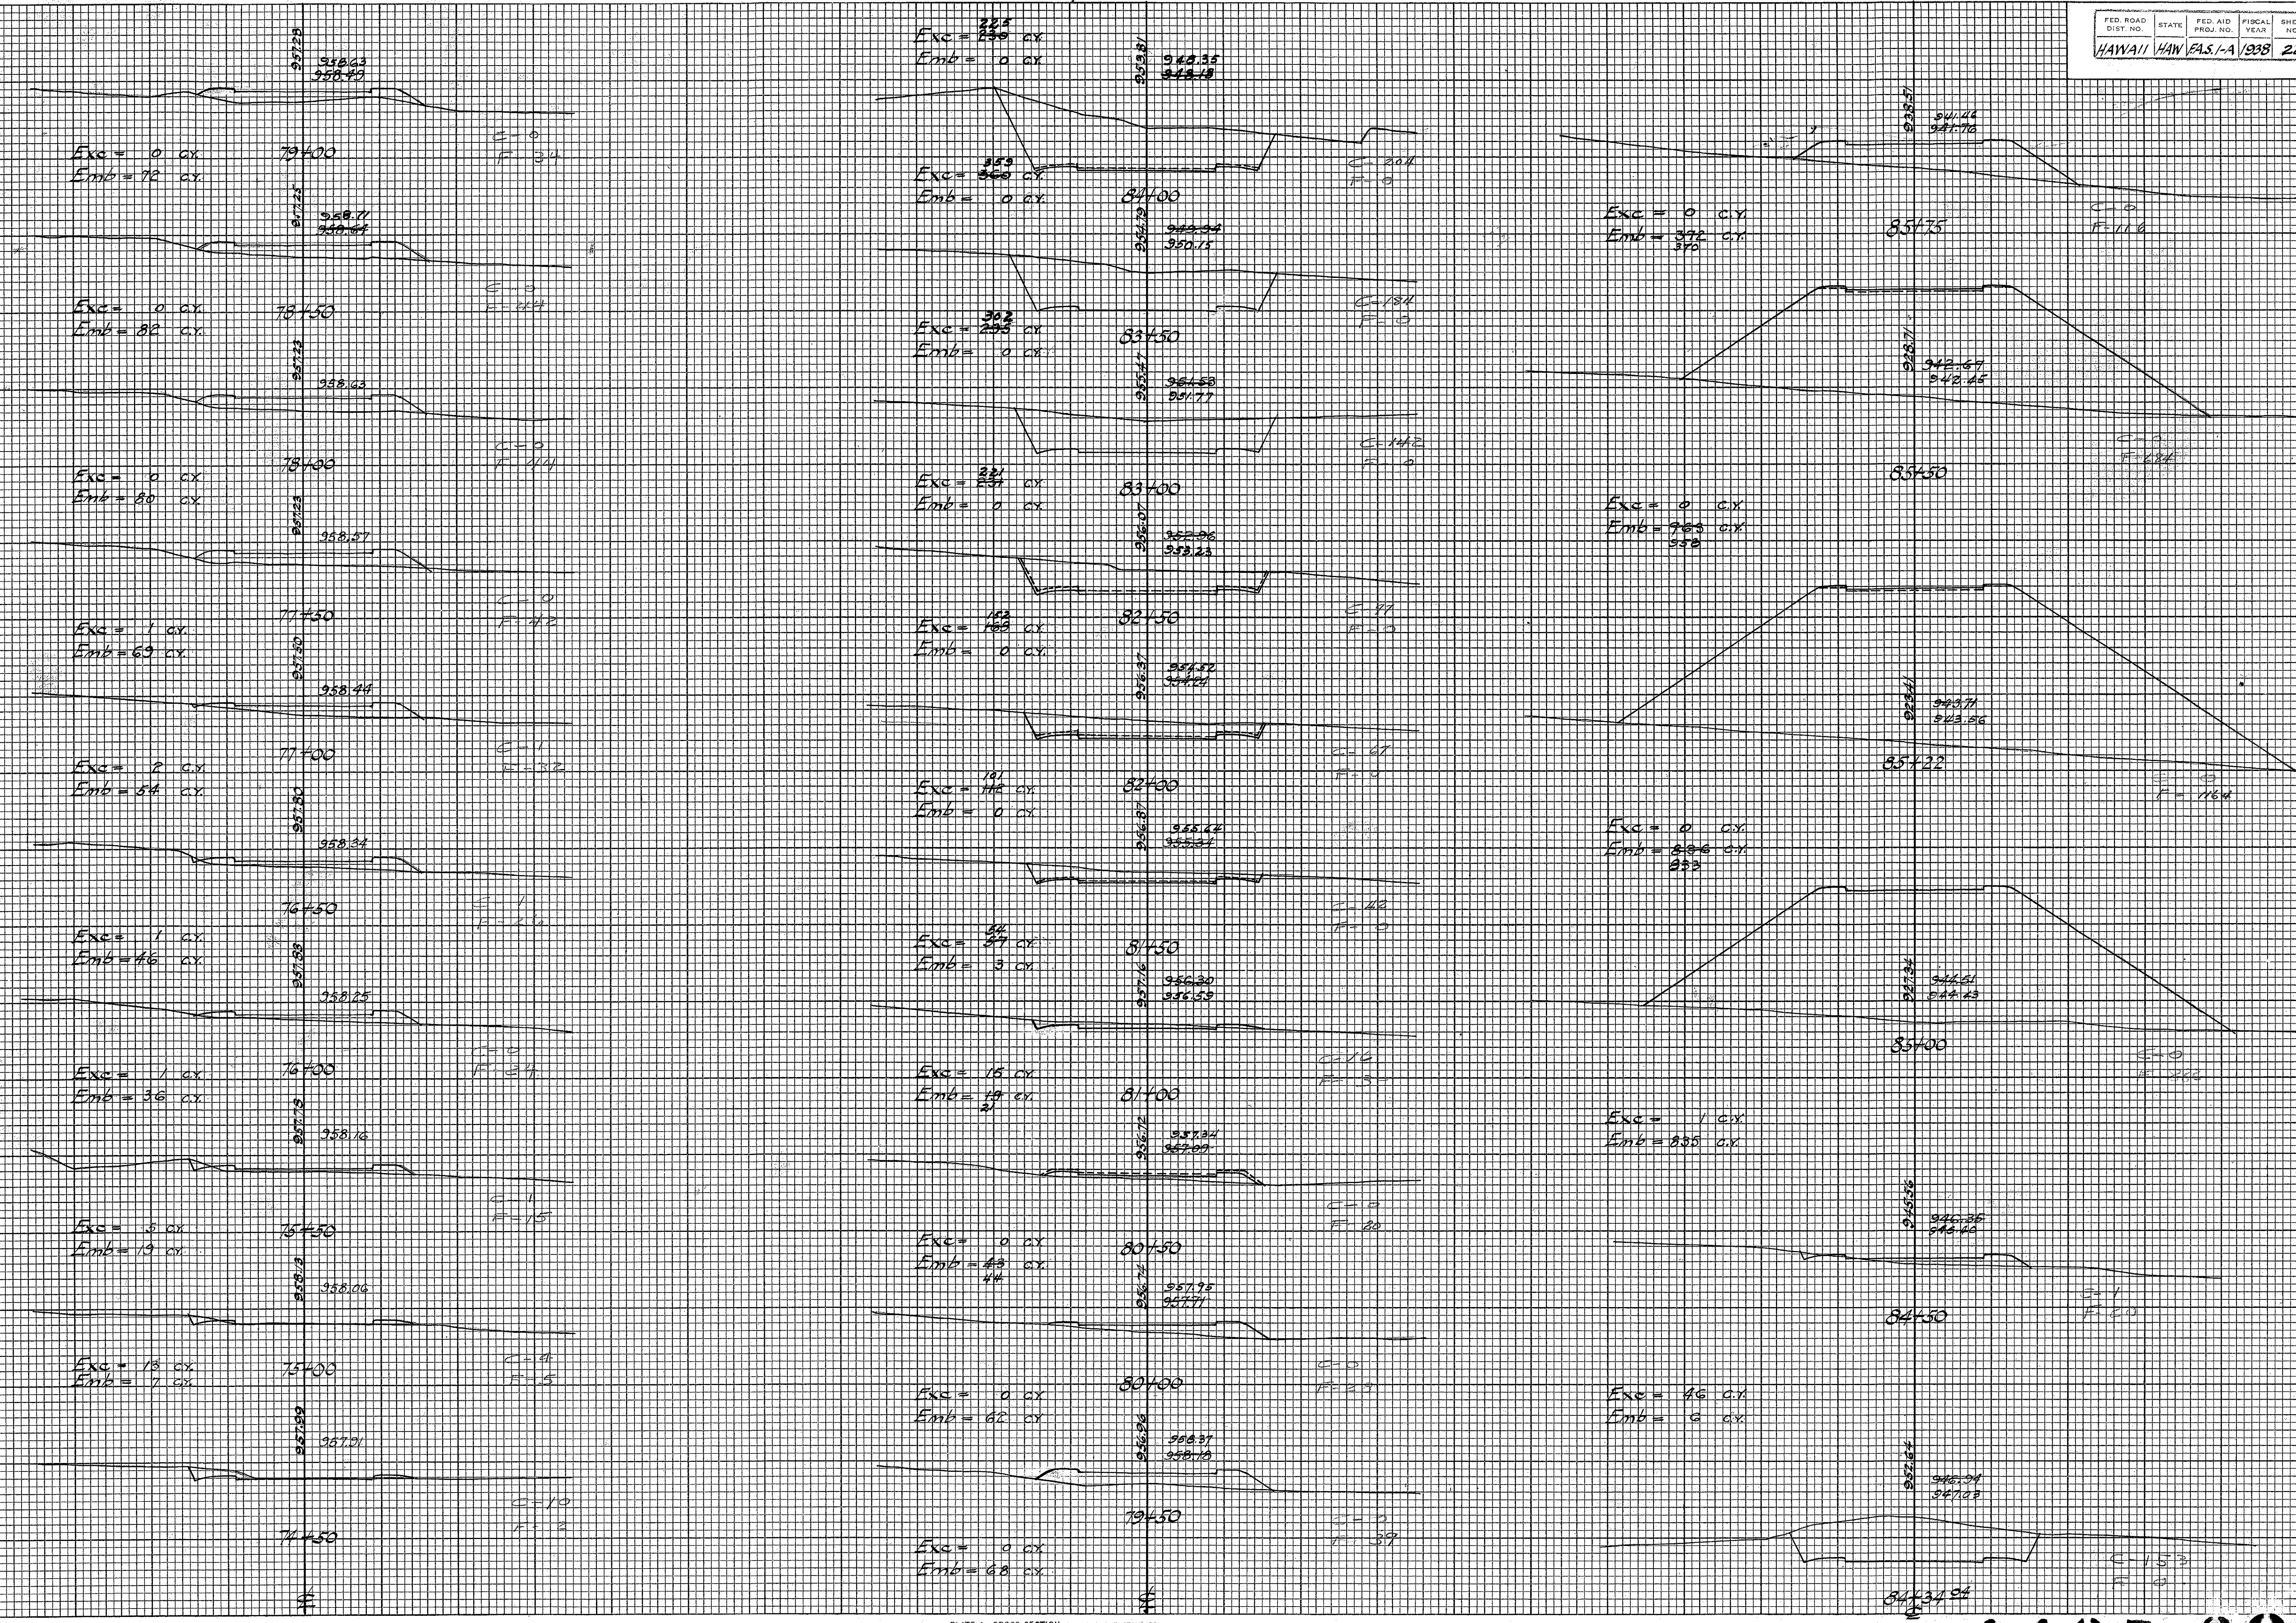


FINAL	SURVEYED	DATE
SURVEY	BY	
NOTE BOOK	PLOTTED	
NO.	TEMPLATE	
	AREAS CHECKED	

ORIGINAL	SURVEYED	DATE
SURVEY	BY	
NOTE BOOK	PLOTTED	
NO.	TEMPLATE	
	AREAS CHECKED	

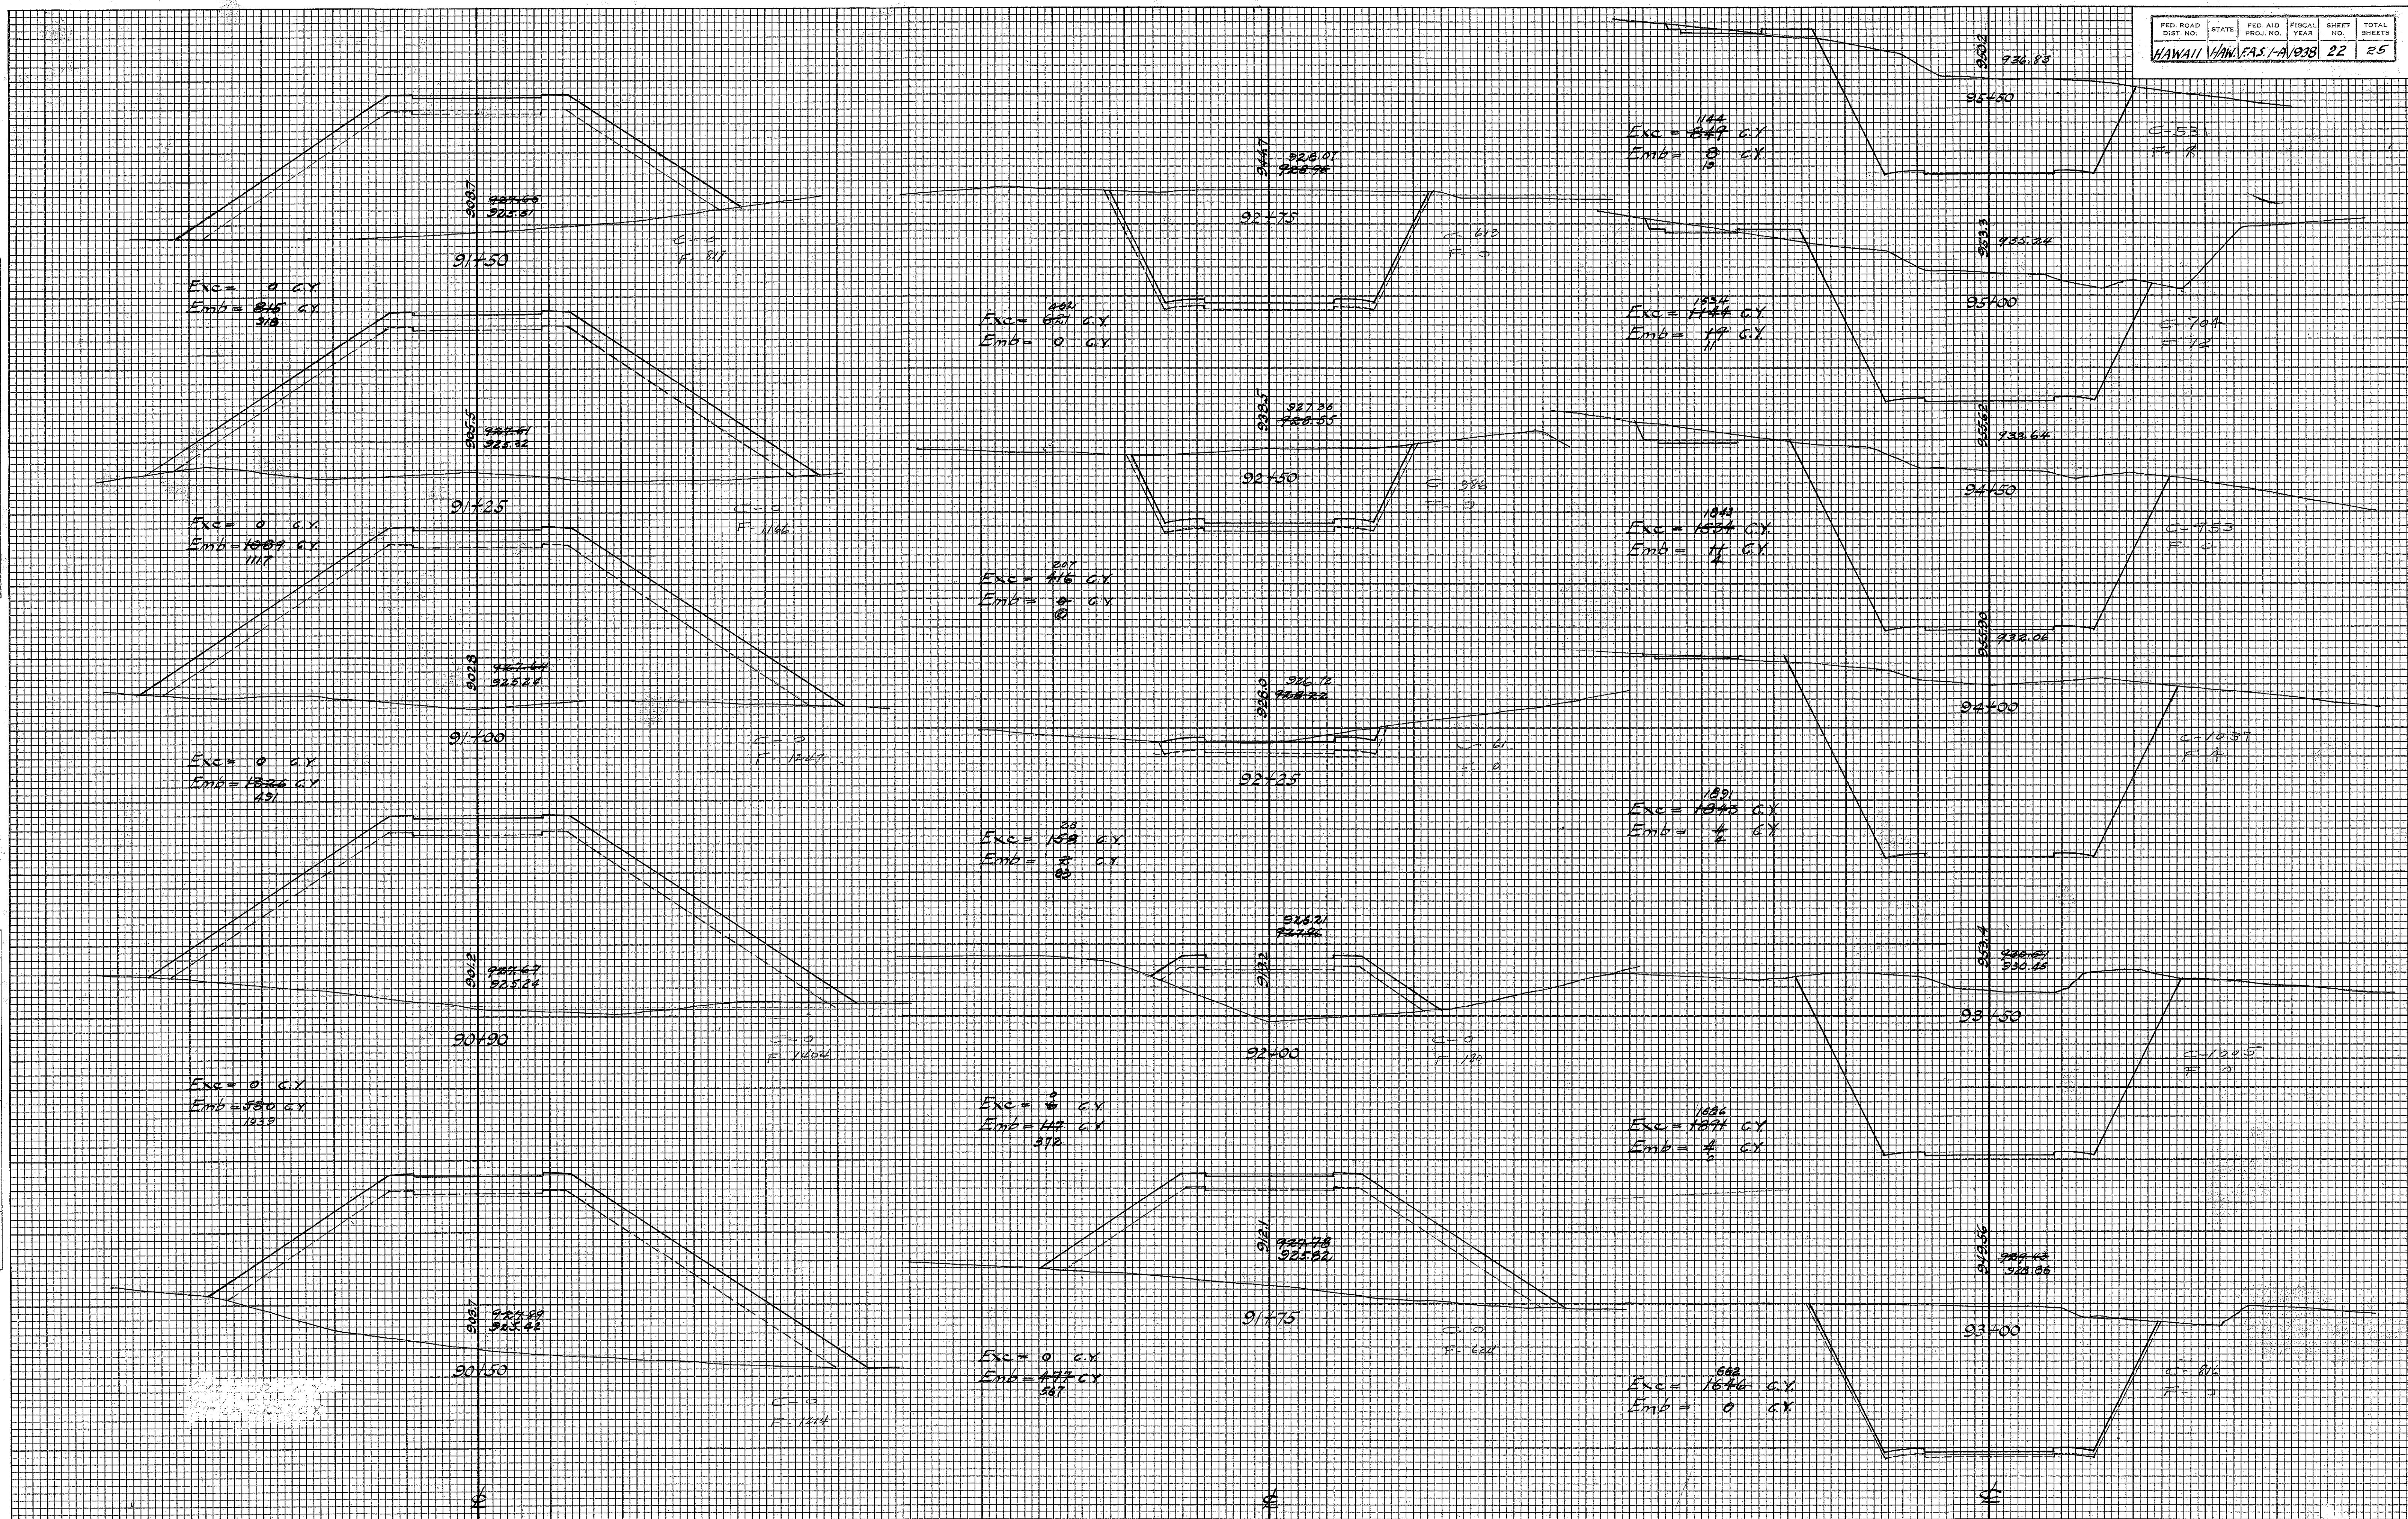




FINAL SURVEY	DATE
BY	
REVIEWED	
PLANNED	
TEMPLATE	
NOTE BOOK	
AREAS CHECKED	
NO.	

ORIGINAL SURVEY	DATE
BY	
REVIEWED	
PLANNED	
TEMPLATE	
NOTE BOOK	
AREAS CHECKED	
NO.	

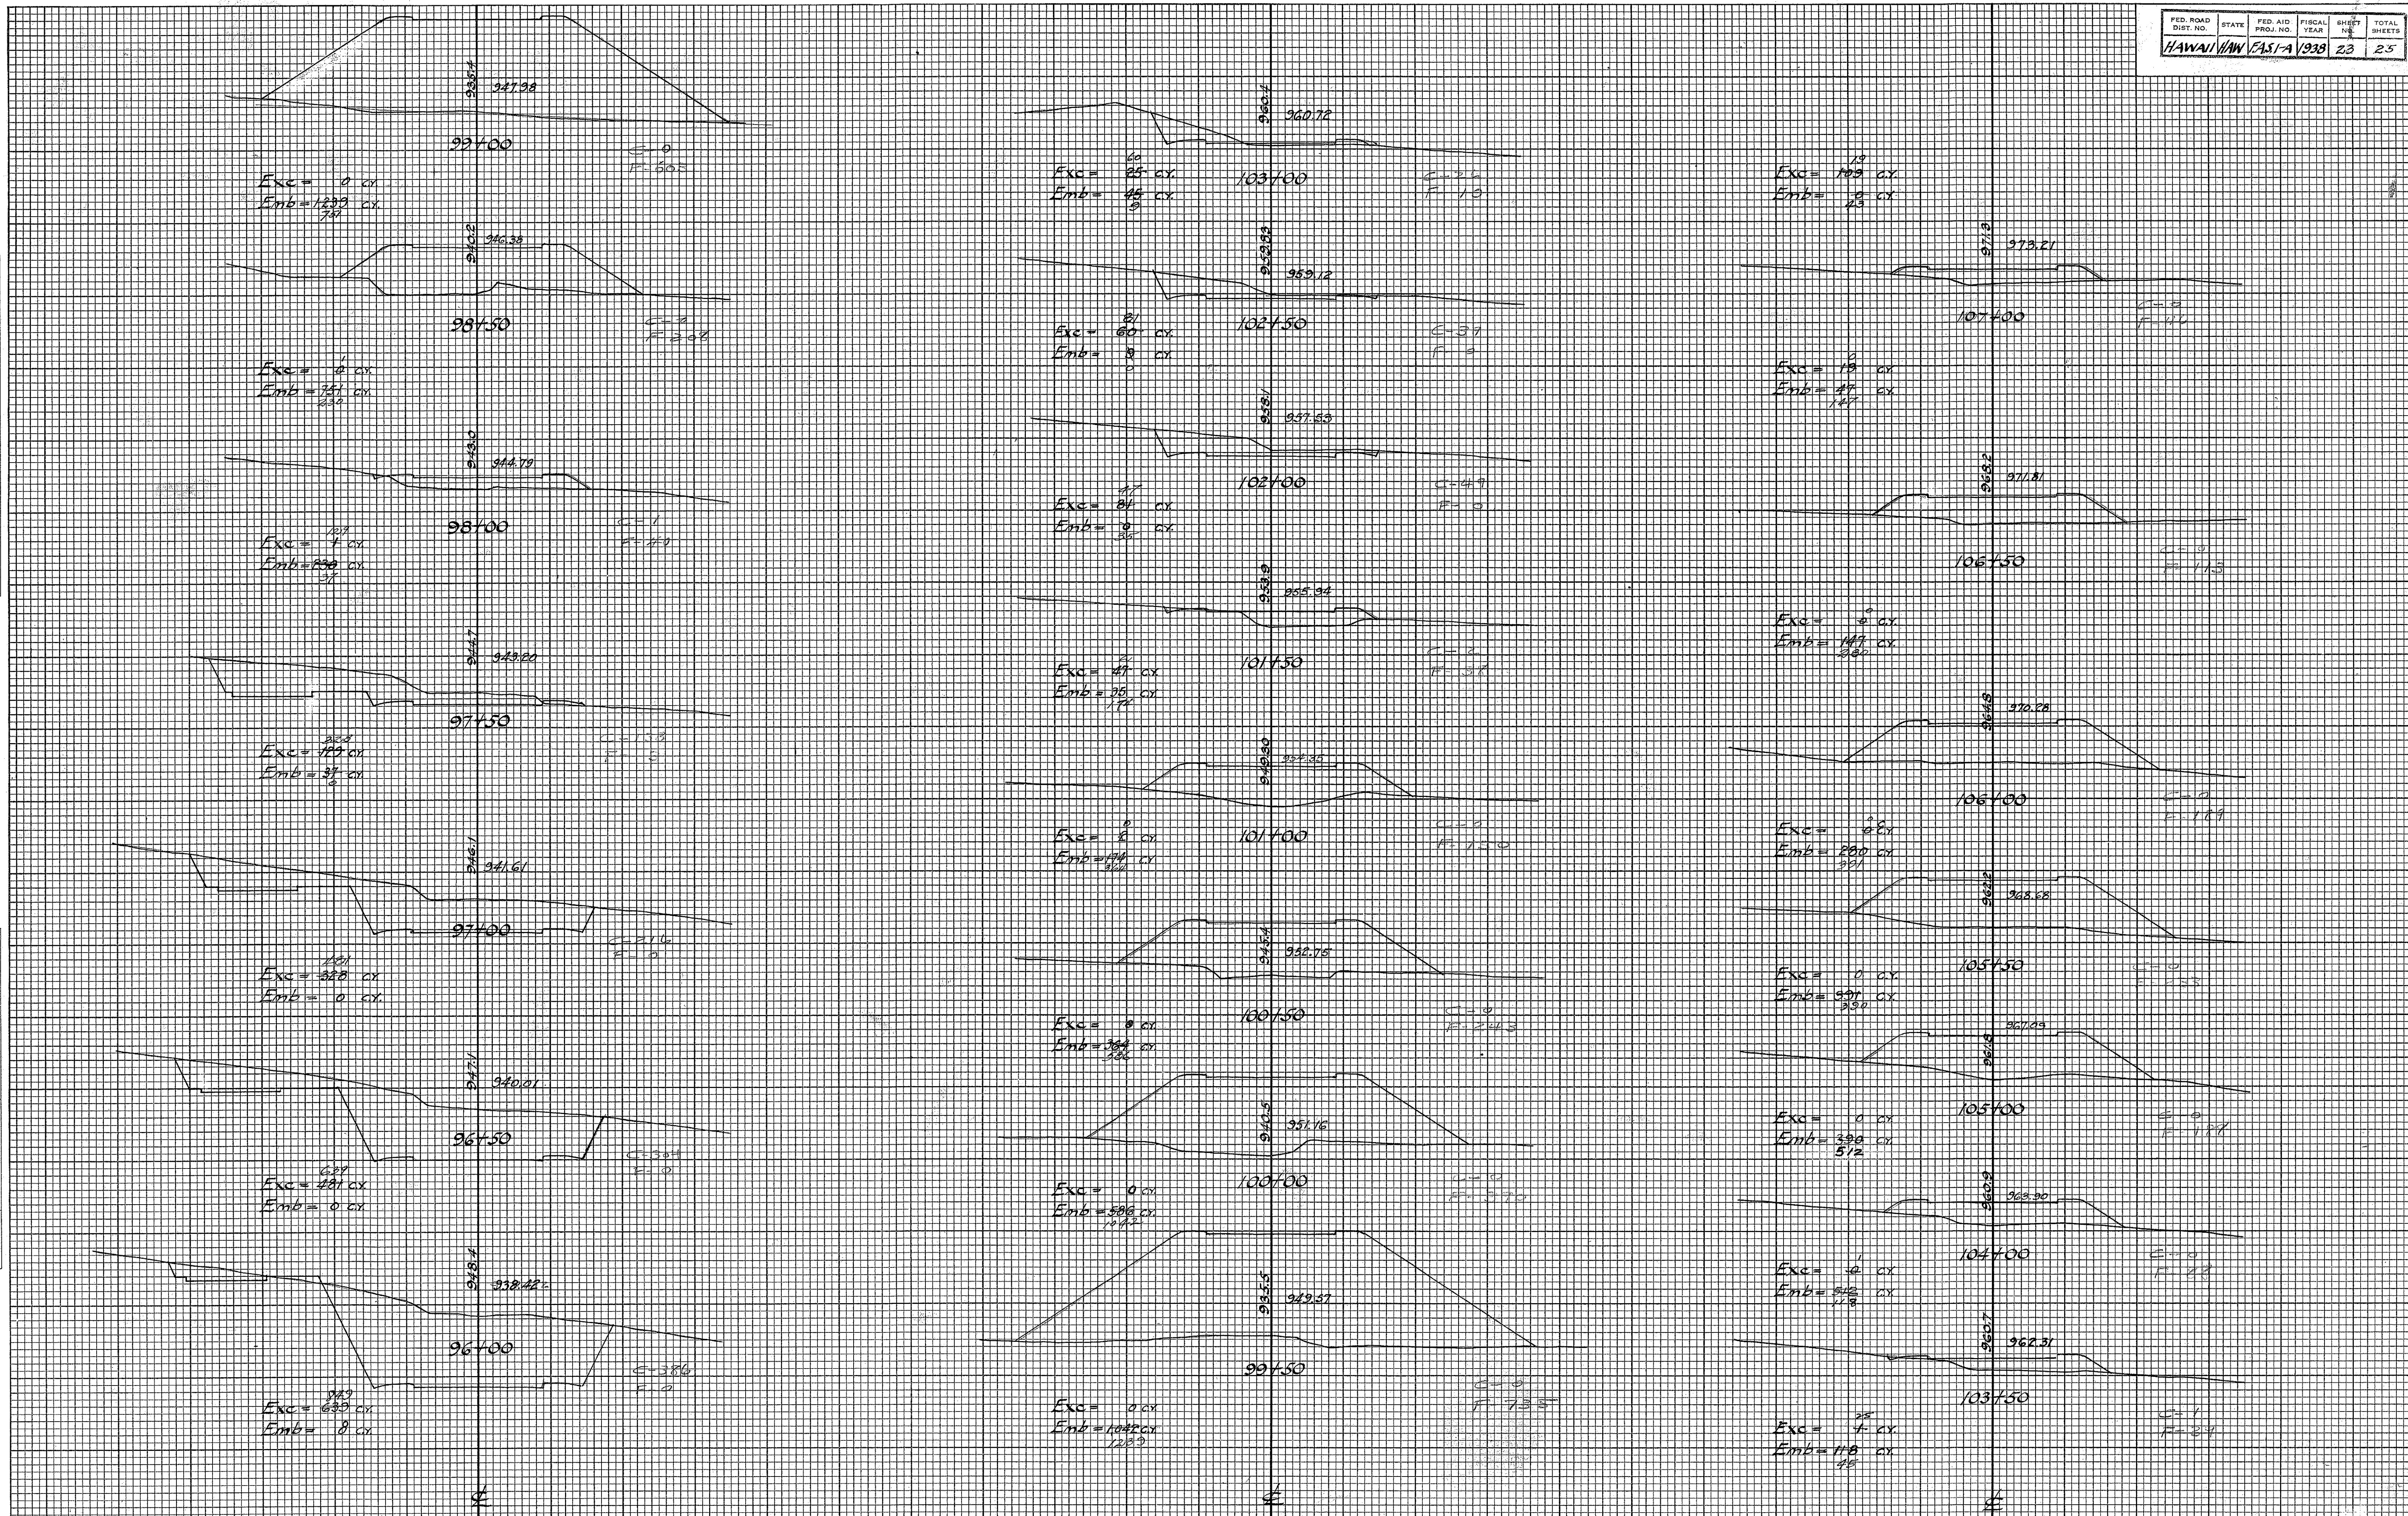

FINAL SURVEY	DATE
SURVEYED	BY
PLOTTED	
NOTE BOOK	
AREAS CHECKED	
NO.	

ORIGINAL SURVEY	DATE
SURVEYED	BY
PLOTTED	
NOTE BOOK	
AREAS CHECKED	
NO.	

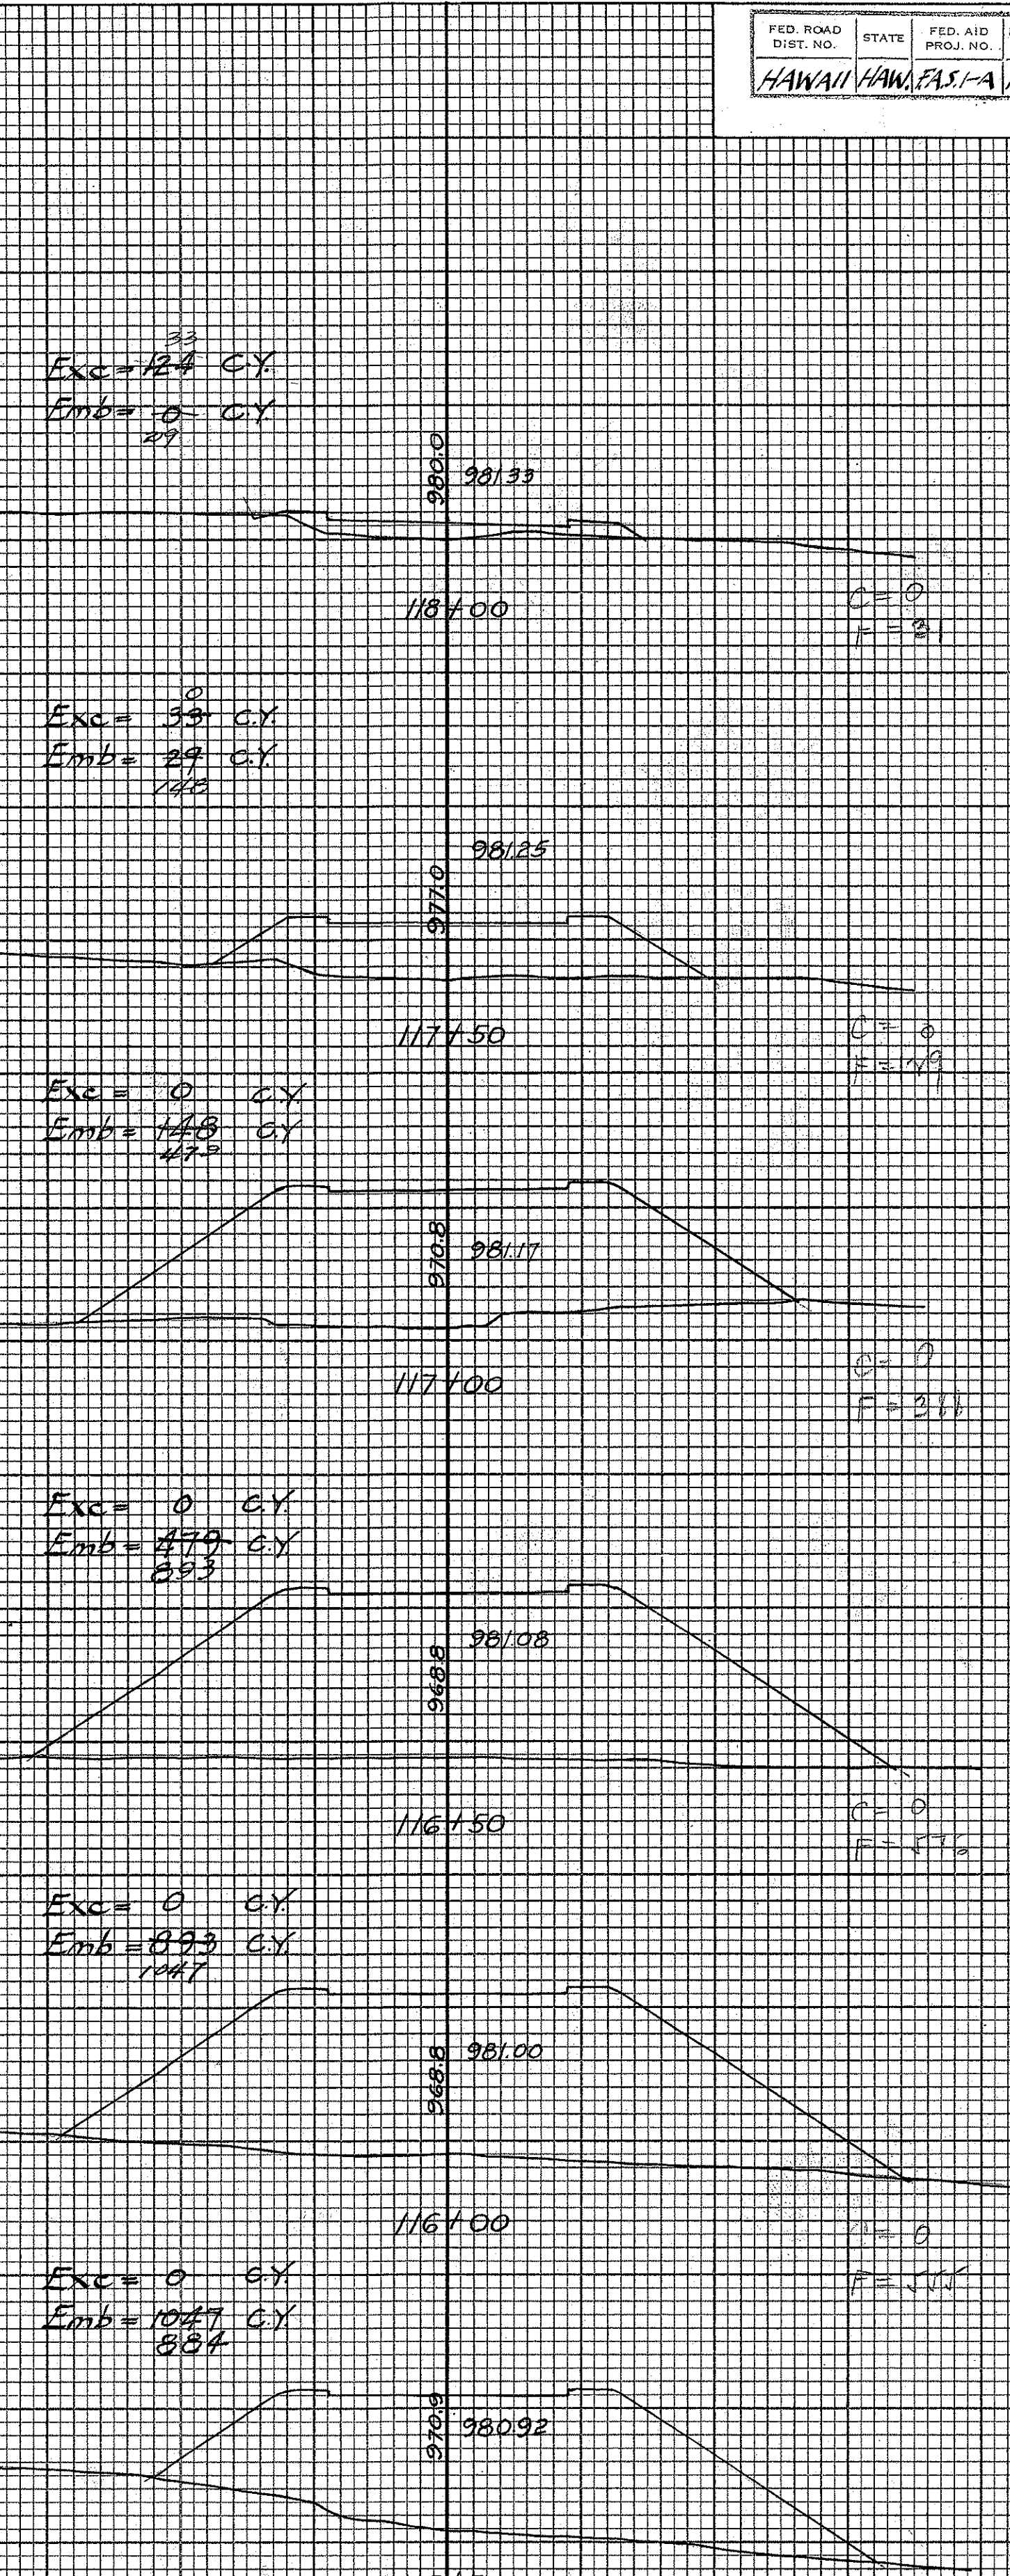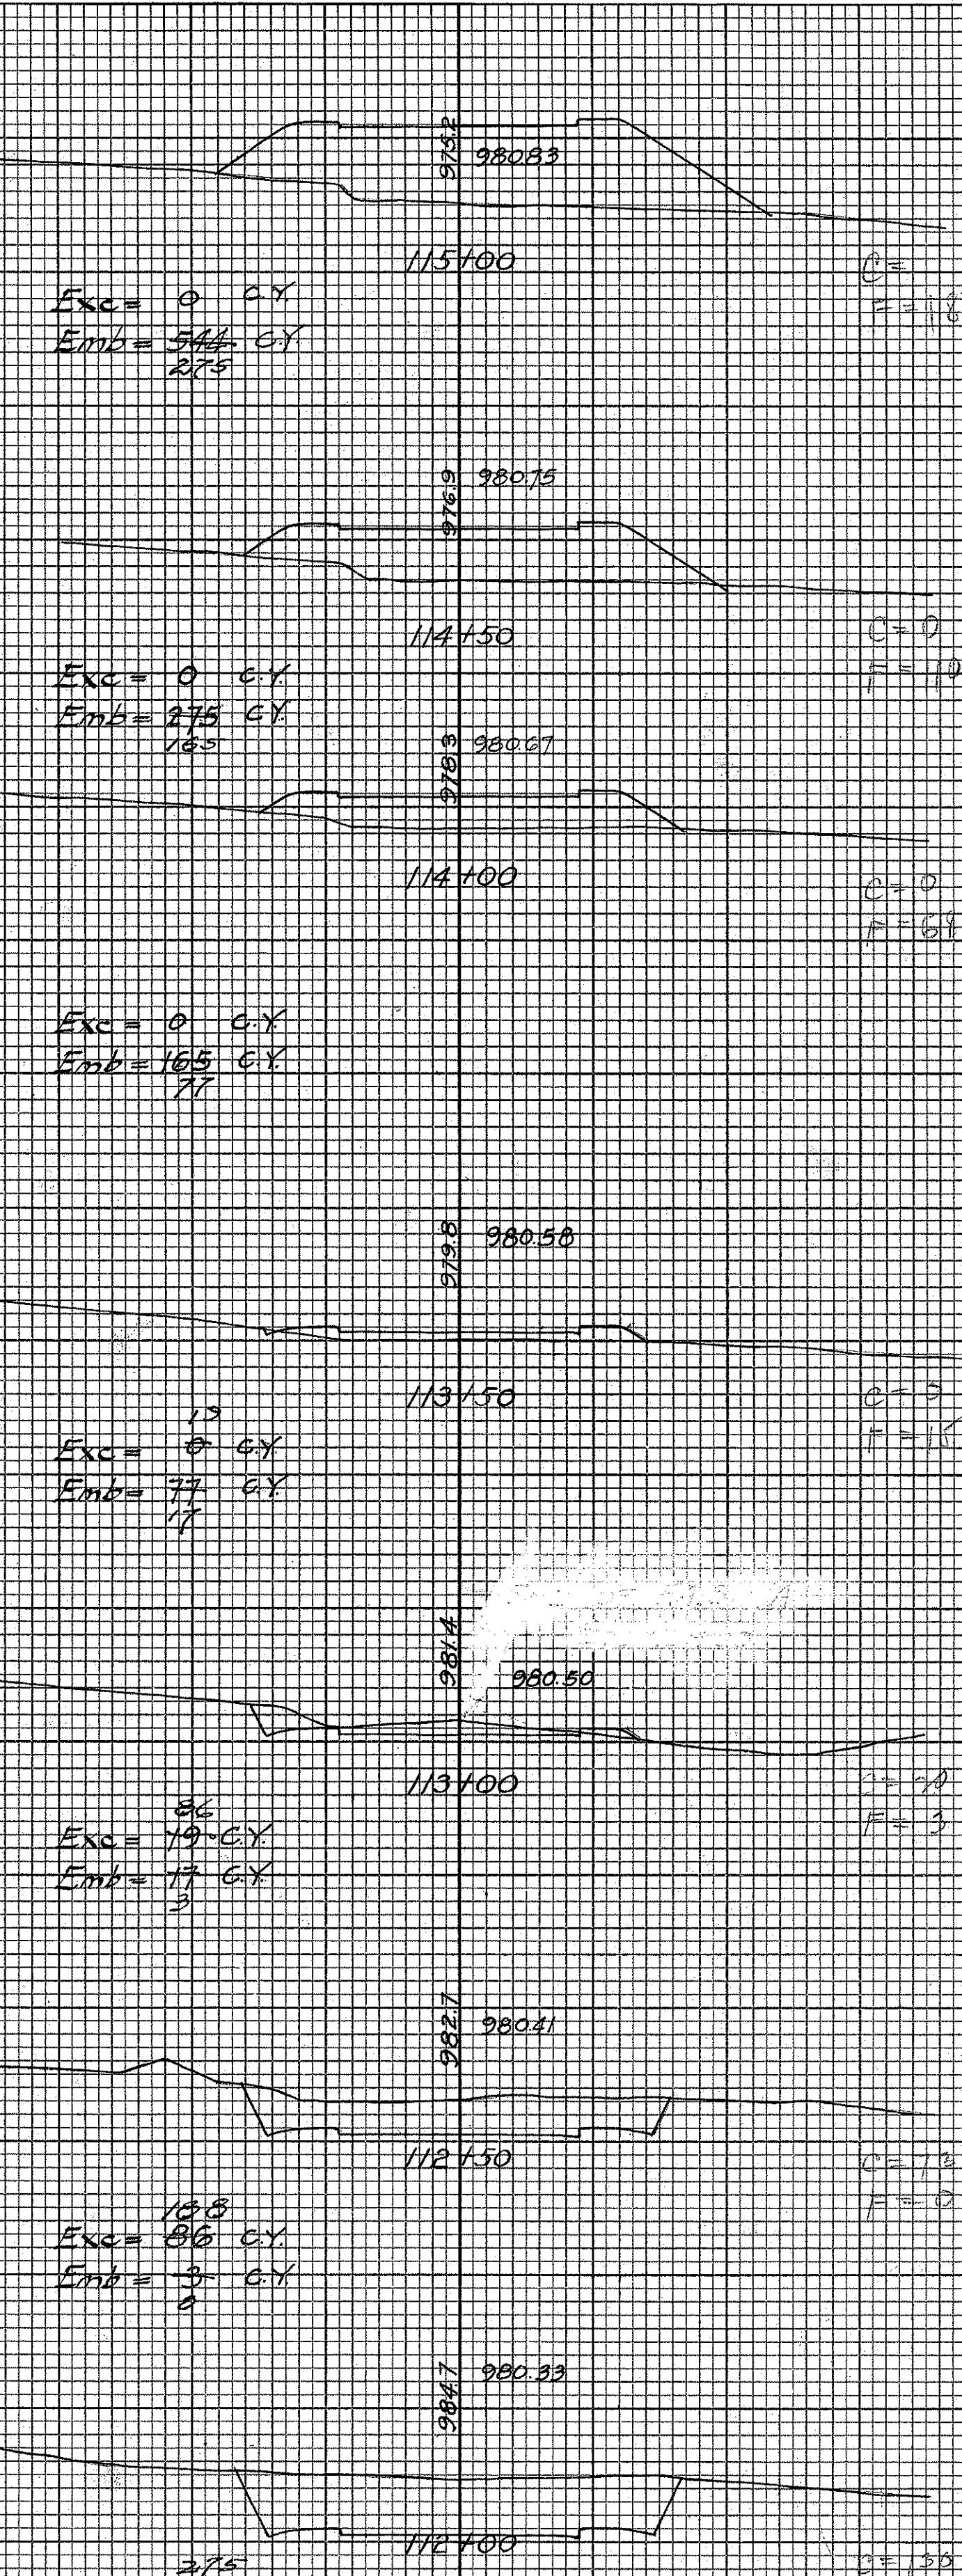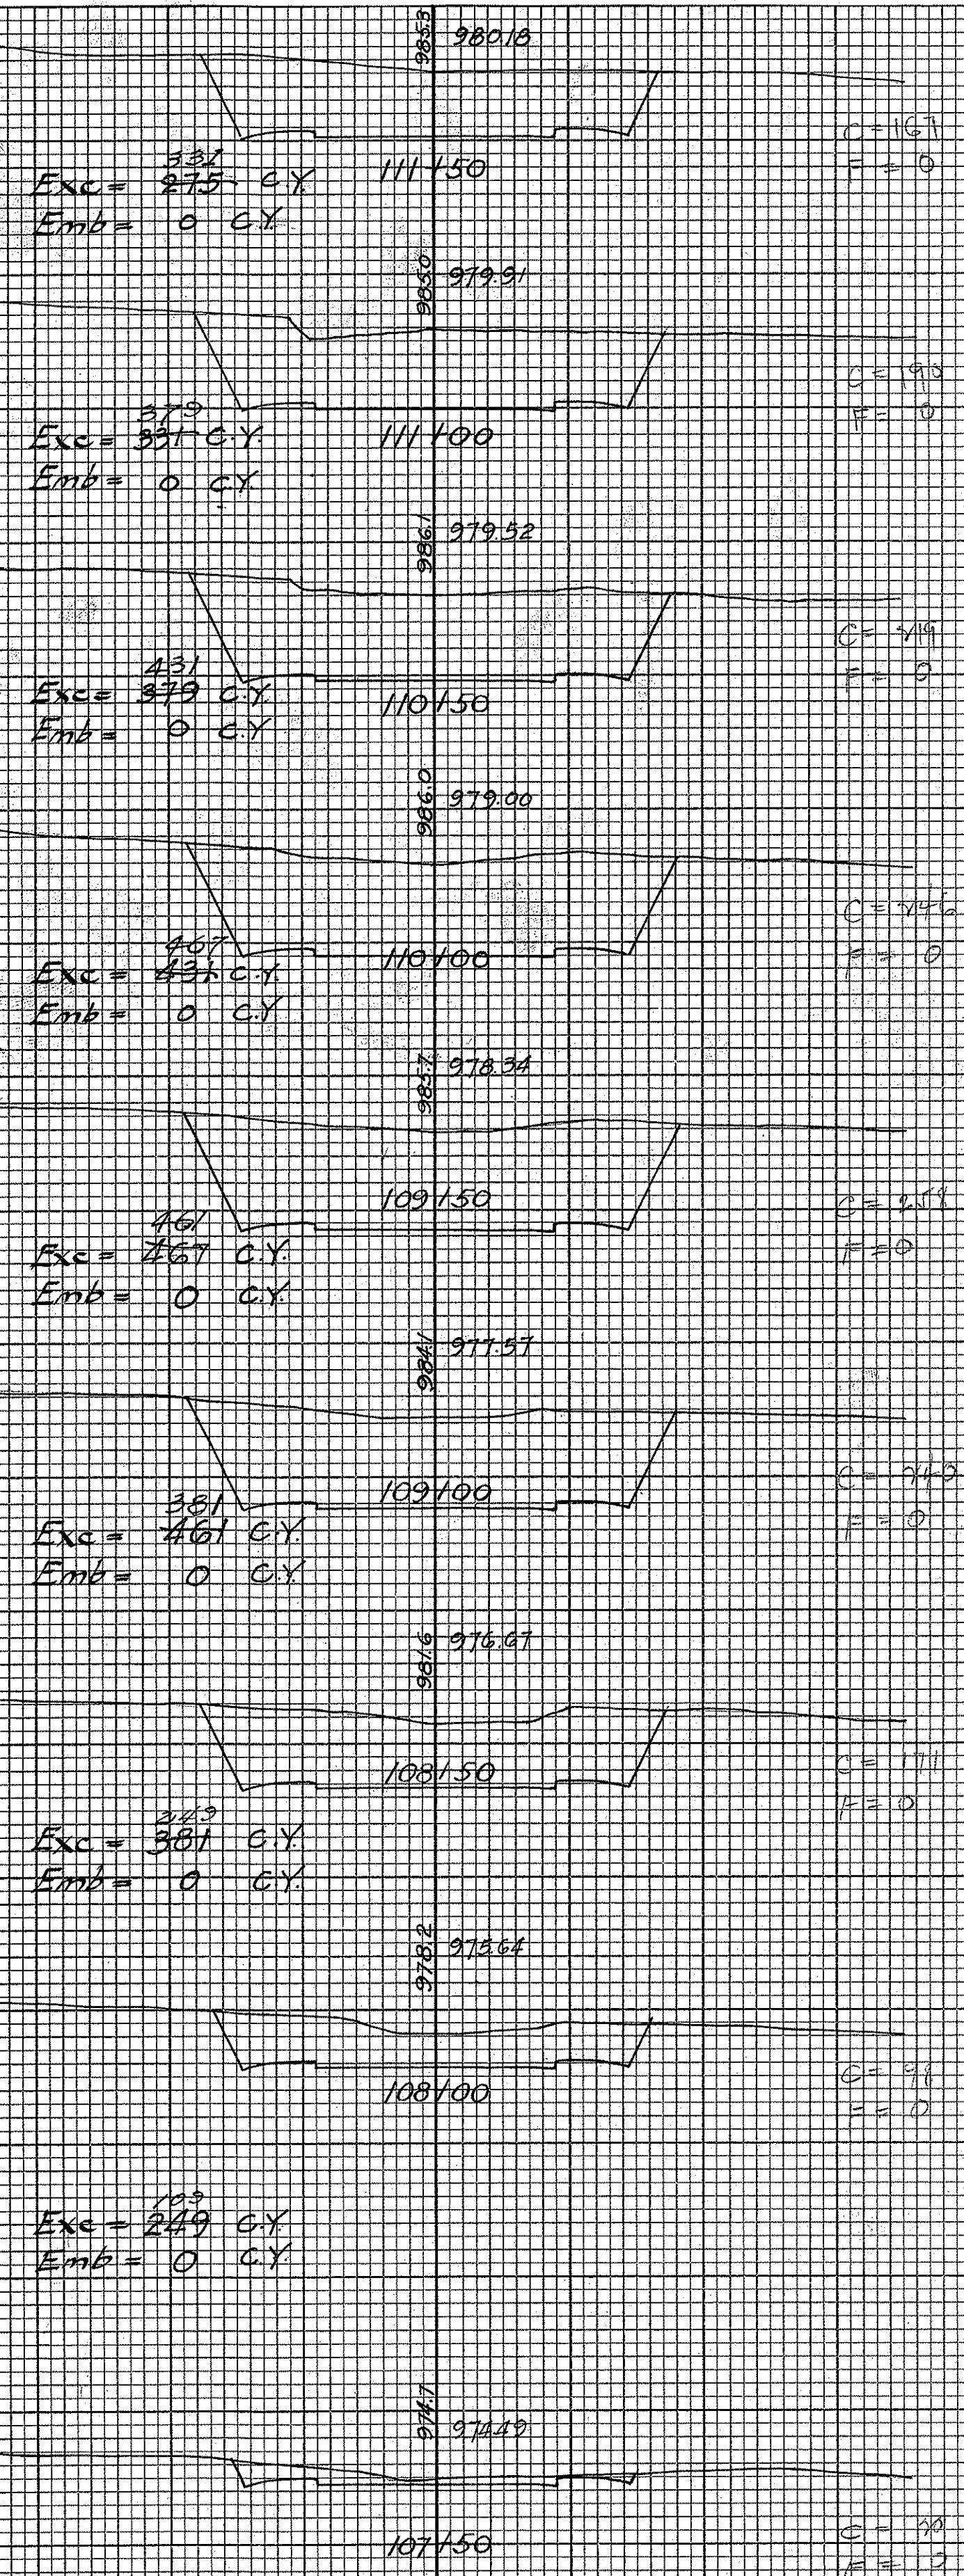

FINAL SURVEY
NOTE BOOK NO. _____
DATE _____
BY _____
SURVEYED _____
PLOTTER _____
CHECKED _____
AREAS CHECKED _____

ORIGINAL SURVEY
NOTE BOOK NO. _____
DATE _____
BY _____
SURVEYED _____
PLOTTER _____
CHECKED _____
AREAS CHECKED _____

