

INDEX TO DRAWINGS	
SHEET NO	DESCRIPTION
1	TITLE SHEET
2	LOCATION LAYOUT PLANS
3-6	DETAIL PLANS AND CROSS SECTIONS
7-10	STANDARD DETAILS

STATE OF HAWAII
DEPARTMENT OF TRANSPORTATION
HIGHWAYS DIVISION
HONOLULU, HAWAII

"AS BUILT" PLANS FOR
HAWAII FEDERAL AID
LANDSCAPING AND SCENIC ENHANCEMENT PROGRAM
AT VARIOUS LOCATIONS

PROJECT LSF 030-1(1)
ISLAND OF MAUI


PROJECT LSF 030-1(2)
ISLAND OF MAUI

PROJECT LSF 046-1(1)
ISLAND OF MOLOKAI


NOTE:
ALL CHANGES MADE DURING
CONSTRUCTION HAVE BEEN
NOTED IN RED ON THESE
TRACINGS AND CHECKED BY

August Ohashi
PROJ. ENG'R

11/7/69
DATE

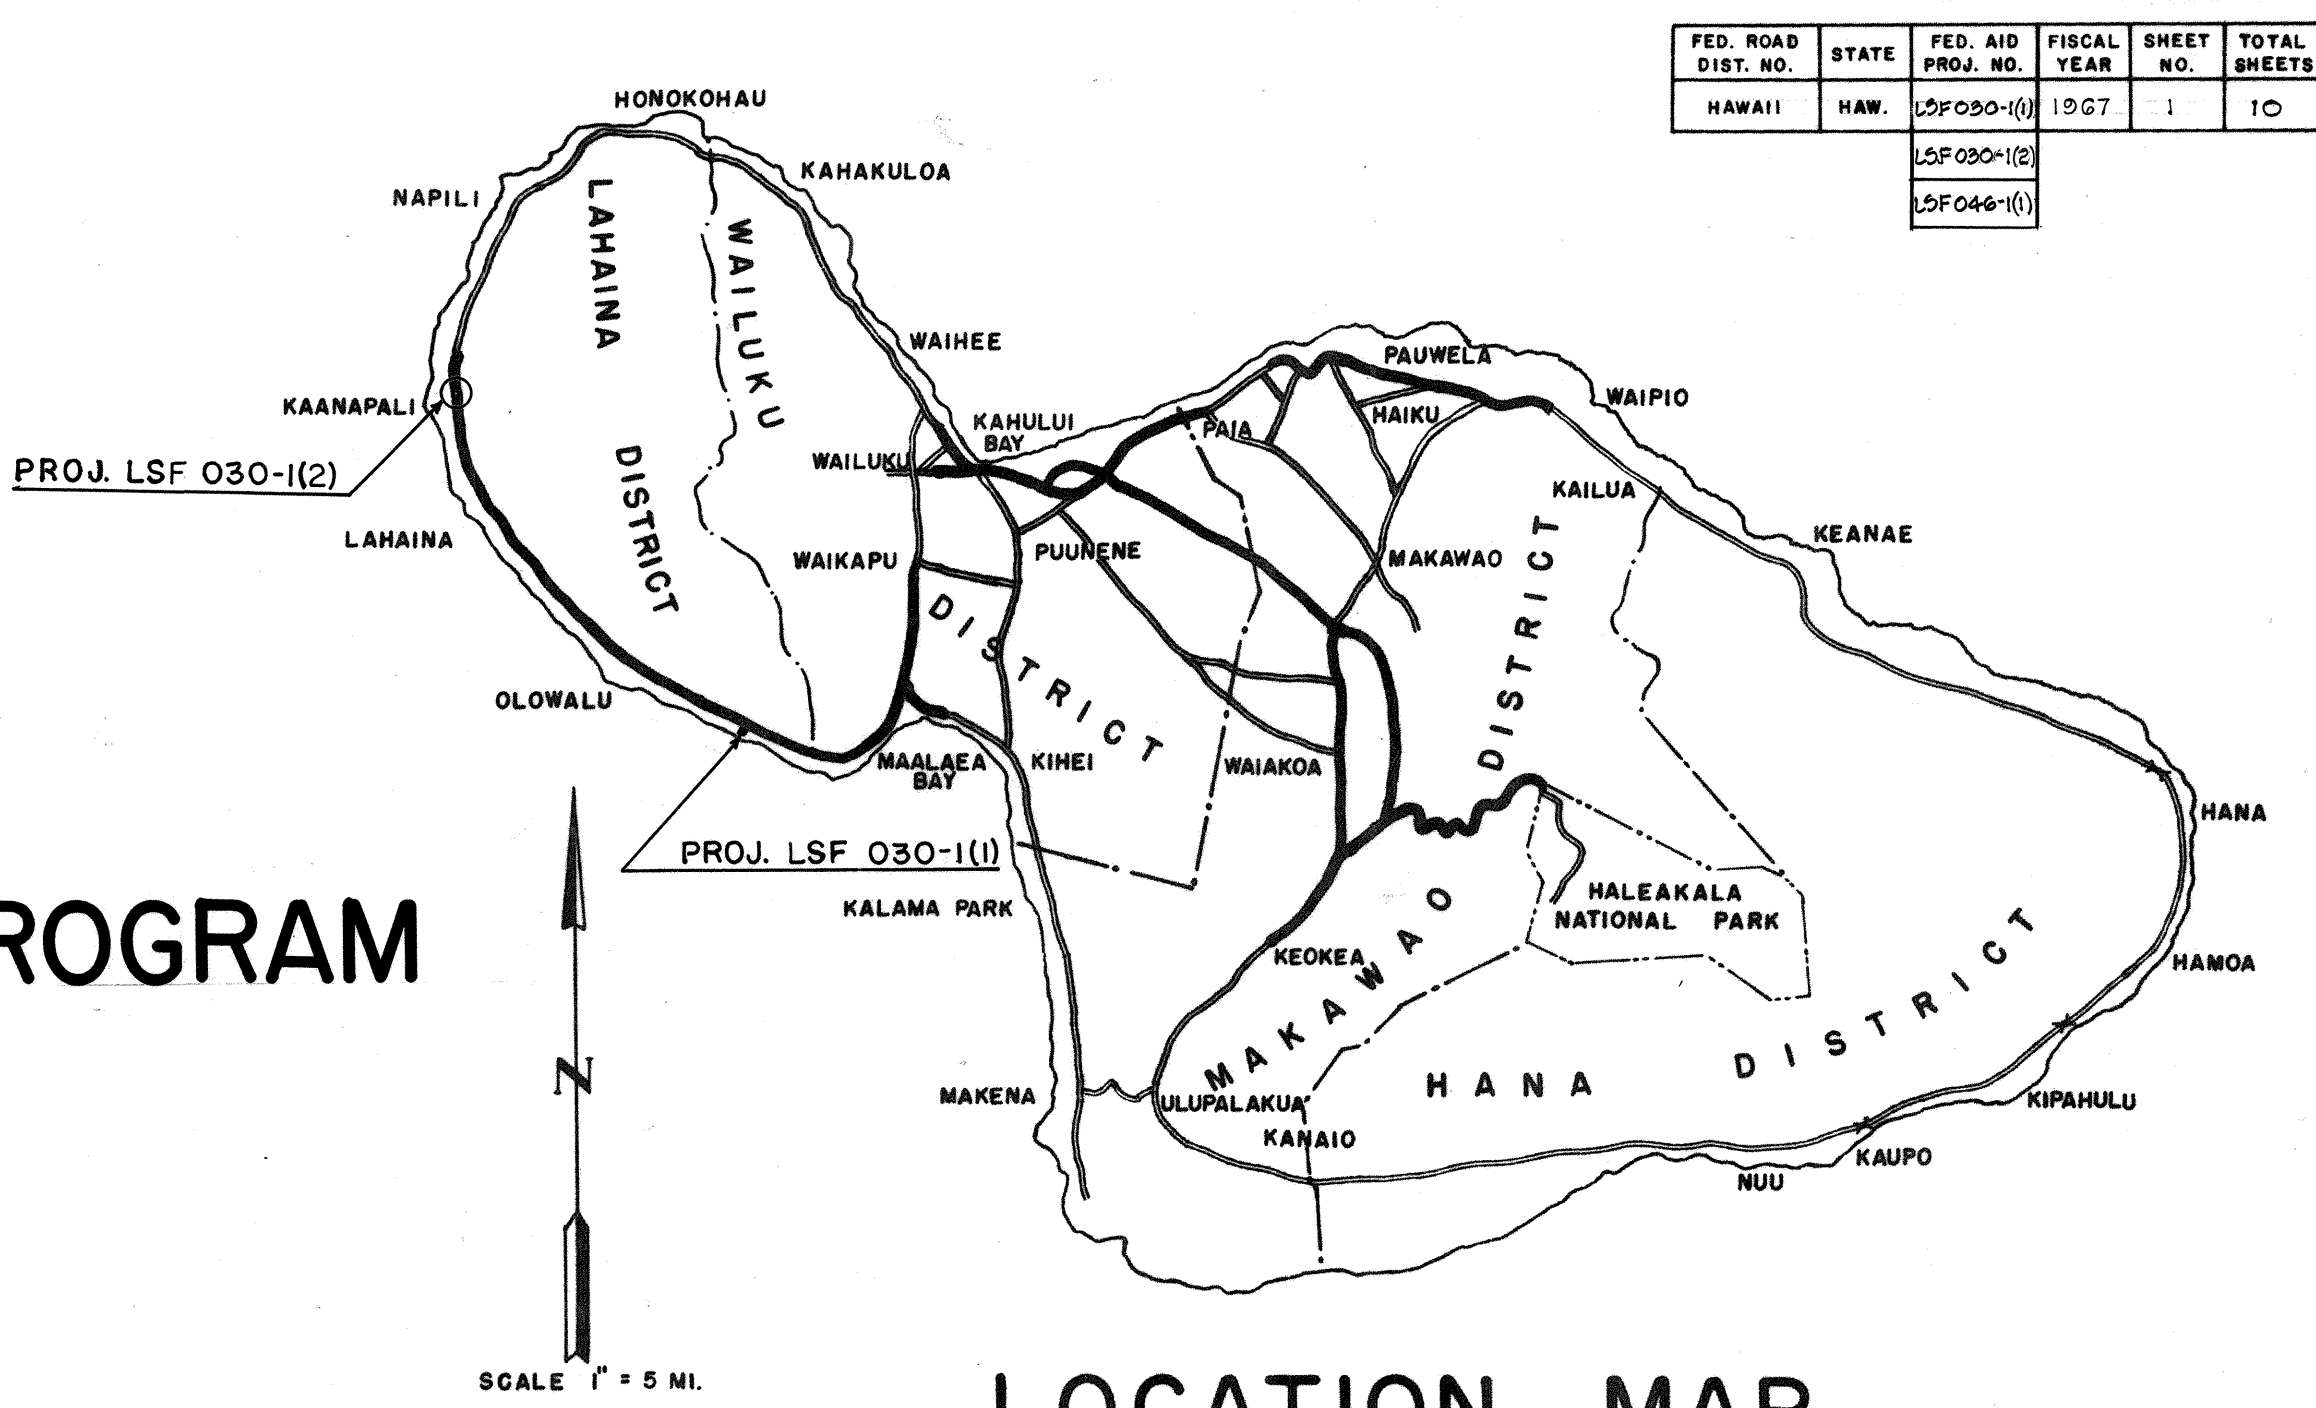

LOCATION MAP
MAUI

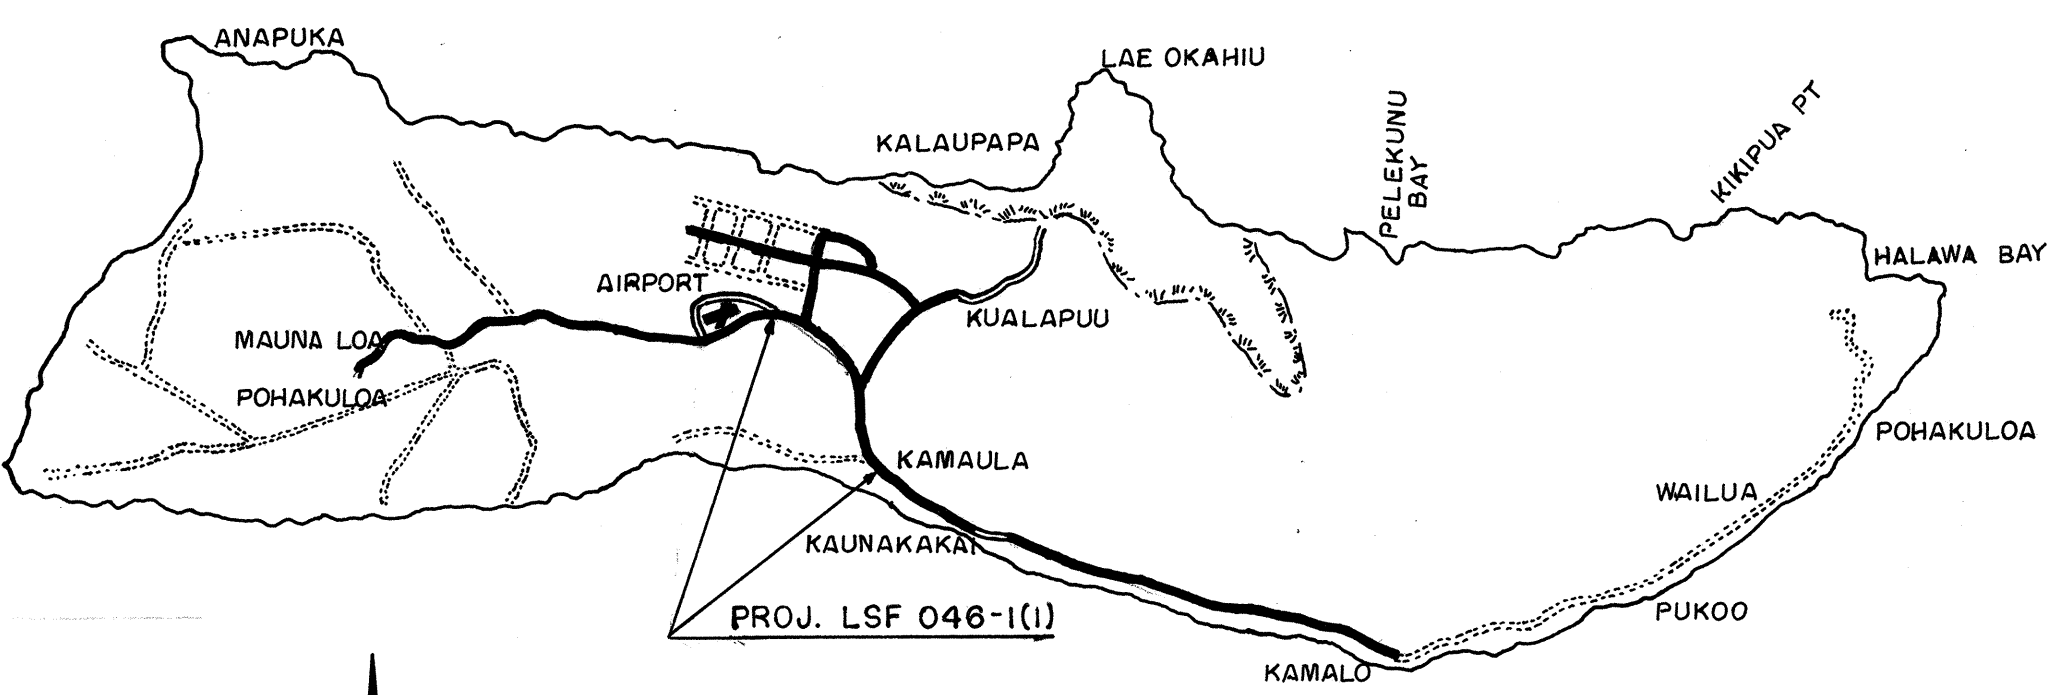

LOCATION MAP
MOLOKAI

APPROVED:

DATE 4/15/68

John M. Anderson
For DIRECTOR OF TRANSPORTATION

DEPARTMENT OF TRANSPORTATION
BUREAU OF PUBLIC ROADS

APPROVED:

Neil D. DeLong
For DIVISION ENGINEER

4-17-68
DATE