



FED. ROAD DIST. NO.	STATE	FED. AID PROJ. NO.	FISCAL YEAR	SHEET NO.	TOTAL SHEETS
HAWAII	HAW.	HWY M-01-74	1974	8	50

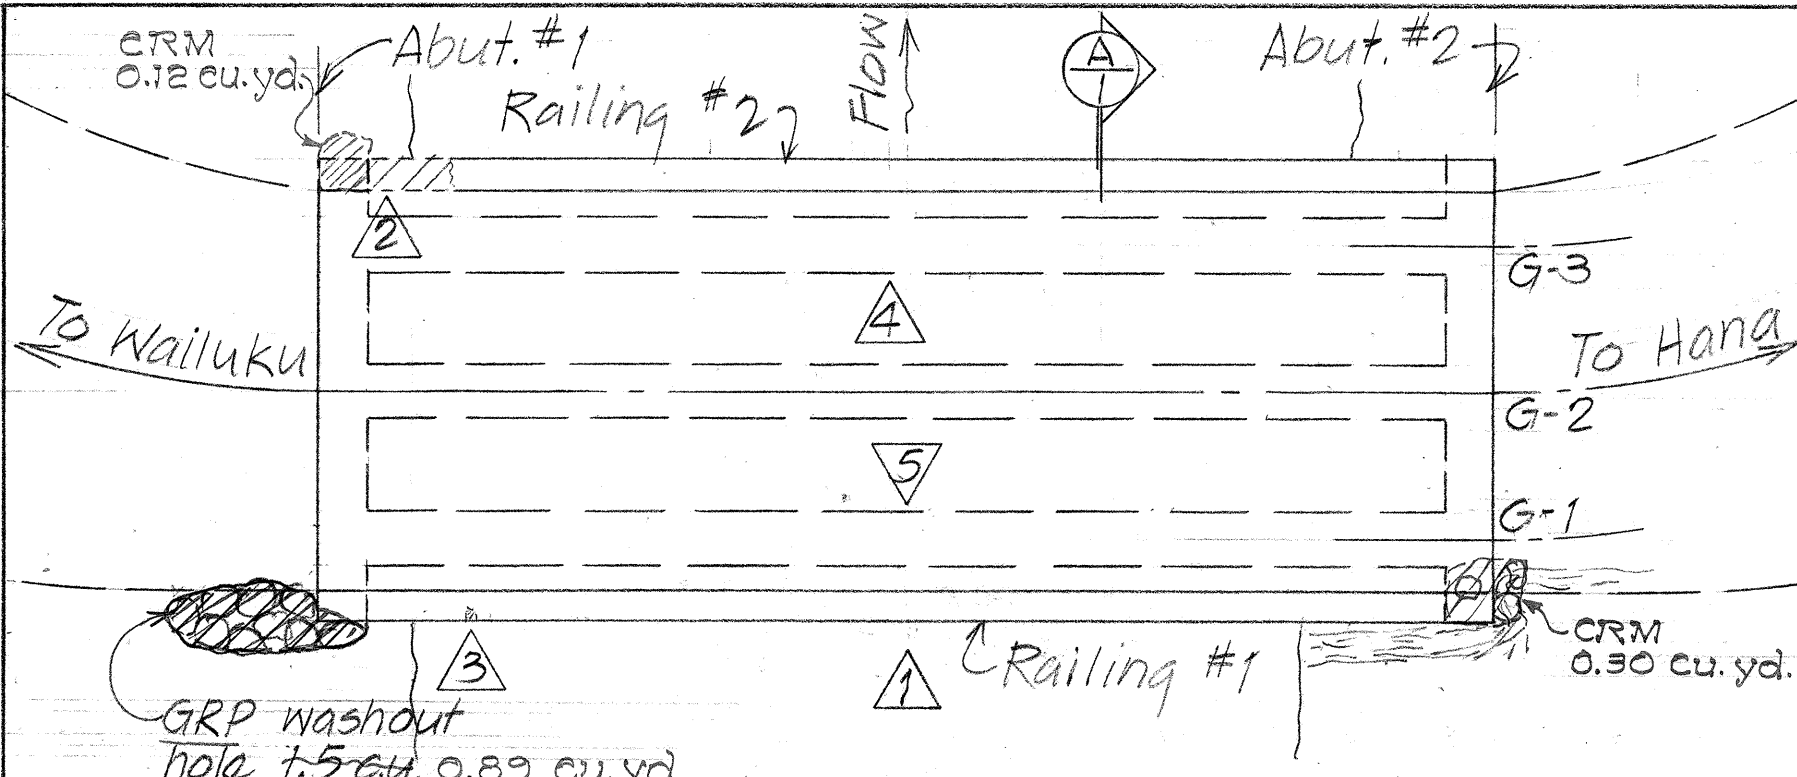


LAYOUT & FRAMING PLAN

Scale: 1/8" = 1'-0"

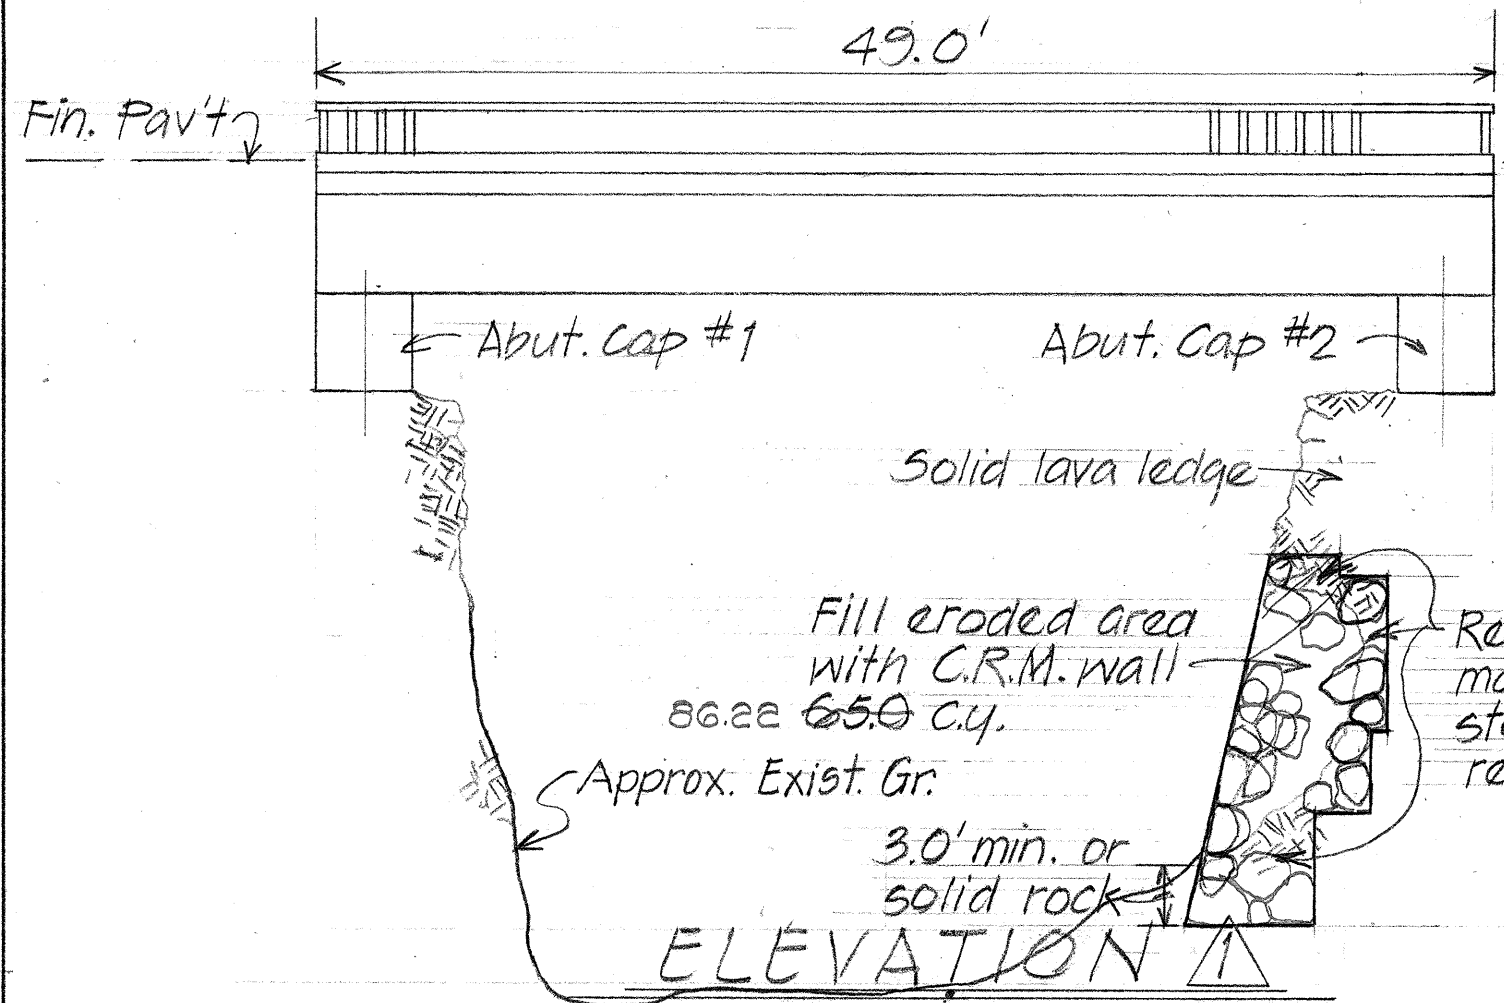


ELEVATION

Scale: 1/8" = 1'-0"

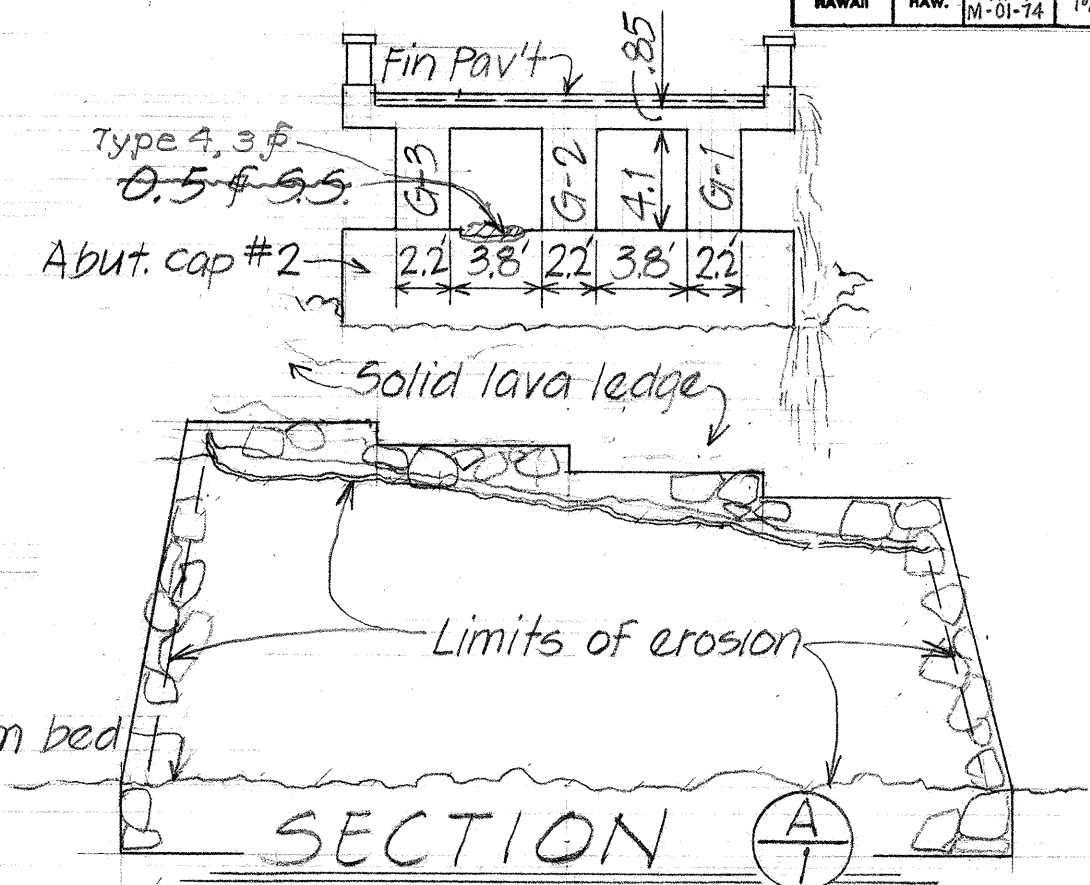

SECTION A-A

Scale: 1/8" = 1'-0"

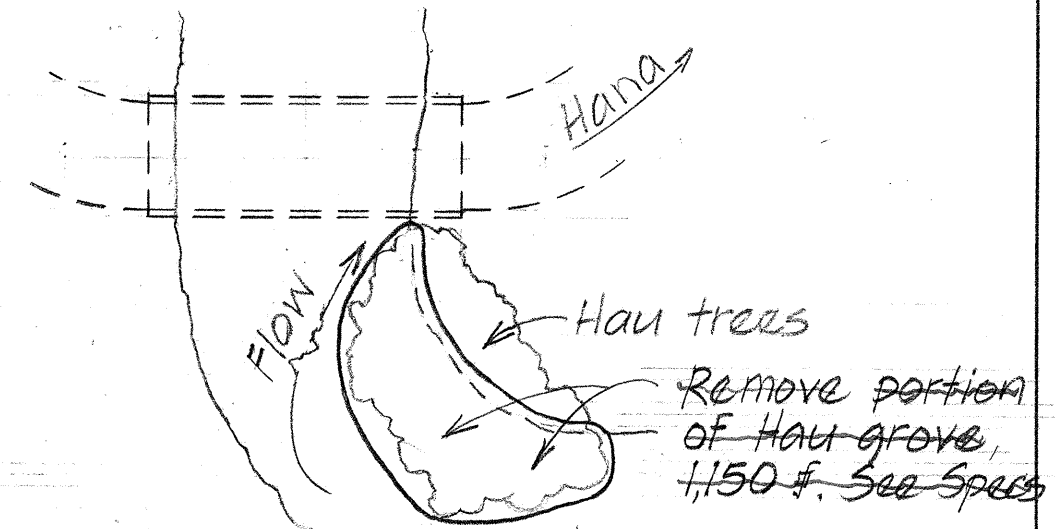

SITE PLAN





Not to Scale

Reference Notes:
Refer to sheets T1 thru T4 incl. for Typical Details.

STATE OF HAWAII
DEPARTMENT OF TRANSPORTATION
HIGHWAYS DIVISION

REHABILITATION & REPAIRS
TO HOALUA BRIDGE
PROJ. NO HWY M-01-74 Nov. 1973

FED. ROAD DIST. NO.	STATE	FED-AID PROJ. NO.	FISCAL YEAR	SHEET NO.	TOTAL SHEETS
HAWAII	HAW.	HWY M-01-74	1974	7	50

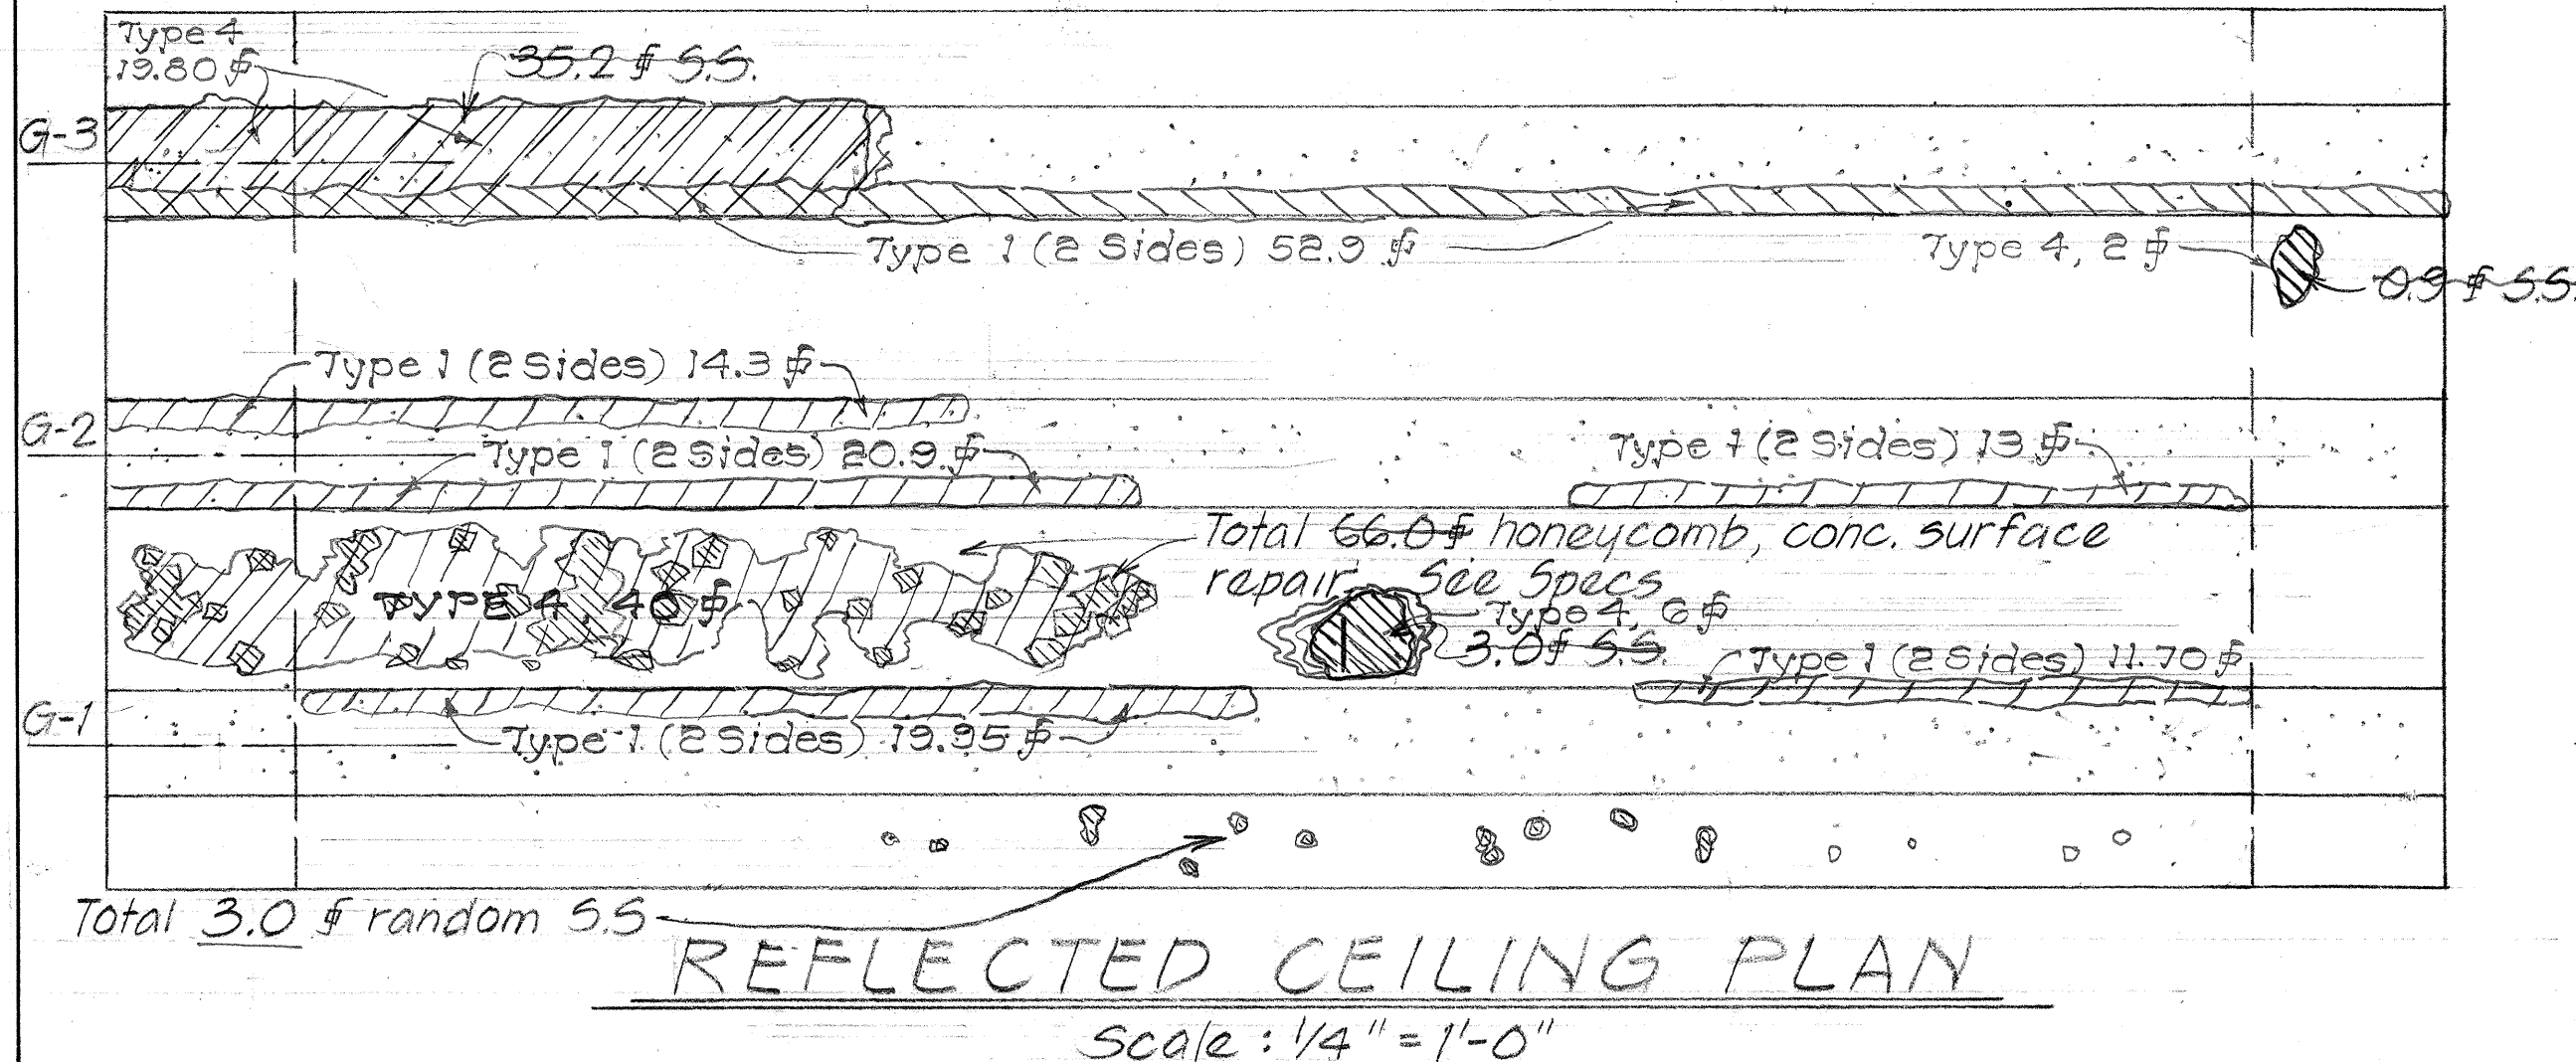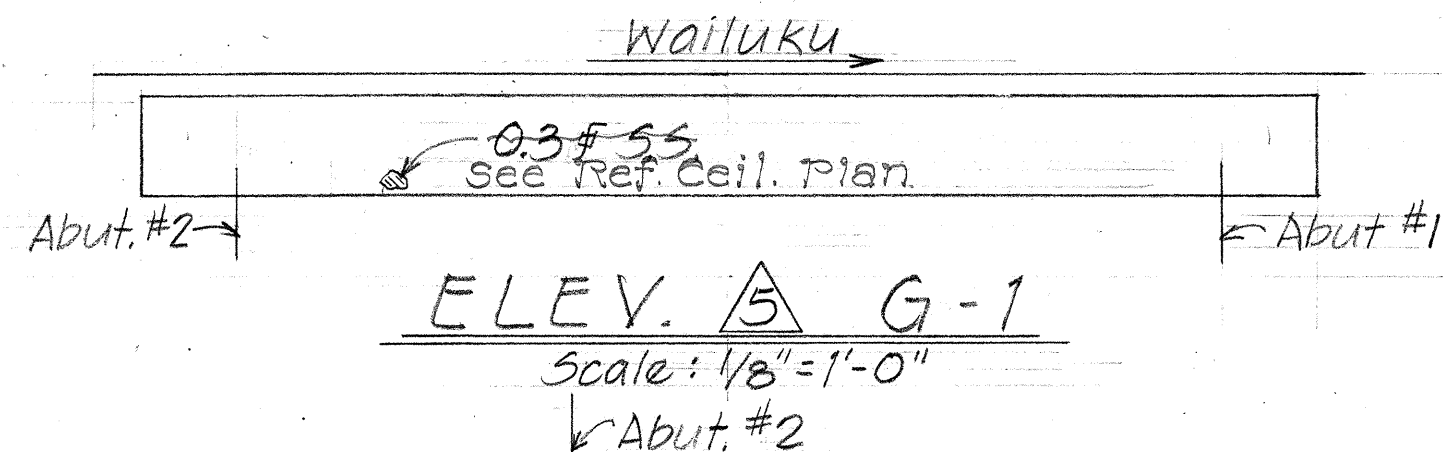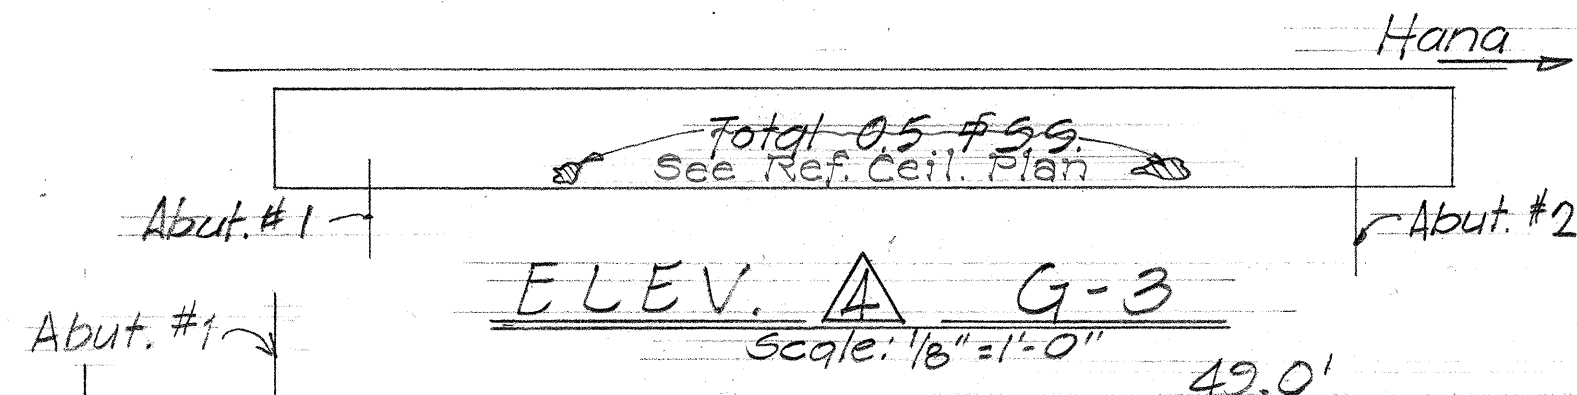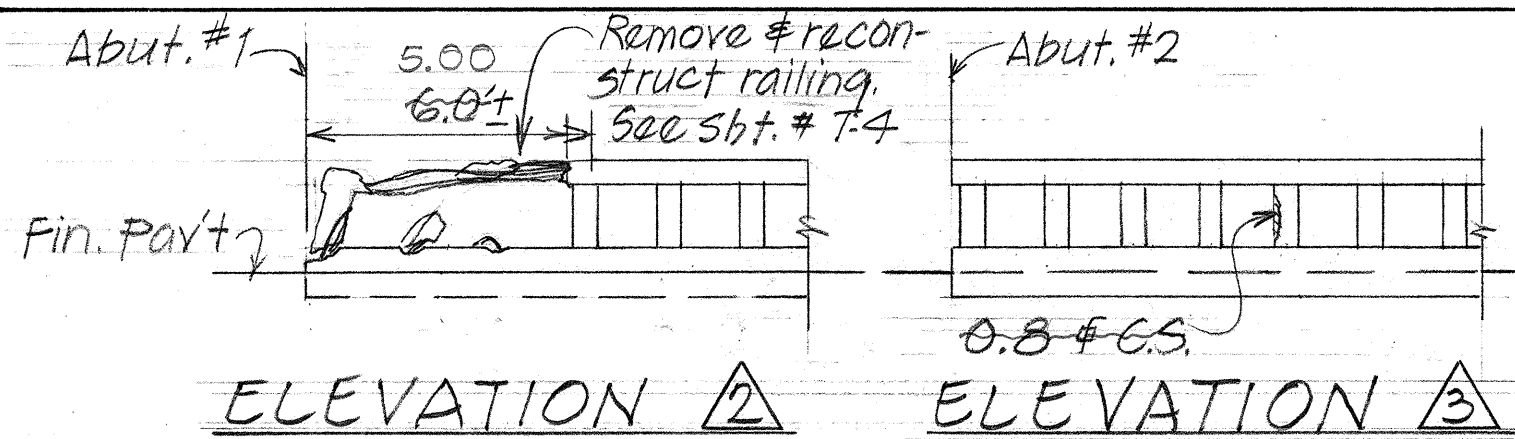

STATE OF HAWAII
DEPARTMENT OF TRANSPORTATION
HIGHWAYS DIVISION

REHABILITATION & REPAIRS
TO HOALUA BRIDGE

PROJ. NO HWY M-01-74 Nov. 1973

SHEET NO. 2 OF 2 SHEETS