





FED. ROAD DIST. NO.	STATE	FED. AID PROJ. NO.	FISCAL YEAR	SHEET NO.	TOTAL SHEETS
HAWAII	HAW.	HWY M-01-74	1974	6	50

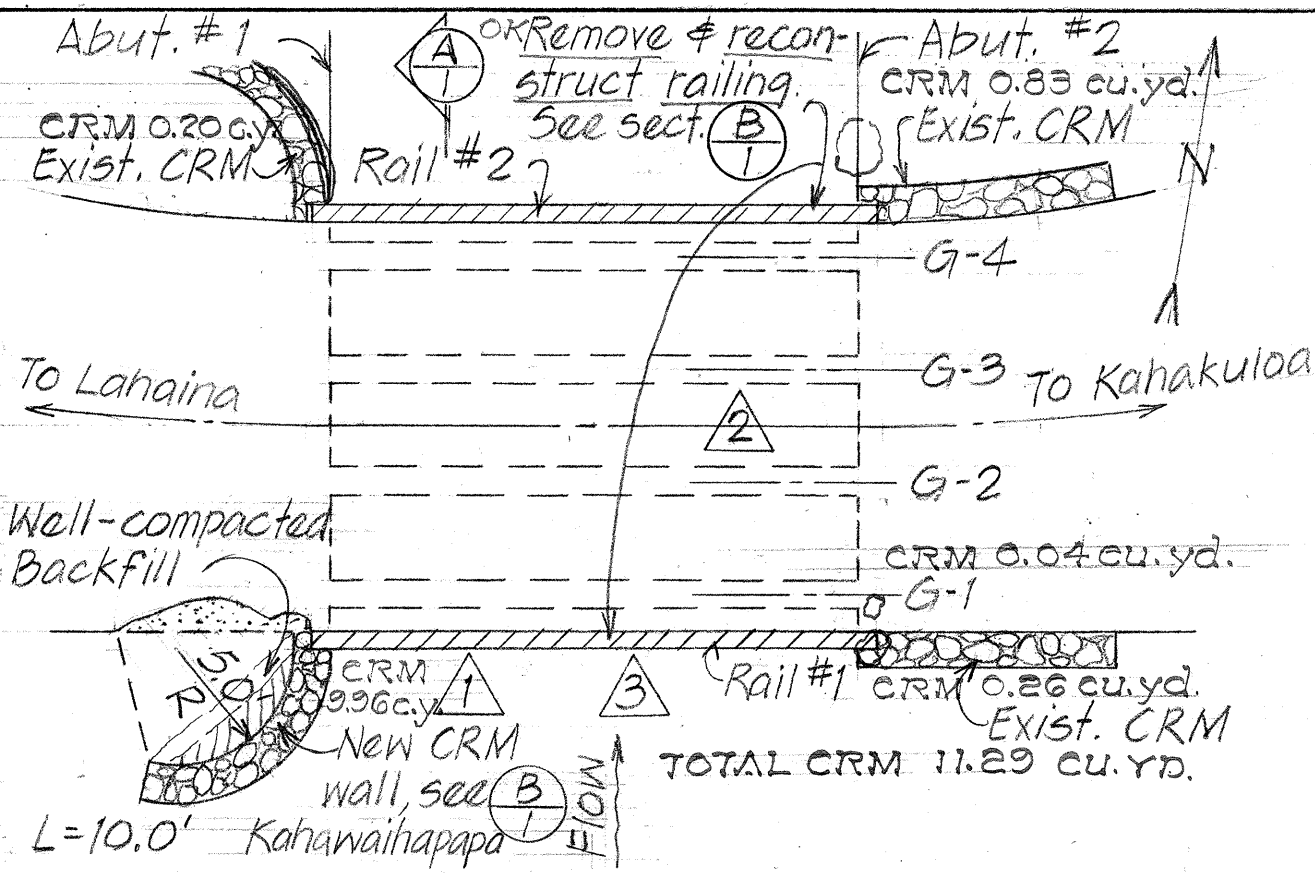


LAYOUT & FRAMING PLAN

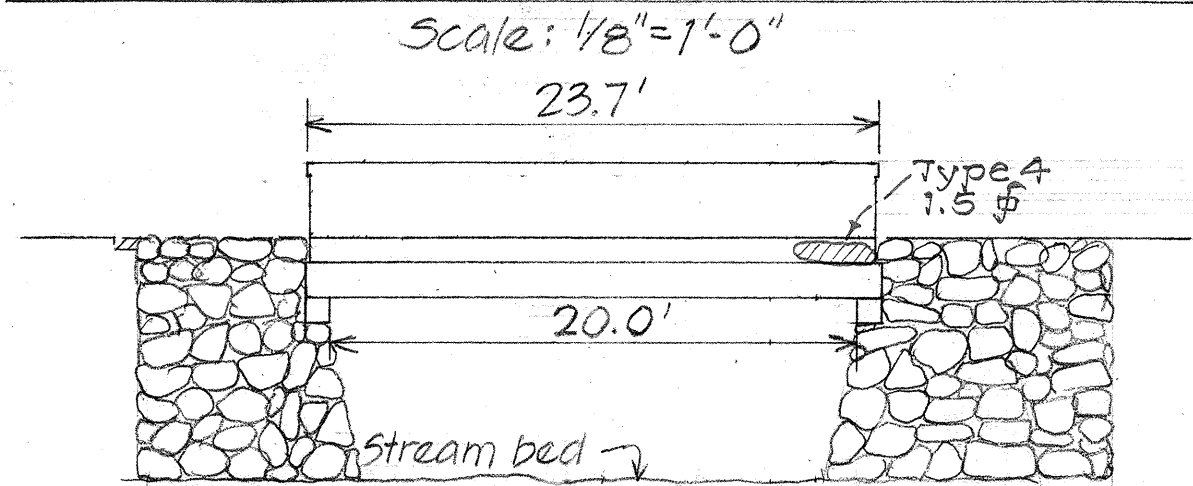

ELEVATION 1

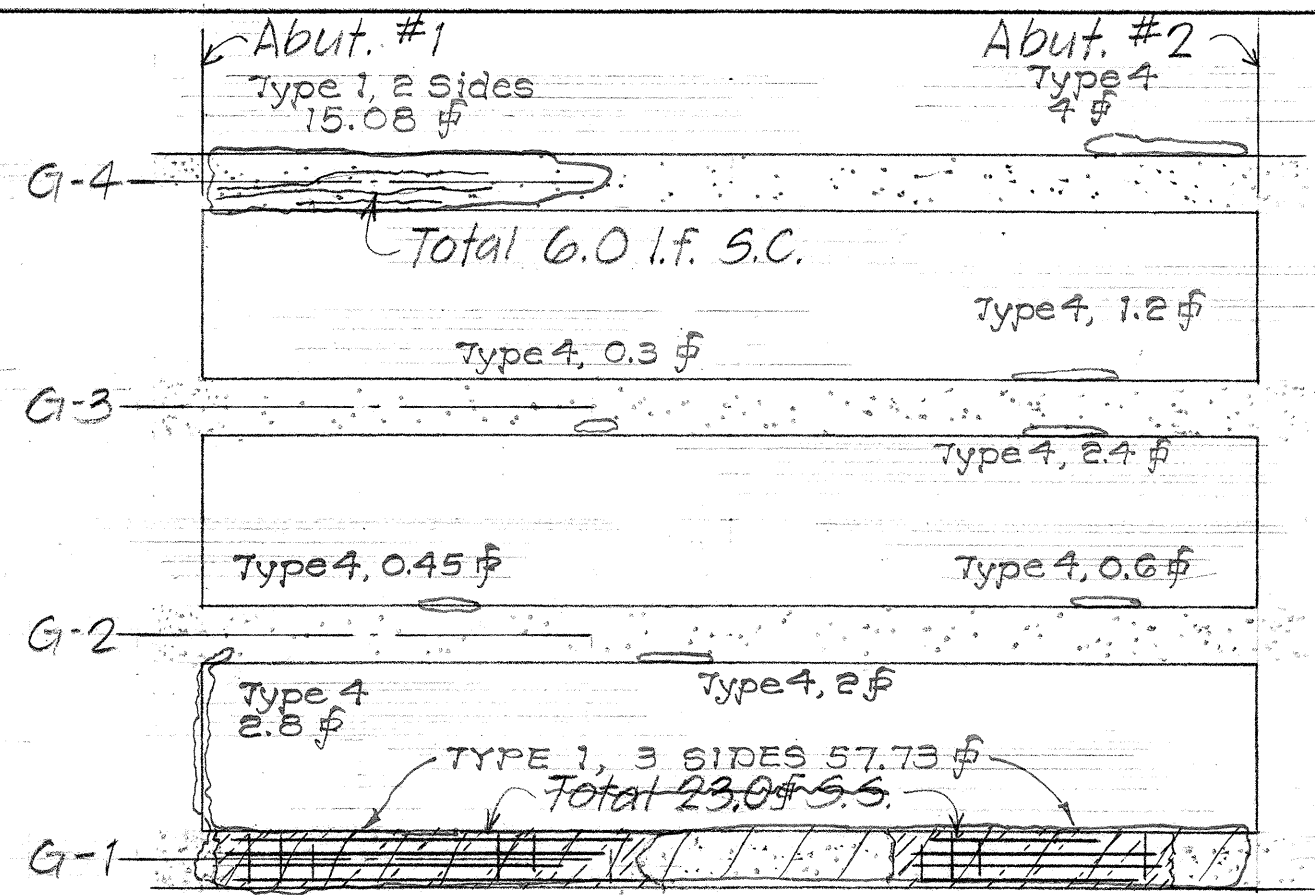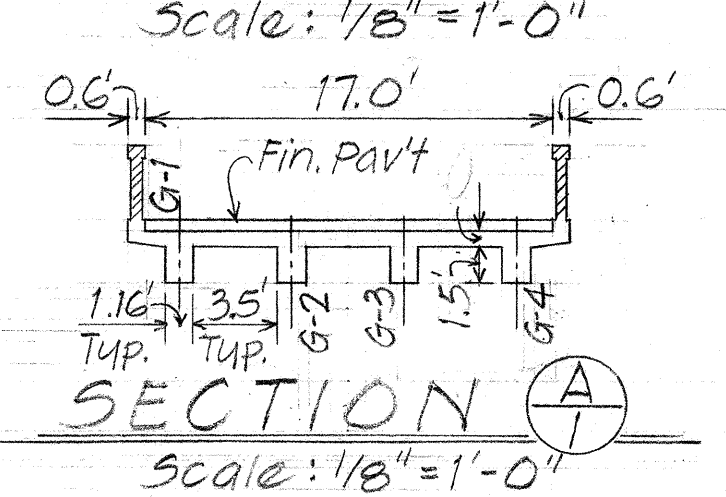


REFLECTED CEILING PLAN

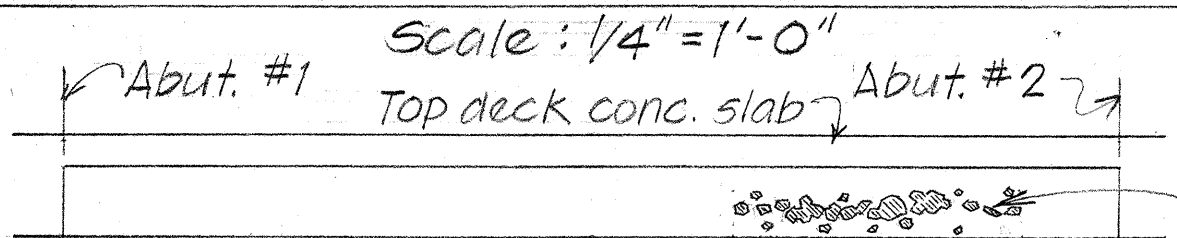


ELEV. 2 G-3

Scale: 1/4" = 1'-0"

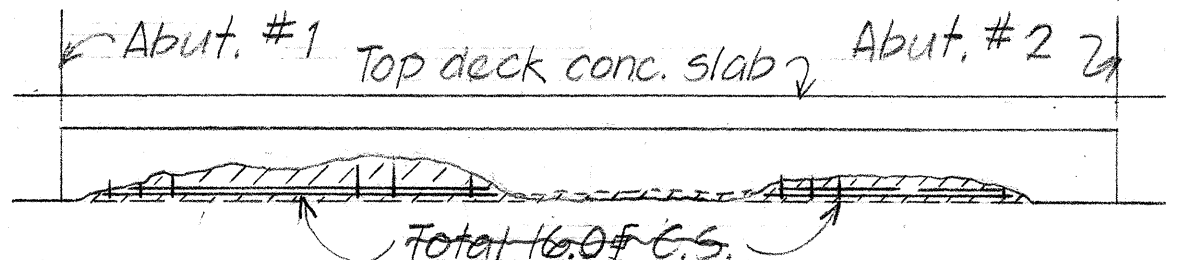

ELEV. 3 G-1

Scale: 1/4" = 1'-0"

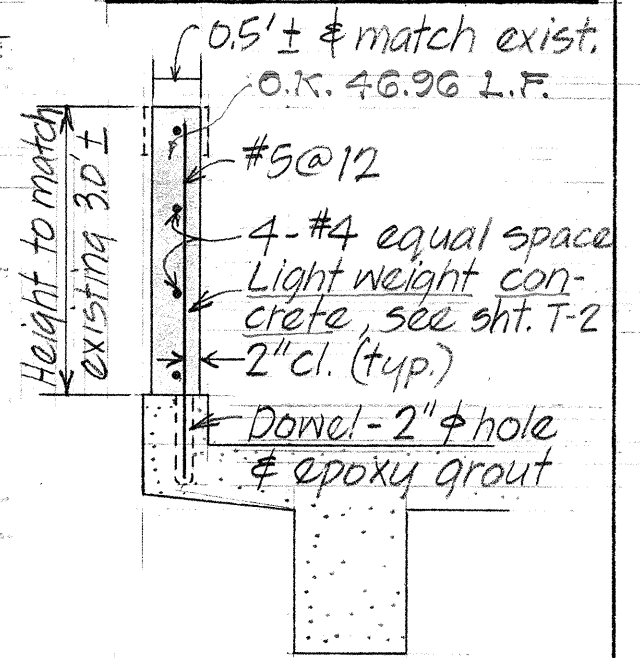

TYPICAL RAIL SECTION (B)

Scale: 1/2" = 1'-0"

Total 6.0 f honeycomb, conc. surface repair. See Specs

Reference Notes:
Refer to sheets T1 thru T-4 incl. for Typical Details.

STATE OF HAWAII
DEPARTMENT OF TRANSPORTATION
HIGHWAYS DIVISION

REHABILITATION & REPAIRS
TO HONOLUA BRIDGE

PROJ. NO. HWY M-01-74 NOV. 1973

SHEET No. 1 OF 1 SHEETS

DATE	11/2/73
DESIGNED BY	...
CHECKED BY	...
NOTED BY	...