




FED. ROAD DIST. NO.	STATE	FED. AID PROJ. NO.	FISCAL YEAR	SHEET NO.	TOTAL SHEETS
HAWAII	HAW.	HWY M-01-74	1974	50	50

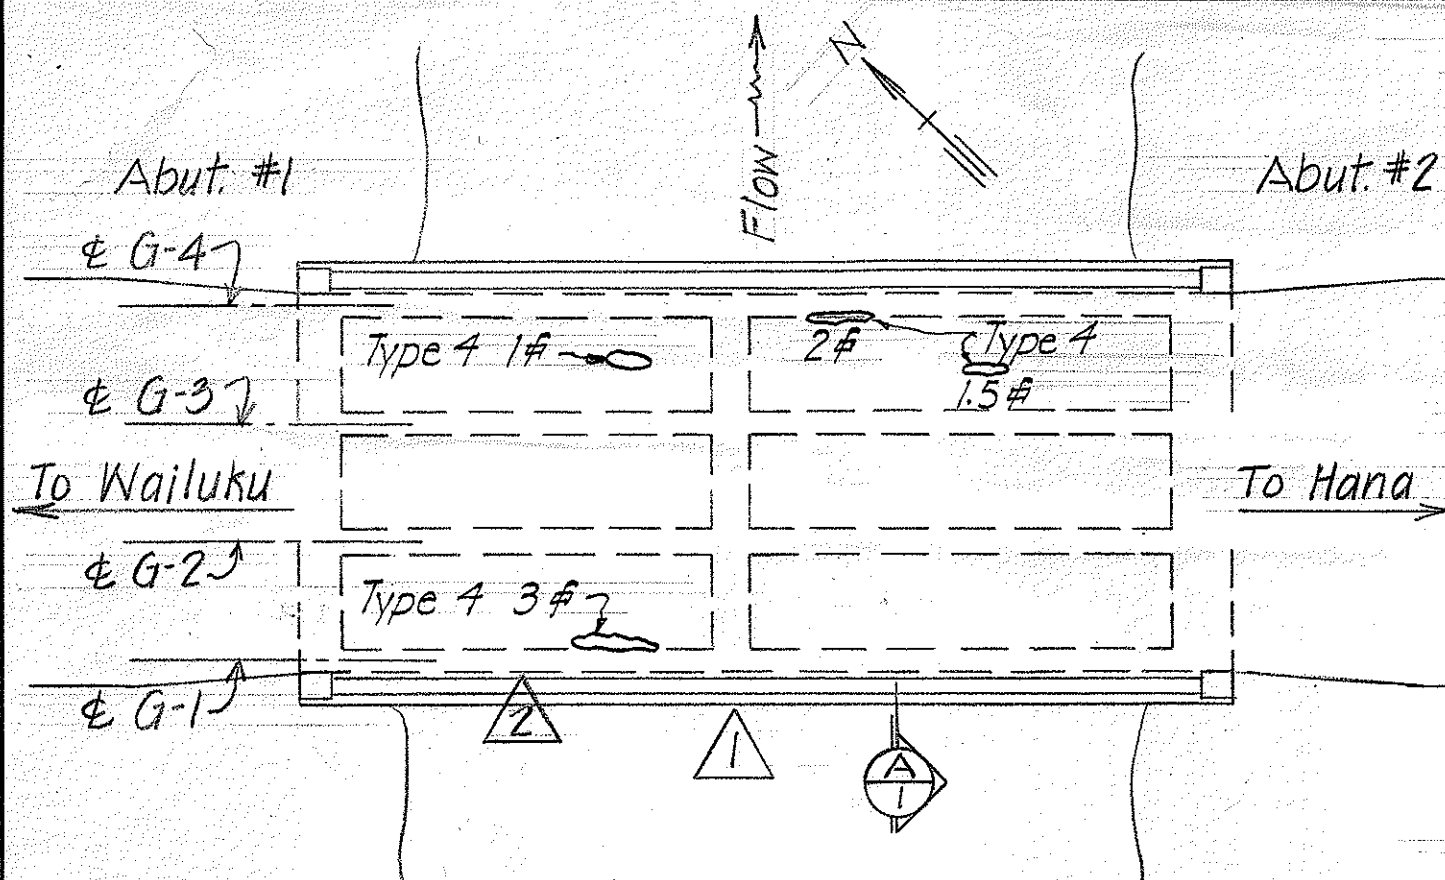


LAYOUT AND FRAMING PLAN Scale: $\frac{1}{8}" = 1'-0"$

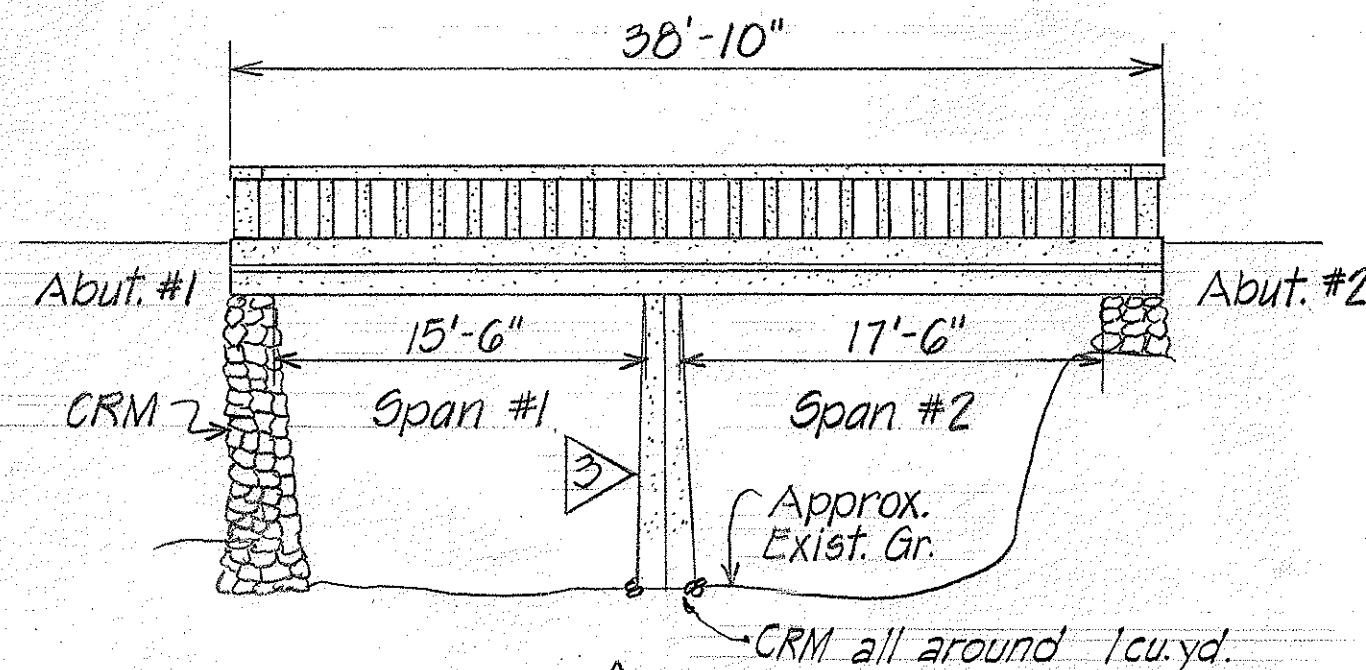


ELEVATION 1 Scale: $\frac{1}{8}" = 1'-0"$

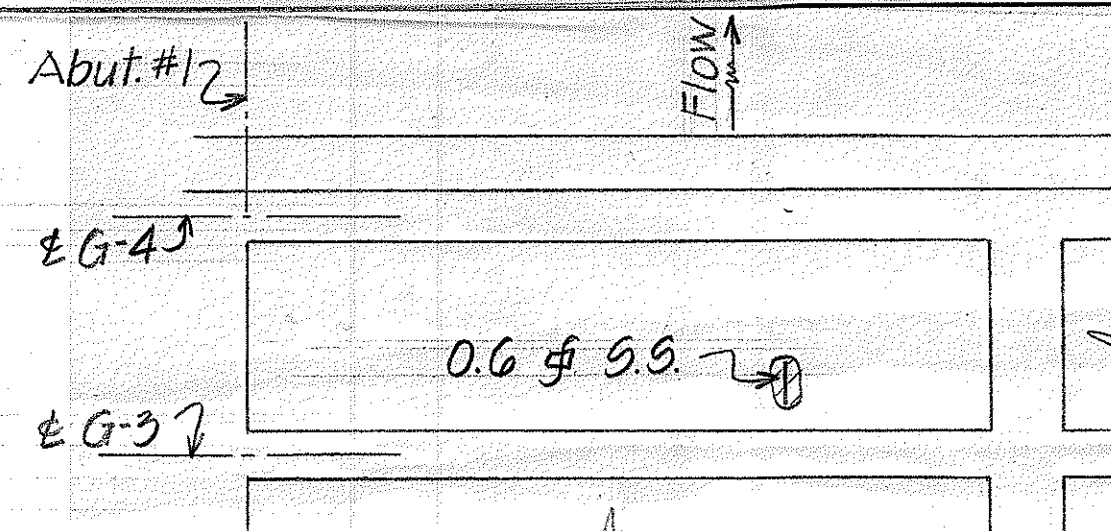


PART REFLECTED CEILING PLAN Scale: $\frac{1}{4}" = 1'-0"$

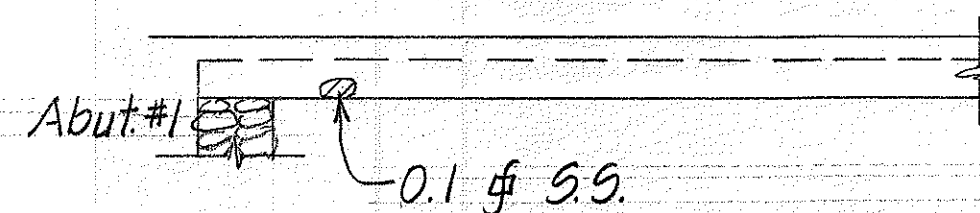

ELEVATION 2 Scale: $\frac{1}{4}" = 1'-0"$

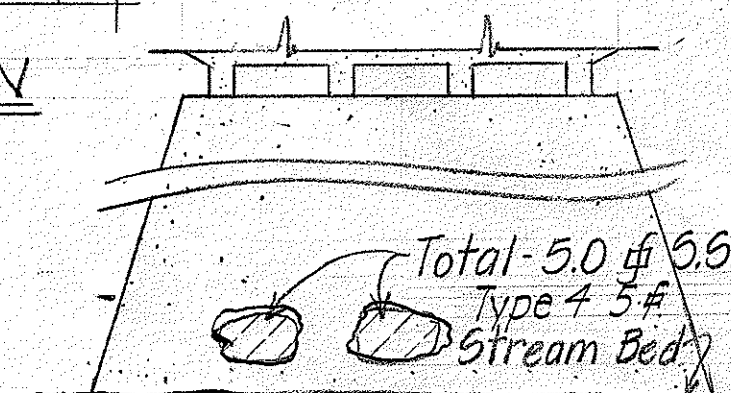

ELEVATION 3 No Scale

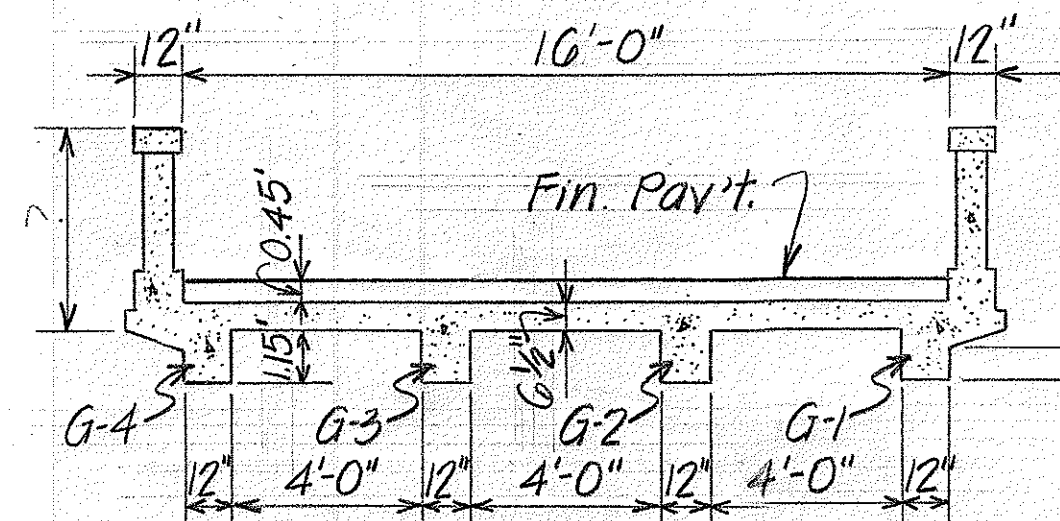

NORMAL DECK SECTION (A-T) Scale: $\frac{1}{4}" = 1'-0"$

Reference Note:
Refer to Sheets T-1 thru T-4 incl. for Typical Details.

DESIGNED BY	DATE
DRAWN BY	11-13
CHECKED BY	
NOTED BY	
APPROVED BY	

STATE OF HAWAII DEPARTMENT OF TRANSPORTATION HIGHWAYS DIVISION
REHABILITATION & REPAIRS TO HONOMAELE BRIDGE
PROJ. NO. HWY M-01-74 Nov. 1973
SHEET No. 1 OF 1 SHEETS