




FED. ROAD DIST. NO.	STATE	FIS-AB-PROJ. NO.	FISCAL YEAR	SHEET NO.	TOTAL SHEETS
HAWAII	HAW.	HWY M-01-74	1974	41	50

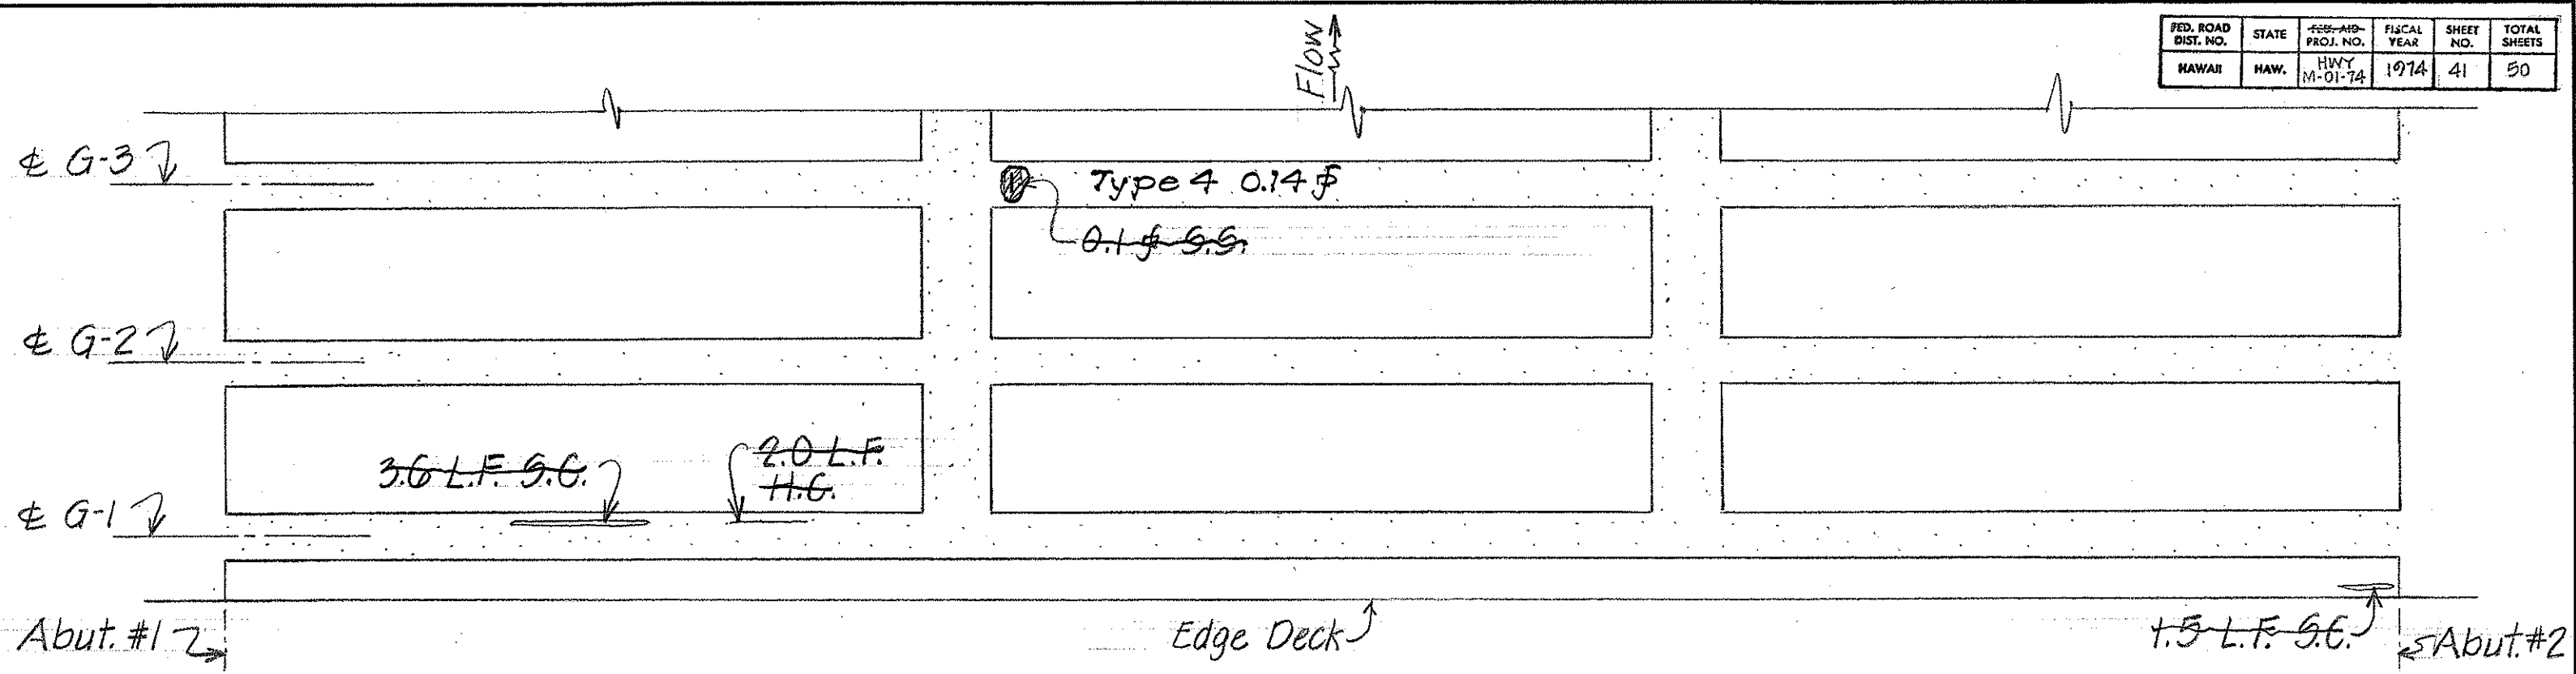


PART REFLECTED CEILING PLAN Scale: 1/4"=1'-0"

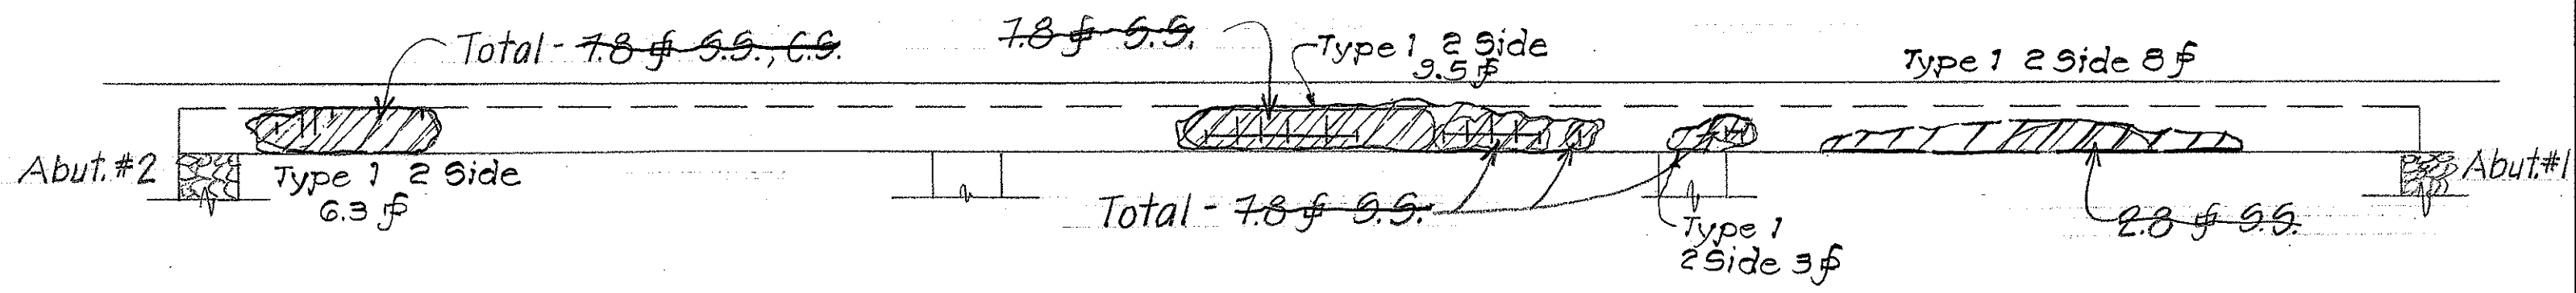


ELEVATION 1 Scale: 1/4"=1'-0"

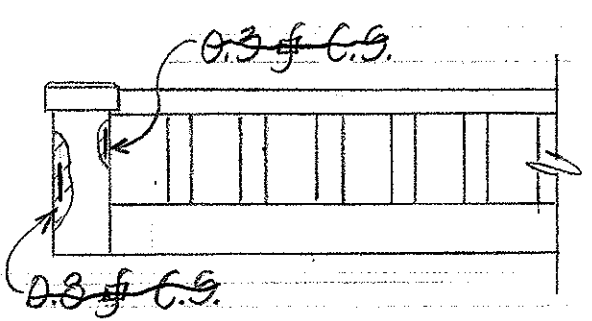

ELEVATION 4 Scale: 1/4"=1'-0"

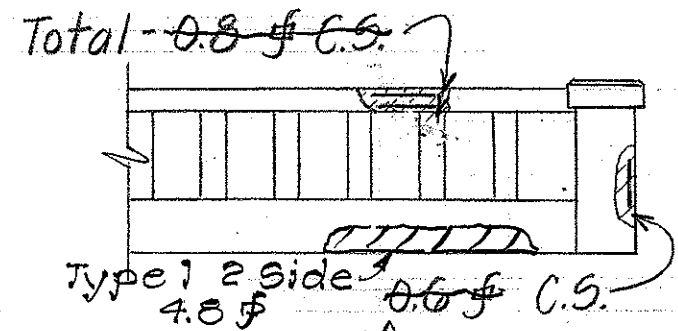

ELEVATION 3 Scale: 1/4"=1'-0"

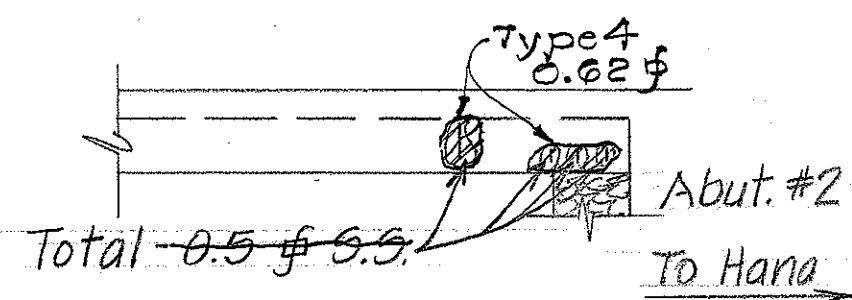

ELEVATION 2 Scale: 1/4"=1'-0"

STATE OF HAWAII
DEPARTMENT OF TRANSPORTATION
HIGHWAYS DIVISION

REHABILITATION & REPAIRS
TO KAHAWAITHAPAPA BRIDGE

PROJ. No HWY M-01-74 Nov. 1973

SHEET No. 2 OF 2 SHEETS

ORIGINAL
PLAN
DATE
DRAWN BY
DESIGNED BY
CHECKED BY
NOTED BY