




FED. ROAD DIST. NO.	STATE	FED-AID PROJ. NO.	FISCAL YEAR	SHEET NO.	TOTAL SHEETS
HAWAII	HAW.	HWY M-01-74	1974	42	50

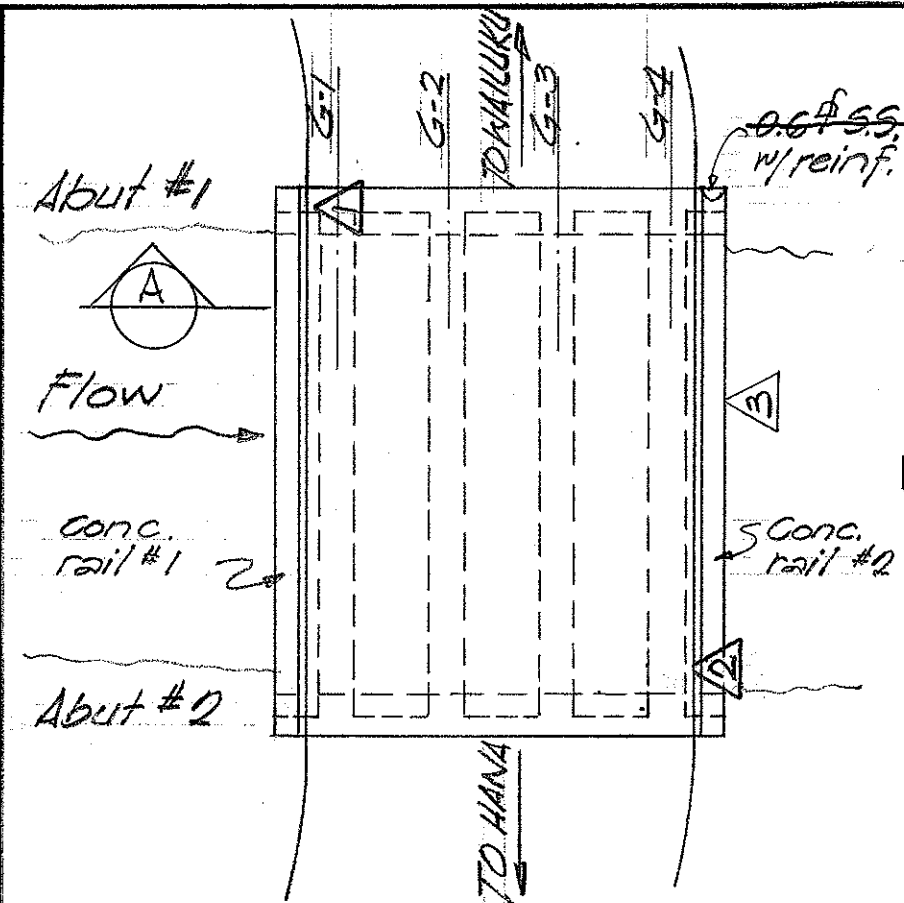

LAYOUT AND FRAMING PLAN
Scale: 1/8" = 1'-0"

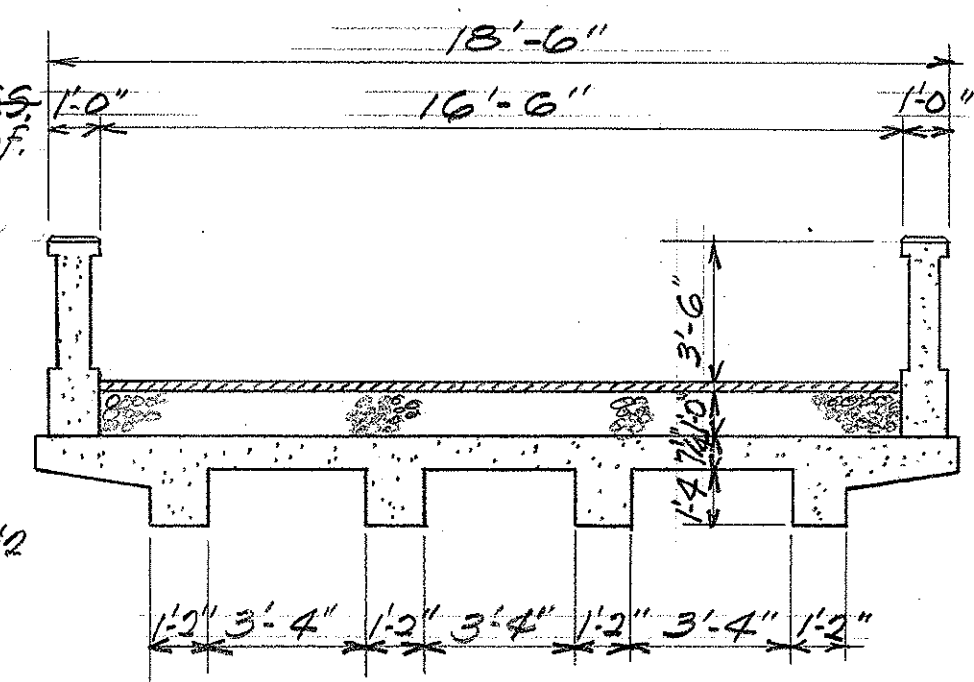


SECTION A
Scale: 1/4" = 1'-0"

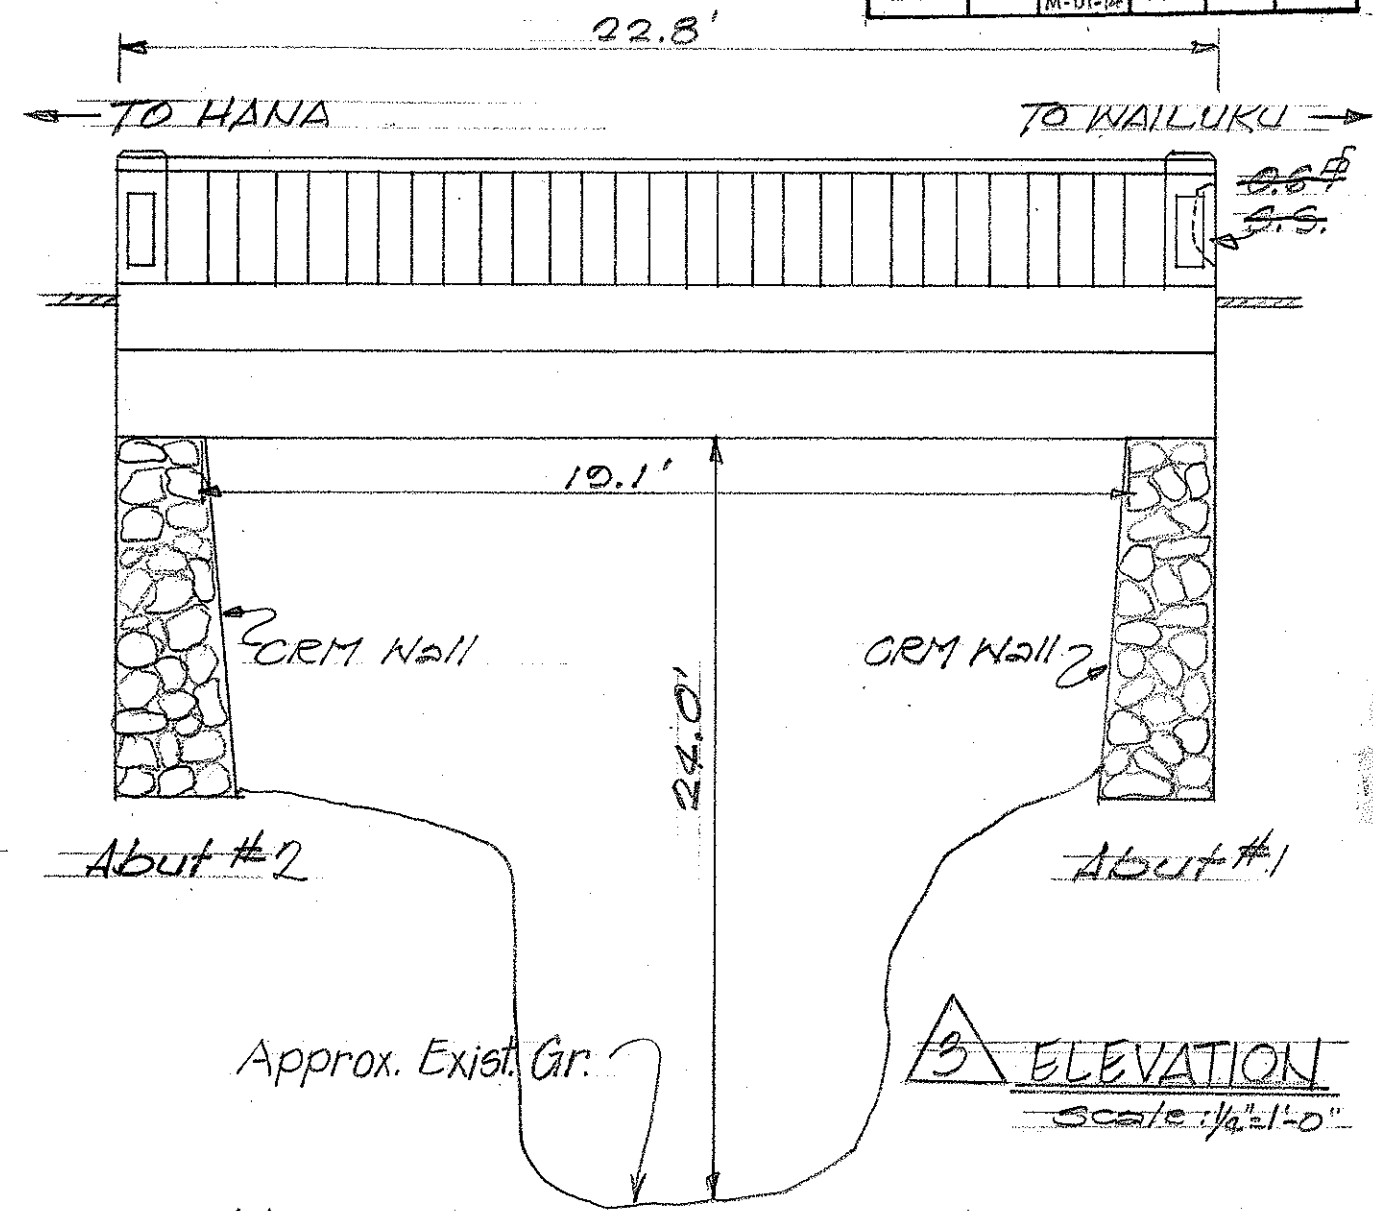


ELEVATION B
Scale: 1/4" = 1'-0"


Reference Note:
Refer to Sheets T-1 thru T-4 incl. for Typical Details.

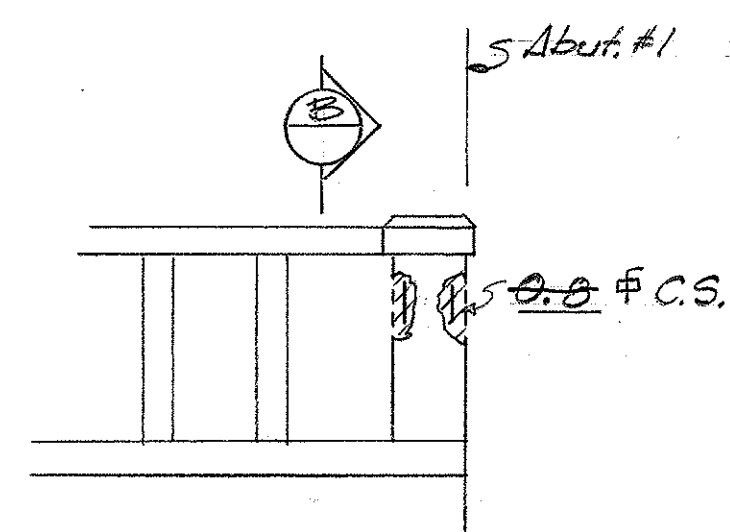

ELEVATION A
Scale: 3/8" = 1'-0"

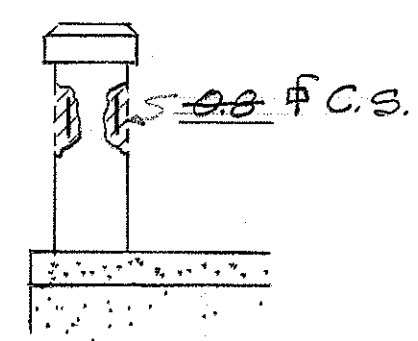

ELEVATION B
Scale: 3/8" = 1'-0"

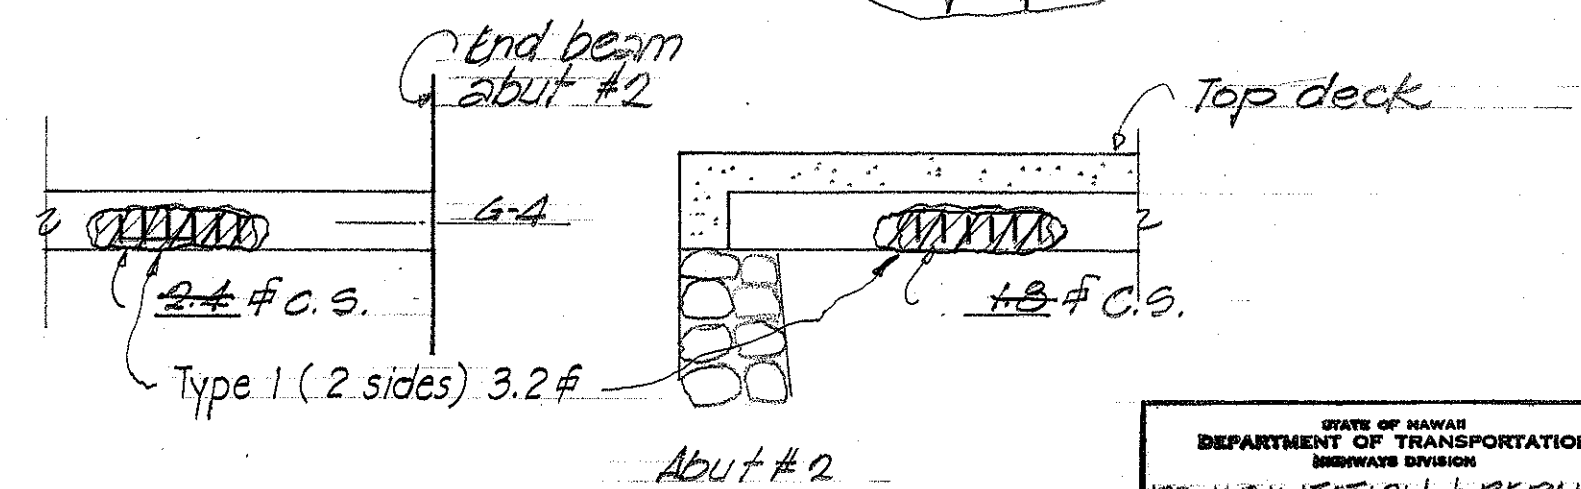

PART REFLECTED CEILING PLAN-G4
Scale: 1/4" = 1'-0"

ELEVATION 2
Scale: 1/4" = 1'-0"

STATE OF HAWAII
DEPARTMENT OF TRANSPORTATION
HIGHWAYS DIVISION

REHABILITATION & REPAIRS
TO KEAAIKI BRIDGE

Proj. No. HWY M-01-74 Nov. 1973

SHEET No. 42 OF 50 SHEETS

DESIGNED BY	DATE
DRAWN BY	12-23
CHECKED BY	
NOTED BY	