
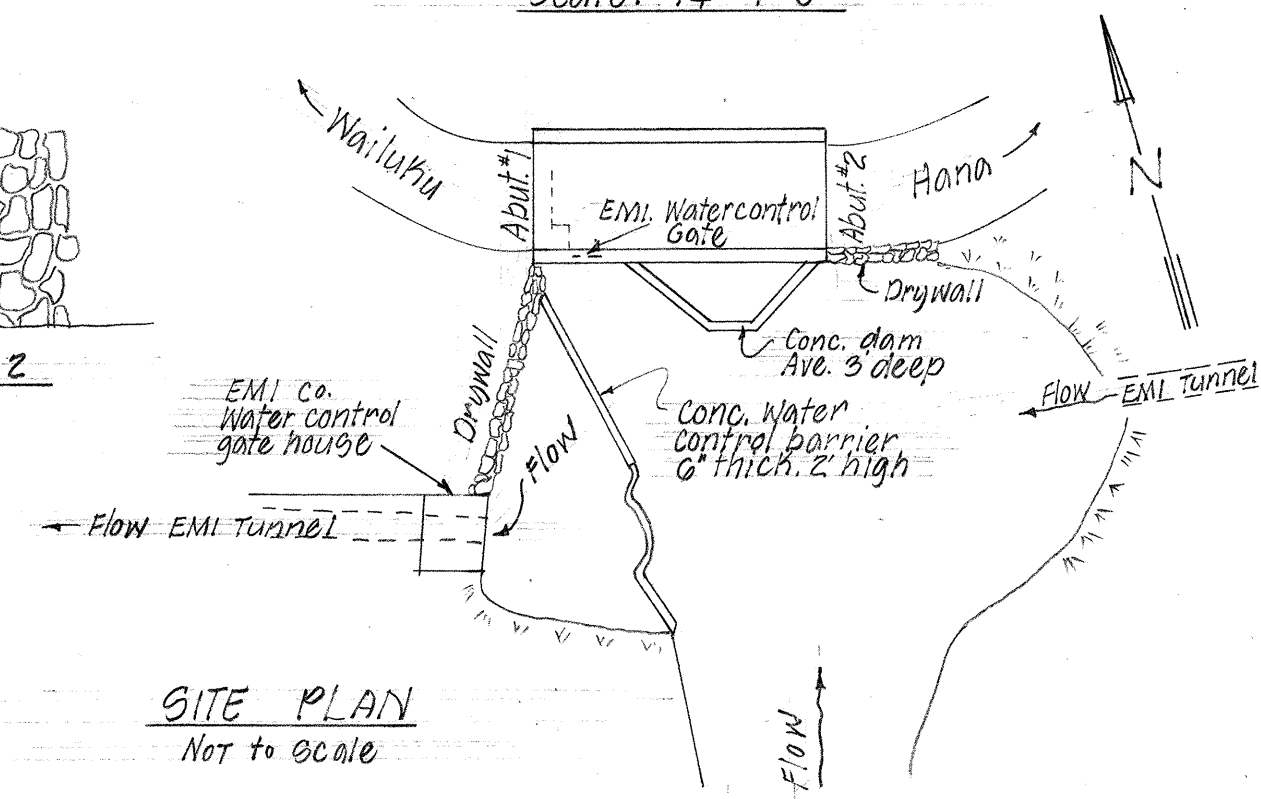
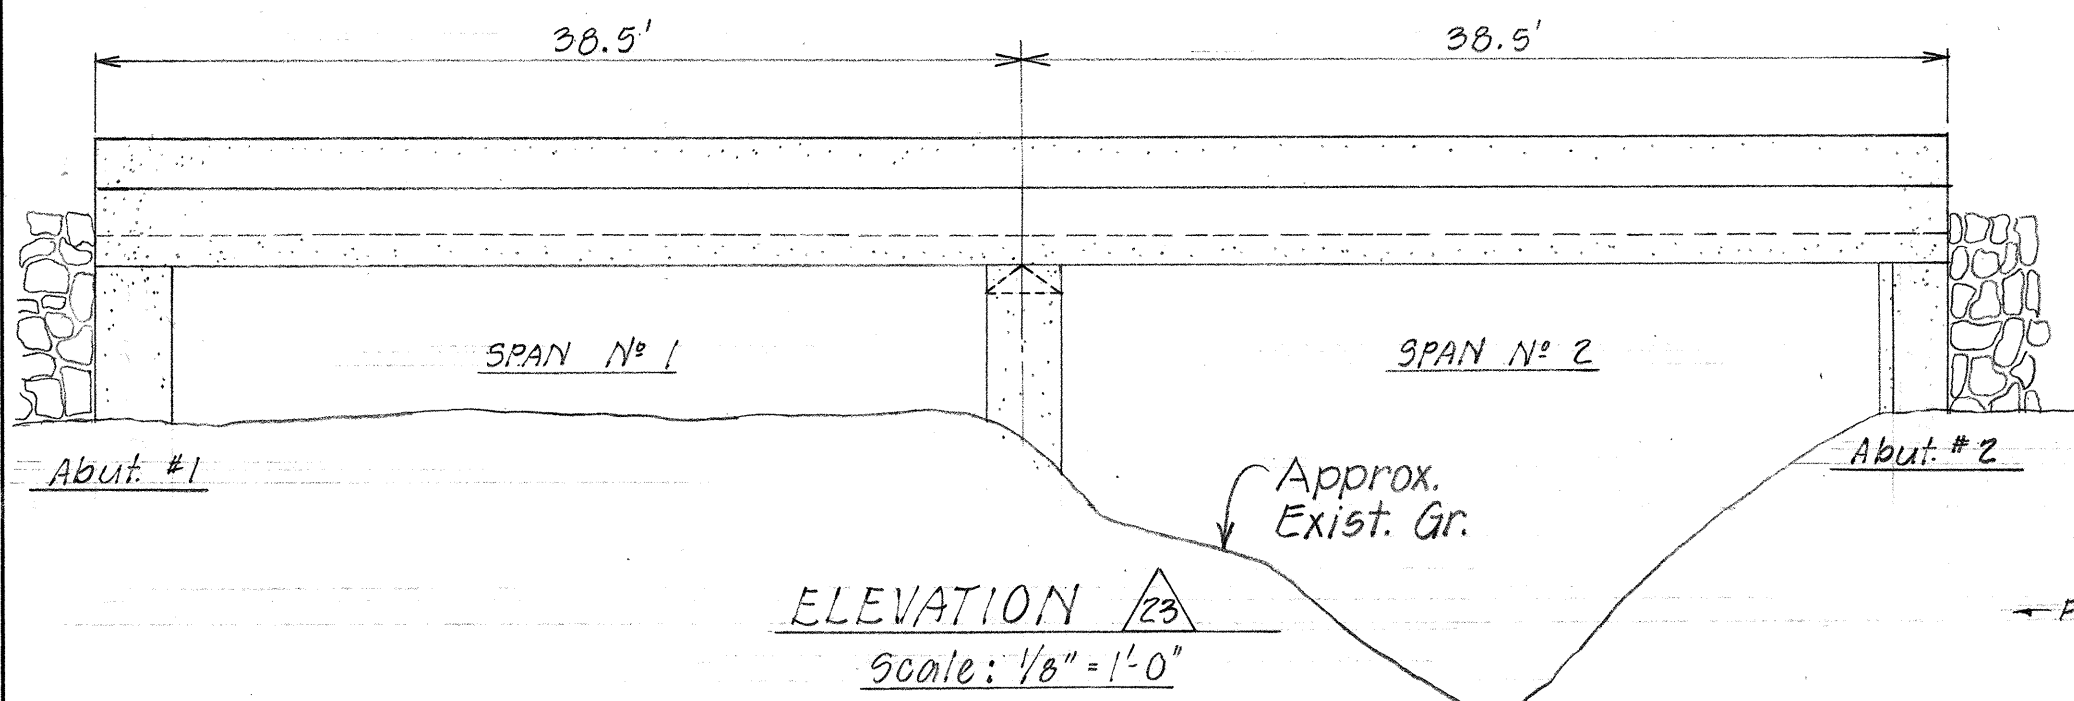
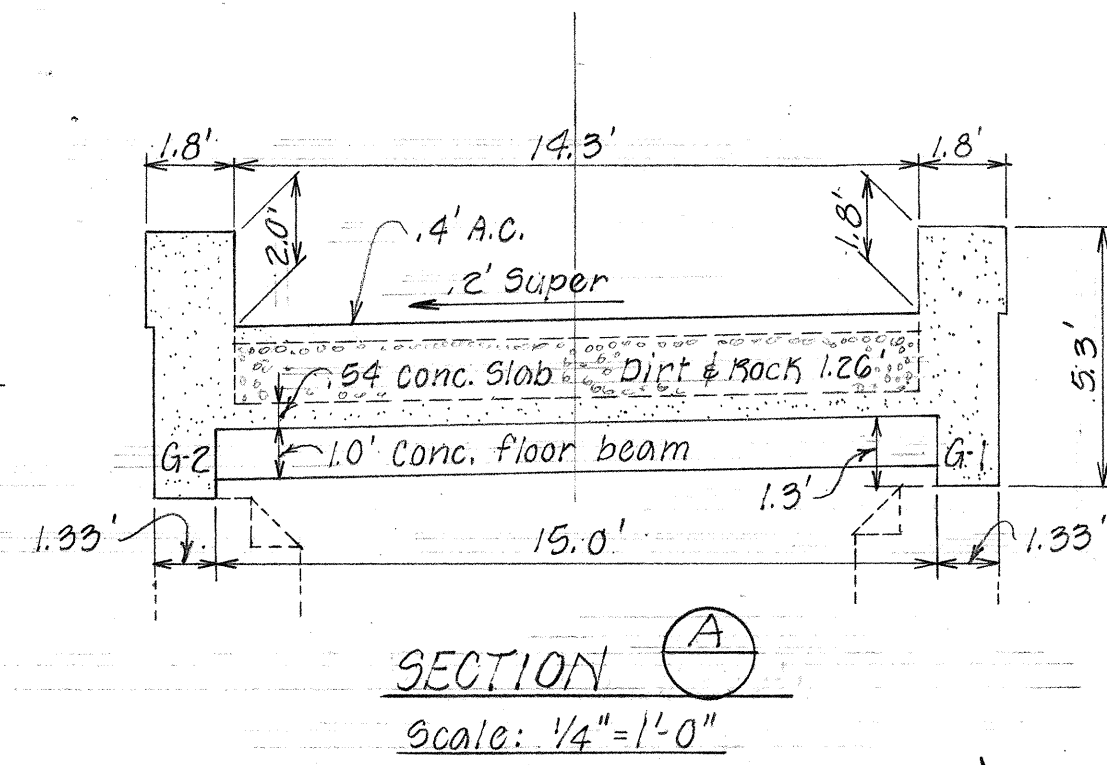


FED. ROAD DIST. NO.	STATE	FED. AID PROJ. NO.	FISCAL YEAR	SHEET NO.	TOTAL SHEETS
HAWAII	HAW.	HWY M-01-74	1974	24	50

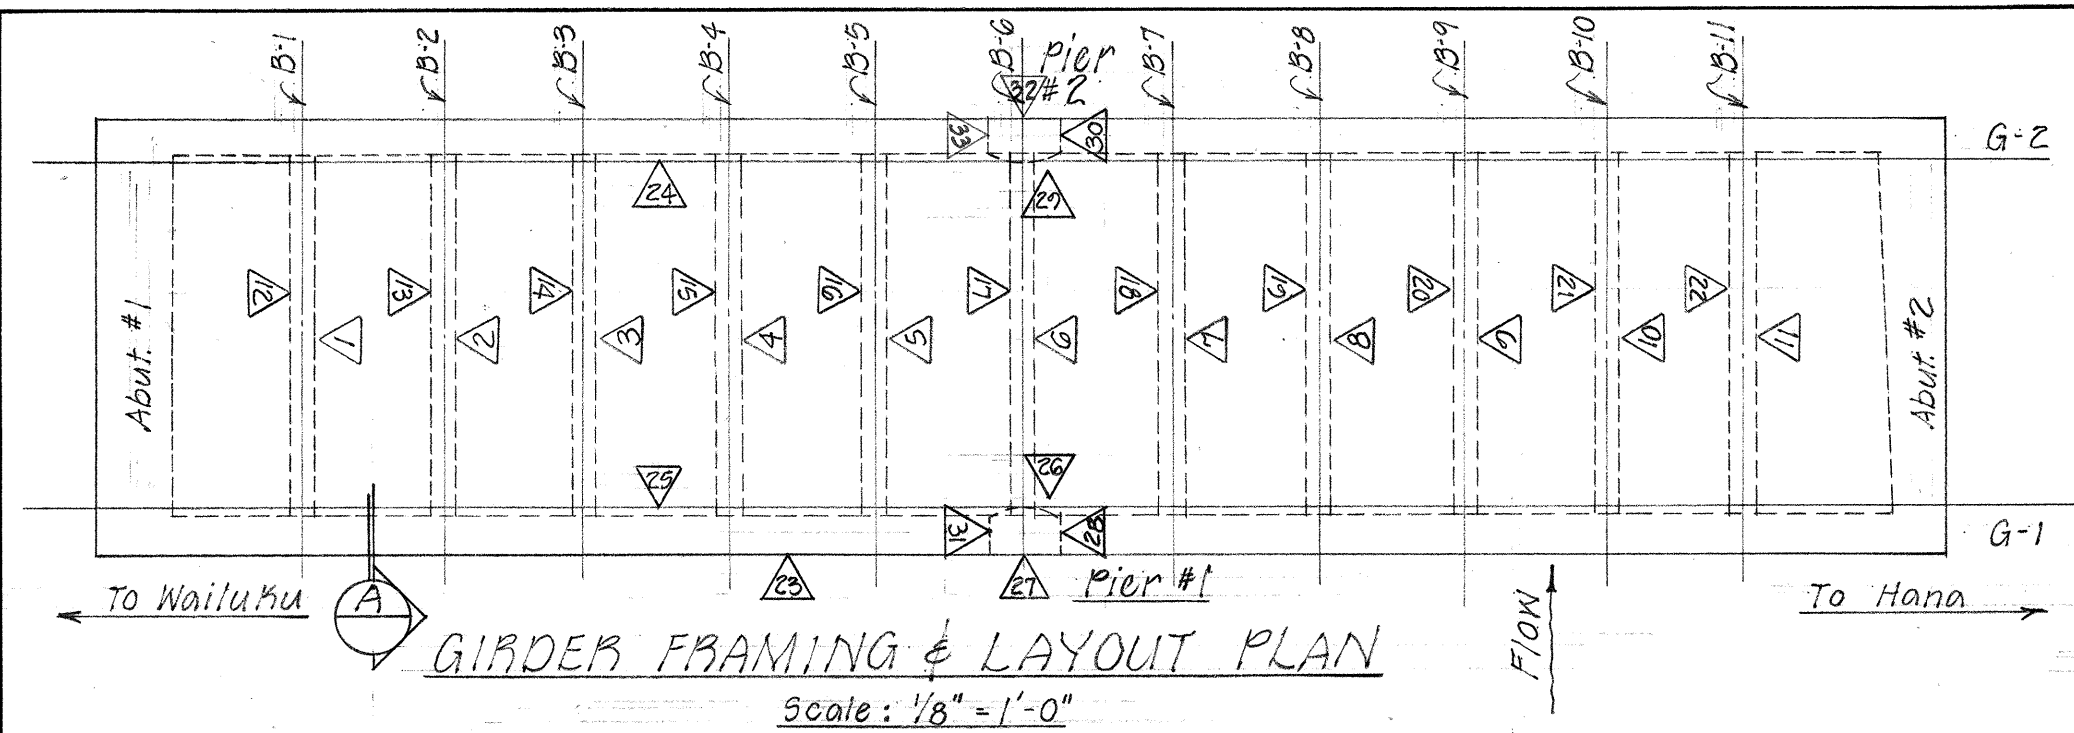

Reference Notes:
Refer to sheets T1 thru T4
incl. for Typical Details.

STATE OF HAWAII
DEPARTMENT OF TRANSPORTATION
HIGHWAYS DIVISION

REHABILITATION & REPAIRS
TO KOPIILIULA BRIDGE


HWY-M-01-74 NOV. 1973

SHEET No. 1 OF 6 SHEETS


DESIGNED BY	DATE
DRAWN BY	3/73
CHECKED BY	
IN CHARGE	
APPROVED BY	

360-018

FED. ROAD DIST. NO.	STATE	FED-AID PROJ. NO.	FISCAL YEAR	SHEET NO.	TOTAL SHEETS
HAWAII	HAW.	HWY M-01-74	1974	25	50

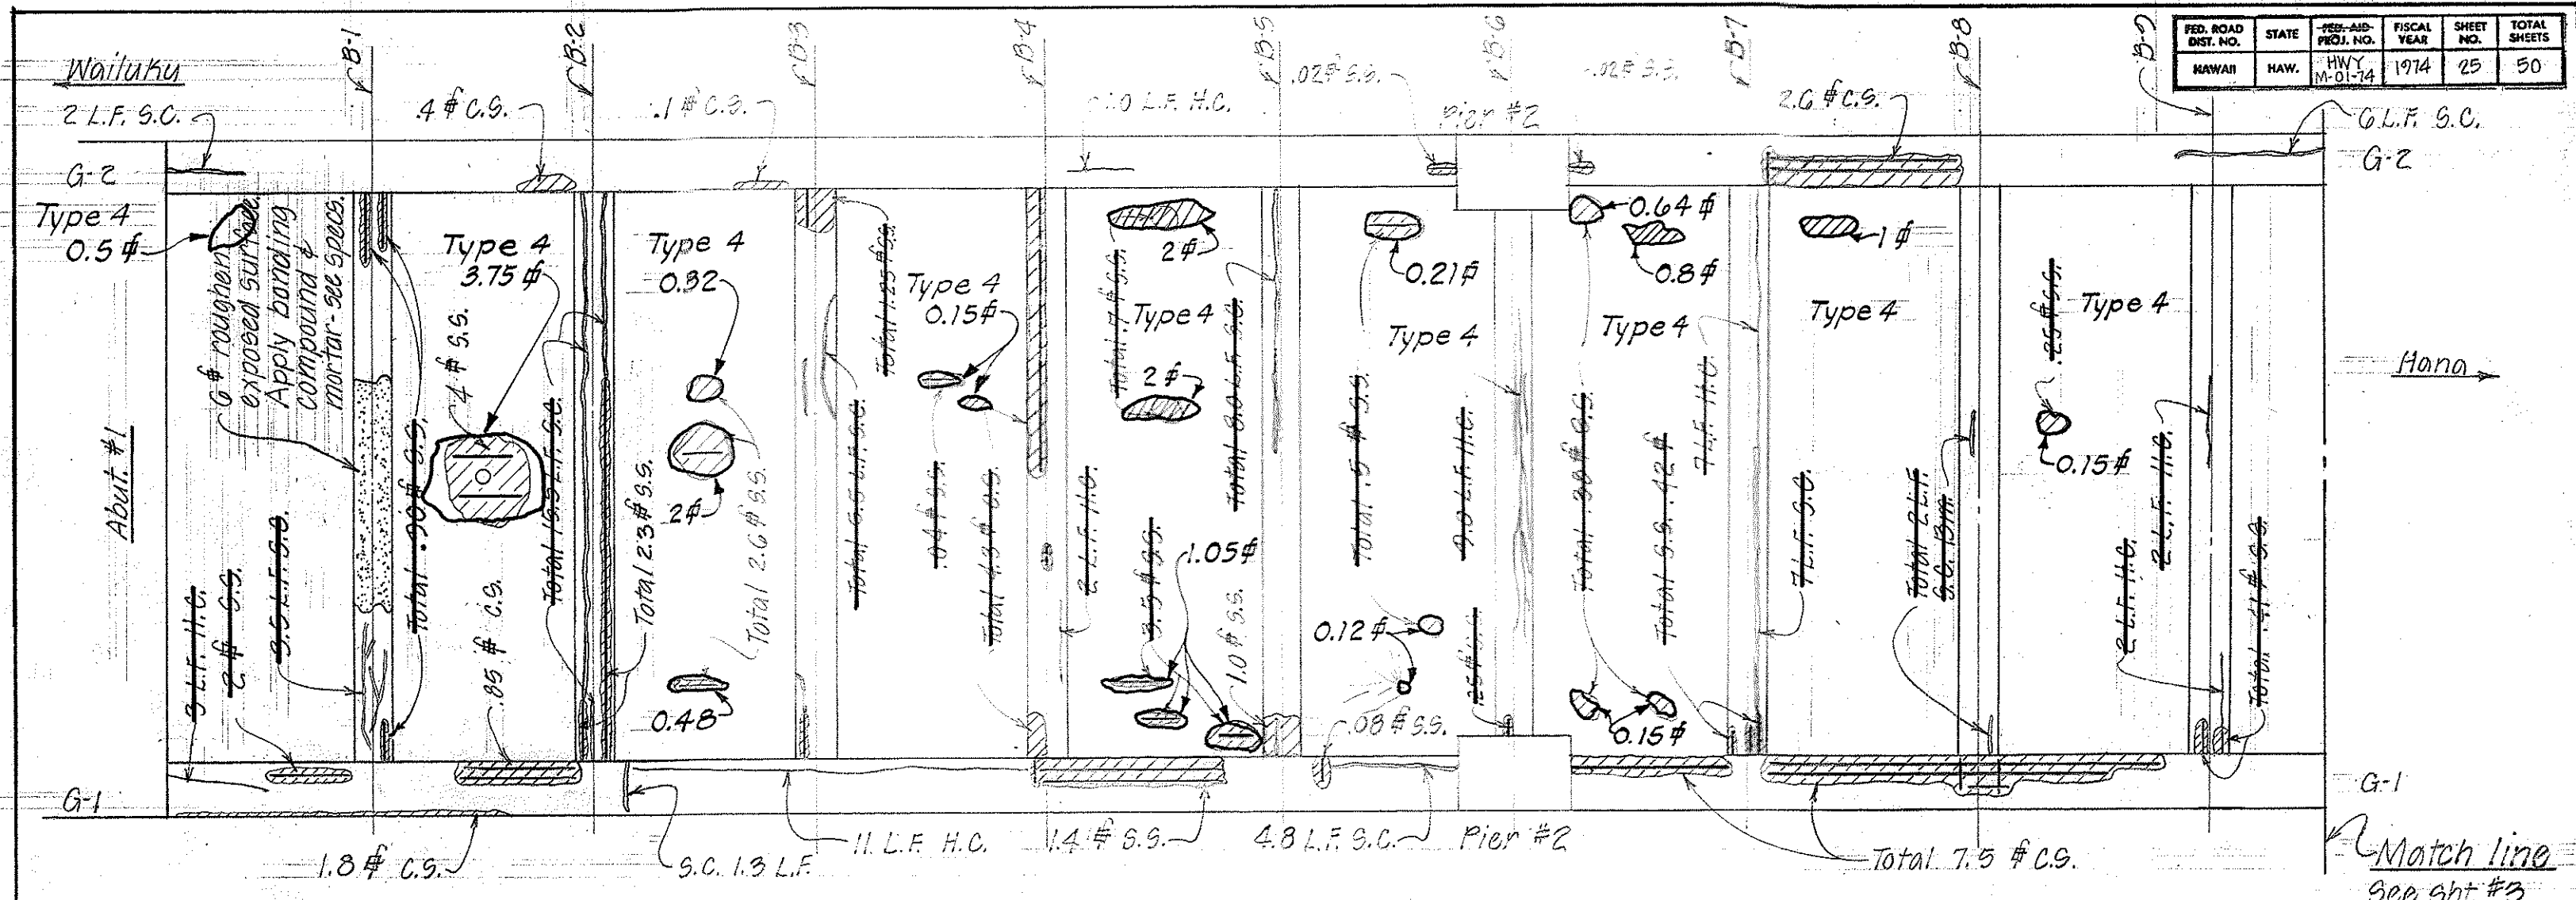

PART. REFLECTED CEILING PLAN
Scale: 1/4" = 1'-0"

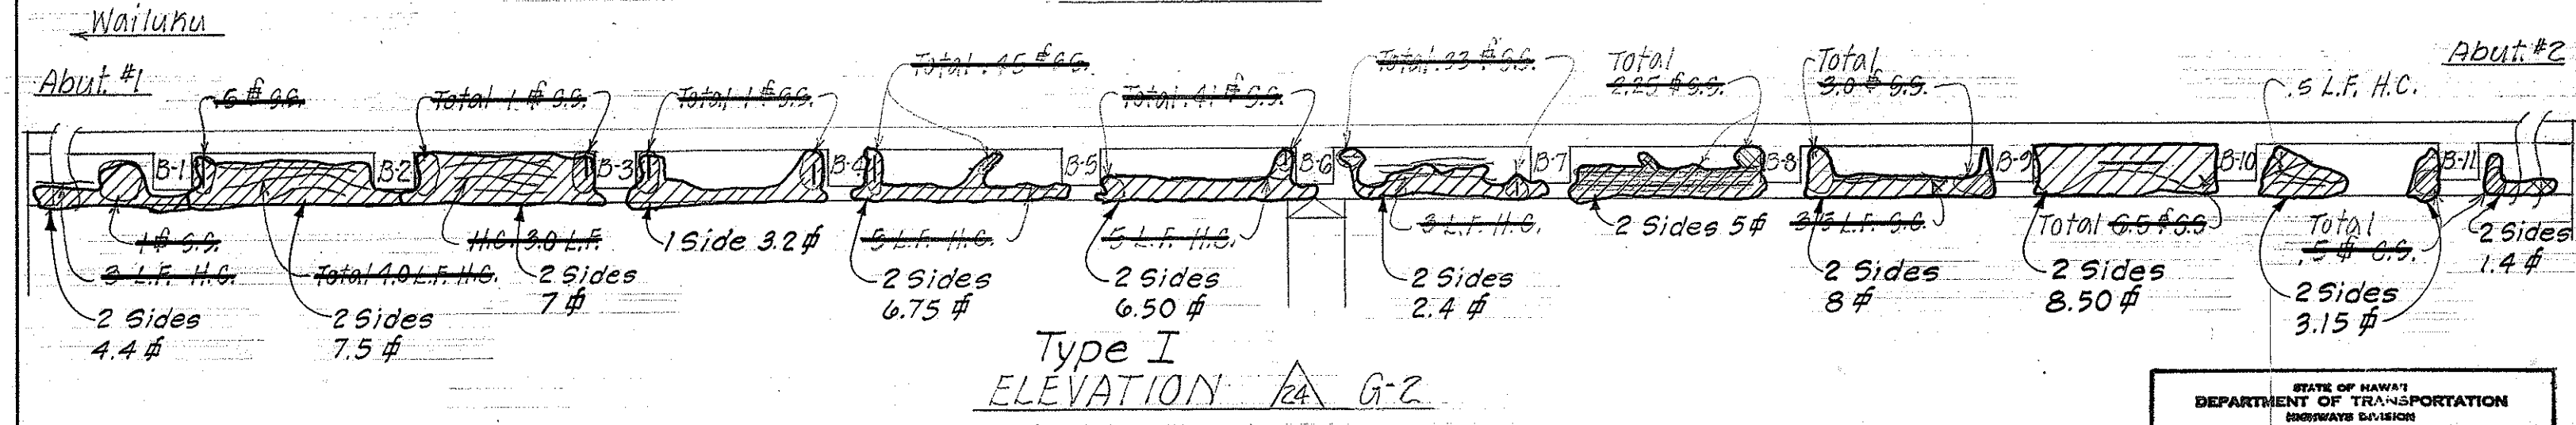

Type I
ELEVATION 24 G-2

STATE OF HAWAII
DEPARTMENT OF TRANSPORTATION
HIGHWAYS DIVISION
REHABILITATION & REPAIRS
TO KOPILIULA BRIDGE
HWY-M-01-74 NOV. 1973
SHEET No. 2 OF 6 SHEETS







DESIGNED BY	DATE
DRAWN BY	3/7/73
CHECKED BY	
APPROVED BY	
NOTES	

360-018



CON. DESIG.	STATE	FISCAL YEAR	SHEET NO.	TOTAL SHEETS
CONCRETE	HAW.	1974	26	50

Hana

Match Line
See Sht. #2

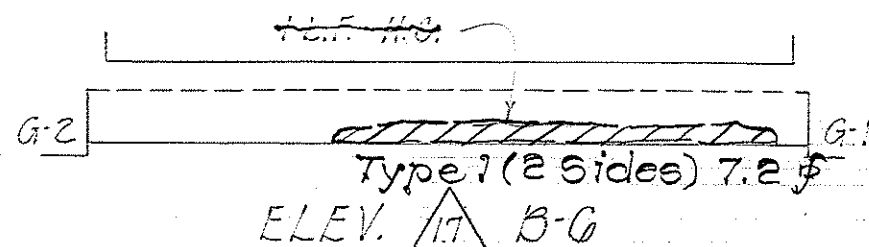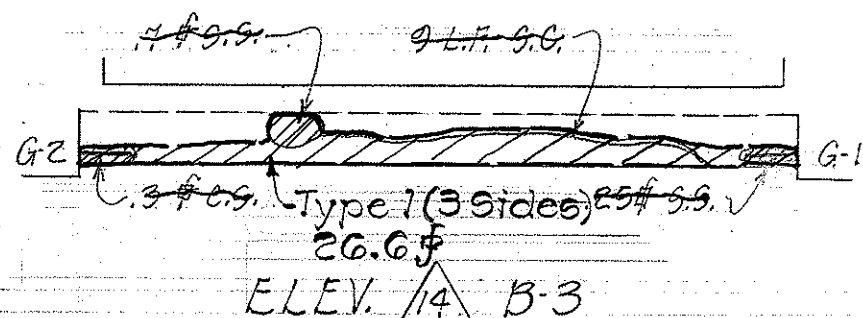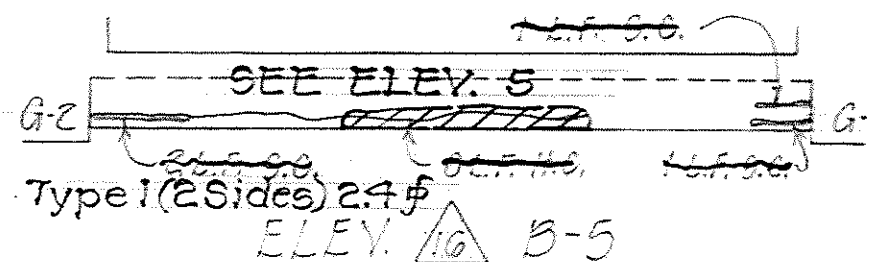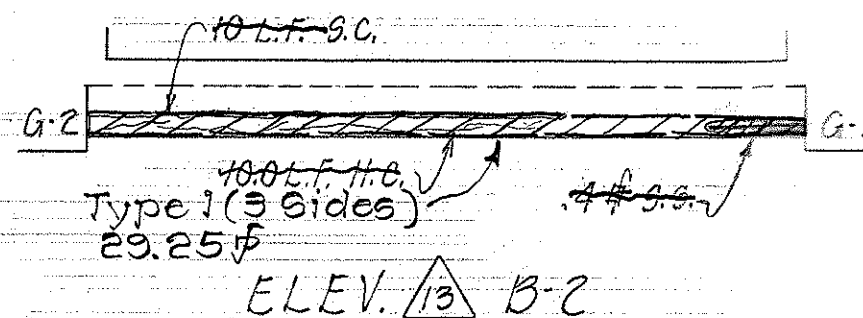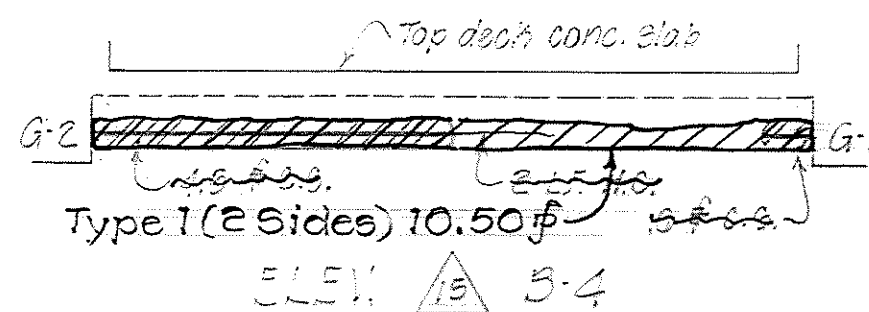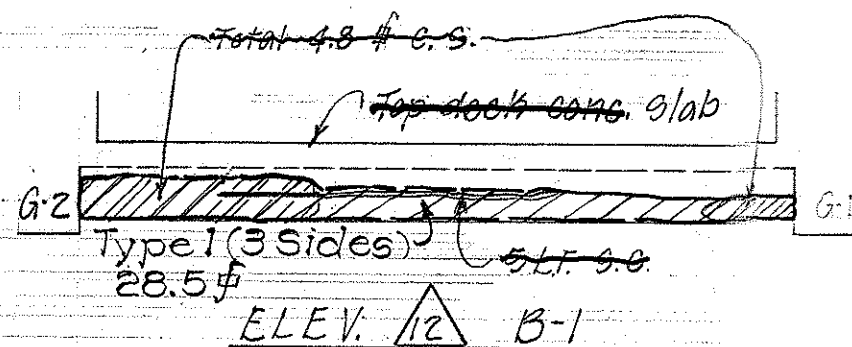

PART. REFLECTED CEILING PLAN
Scale: 1/4" = 1'-0"












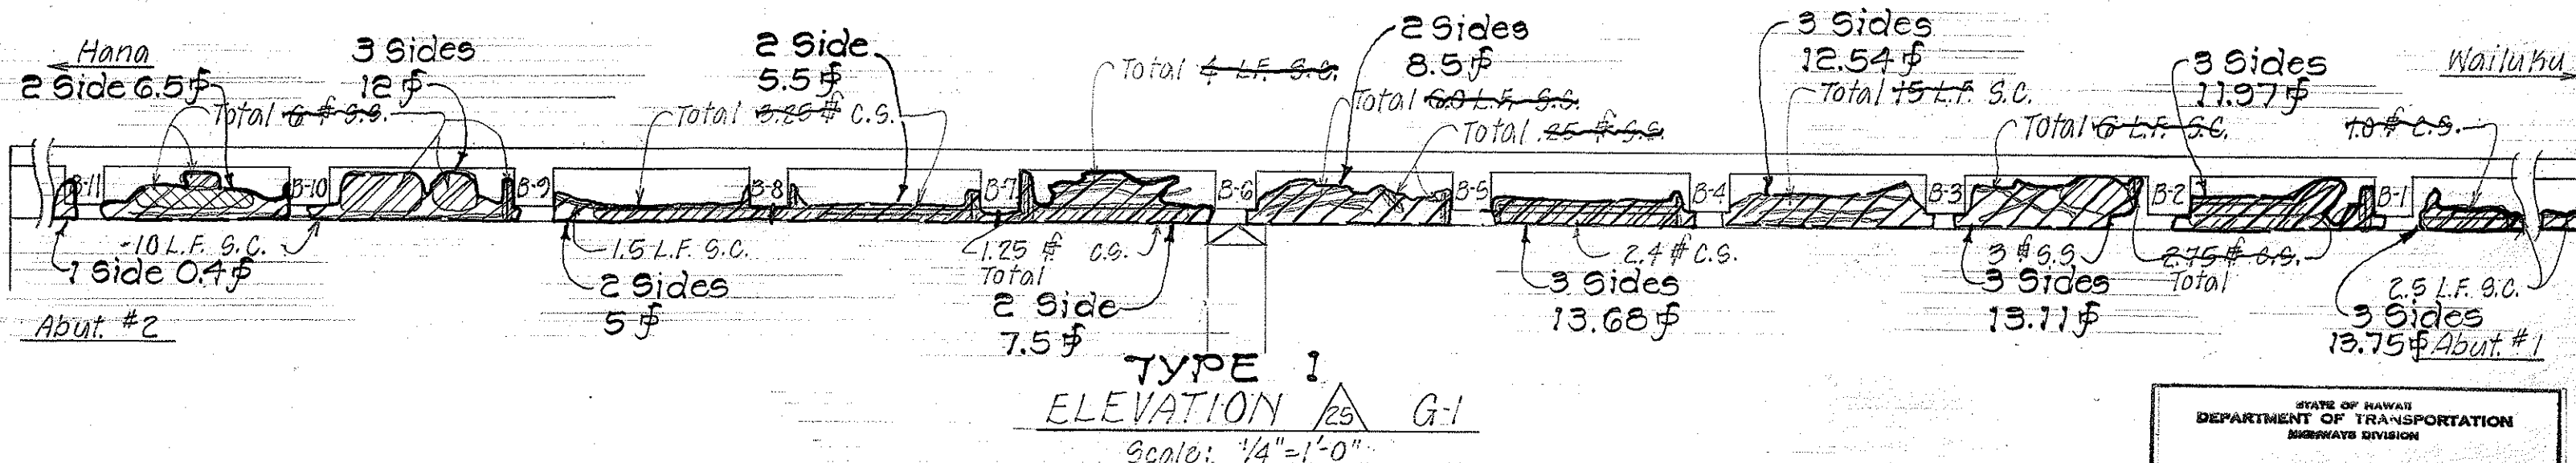
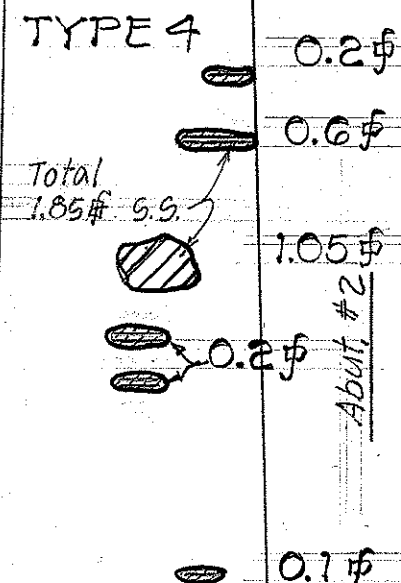


STATE OF HAWAII
DEPARTMENT OF TRANSPORTATION
HIGHWAYS DIVISION
REHABILITATION & REPAIRS
TO KOPIILULA BRIDGE
HWY-M-01-74 NOV. 1973
SHEET No. 3 OF 6 SHEETS

360-018

26


FED. ROAD DIST. NO.	STATE	FED. AID PROJ. NO.	FISCAL YEAR	SHEET NO.	TOTAL SHEETS
HAWAII	HAW.	HWY M-01-74	1974	21	50

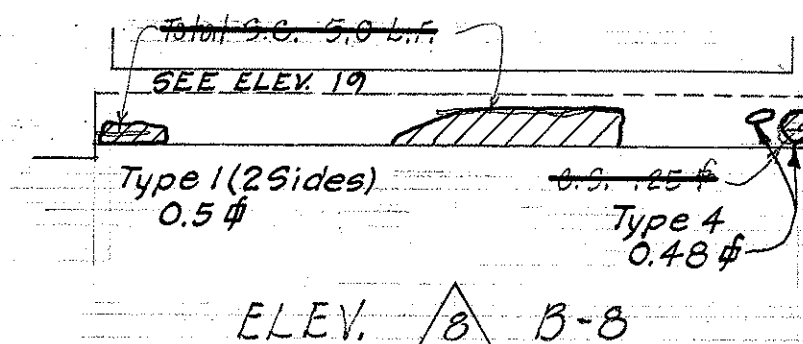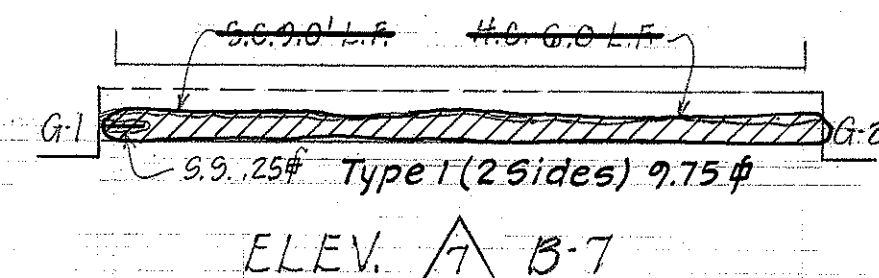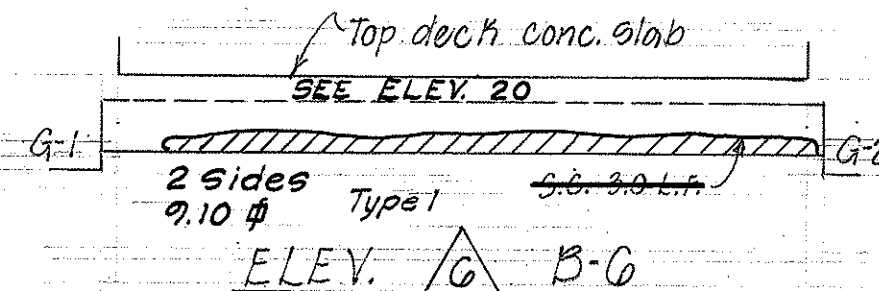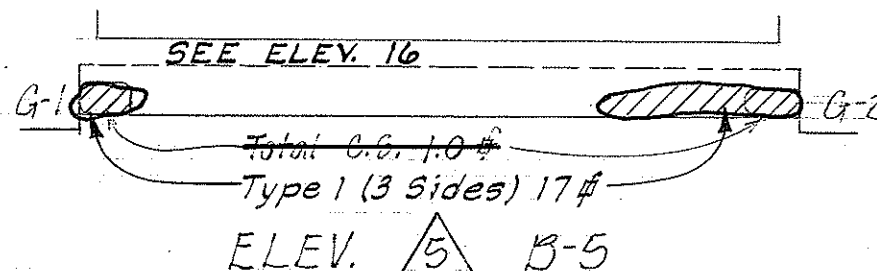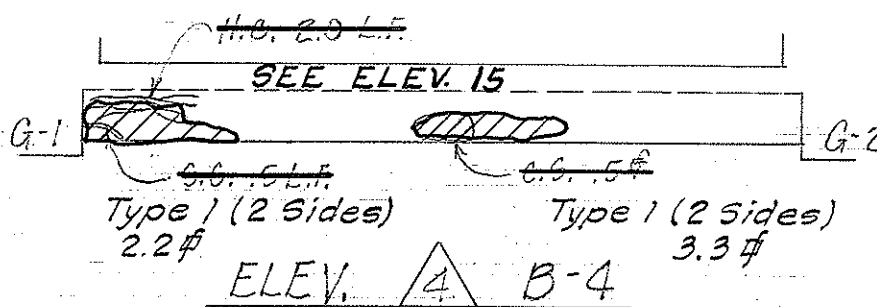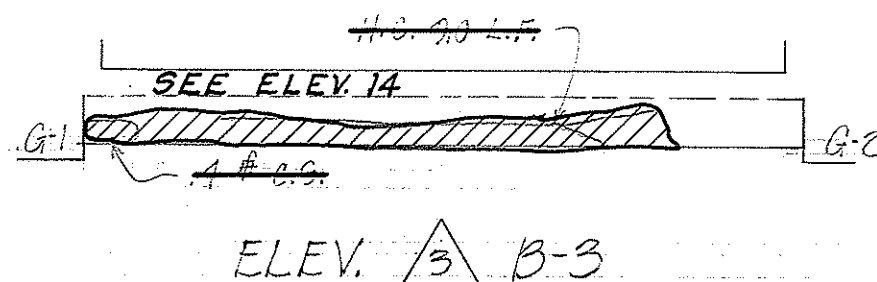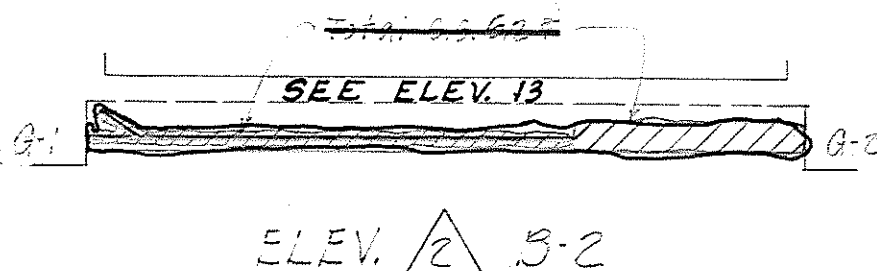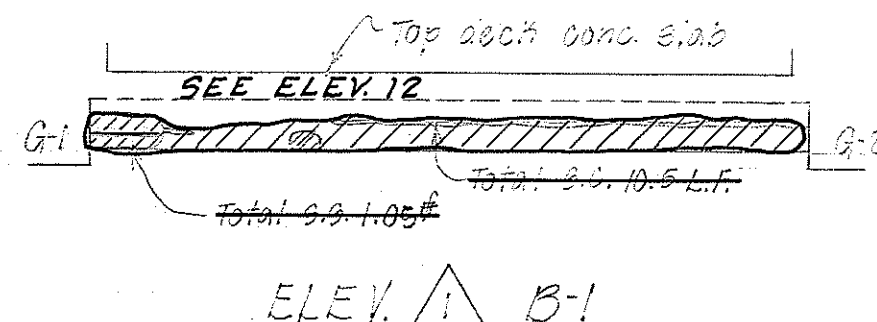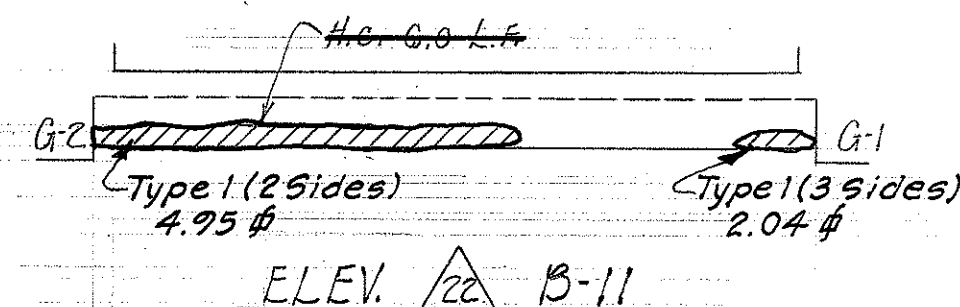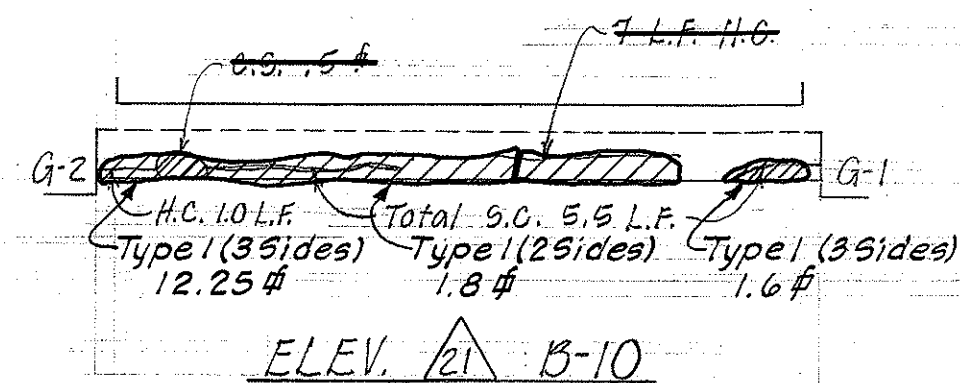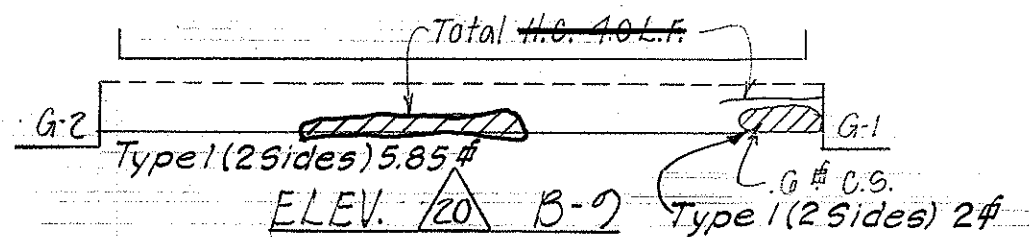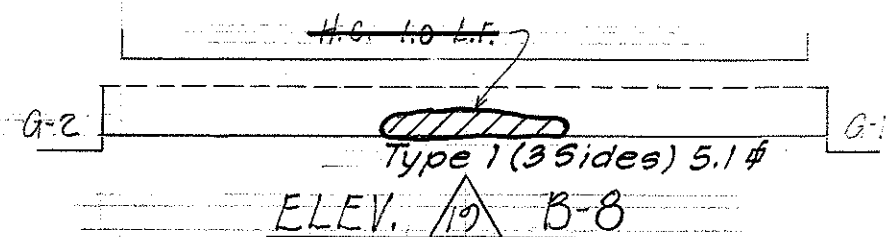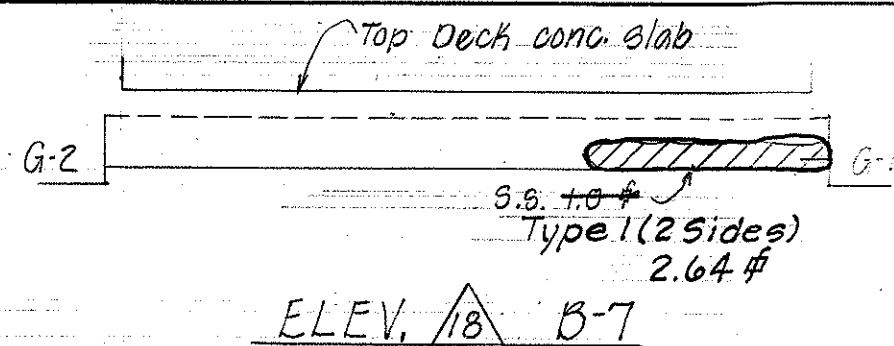


STATE OF HAWAII DEPARTMENT OF TRANSPORTATION BRIDGE DIVISION	
REHABILITATION & REPAIRS TO KOPIILULA BRIDGE	
HWY-M-01-74	NOV. 1973
SHEET No. 4 OF 6 SHEETS	

DESIGNED BY	DATE
DRAWN BY	5/73
CHECKED BY	
APPROVED BY	
ORIGINAL PLAN	
REVISION	
QUANTITY BY	
CHECKED BY	


FED. ROAD DIST. NO.	STATE	FED. AID PROJ. NO.	FISCAL YEAR	SHEET NO.	TOTAL SHEETS
HAWAII	HAW.	HWY-M-01-74	1974	28	50

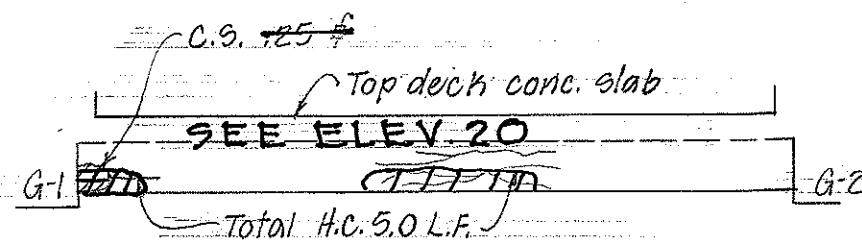


ELEV. Δ B-9

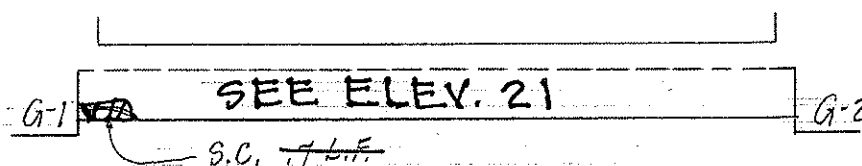


ELEV. Δ B-10

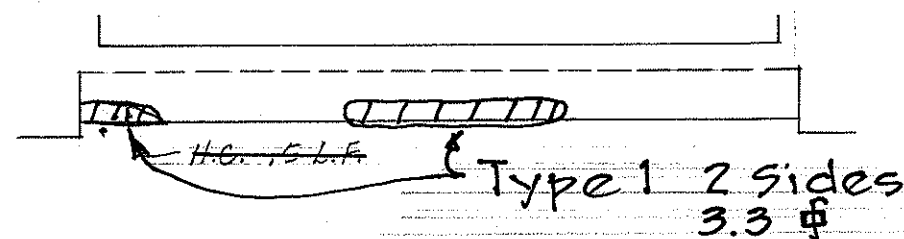


ELEV. Δ B-11

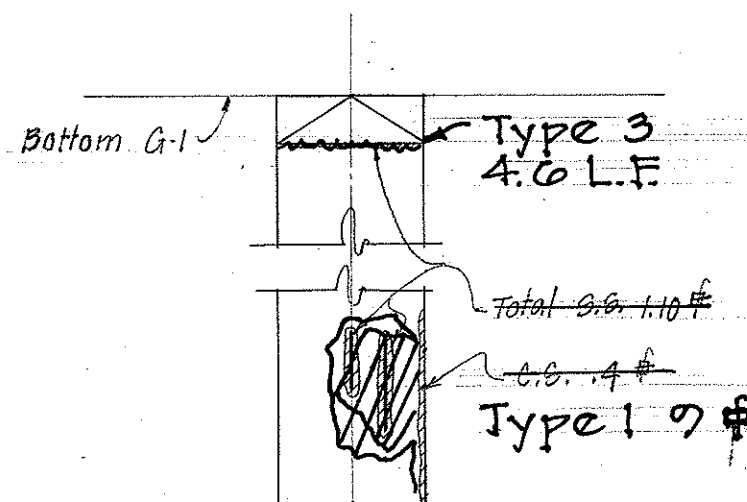


PIER No 1
ELEVATION Δ 26
27

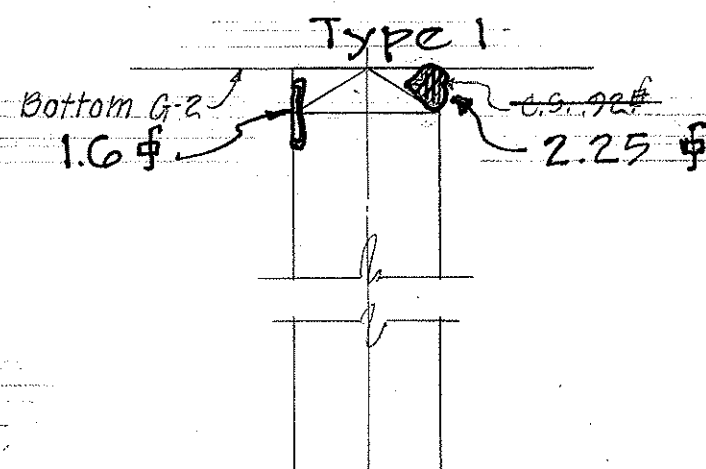


PIER No 2
ELEVATION Δ 29

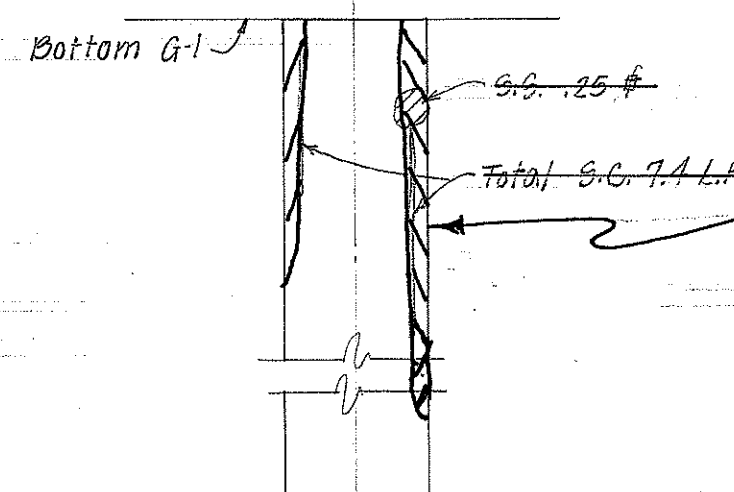


PIER No 1
ELEVATION Δ 24
20

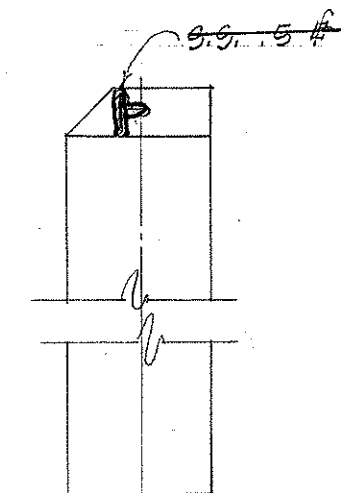

PIER No 2
ELEVATION Δ 30

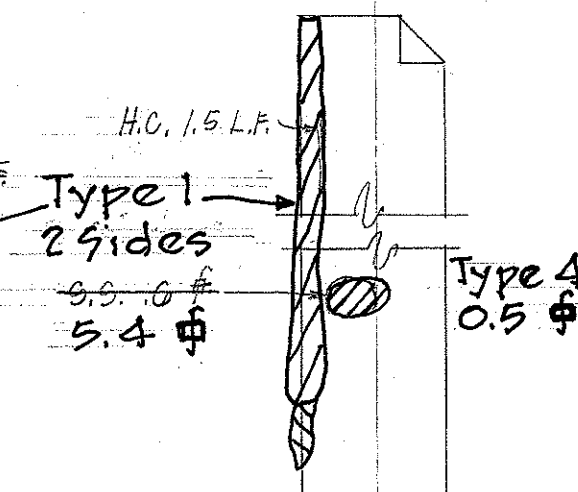

PIER No 1
ELEVATION Δ 28
31

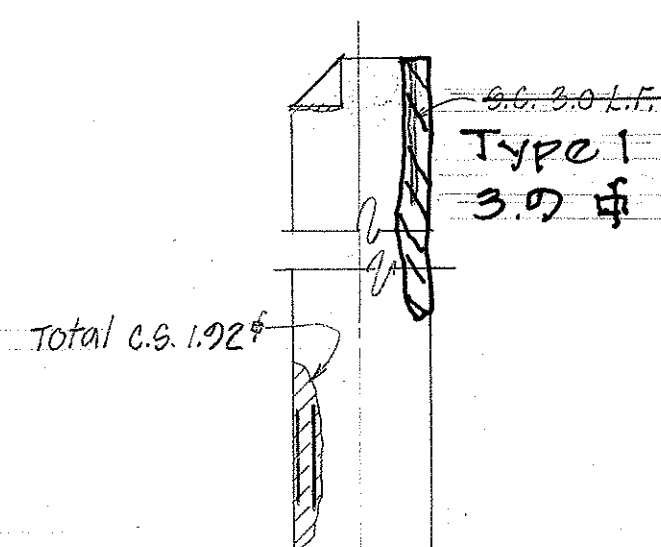

PIER No 1
ELEVATION Δ 31
28


STATE OF HAWAII
DEPARTMENT OF TRANSPORTATION
HIGHWAYS DIVISION
REHABILITATION & REPAIRS
TO KOPIILULA BRIDGE
HWY-M-01-74 NOV. 1973
SHEET No. 5 OF 6 SHEETS

760-018


28

DESIGNED BY	DATE
DRAWN BY	3/73
CHECKED BY	
APPROVED BY	
SCALE	
NOTES	

CD. ROAD DIST. NO.	STATE	PROJ. NO.	FISCAL YEAR	SHEET NO.	TOTAL SHEETS
HAWAII	HAW.	HWY M-01-74	1974	29	50

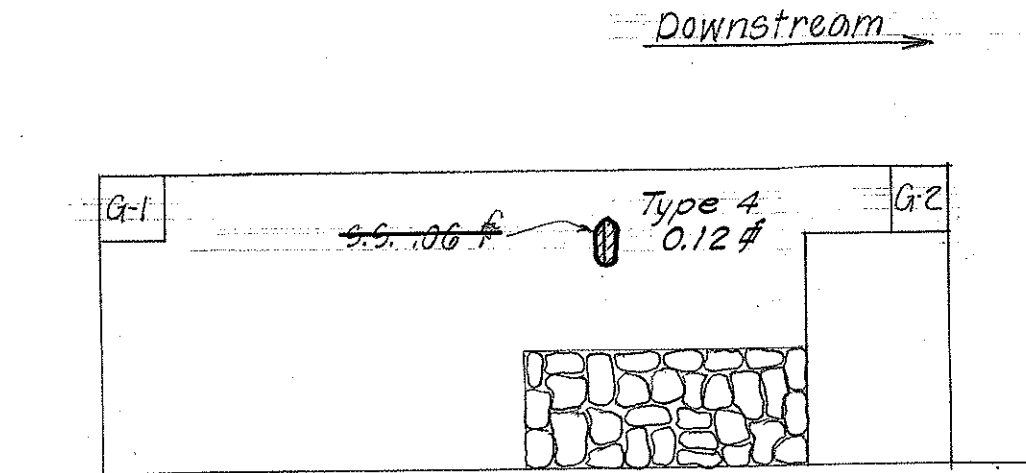

WAILUKU
ABUT. N^o 1 (~~HANA~~ FACE)

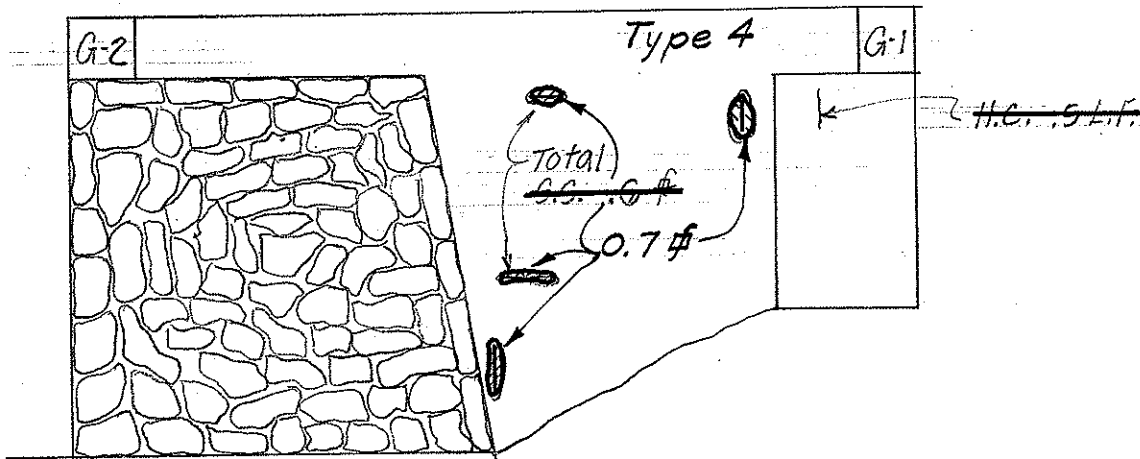

HANA
ABUT. N^o 2 (~~WAILUKU~~ FACE)

DESIGNED BY	3/73
CHECKED BY	3/73
APPROVED BY	3/73
DATE	3/73
BY	3/73
FOR	3/73
OF	3/73
AT	3/73
BY	3/73
FOR	3/73
OF	3/73
AT	3/73

STATE OF HAWAII
DEPARTMENT OF TRANSPORTATION
HIGHWAY DIVISION

REHABILITATION & REPAIRS
TO KOPIILUA BRIDGE

HWY-M-01-74 NOV. 1973

SHEET No. 6 OF 6 SHEETS