




FED. ROAD DIST. NO.	STATE	FED-AID PROJ. NO.	FISCAL YEAR	SHEET NO.	TOTAL SHEETS
HAWAII	HAW.	HWY M-01-74	1974	15	50

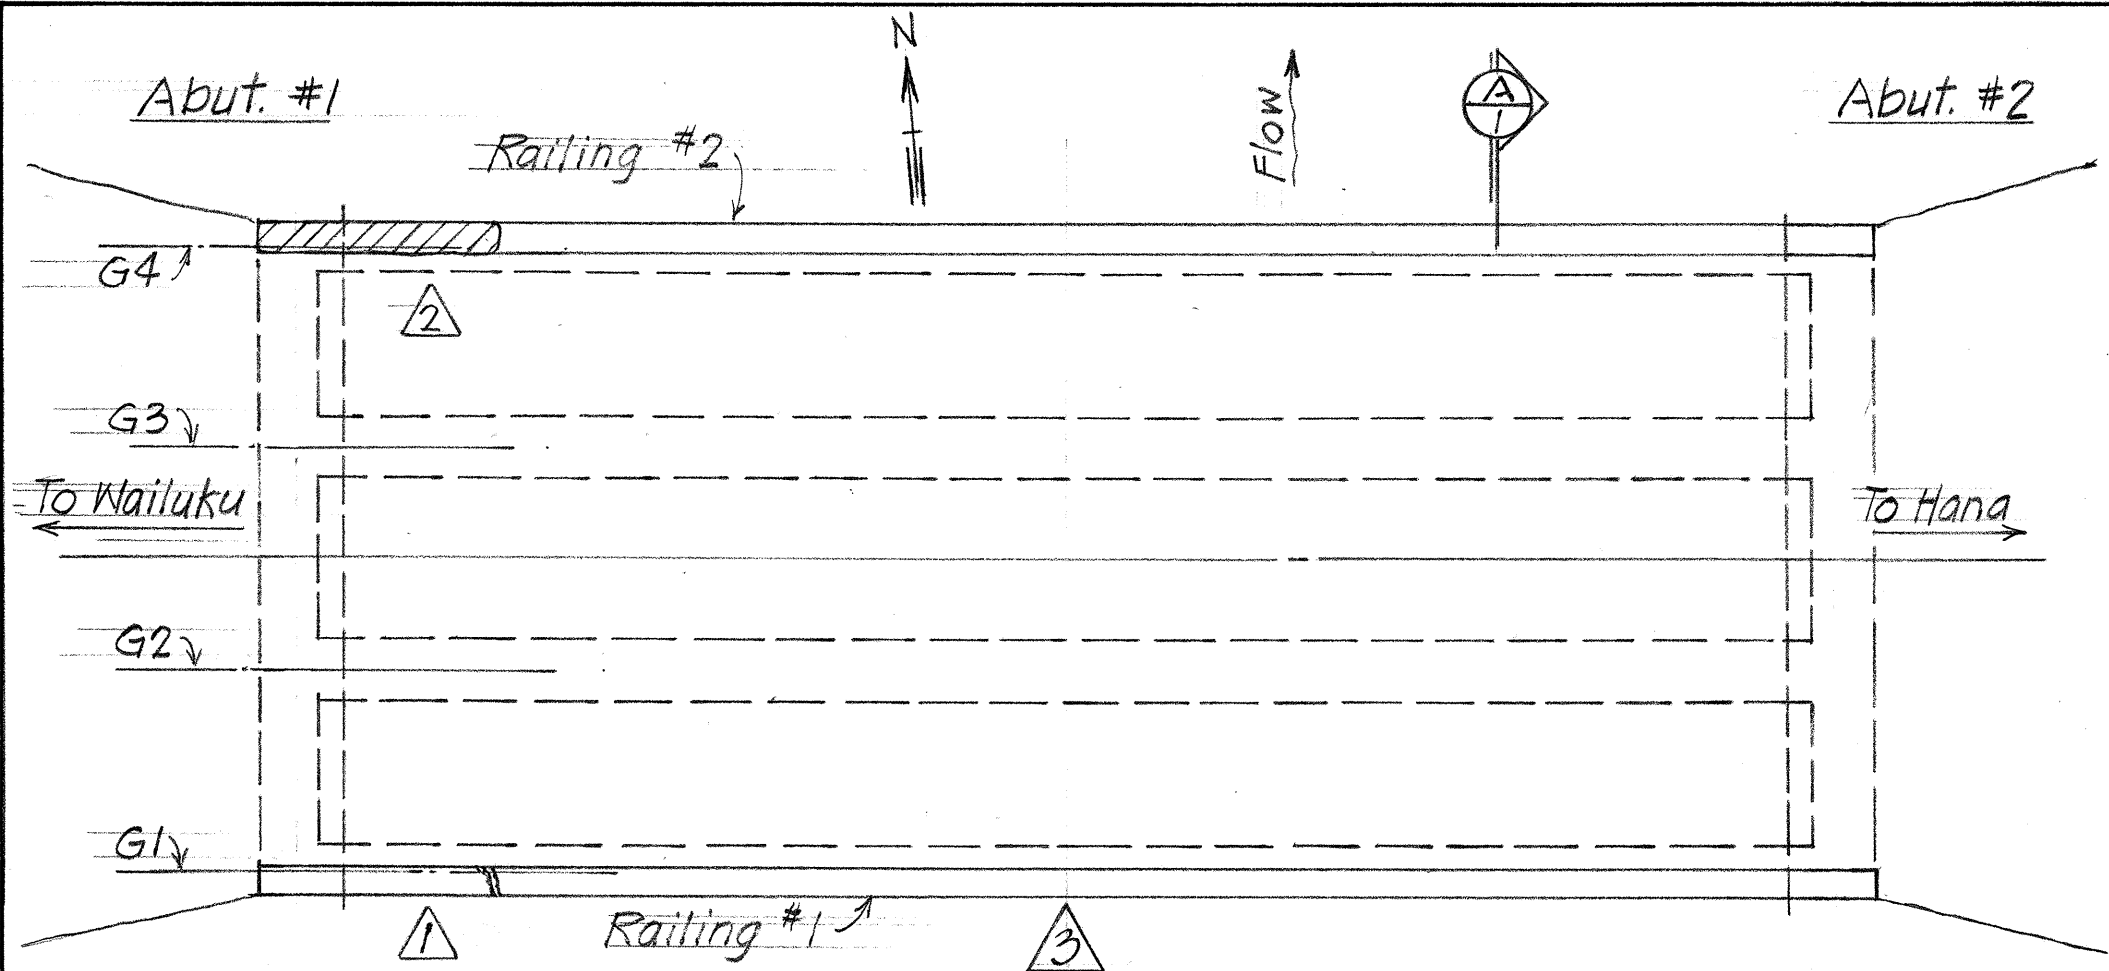


LAYOUT AND FRAMING PLAN Scale: 1/4"=1'-0"

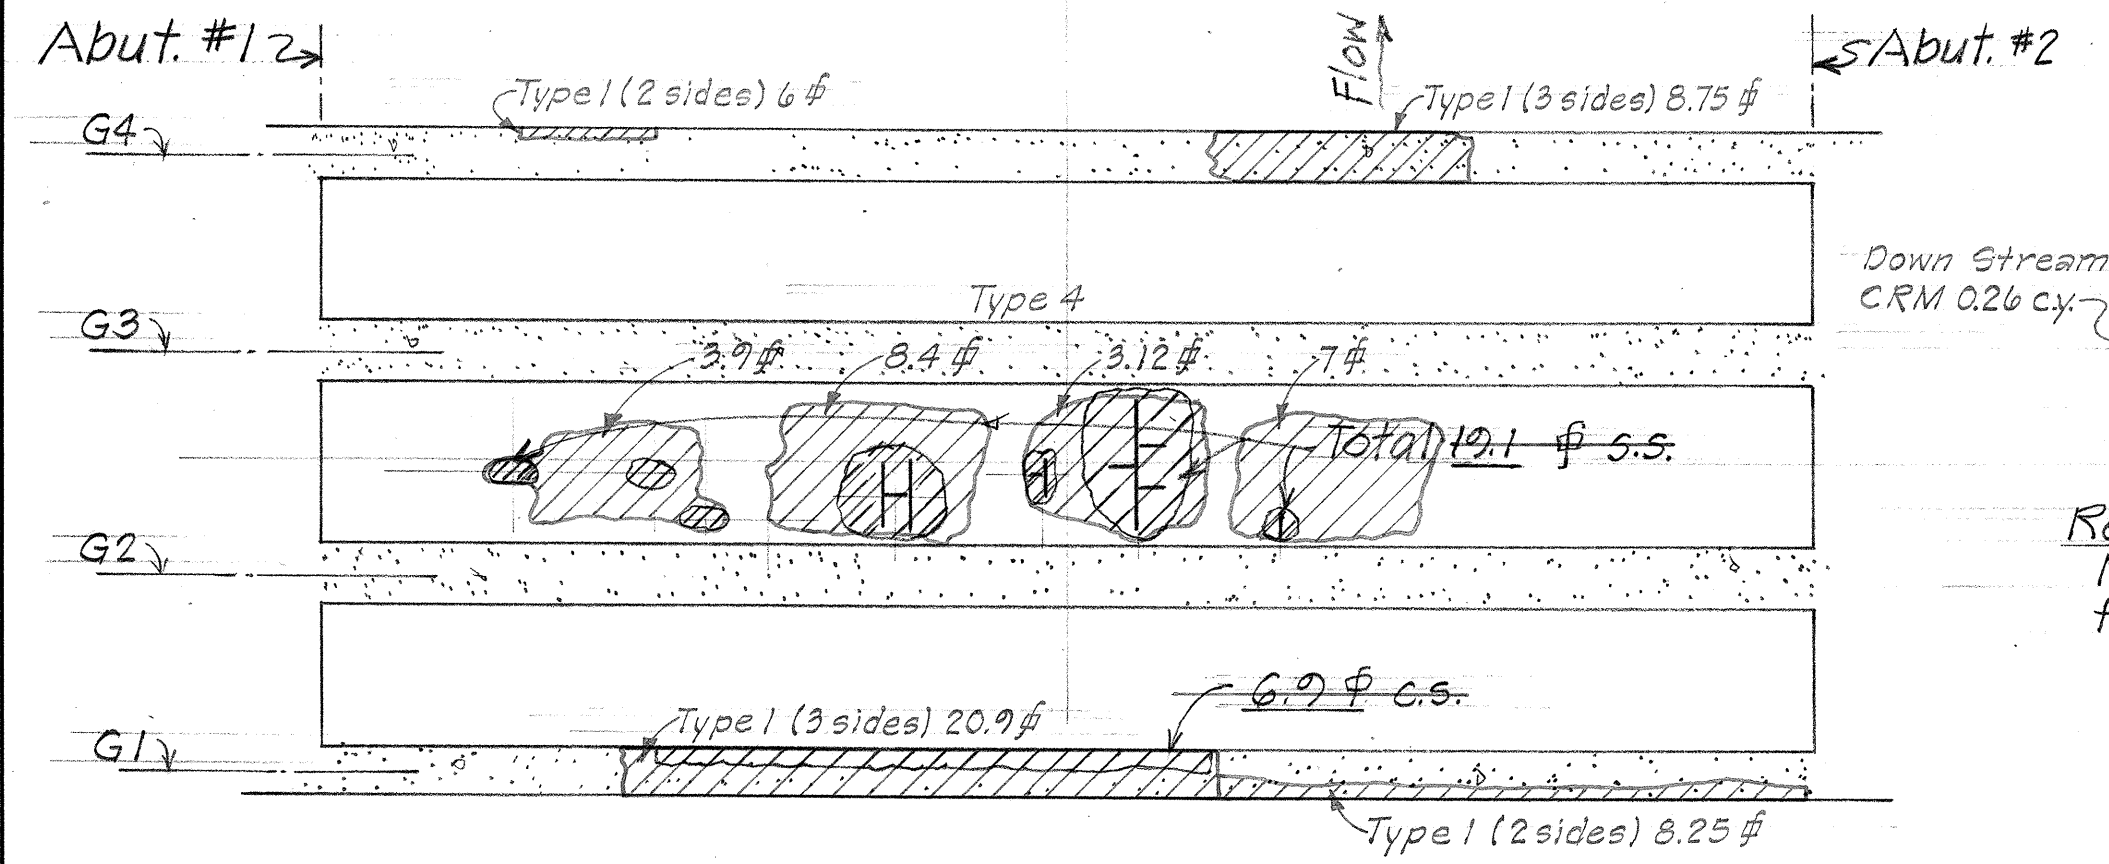

REFLECTED CEILING PLAN Scale: 1/4"=1'-0"

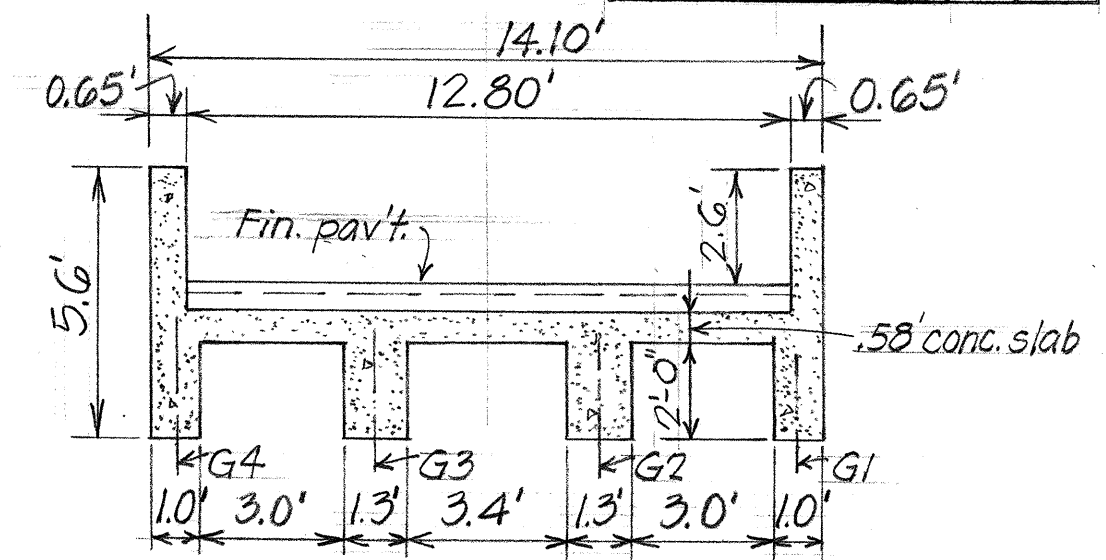

NORMAL DECK SECTION (A) Scale: 1/4"=1'-0"

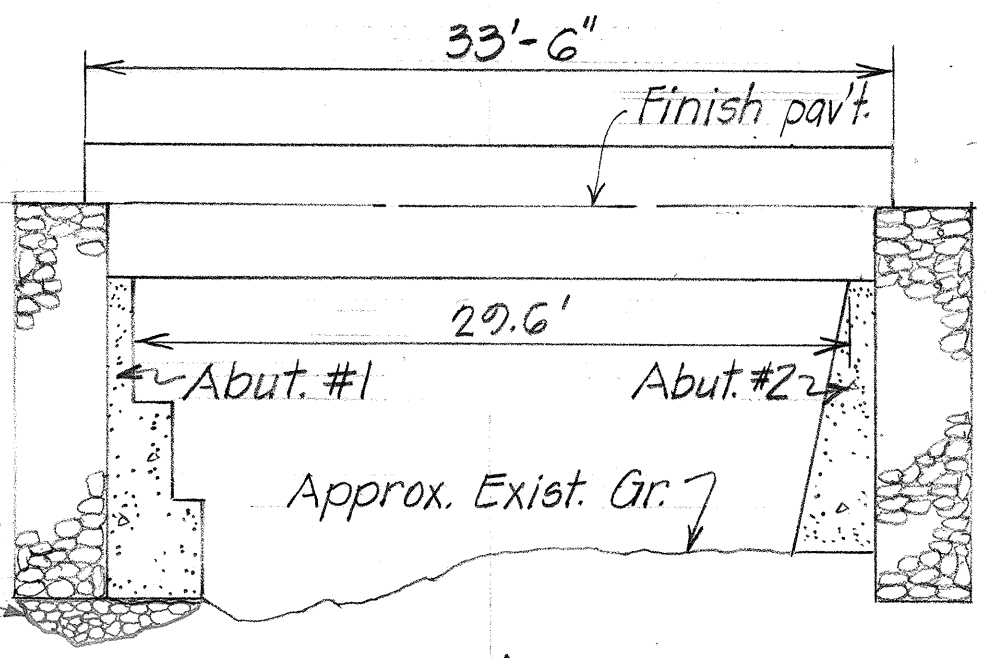

ELEVATION (3) Scale: 1/8"=1'-0"

Reference Note:
Refer to Sheets T-1 thru T-4 incl.
for Typical Details.

STATE OF HAWAII

DEPARTMENT OF TRANSPORTATION

HIGHWAYS DIVISION

REHABILITATION & REPAIRS


TO PUNALAU BRIDGE

PROJ. NO. HWY. M-01-74


Nov. 1973

SHEET No. 1 OF 2 SHEETS

FED. ROAD DIST. NO.	STATE	FED. AID PROJ. NO.	FISCAL YEAR	SHEET NO.	TOTAL SHEETS
HAWAII	HAW.	HWY M-01-74	1974	16	50

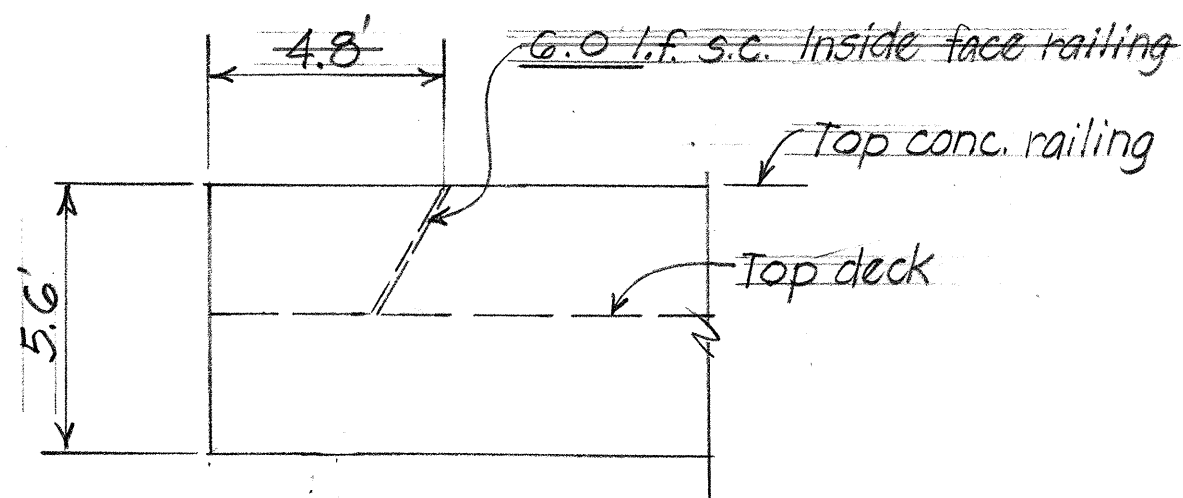

ELEVATION ① - RAILING #1
Scale: 1/4" = 1'-0"

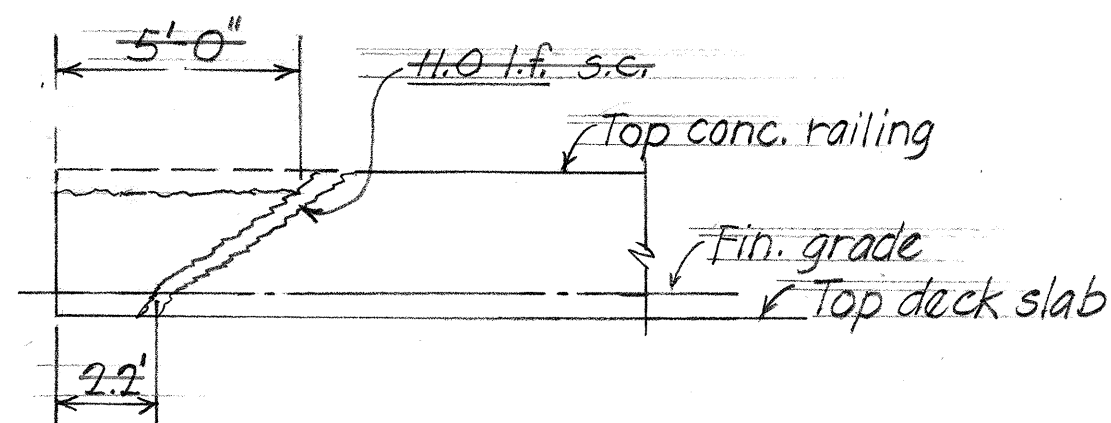

ELEVATION ② - RAILING #2
Scale: 1/4" = 1'-0"

STATE OF HAWAII DEPARTMENT OF TRANSPORTATION HIGHWAYS DIVISION	
REHABILITATION & REPAIRS TO PUNALAU BRIDGE	
PROJ. NO. HWY. M-01-74 Nov. 1973	
SHEET No. 2 OF 2 SHEETS	