




FED. ROAD DIST. NO.	STATE	FED-AID PROJ. NO.	FISCAL YEAR	SHEET NO.	TOTAL SHEETS
HAWAII	HAW.	HWY M-01-74	1974	13	50

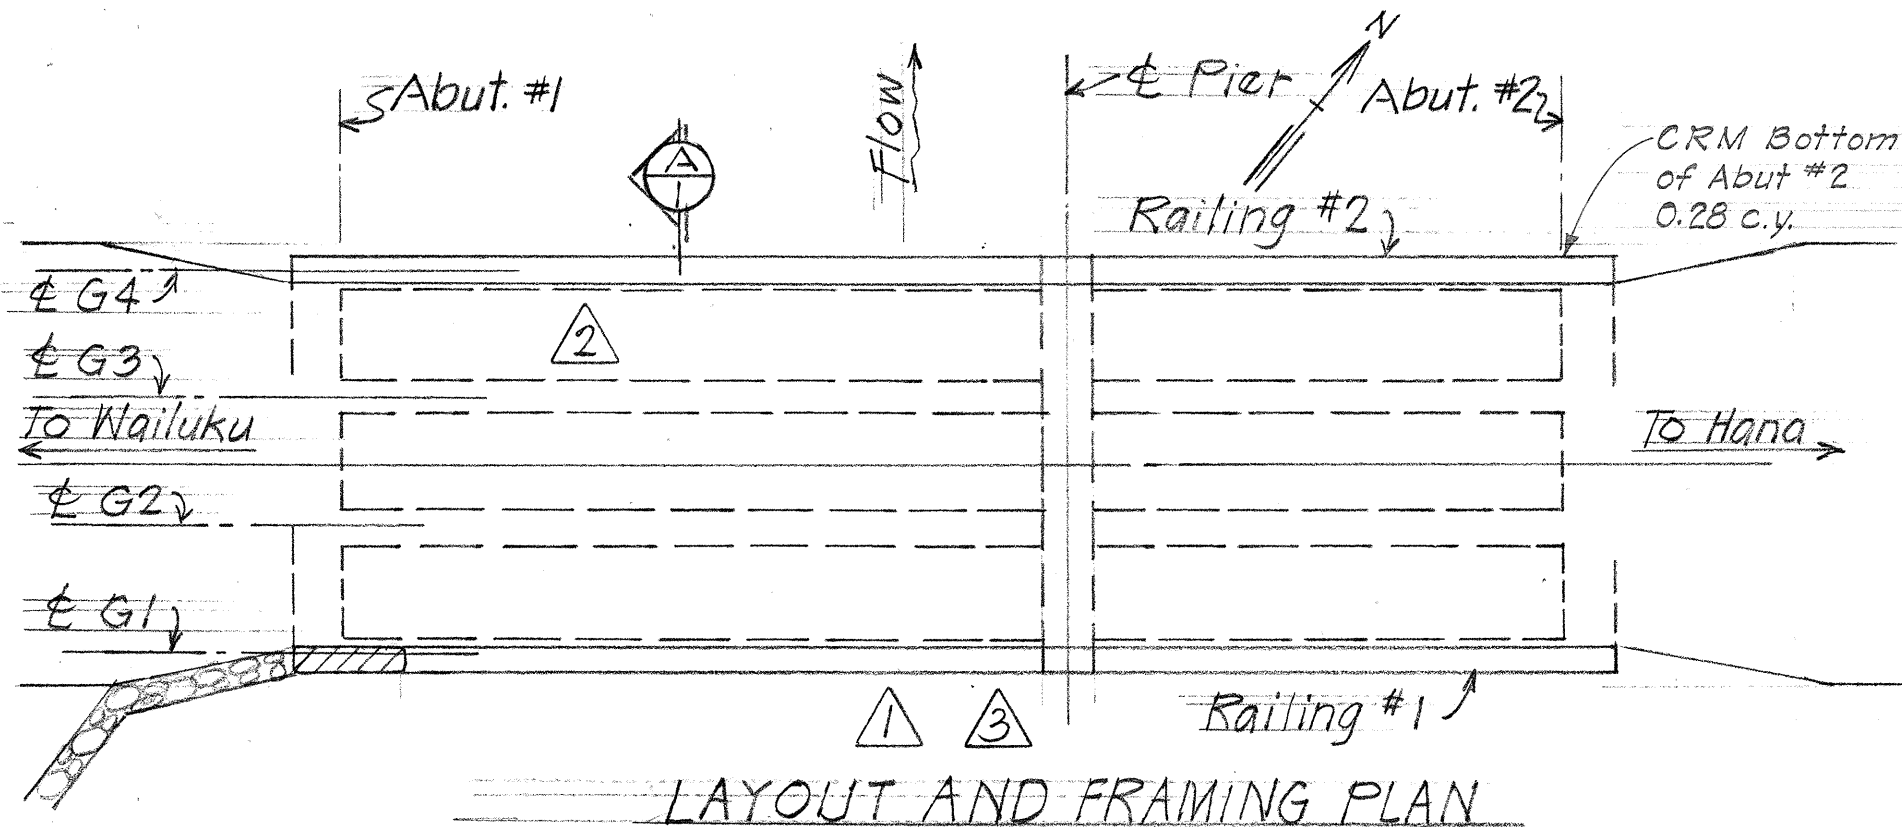


LAYOUT AND FRAMING PLAN
Scale: 1/8" = 1'-0"

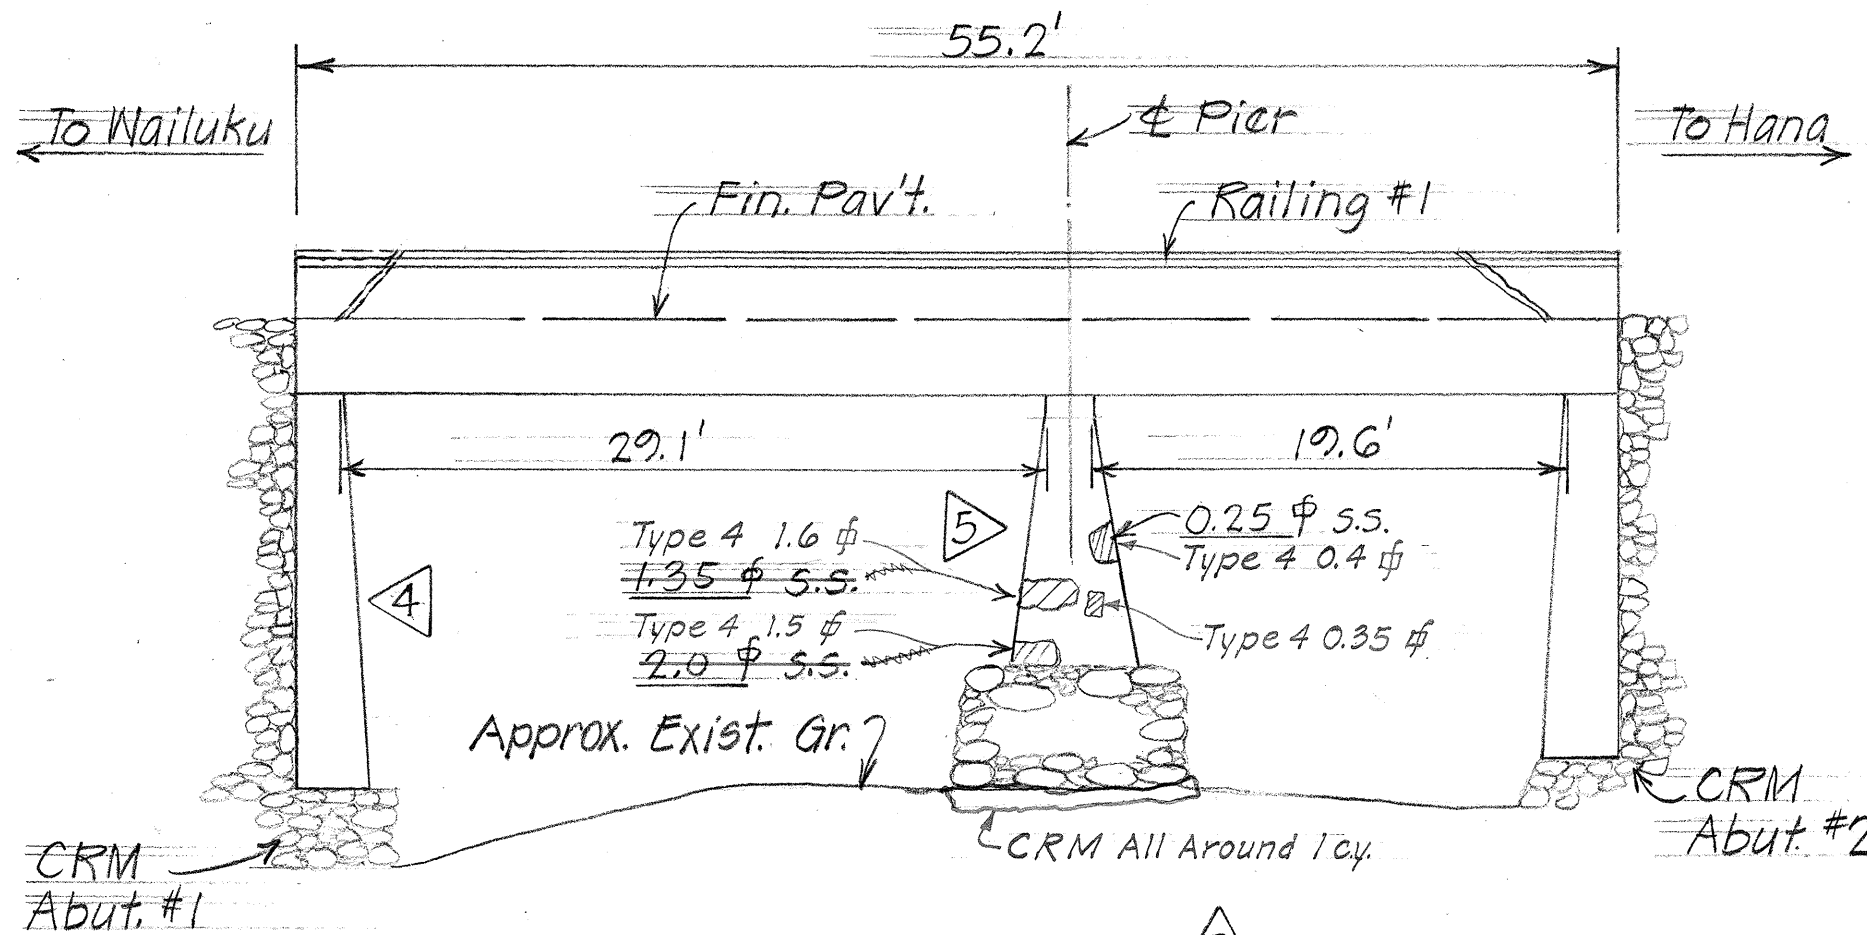

ELEVATION 3
Scale: 1/8" = 1'-0"

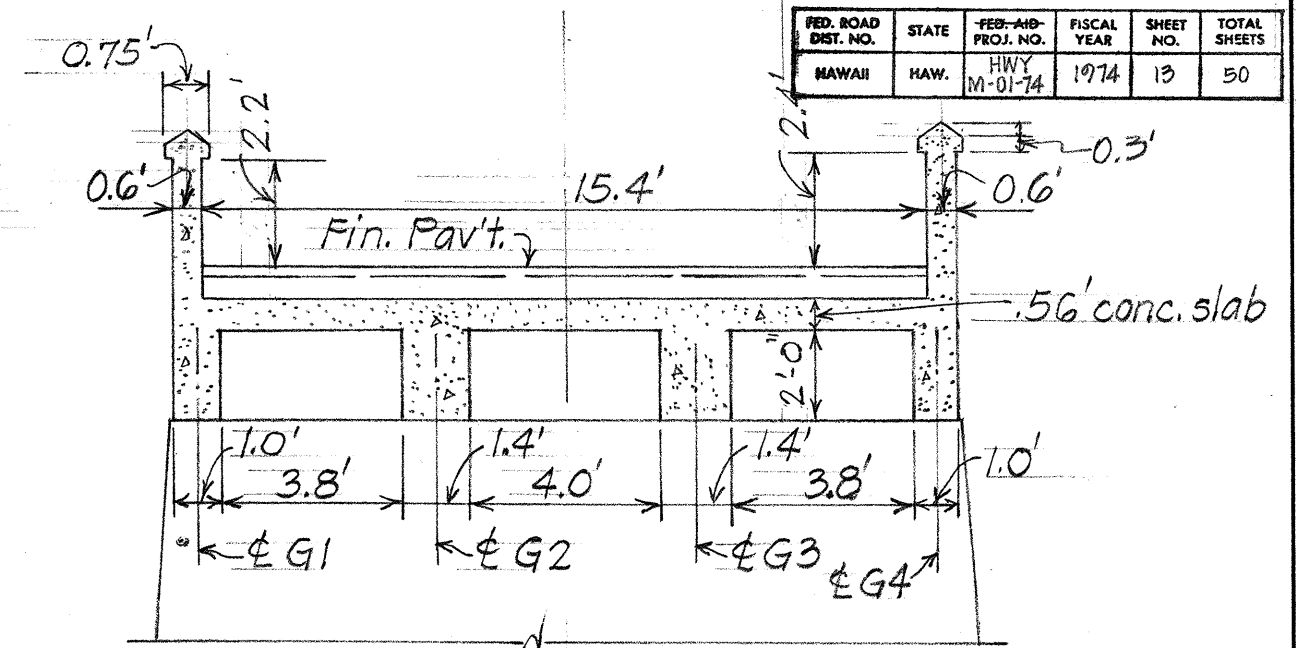

NORMAL DECK SECTION A-A
Scale: 1/4" = 1'-0"



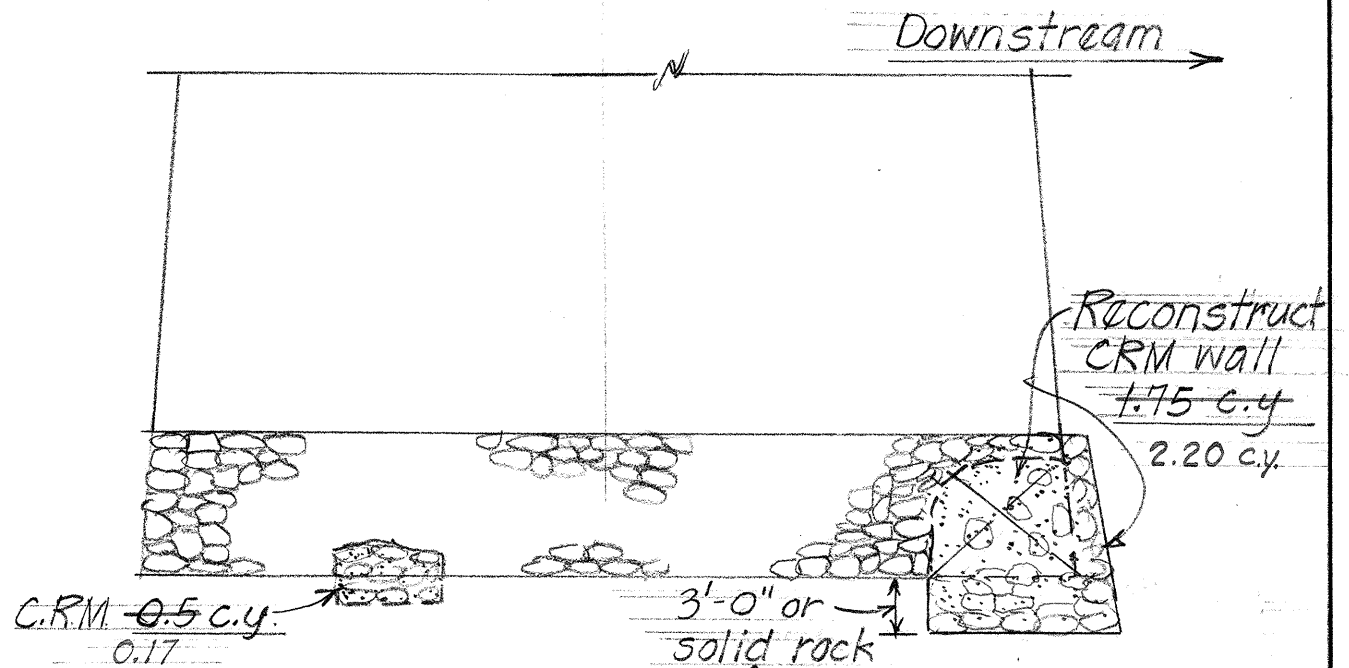


ELEVATION 4
ABUTMENT #1 FOUNDATION
Scale: 1/4" = 1'-0"

Reference Note: Refer to sheets T1 thru T4 incl. for Typical Details.

STATE OF HAWAII DEPARTMENT OF TRANSPORTATION HIGHWAYS DIVISION
REHABILITATION & REPAIRS TO PUOHOKAMOA BRIDGE
PROJ. NO. HWY. M-01-74 Nov. 1973
SHEET No. 1 OF 2 SHEETS

FED. ROAD DIST. NO.	STATE	FED. AID PROJ. NO.	FISCAL YEAR	SHEET NO.	TOTAL SHEETS
HAWAII	HAW.	HWY M-01-74	1974	14	50

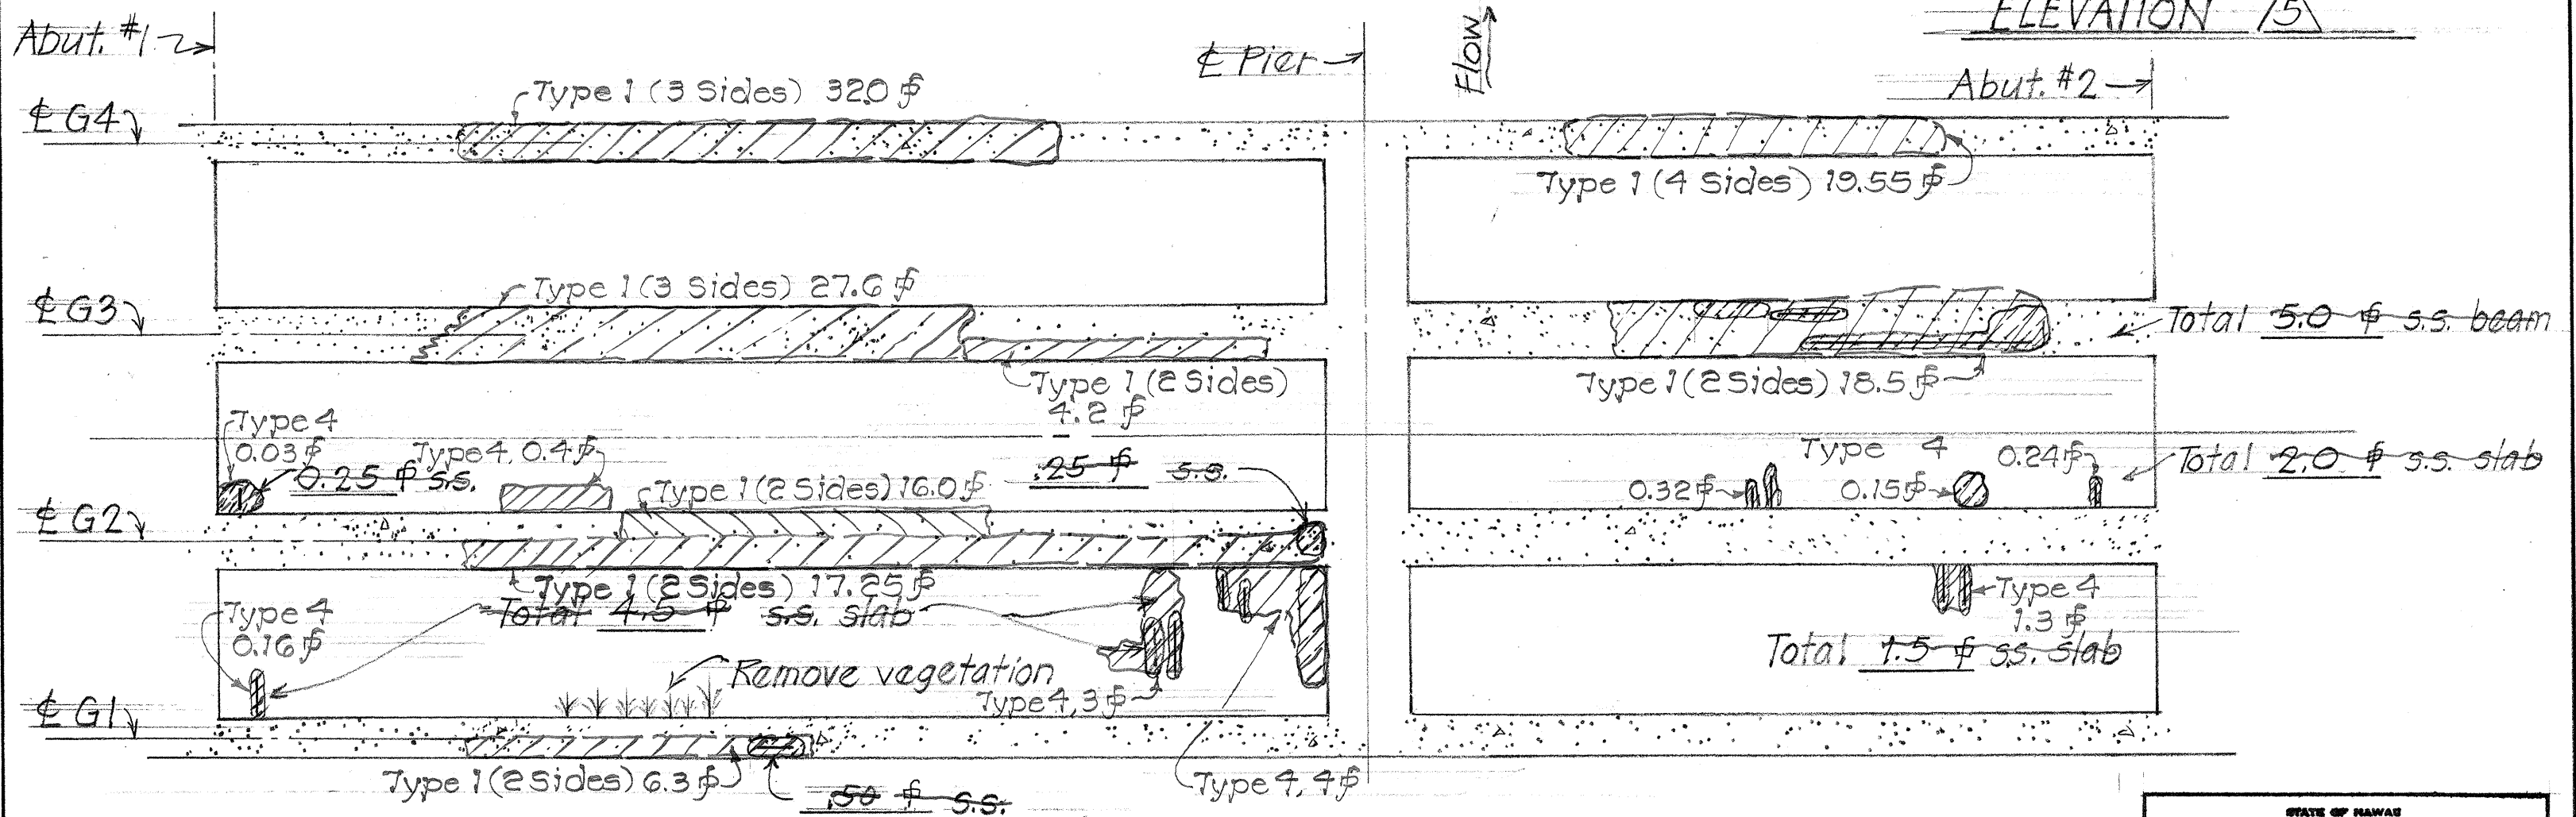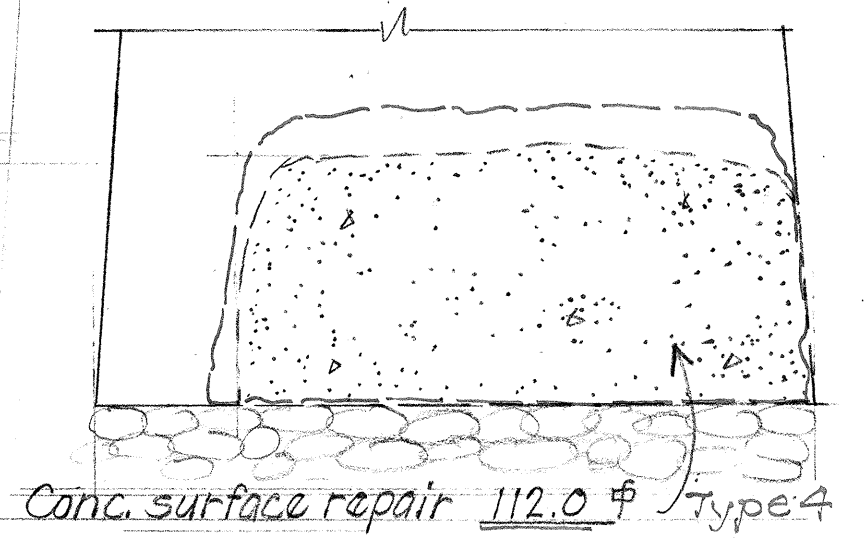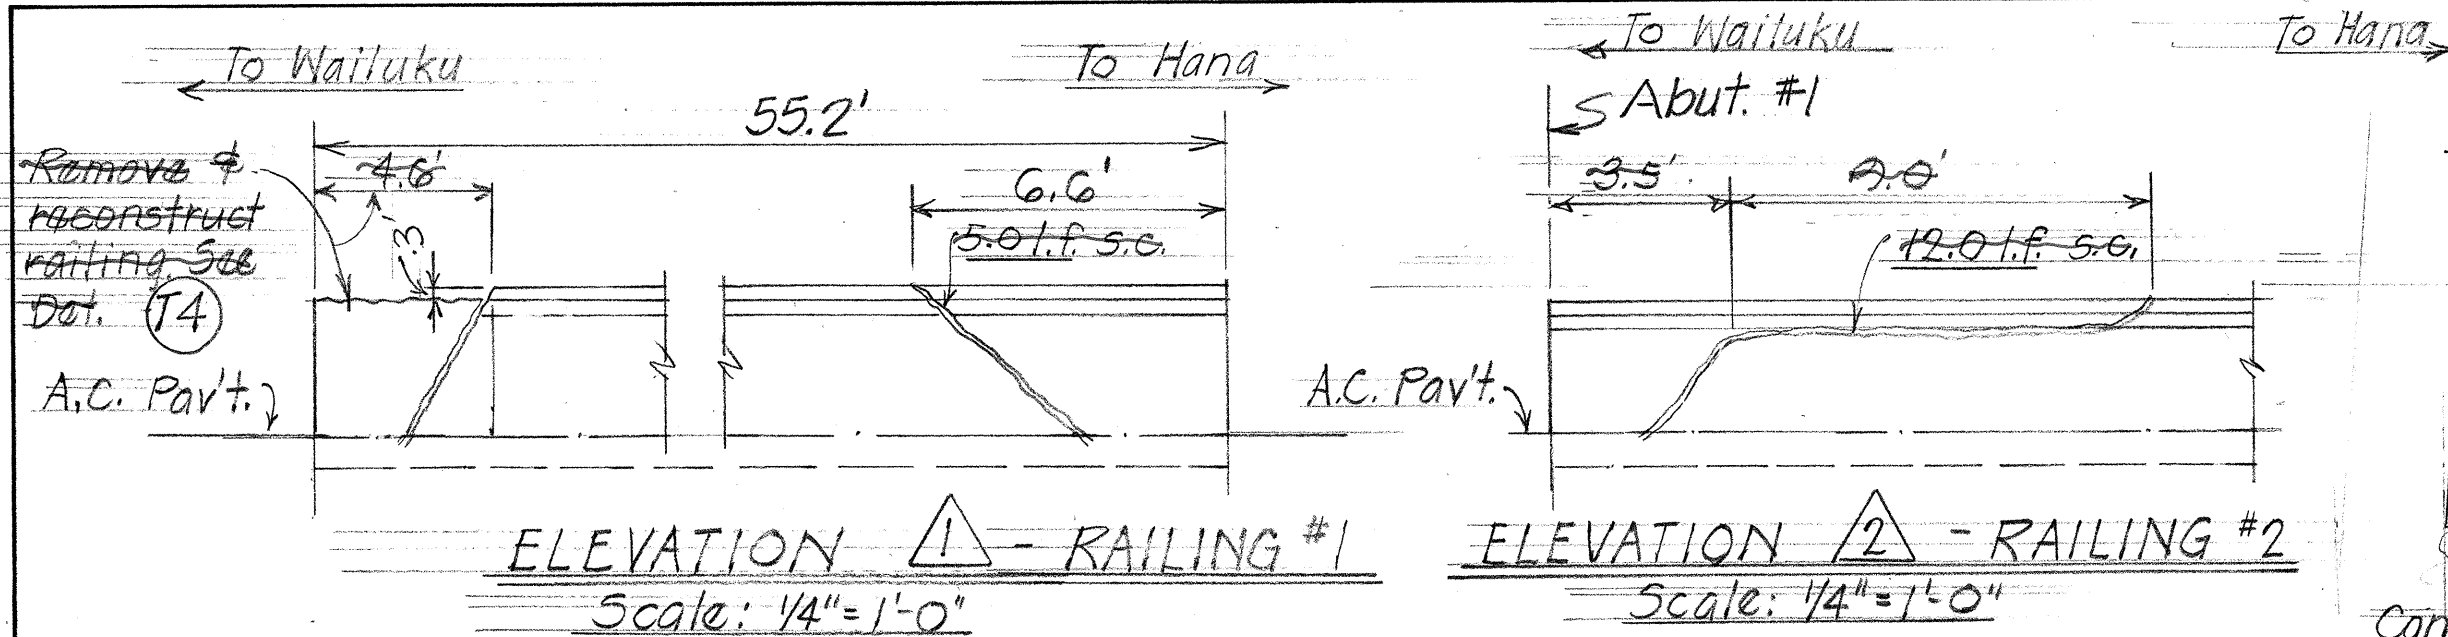

STATE OF HAWAII
DEPARTMENT OF TRANSPORTATION
HIGHWAYS DIVISION

REHABILITATION & REPAIRS
TO PUOHOKAMOA BRIDGE

PROJ. No. HWY. M-01-74 Nov. 1973

SHEET No. 2 OF 2 SHEETS