




FED. ROAD DIST. NO.	STATE	FED-AID PROJ. NO.	FISCAL YEAR	SHEET NO.	TOTAL SHEETS
HAWAII	HAW.	HWY M-01-74	1974	39	50

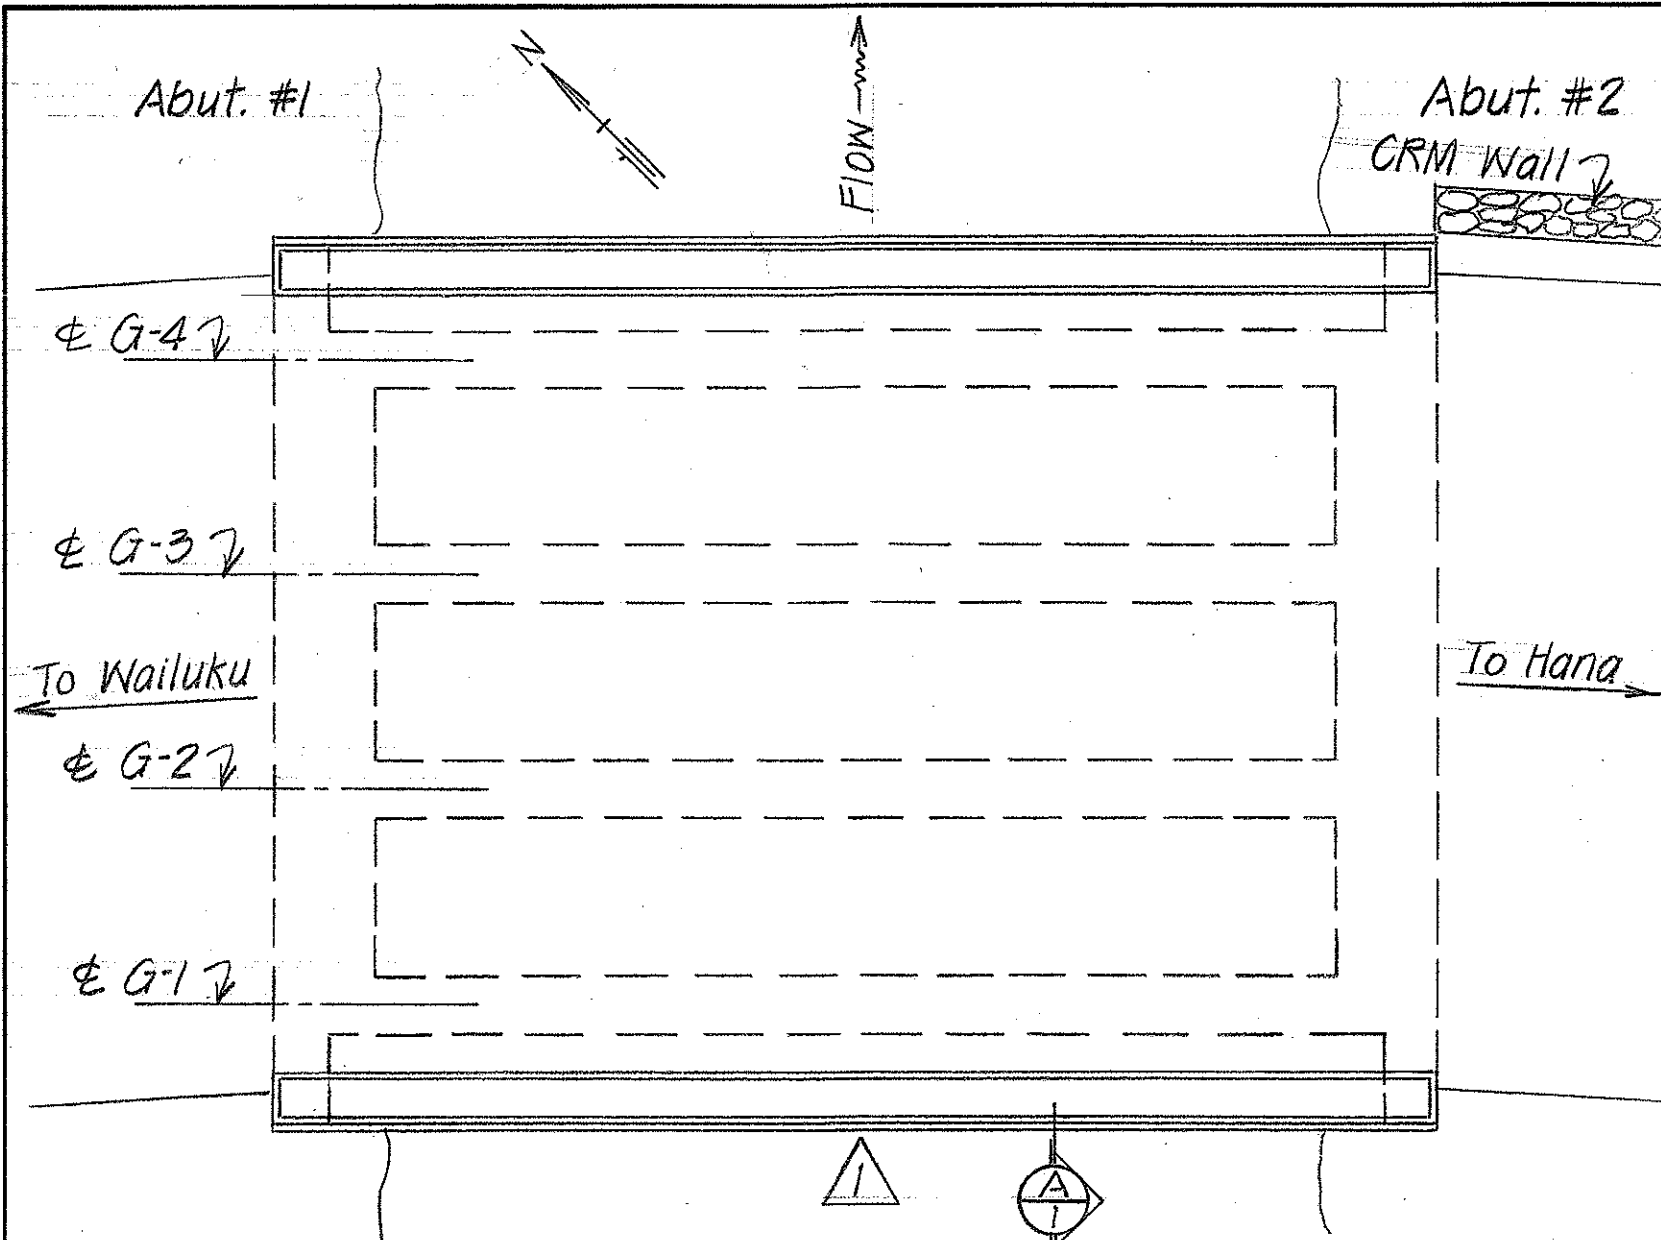


LAYOUT AND FRAMING PLAN Scale: 1/4"=1'-0"

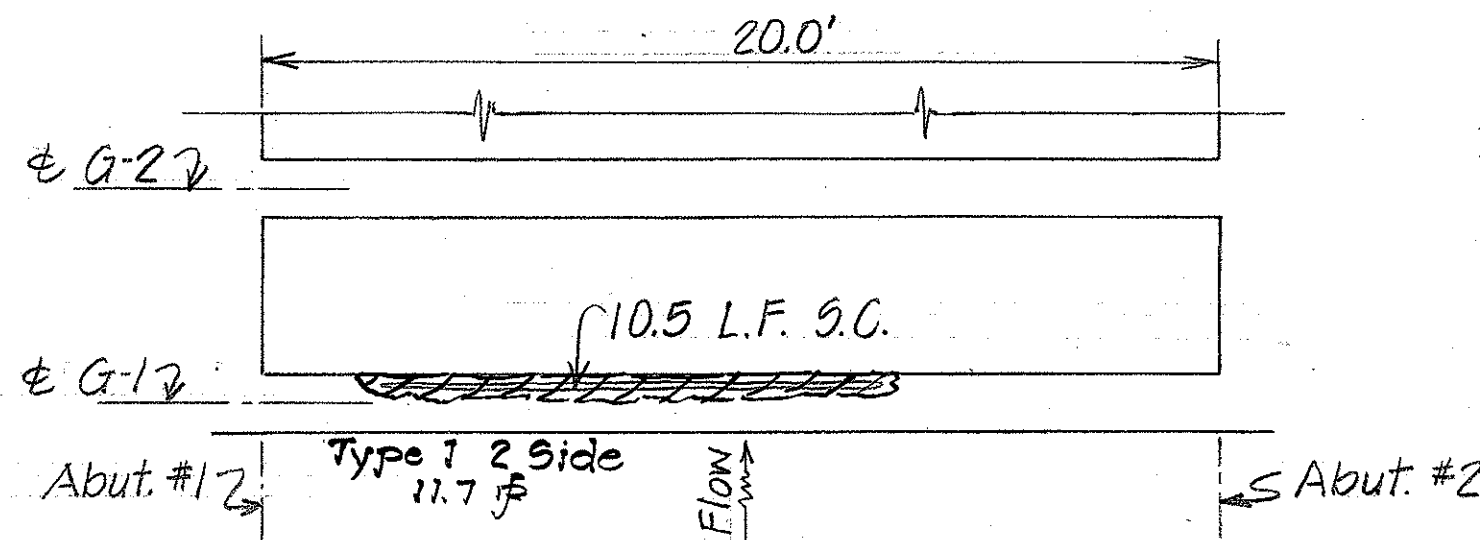

PART REFLECTED CEILING PLAN Scale: 1/4"=1'-0"

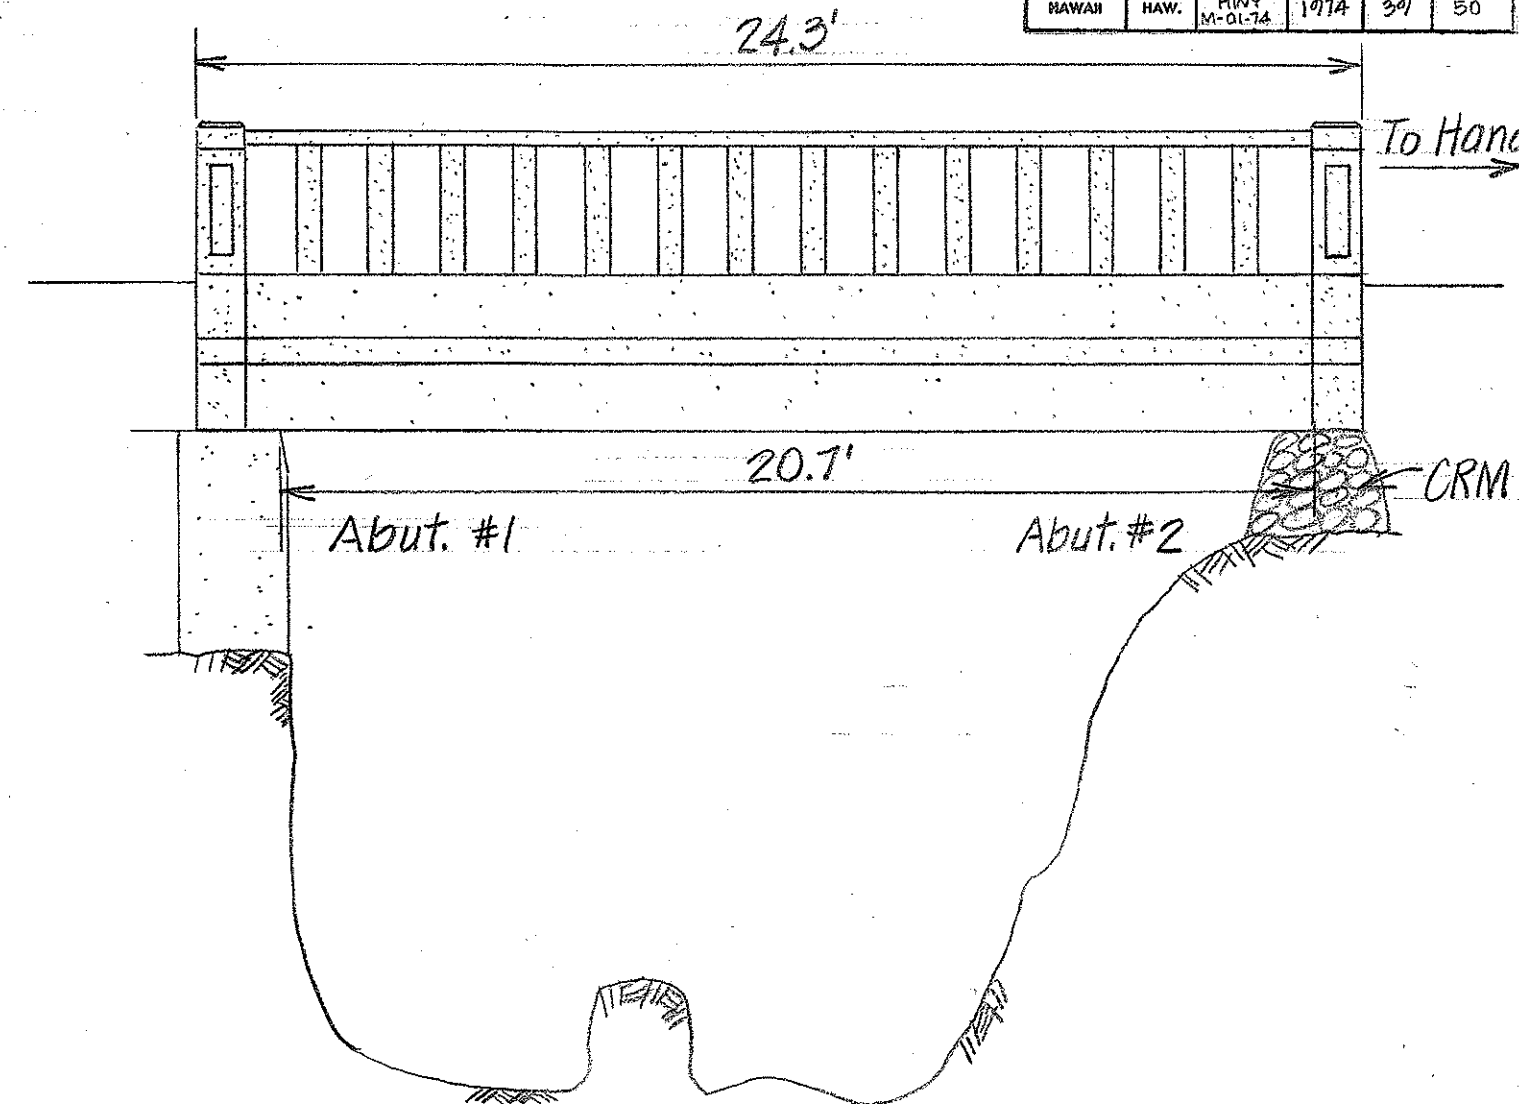

ELEVATION Scale: 1/4"=1'-0"

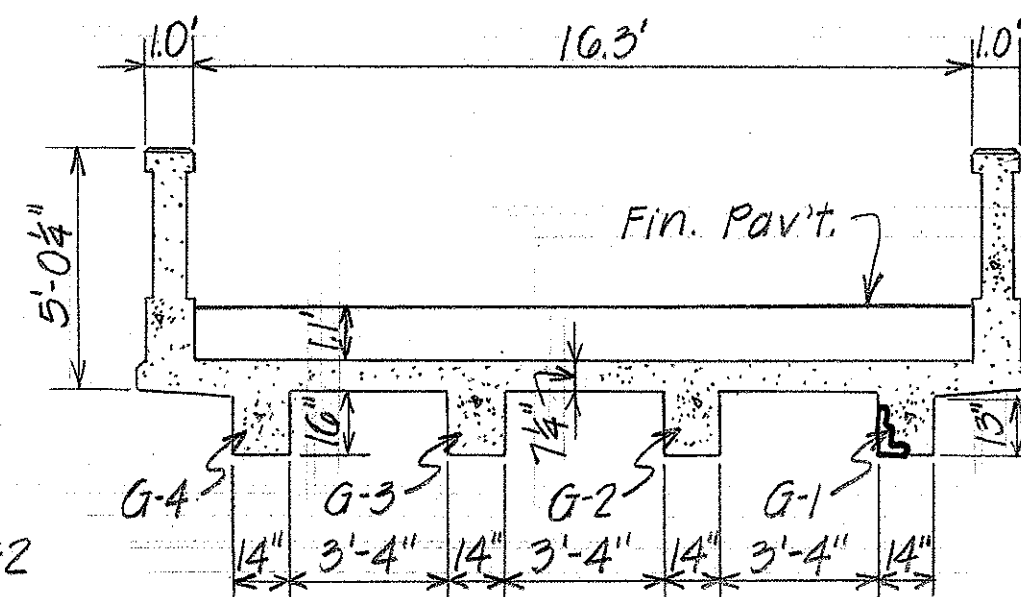

NORMAL DECK SECTION Scale: 1/4"=1'-0"

Reference Note:
Refer to Sheets T-1 thru T-4 incl. for Typical Details.

STATE OF HAWAII DEPARTMENT OF TRANSPORTATION HIGHWAYS DIVISION
REHABILITATION & REPAIRS TO PUPAPE BRIDGE
PROJ. No HWY M-01-74 Nov. 1973
SHEET No. 1 OF 1 SHEETS

DESIGNED BY: L.N.	CHECKED BY: V.C.
DRAWN BY: L.N.	DATE: 11/73
NOTED BY: L.N.	
DATE: 11/73	