

INDEX TO DRAWINGS	
SHEET NO.	DESCRIPTION
1	TITLE SHEET
2	ESTIMATED QUANTITIES
3-5	TYPICAL DETAILS
6-50	SEE SHT. NO. 2 FOR LISTING OF INDIVIDUAL BRIDGES

STATE OF HAWAII
DEPARTMENT OF TRANSPORTATION
HIGHWAYS DIVISION
HONOLULU, HAWAII


"AS-BUILT" PLANS OF
REPAIR BRIDGES - VARIOUS LOCATIONS
ISLAND OF MAUI
PROJECT NO. HWY M-01-74

NOTE:


ALL CHANGES MADE DURING CONSTRUCTION HAVE BEEN INCORPORATED ON THESE PLANS INCLUDING CHANGES IN THE ORIGINAL THEORETICAL QUANTITIES.

George N. Kaya
PROJECT ENGINEER

3/25/75
DATE

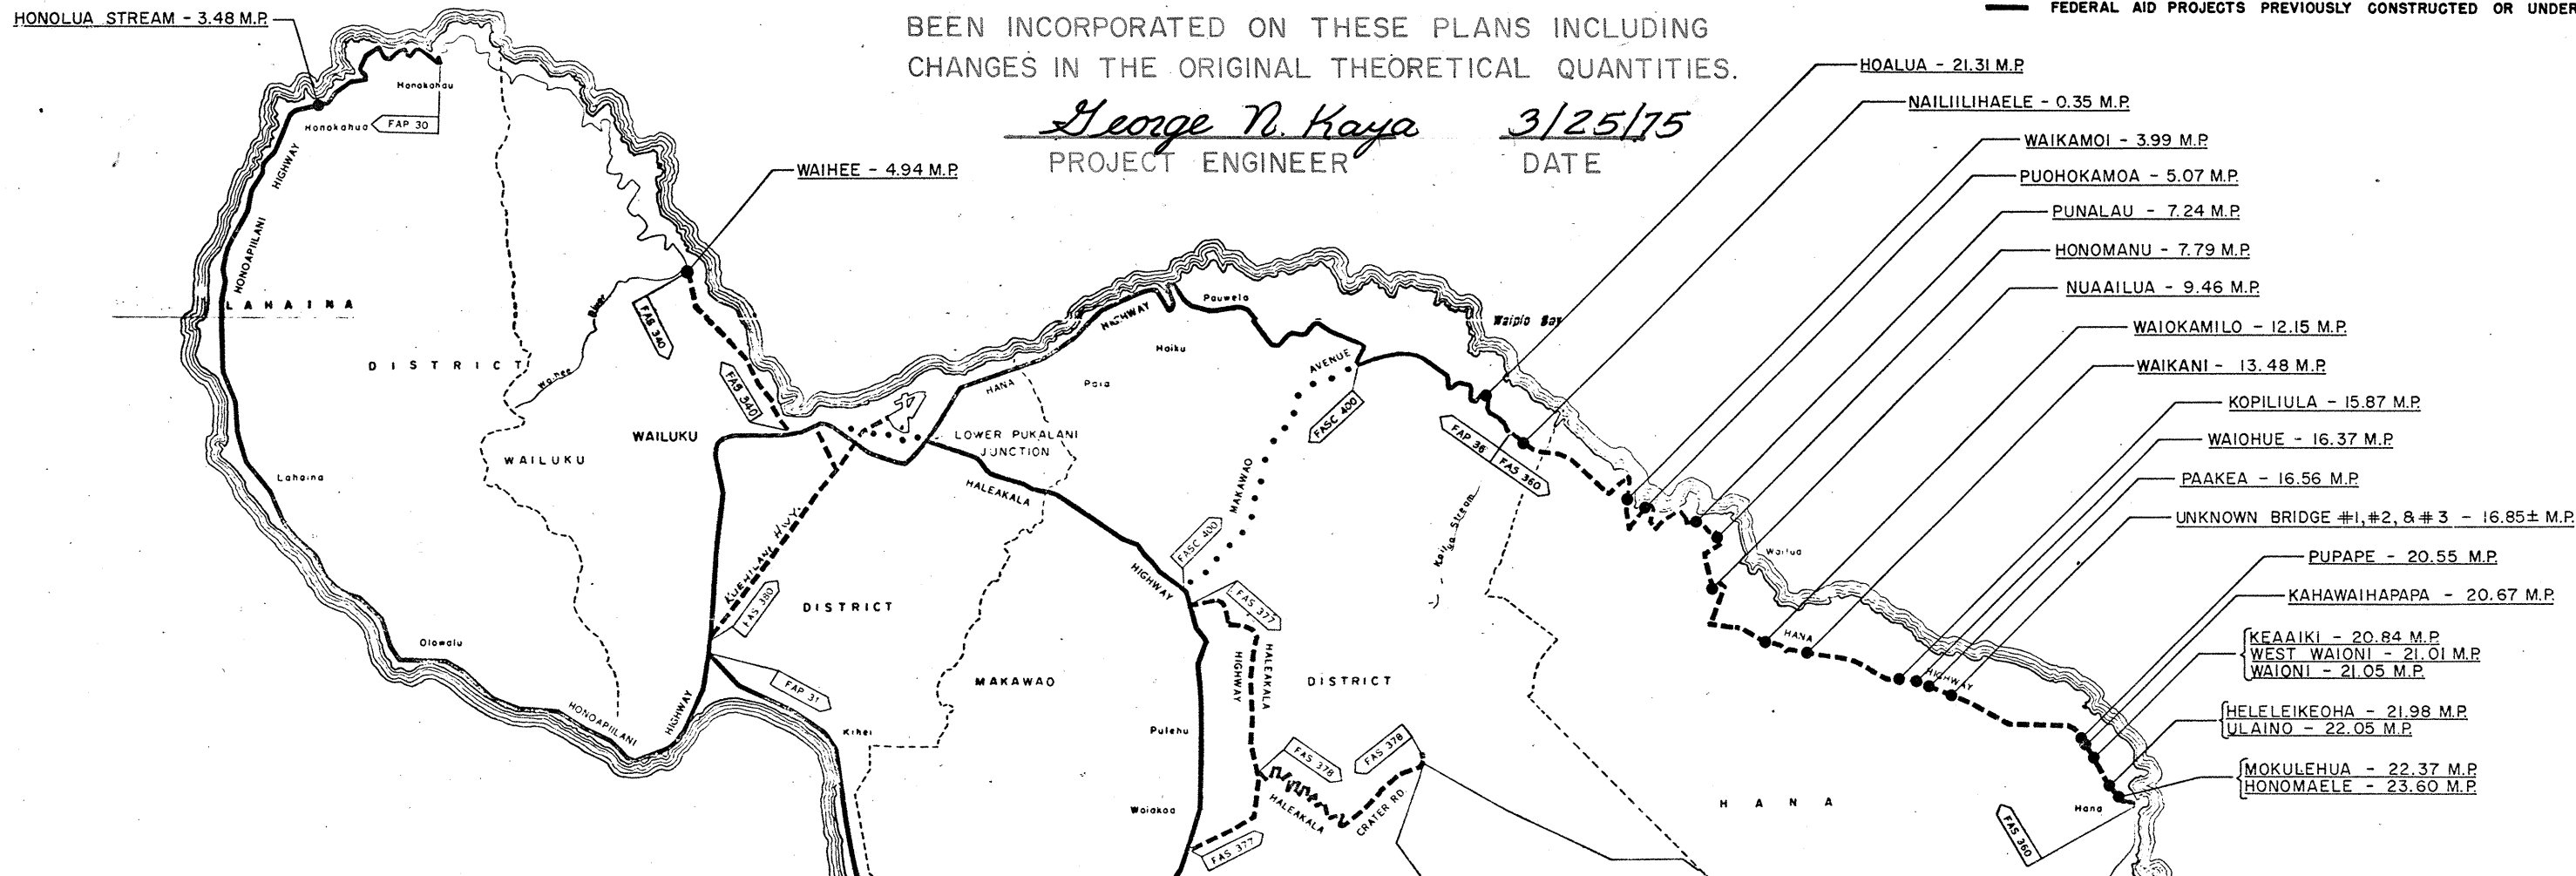

LOCATION PLAN - SCALE: 1" = 2 MI.

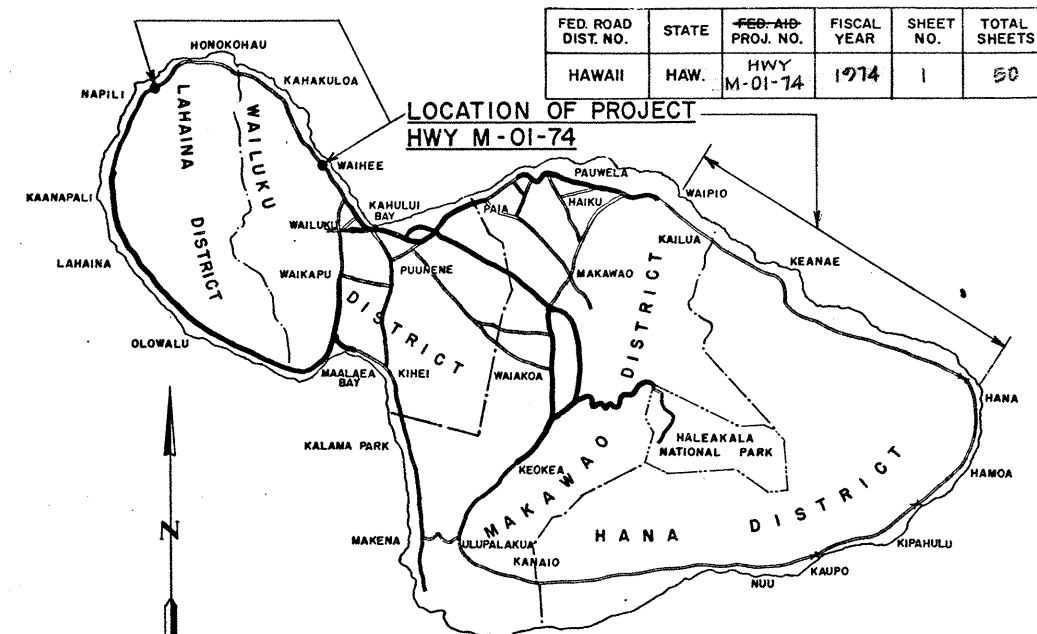

LOCATION MAP

— FEDERAL AID PROJECTS PREVIOUSLY CONSTRUCTED OR UNDER CONSTRUCTION

DEPARTMENT OF TRANSPORTATION STATE OF HAWAII	
APPROVED:	
FOR <i>Murray Lee</i>	12/7/73
DIR. OF TRANSPORTATION	DATE