




FED. ROAD DIST. NO.	STATE	FED-AID PROJ. NO.	FISCAL YEAR	SHEET NO.	TOTAL SHEETS
HAWAII	HAW.	M-01-74	1974	34	50

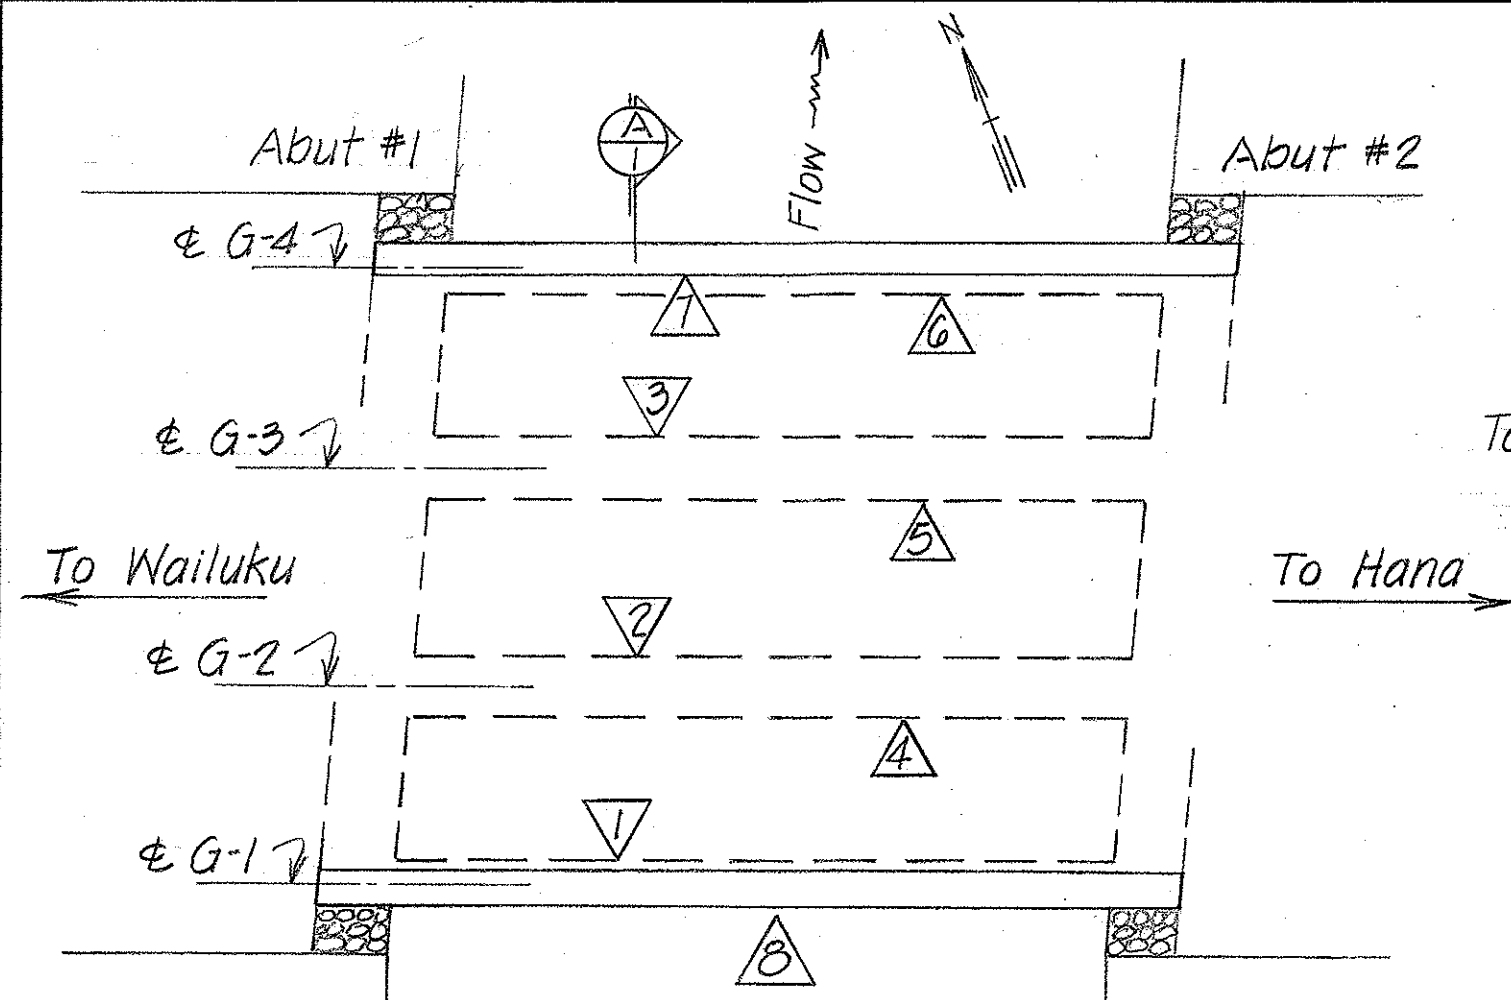

LAYOUT AND FRAMING PLAN Scale: 1/4"=1'-0"

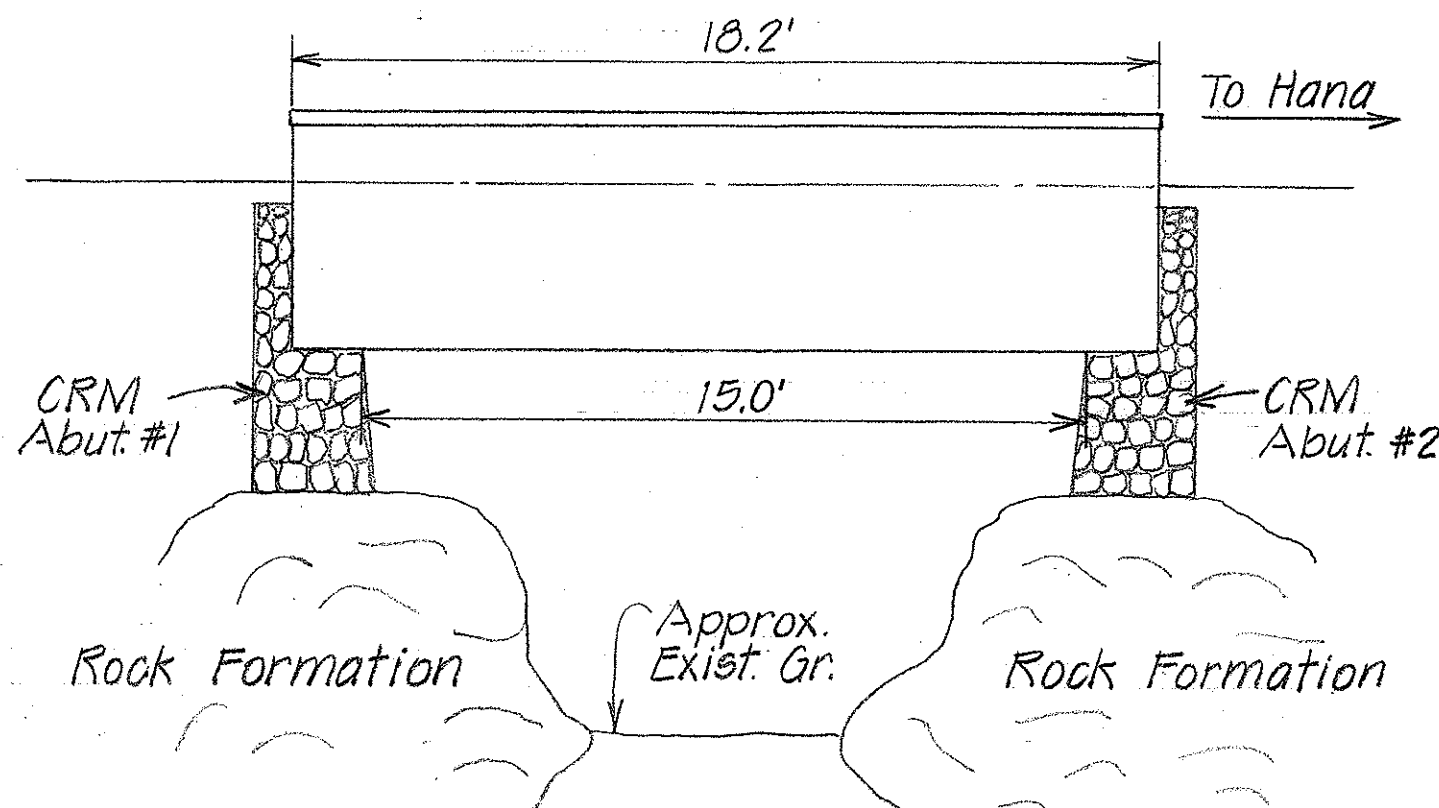


ELEVATION 8 Scale: 1/4"=1'-0"

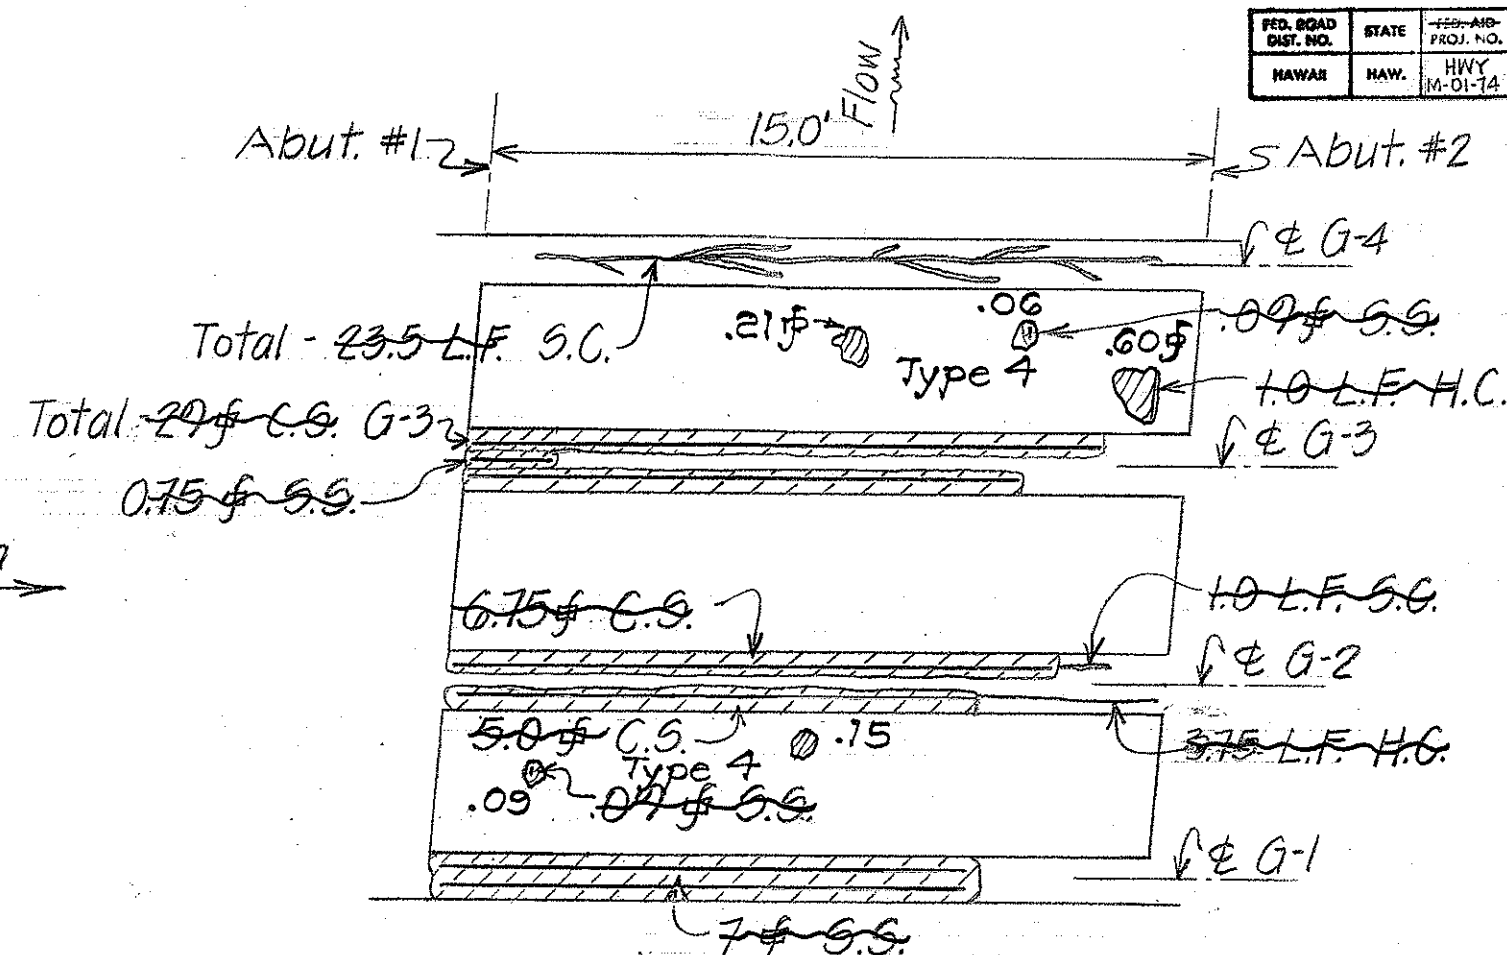

REFLECTED CEILING PLAN Scale: 1/4"=1'-0"

Reference Note:

Refer to Sheets T-1 thru T-4 incl. for Typical Details.

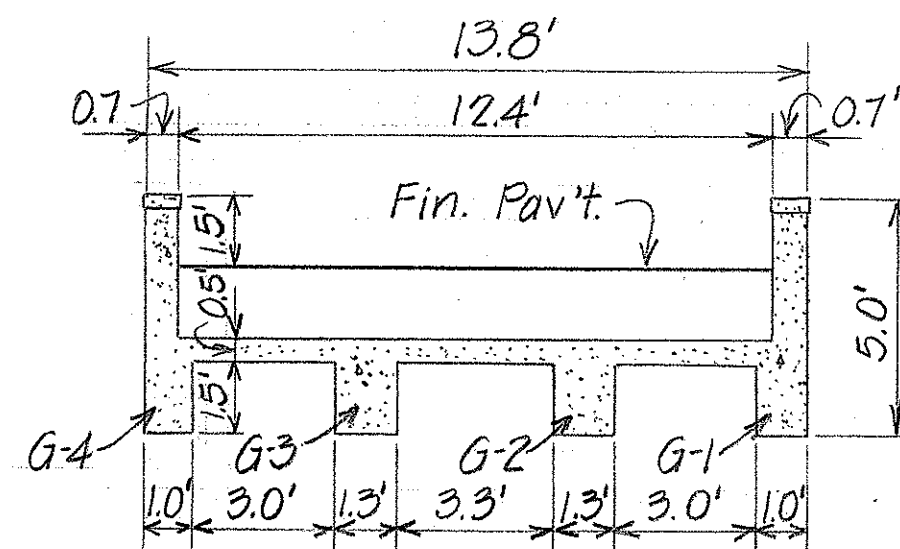

NORMAL DECK SECTION A Scale: 1/4"=1'-0"

STATE OF HAWAII DEPARTMENT OF TRANSPORTATION HIGHWAYS DIVISION
REHABILITATION & REPAIRS TO UNKNOWN #1 BRIDGE
PROJ. NO. HWY. M-01-74 Nov. 1973
SHEET No. 1 OF 2 SHEETS

DESIGNED BY	DATE
DRAWN BY	11-73
CHECKED BY	
APPROVED BY	
NOTES	


FED. ROAD DIST. NO.	STATE	PROJ. NO.	FISCAL YEAR	SHEET NO.	TOTAL SHEETS
HAWAII	HAW.	HWY M-01-74	1974	35	50

To Hana


To Wailuku

To Wailuku


To Hana

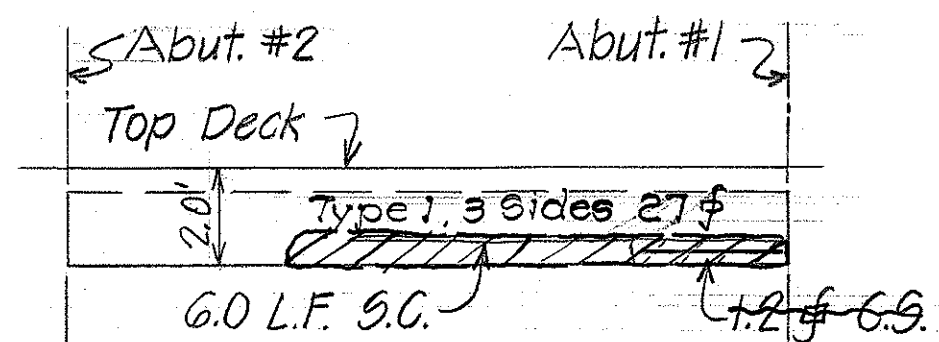


ELEVATION 1 (G-1)

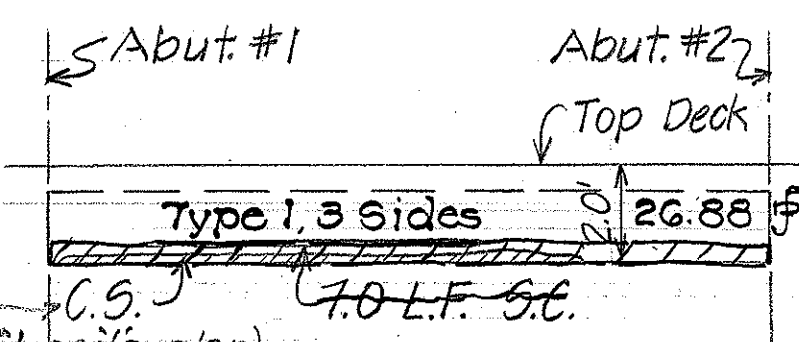


ELEVATION 4 (G-2)

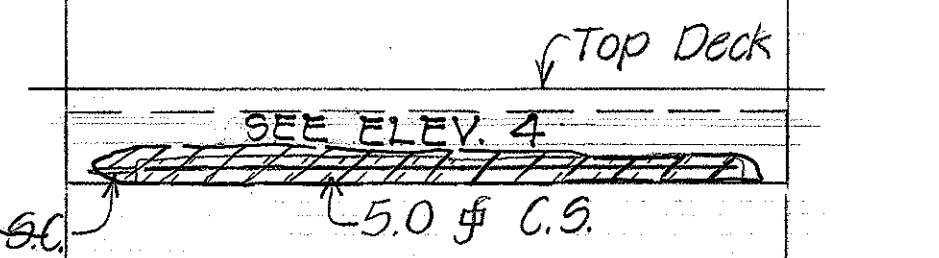


ELEVATION 2 (G-2)

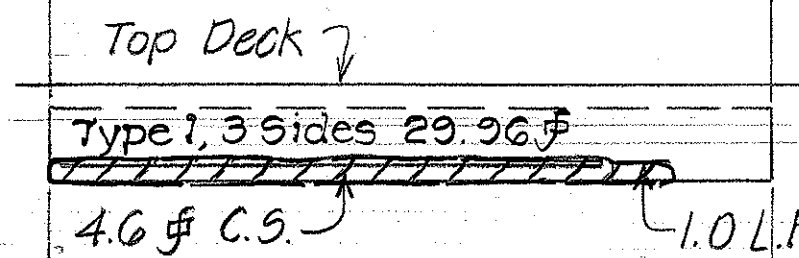

ELEVATION 5 (G-3)

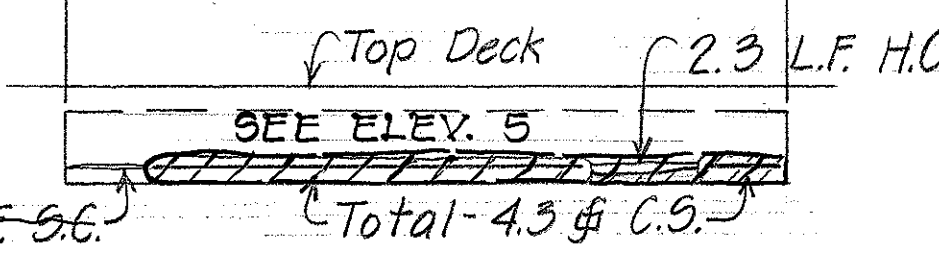


ELEVATION 3 (G-3)

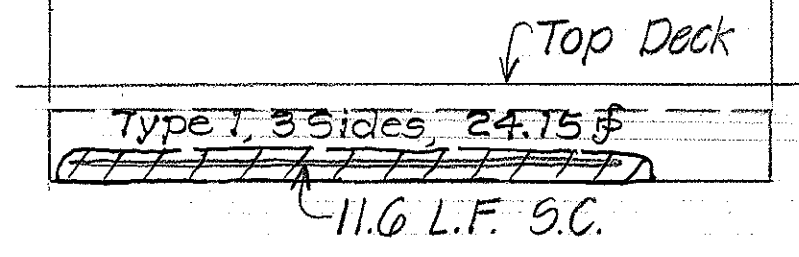

ELEVATION 6 (G-4)

Scale: 1/4" = 1'-0"

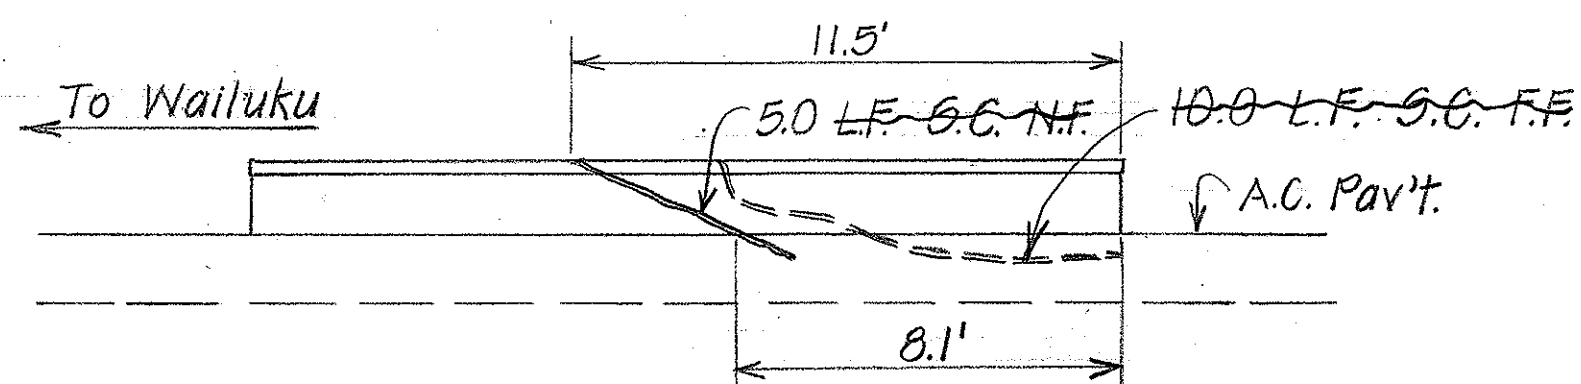

ELEVATION 7 scale: 1/4" = 1'-0"

DESIGNED BY	DATE
CHECKED BY	DATE
APPROVED BY	DATE
REVISIONS	

STATE OF HAWAII
DEPARTMENT OF TRANSPORTATION
HIGHWAYS DIVISION

REHABILITATION & REPAIRS
TO UNKNOWN #1 BRIDGE

PROJ. NO. HWY. M-01-74 Nov. 1973

SHEET No. 2 OF 2 SHEETS