



FED. ROAD DIST. NO.	STATE	FED. AID PROJ. NO.	FISCAL YEAR	SHEET NO.	TOTAL SHEETS
HAWAII	HAW.	HWY M-01-74	1974	38	50

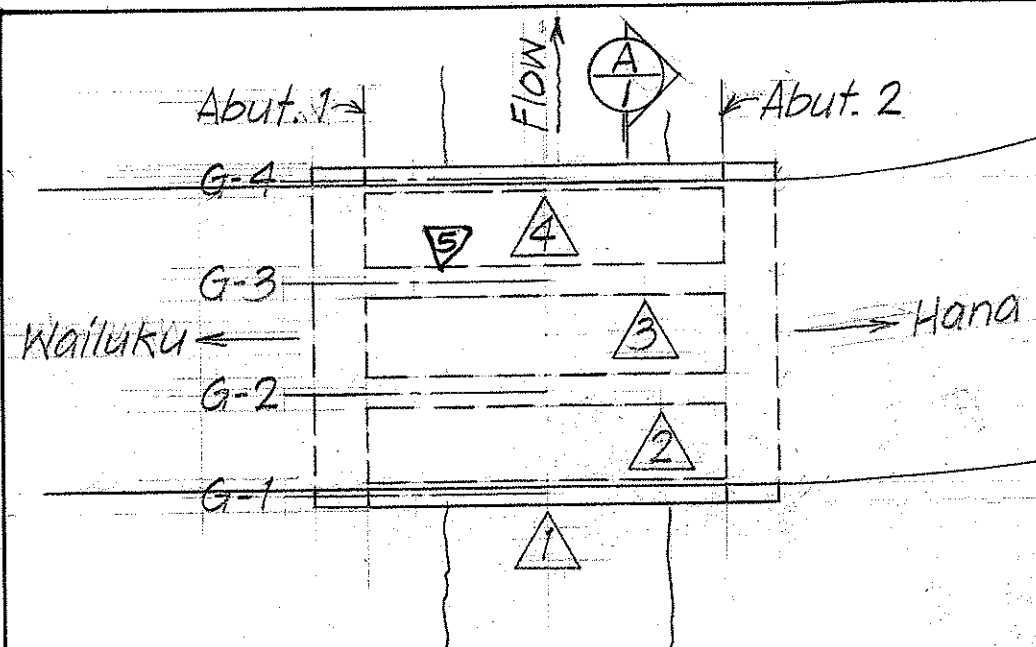



LAYOUT & FRAMING PLAN

Scale: 1/8"=1'-0"

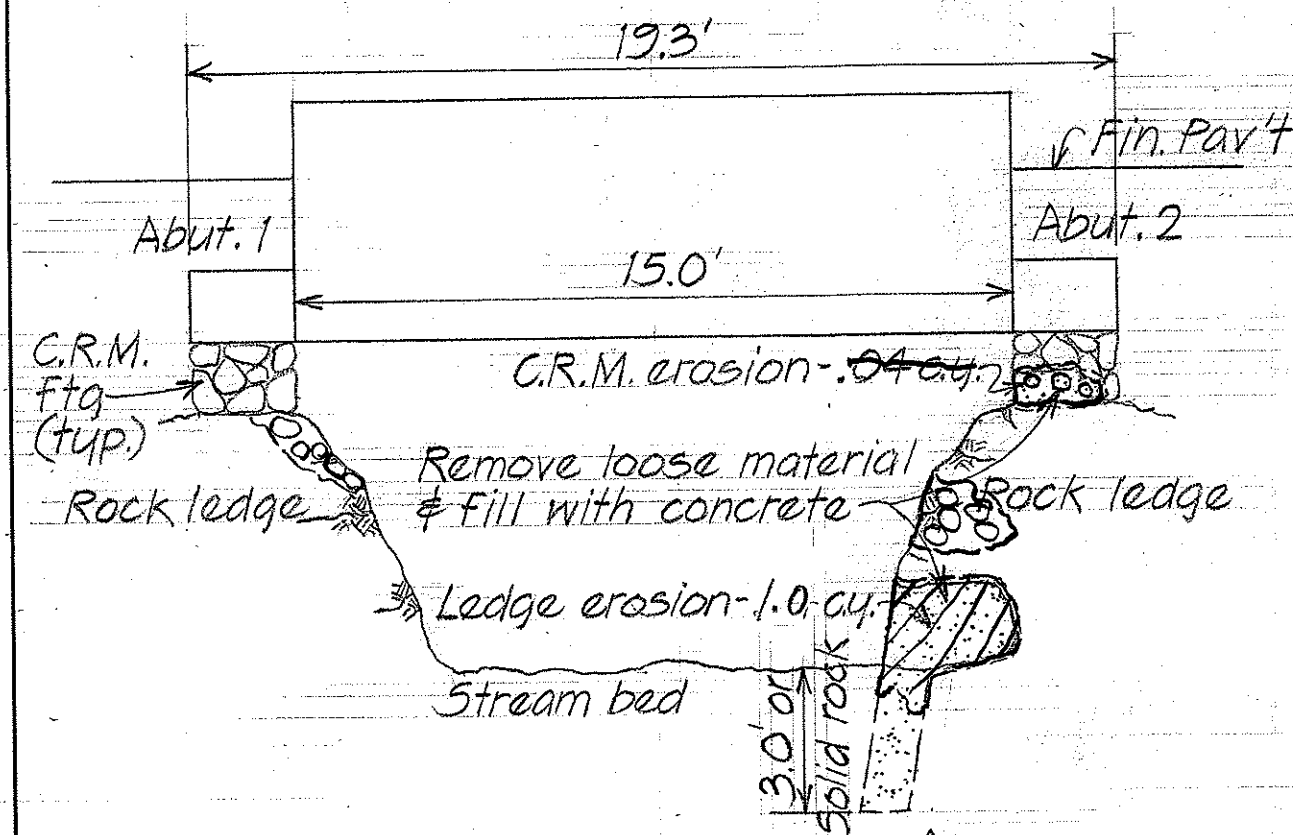


ELEVATION 1

Scale: 1/4"=1'-0"

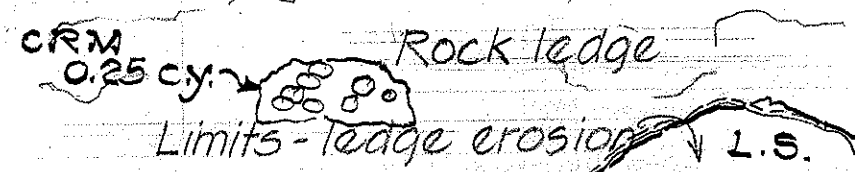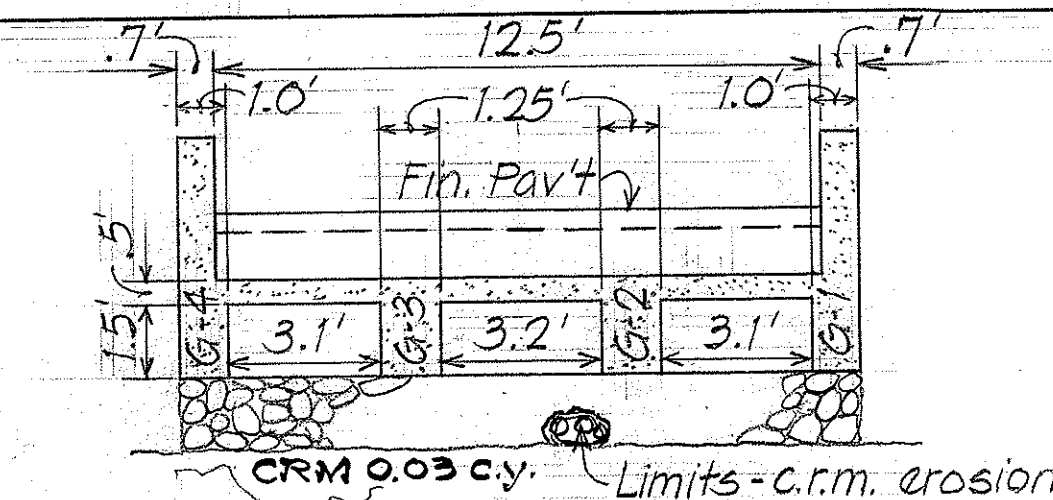

SECTION A-1

Scale: 1/4"=1'-0"

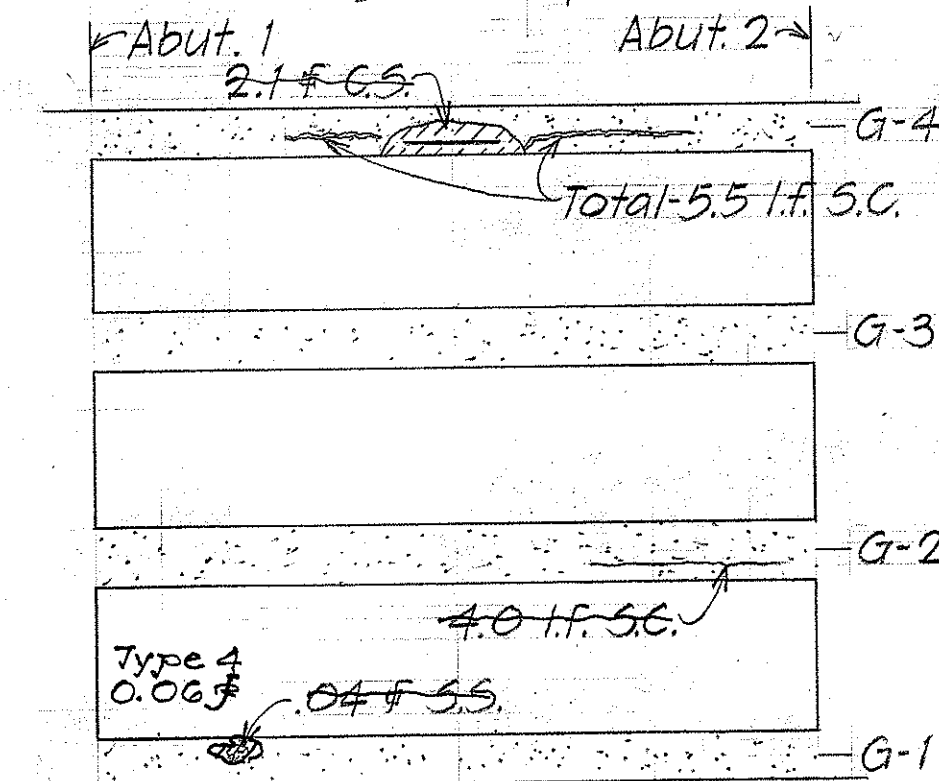

REFLECTED CEILING PLAN

Scale: 1/4"=1'-0"

Reference Notes:

Refer to sheets T-1 thru T-4 incl. for Typical Details.

Type 1 2 Side 2.45 c.y.

ELEV. 5 G-3

Abut. 1 Top deck 1.2 l.f. S.C. Abut. 2 3.0 l.f. H.C.

Type 1 3 Sides 20.37 c.y.

Total-5.5 l.f. S.C.

ELEV. 4 G-4

Scale: 1/4"=1'-0"

Abut. 1 Top deck Abut. 2

ELEV. 3 G-3

Scale: 1/4"=1'-0"

Abut. 1 Top deck Abut. 2

Type 3 7.2 l.f.

Type 1 2 Side 2.58 c.y.

ELEV. 2 G-2

Scale: 1/4"=1'-0"

STATE OF HAWAII DEPARTMENT OF TRANSPORTATION HIGHWAYS DIVISION	
REHABILITATION & REPAIRS TO UNKNOWN #3 BRIDGE	
PROJ. NO. HWY M-01-74 Nov. 1973	
SHEET No. 1 OF 1 SHEETS	