
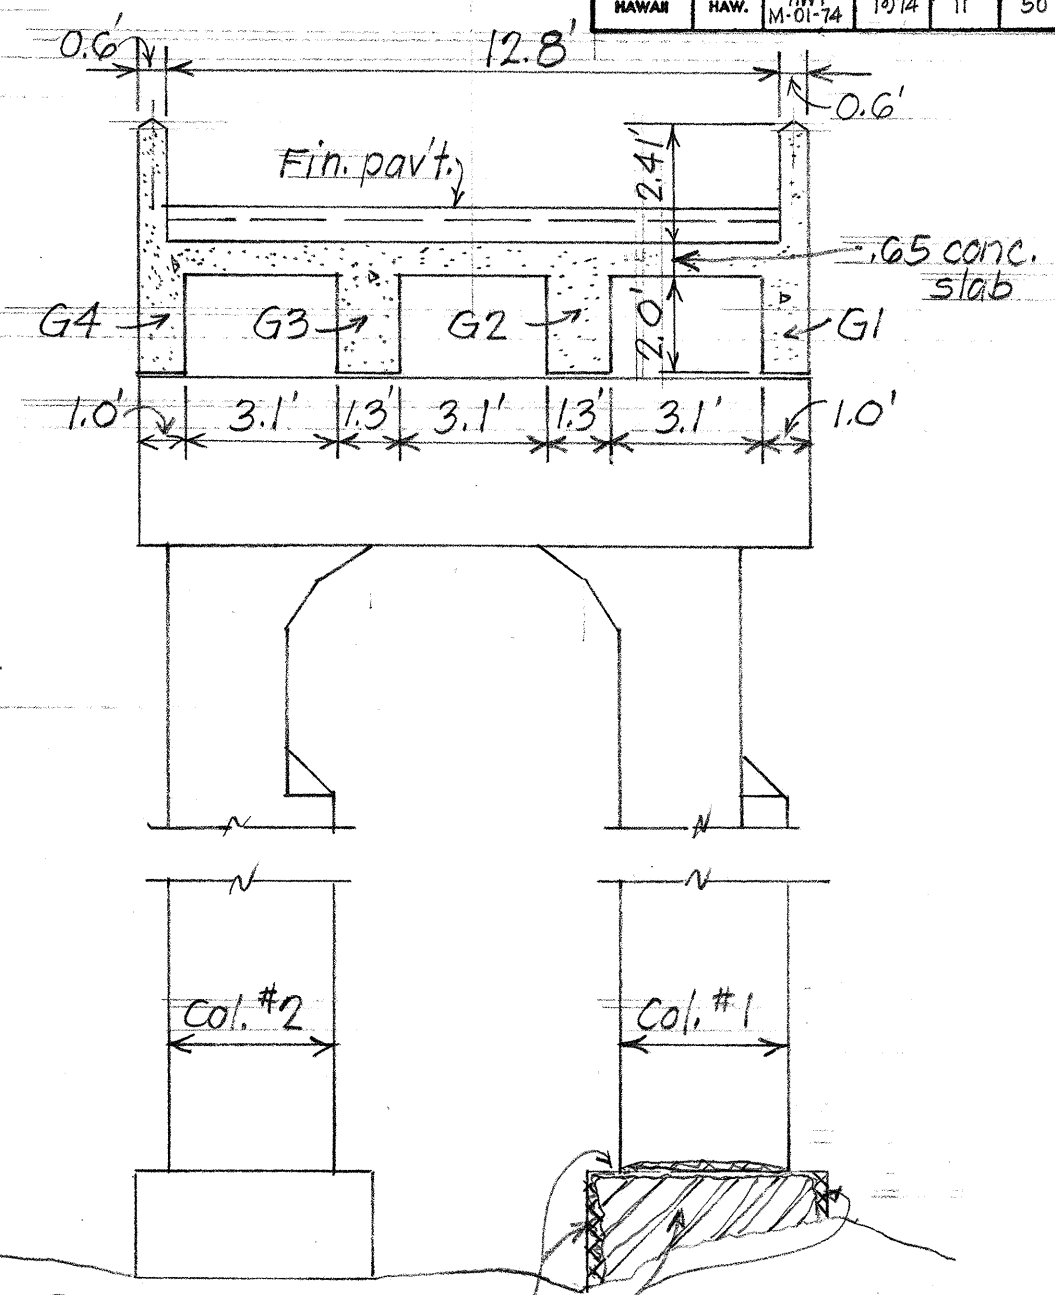


FED. ROAD DIST. NO.	STATE	FED-AID PROJ. NO.	FISCAL YEAR	SHEET NO.	TOTAL SHEETS
HAWAII	HAW.	HWY M-01-74	1974	11	50

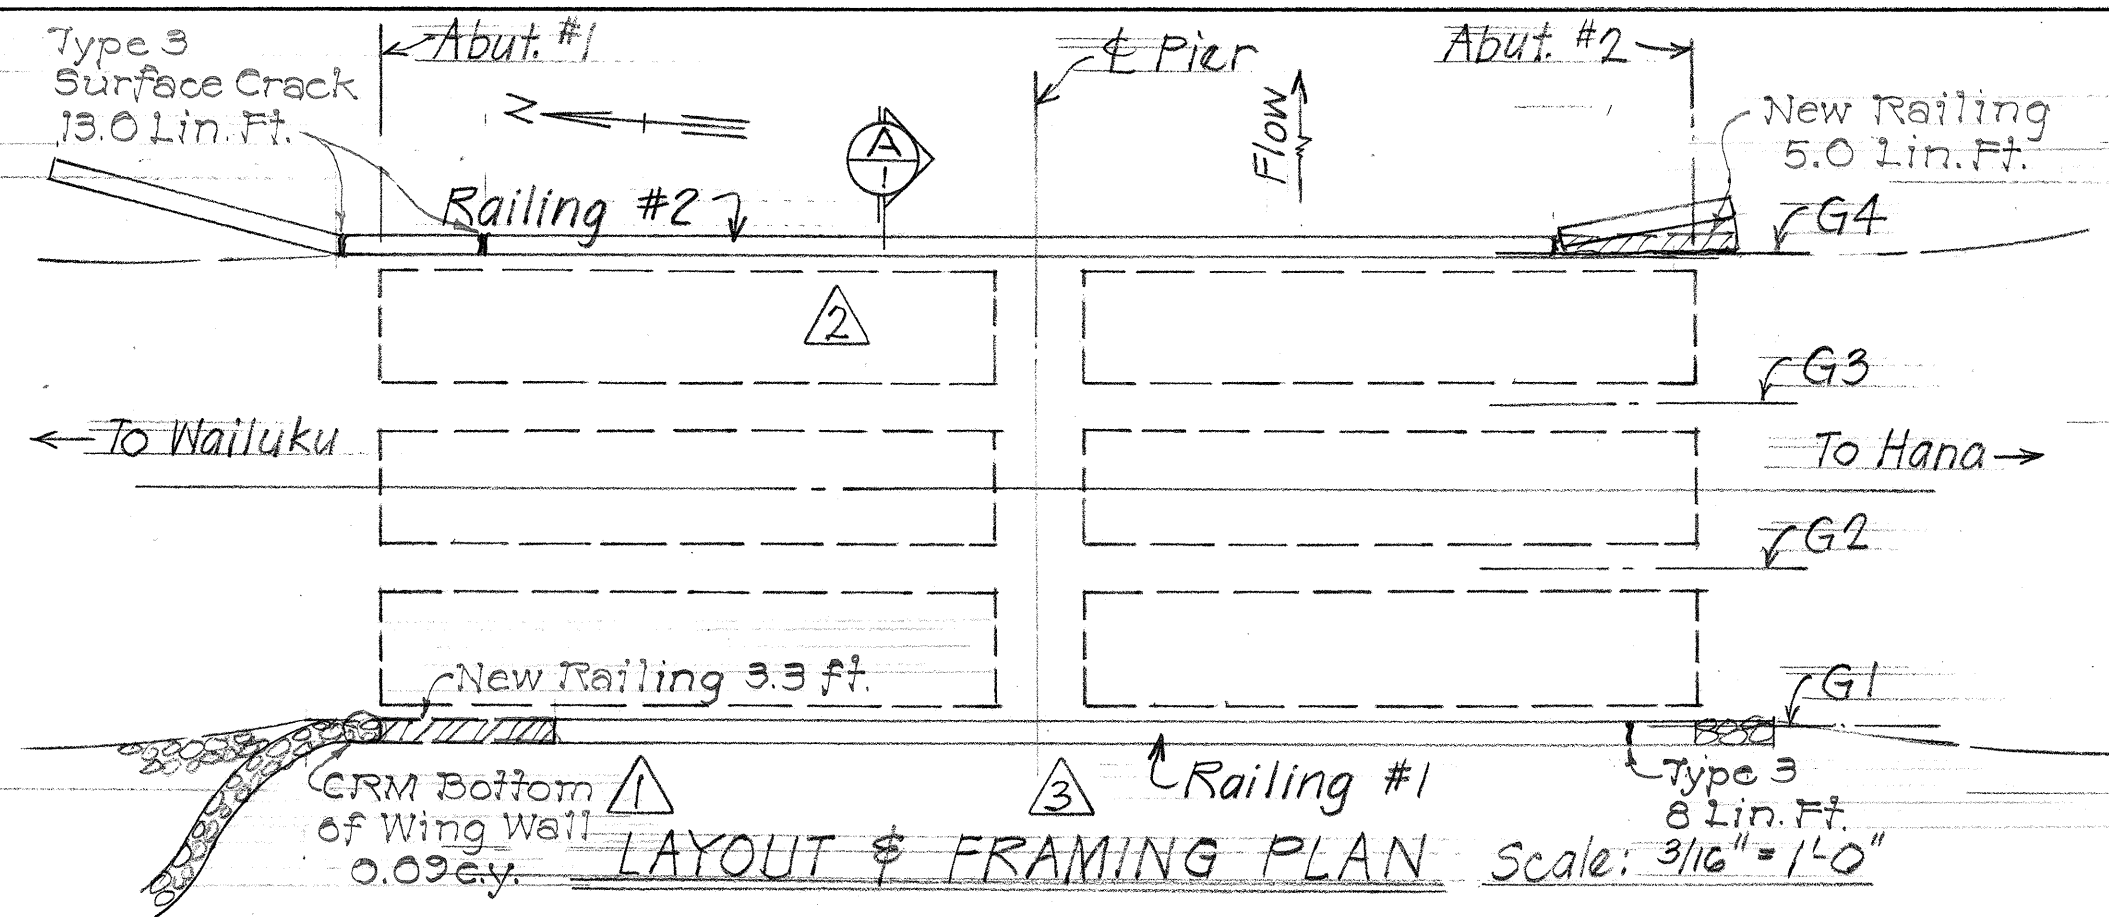


Roughen all exposed surfaces. Apply bonding compound & mortar. See Specs.
Type 4 33 & surface repair.

NORMAL DECK SECTION (A)

Scale: 1/4" = 1'-0"

Reference Notes:
Refer to sheets T1 thru T4 incl. for Typical Details.

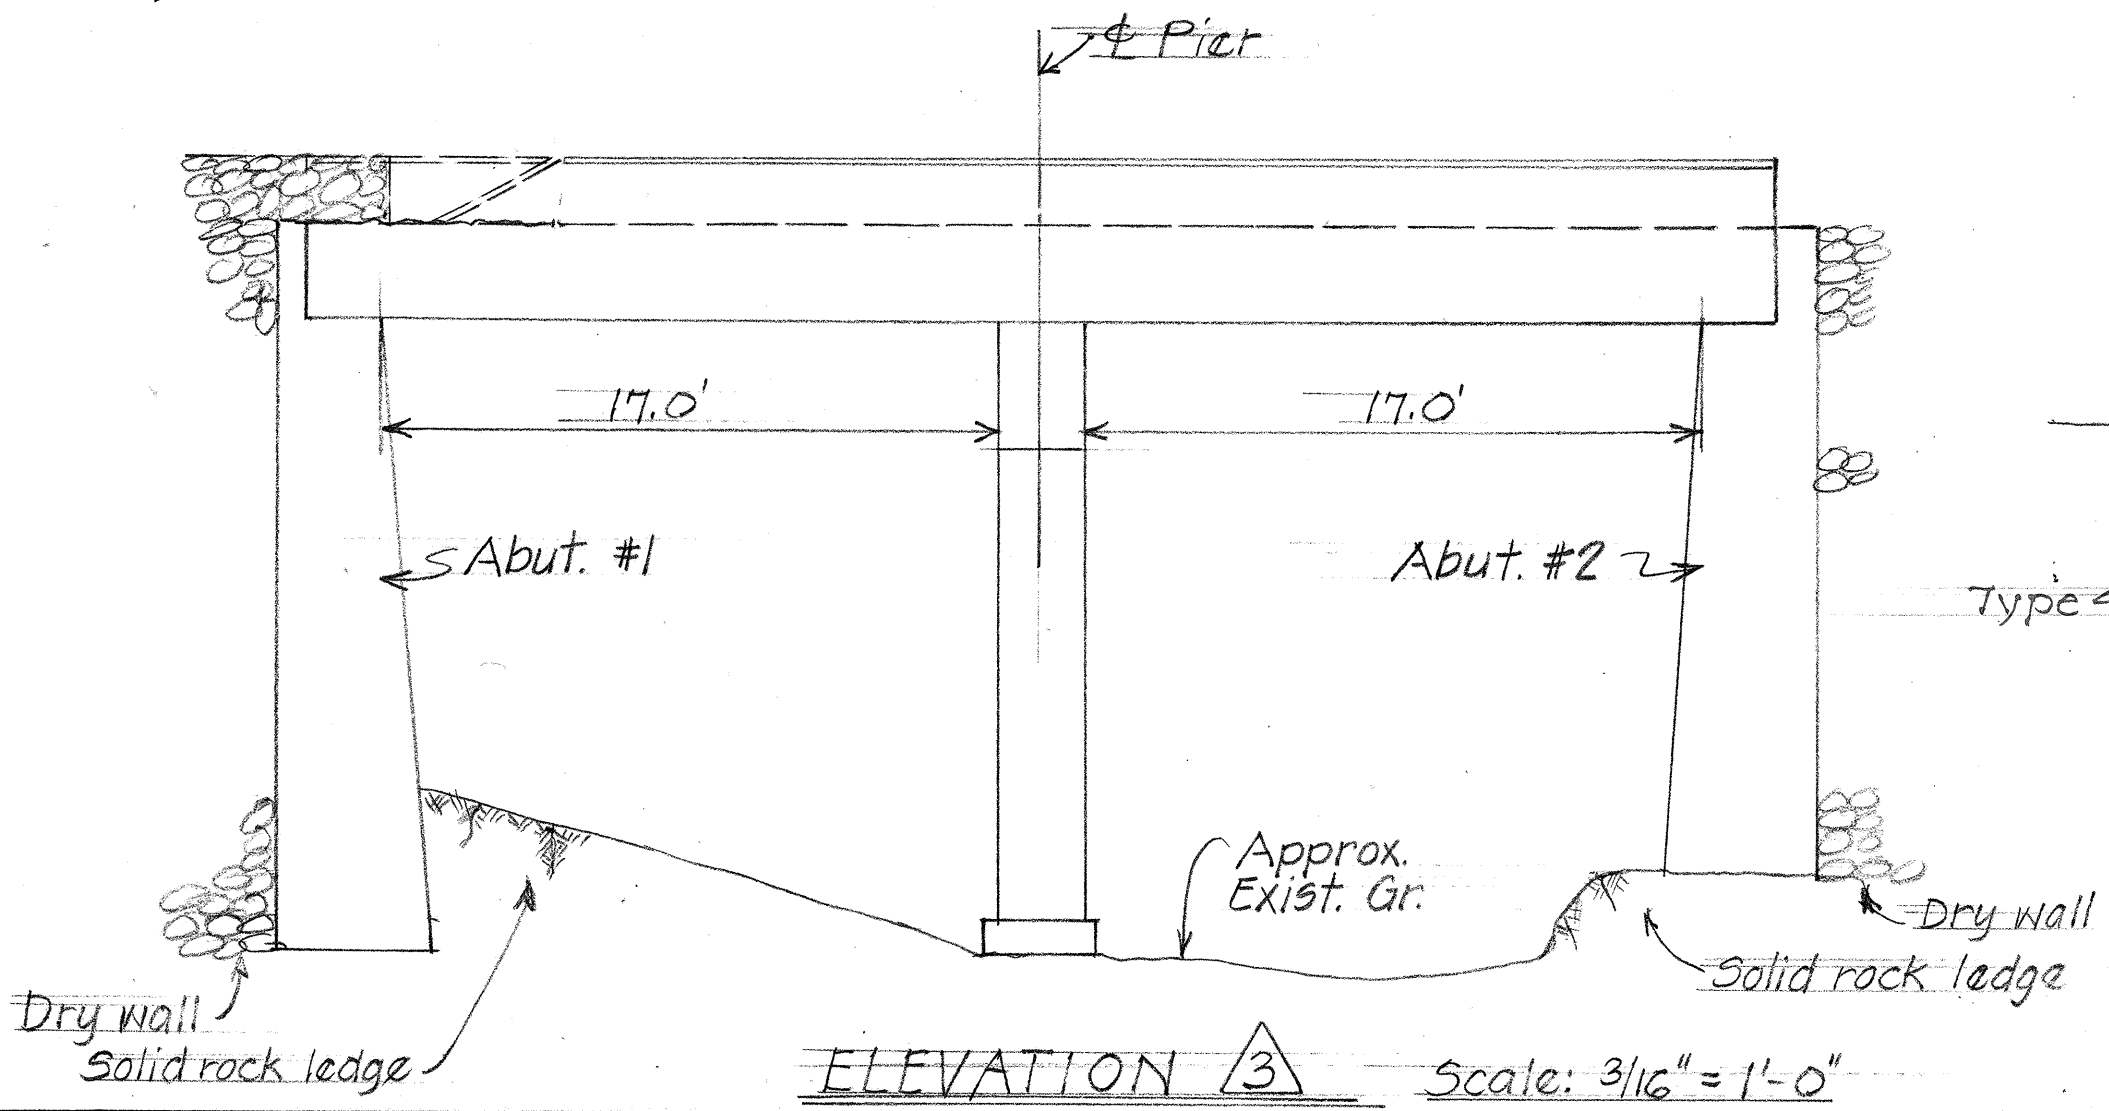

ELEVATION (3)

Scale: 3/16" = 1'-0"

STATE OF HAWAII
DEPARTMENT OF TRANSPORTATION
HIGHWAYS DIVISION


REHABILITATION & REPAIRS
TO WAIKAMOI BRIDGE

PROJ. NO HWY. M-01-74 Nov. 1973

SHEET No. 1 OF 2 SHEETS


DESIGNED BY	DATE
CHECKED BY	DATE
APPROVED BY	DATE
NOTED BY	DATE
QUANTITIES BY	DATE
PLANNED BY	DATE
SURVEY PLANNED BY	DATE

FED. ROAD DIST. NO.	STATE	FED-AID PROJ. NO.	FISCAL YEAR	SHEET NO.	TOTAL SHEETS
HAWAII	HAW.	HWY M-01-74	1974	12	50

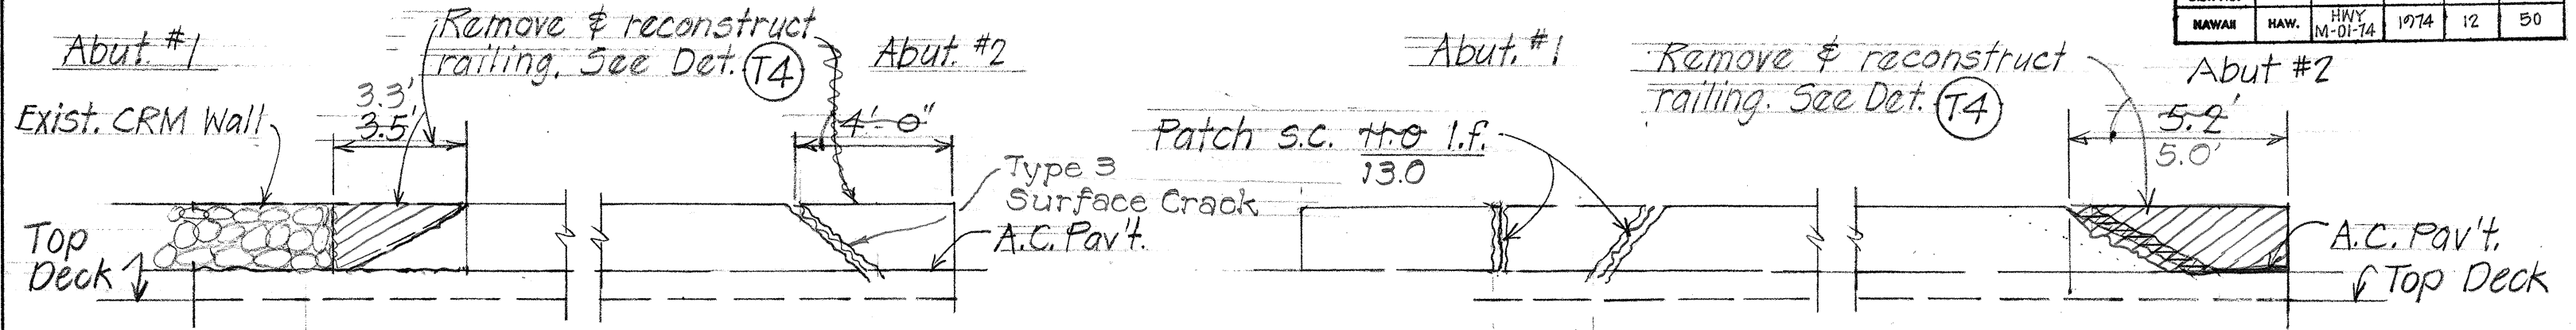

ELEVATION 1 - RAILING #1
Scale: 1/4" = 1'-0"

ELEVATION 2 - RAILING #2
Scale: 1/4" = 1'-0"

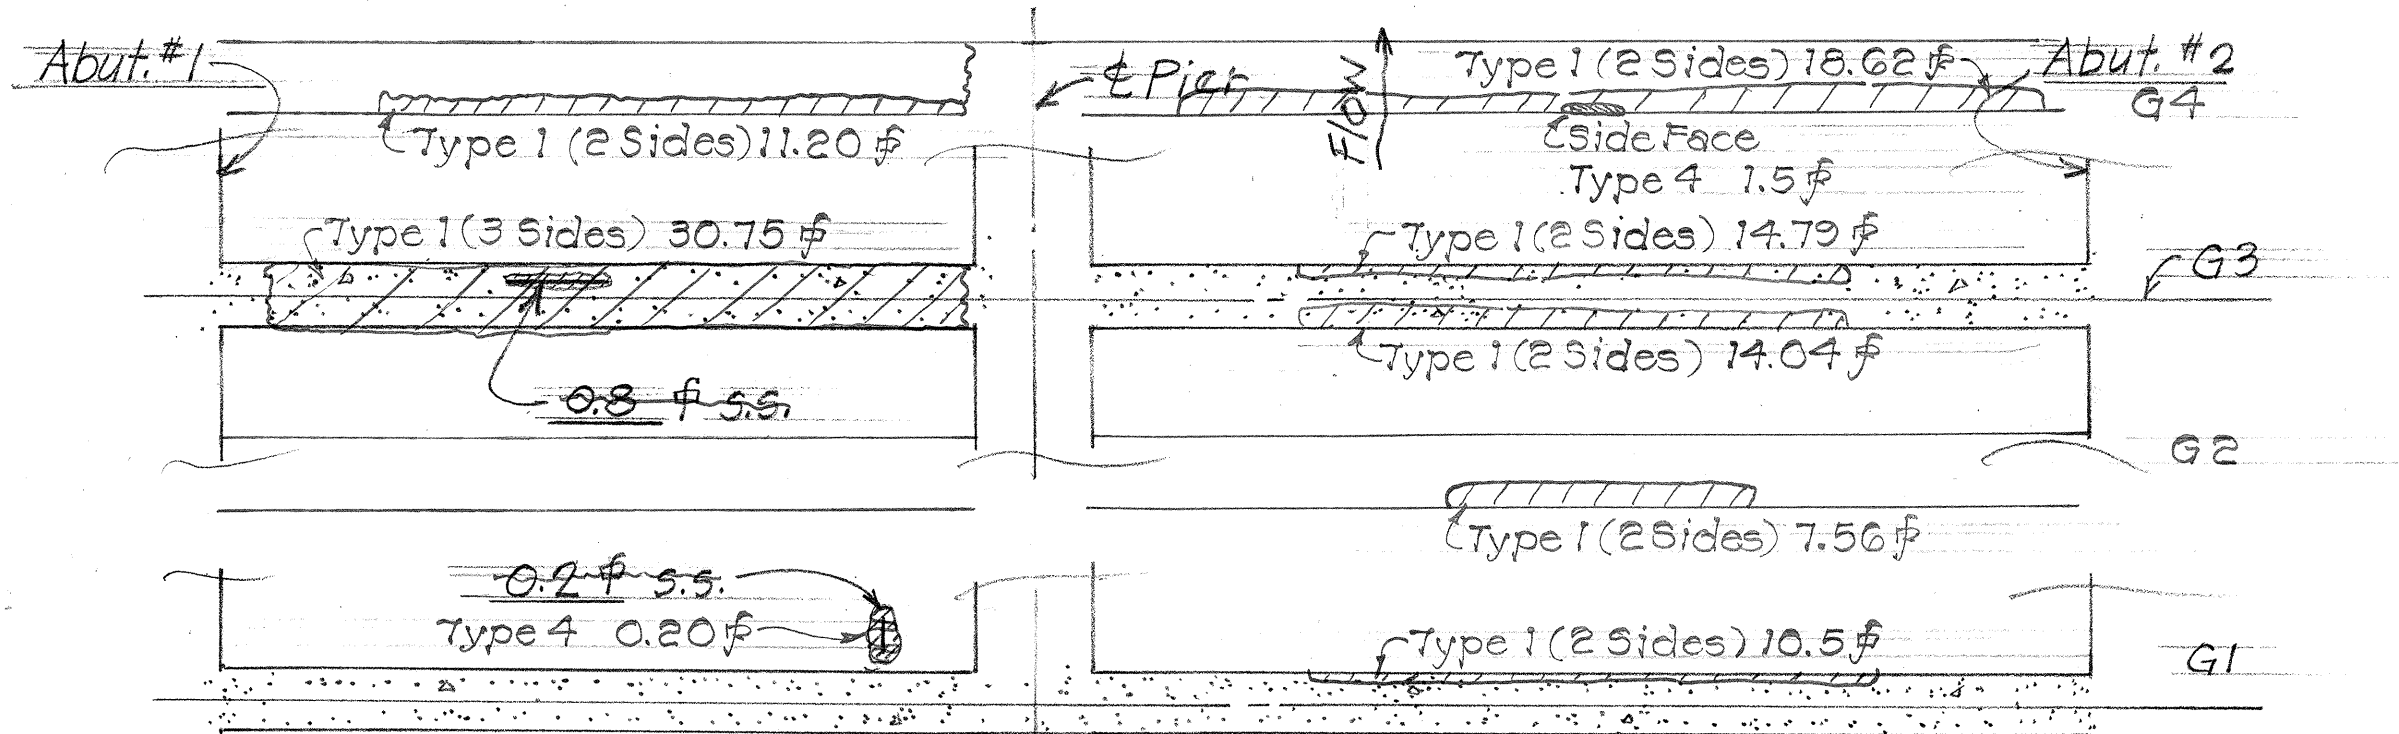

PART REFLECTED CEILING PLAN
Scale: 1/4" = 1'-0"

STATE OF HAWAII
DEPARTMENT OF TRANSPORTATION
HIGHWAYS DIVISION

REHABILITATION & REPAIRS
TO WAIKAMOI BRIDGE

PROJ. NO. HWY. M-01-74 Nov. 1973

SHEET No. 2 OF 2 SHEETS