

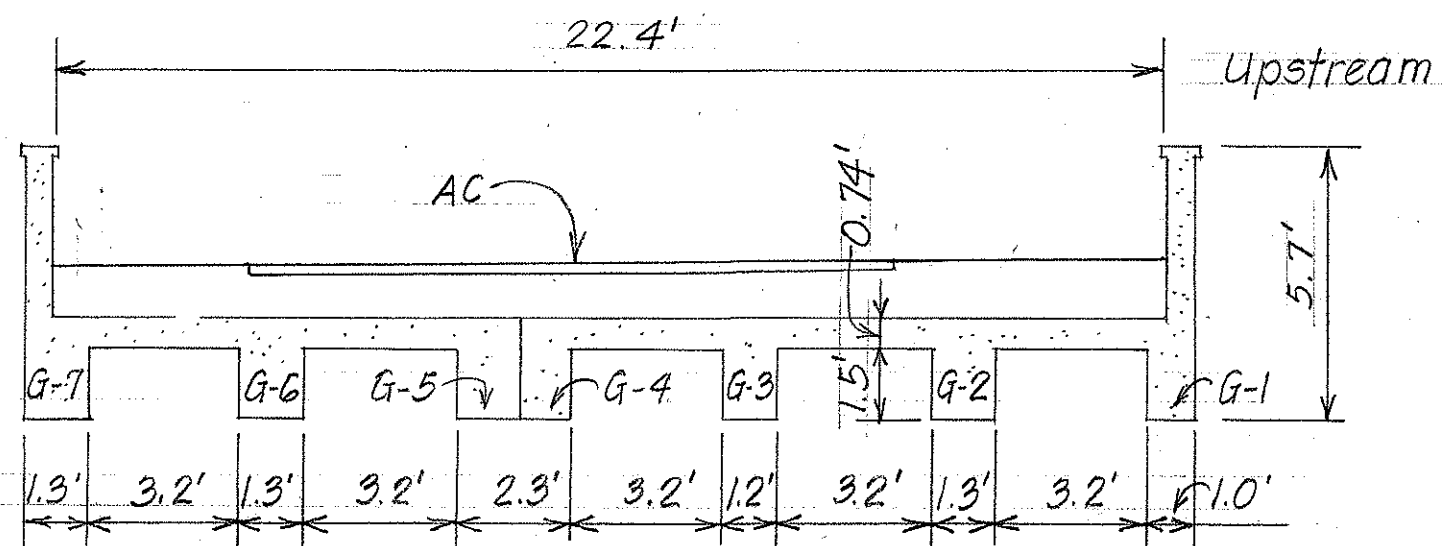


FED. ROAD DIST. NO.	STATE	FED-AID PROJ. NO.	FISCAL YEAR	SHEET NO.	TOTAL SHEETS
HAWAII	HAW.	HWY M-01-74	1974	30	50

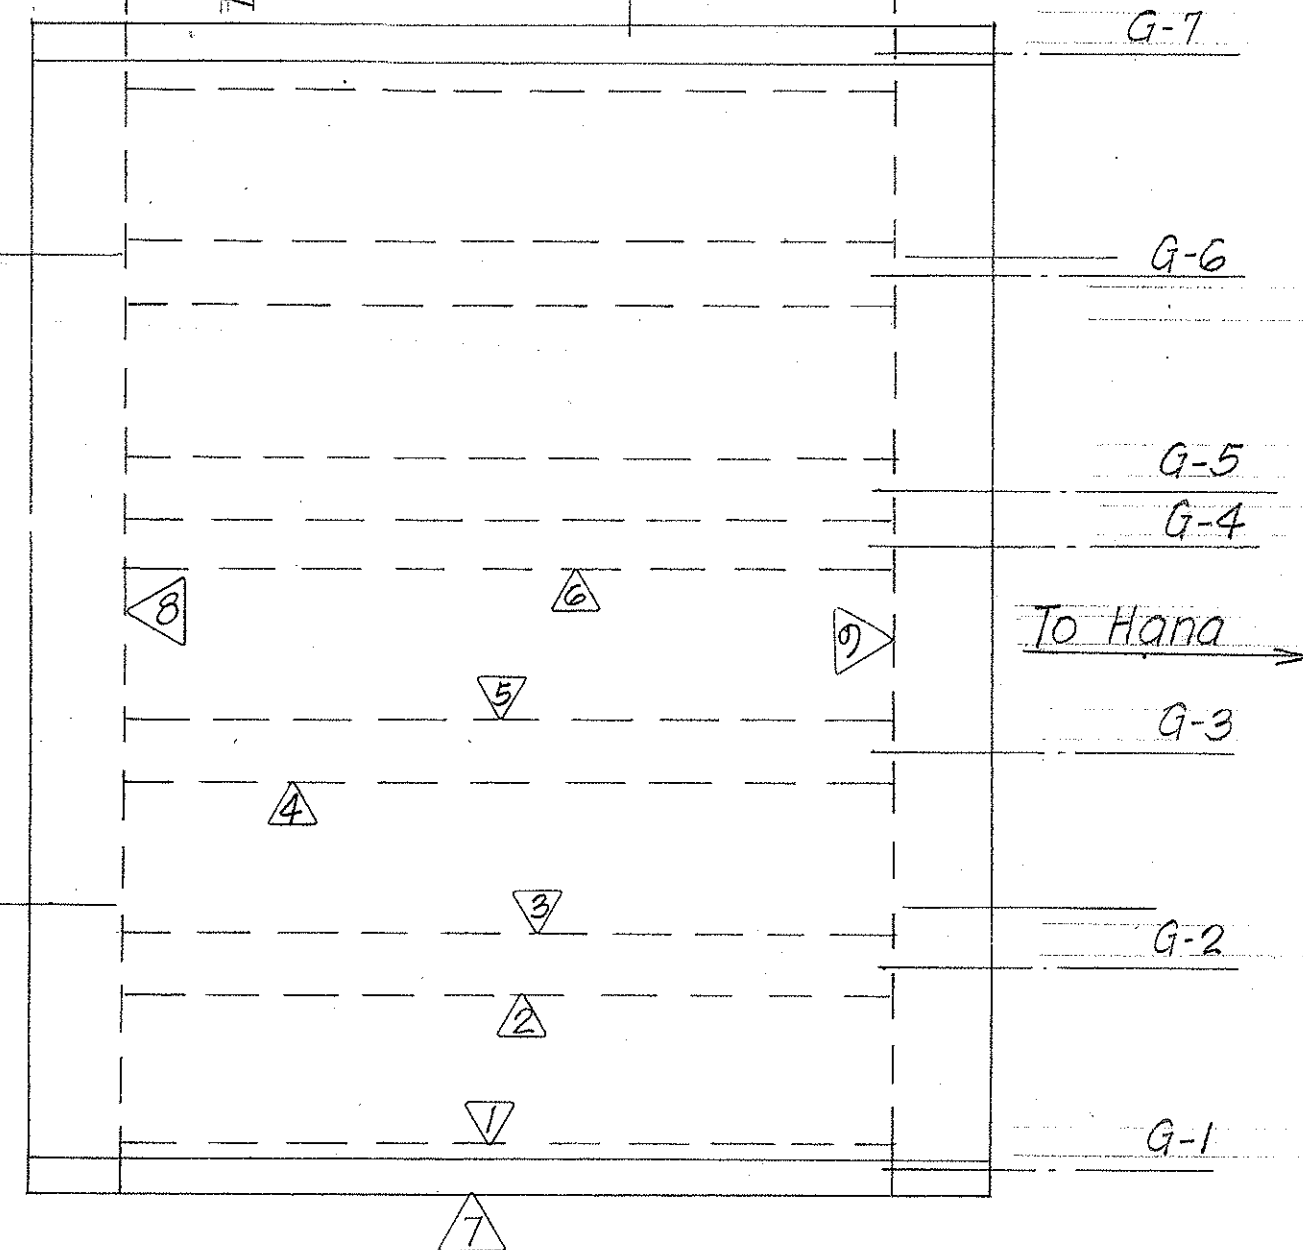

NORMAL DECK SECTION A-A

Scale: 1/4" = 1'-0"

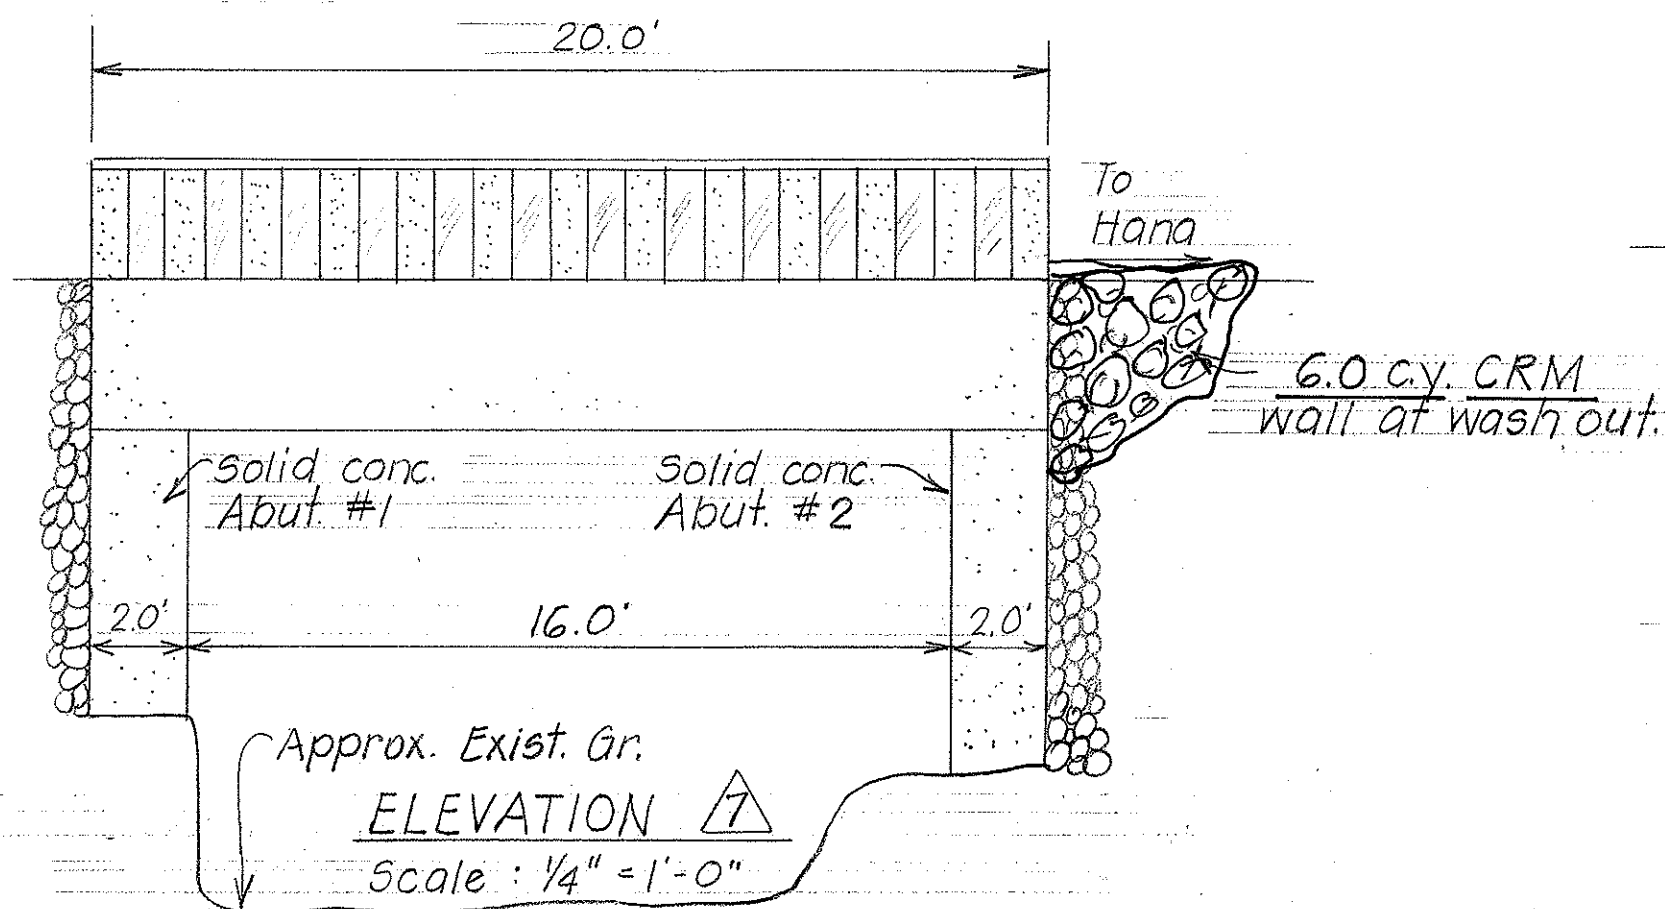

LAYOUT AND FRAMING PLAN



Scale: 1/4" = 1'-0"

Reference Note: Refer to sheets T1 thru T4 incl. for Typical Details.

STATE OF HAWAII DEPARTMENT OF TRANSPORTATION HIGHWAYS DIVISION
REHABILITATION & REPAIRS TO WAIOHUE BRIDGE
HWY-M-01-74 NOV. 1973
SHEET No. 1 OF 2 SHEETS

DESIGNED BY	DATE
CHECKED BY	11/73
NOTED BY	
ORIGINAL PLAN	

FED. ROAD DIST. NO.	STATE	FED. AID PROJ. NO.	FISCAL YEAR	SHEET NO.	TOTAL SHEETS
HAWAII	HAW.	HWY M-01-74	1974	31	50

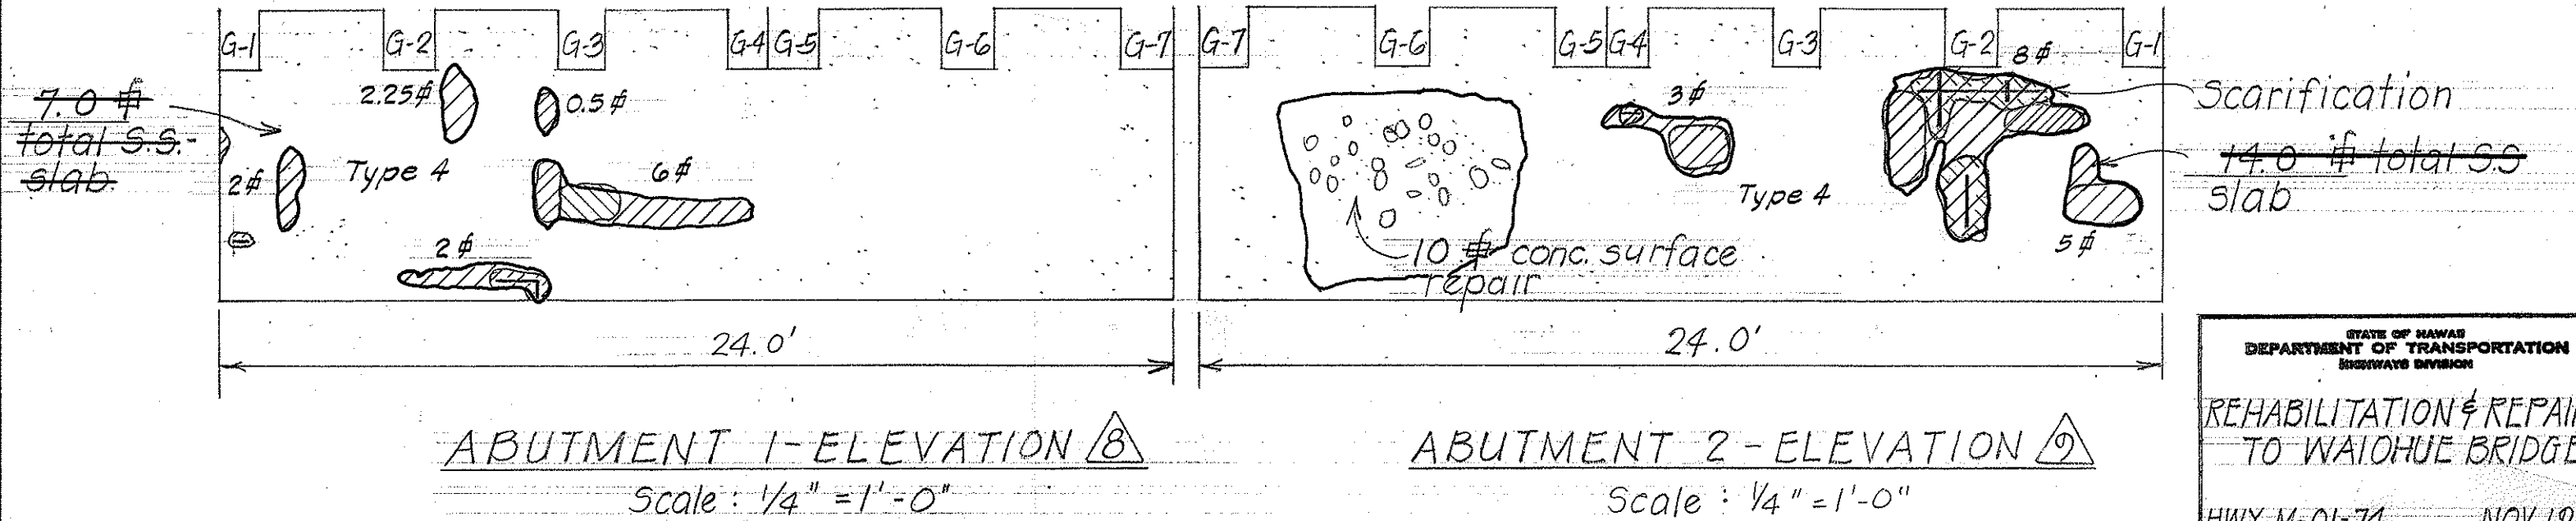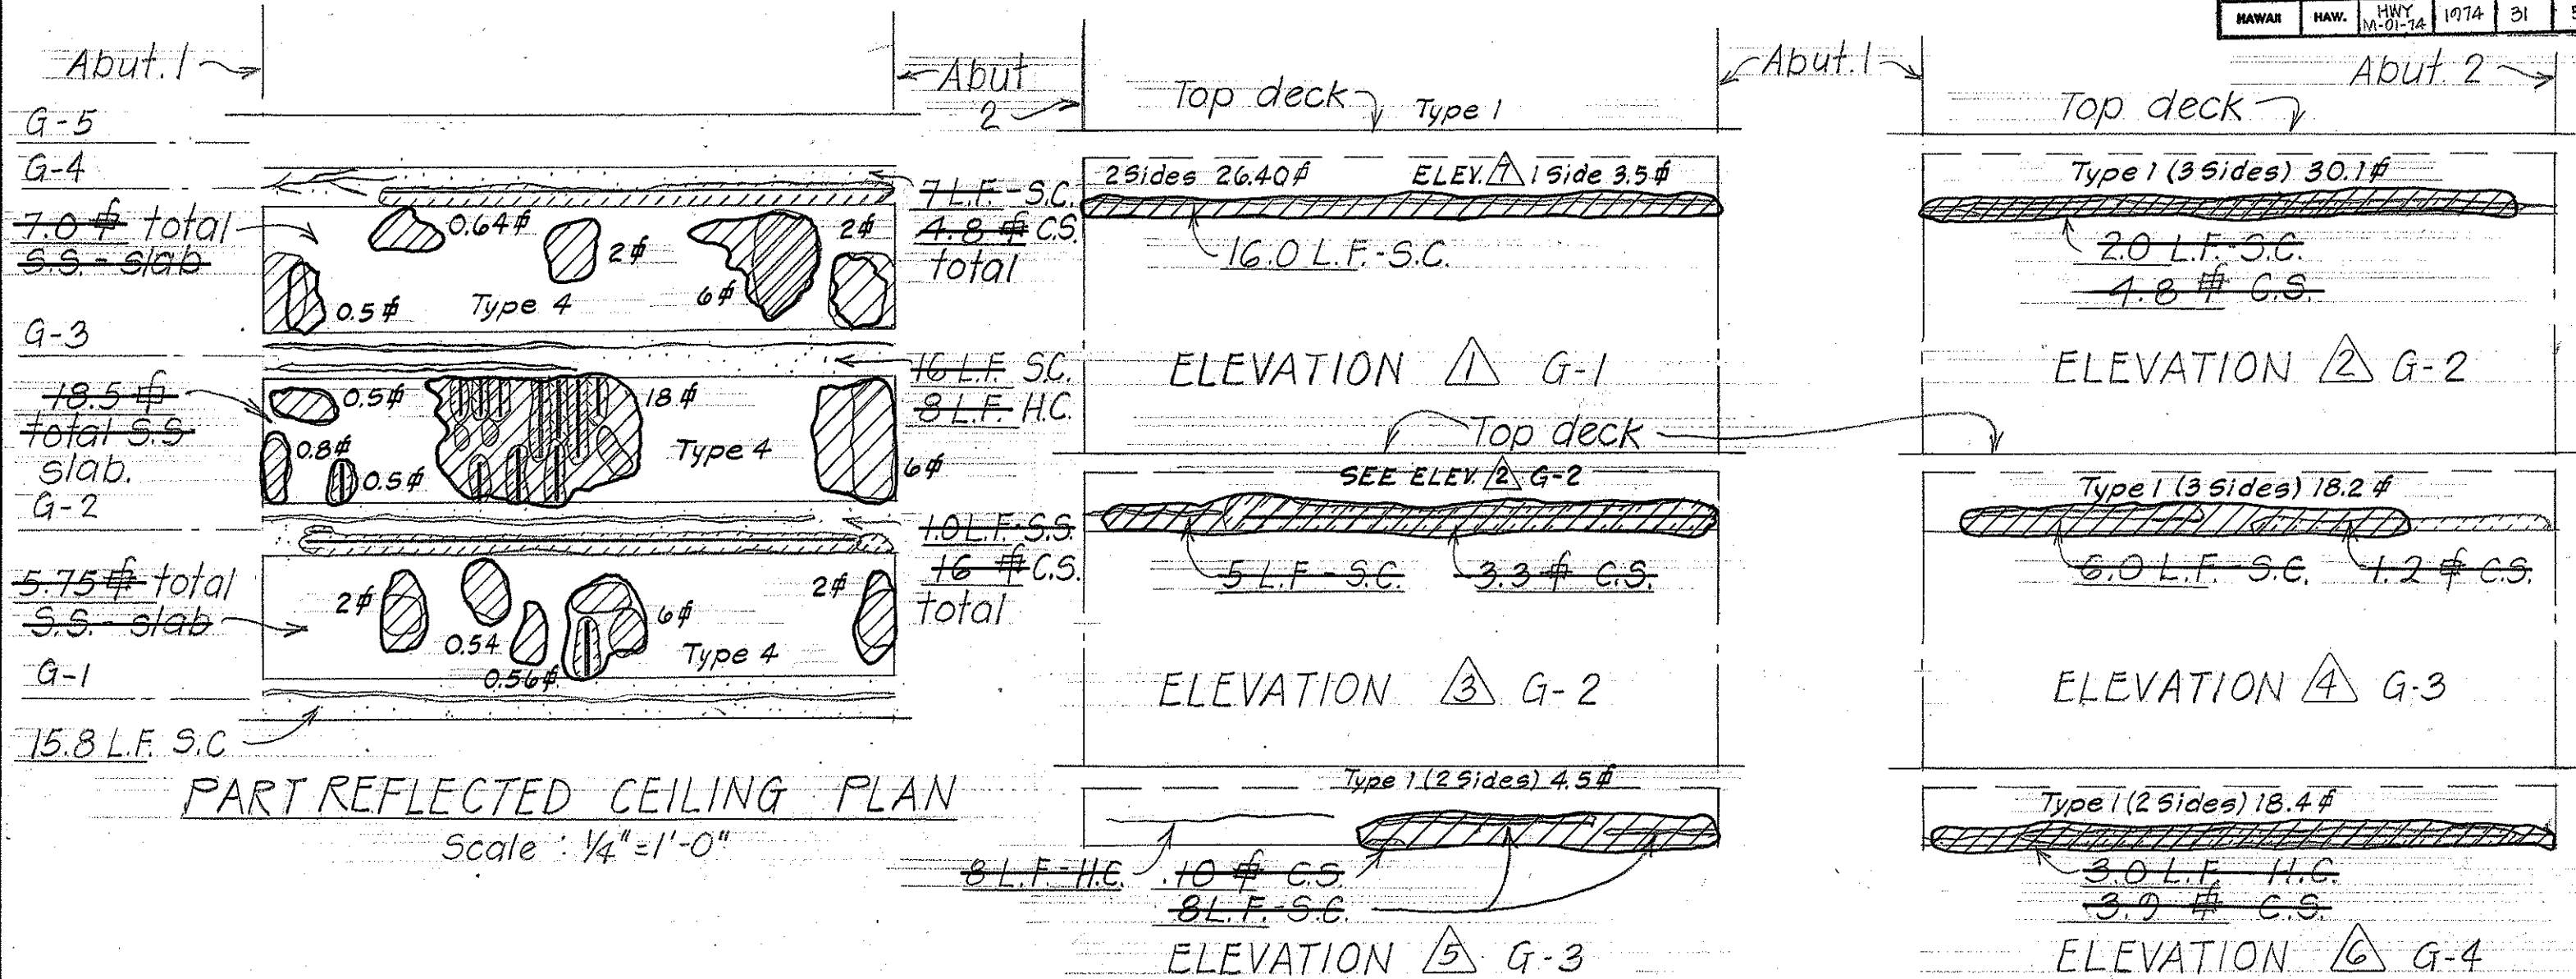

STATE OF HAWAII
DEPARTMENT OF TRANSPORTATION
HIGHWAYS DIVISION

REHABILITATION & REPAIRS
TO WAIOHUE BRIDGE

HWY-M-01-74 NOV. 1973

SHEET No. 2 OF 2 SHEETS

DESIGNED BY: J. A. [illegible]
DRAWN BY: J. A. [illegible]
CHECKED BY: J. A. [illegible]
DATE: 11/73