



FED. ROAD DIST. NO.	STATE	FED-AID PROJ. NO.	FISCAL YEAR	SHEET NO.	TOTAL SHEETS
HAWAII	HAW.	HWY M-01-74	1974	21	50

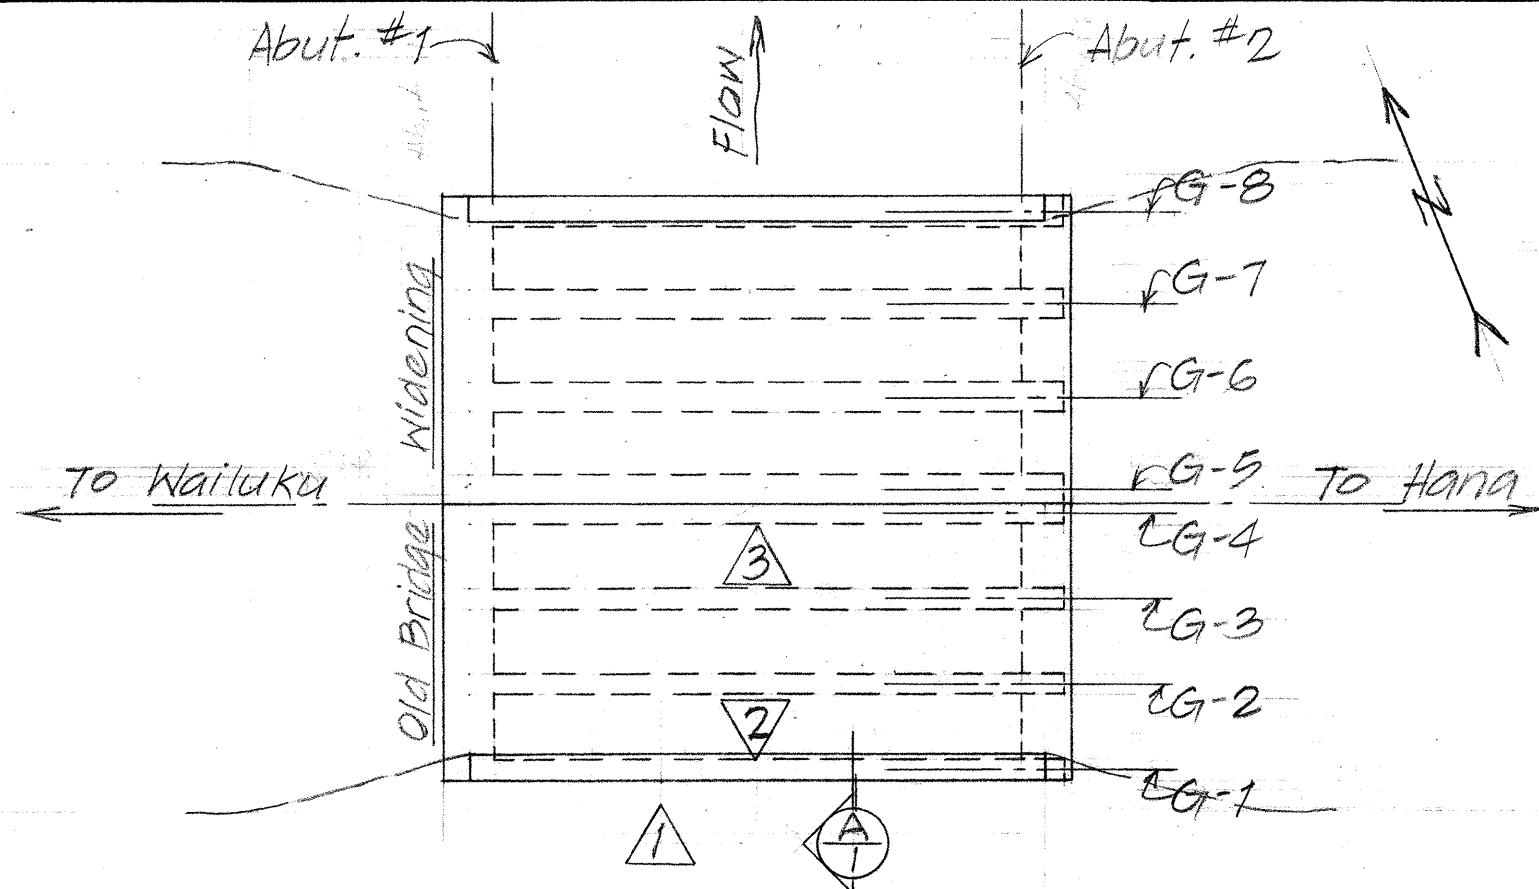


LAYOUT & FRAMING PLAN

Scale: $\frac{1}{8}'' = 1'-0''$

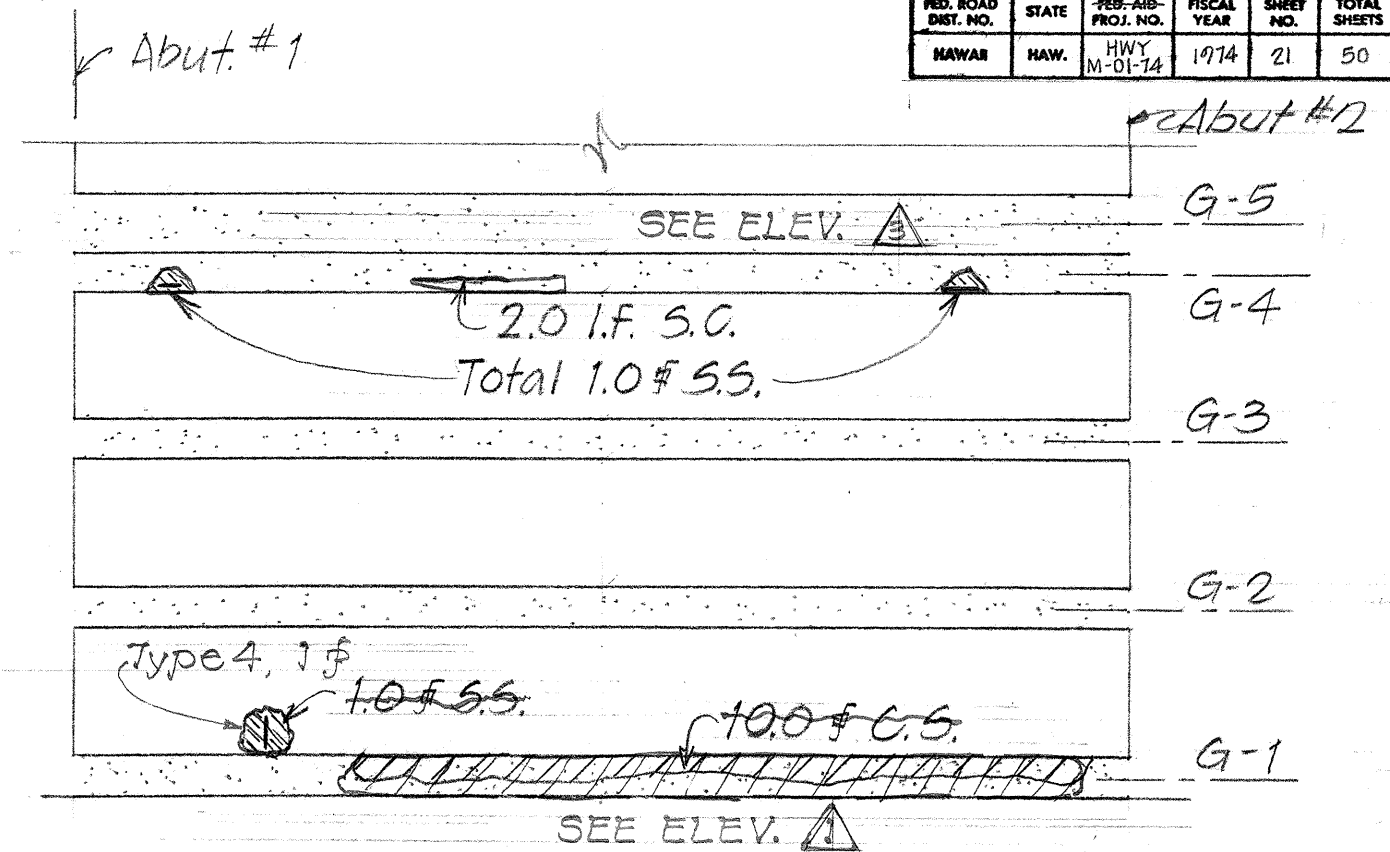


PART. REFLECTED CEILING PLAN

Scale: $\frac{1}{4}'' = 1'-0''$

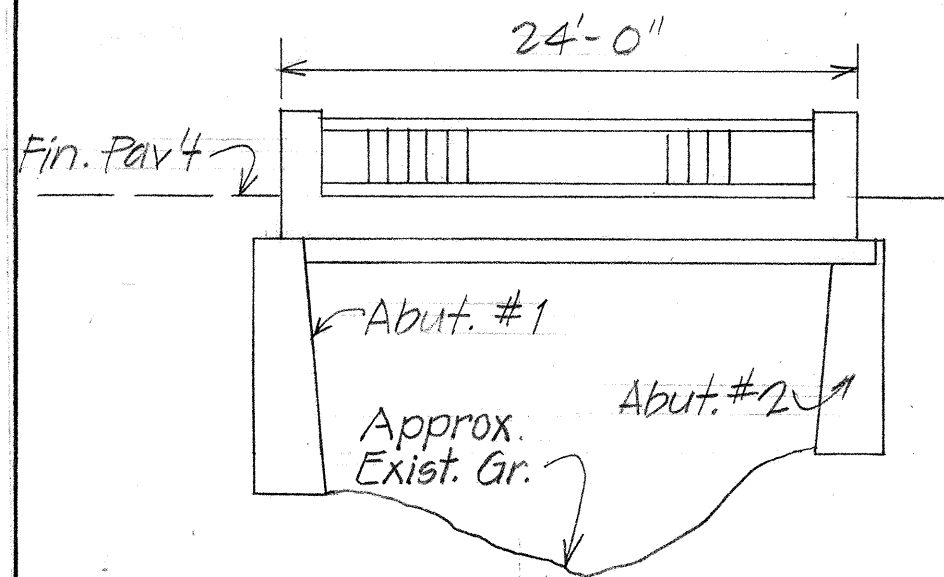


ELEVATION 1

Scale: $\frac{1}{8}'' = 1'-0''$

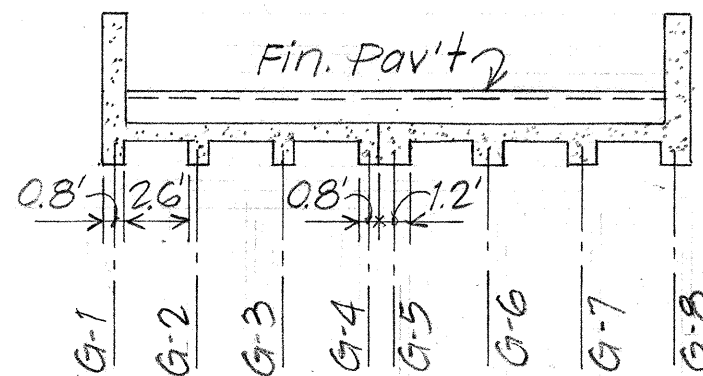

SECTION A

Scale: $\frac{1}{8}'' = 1'-0''$

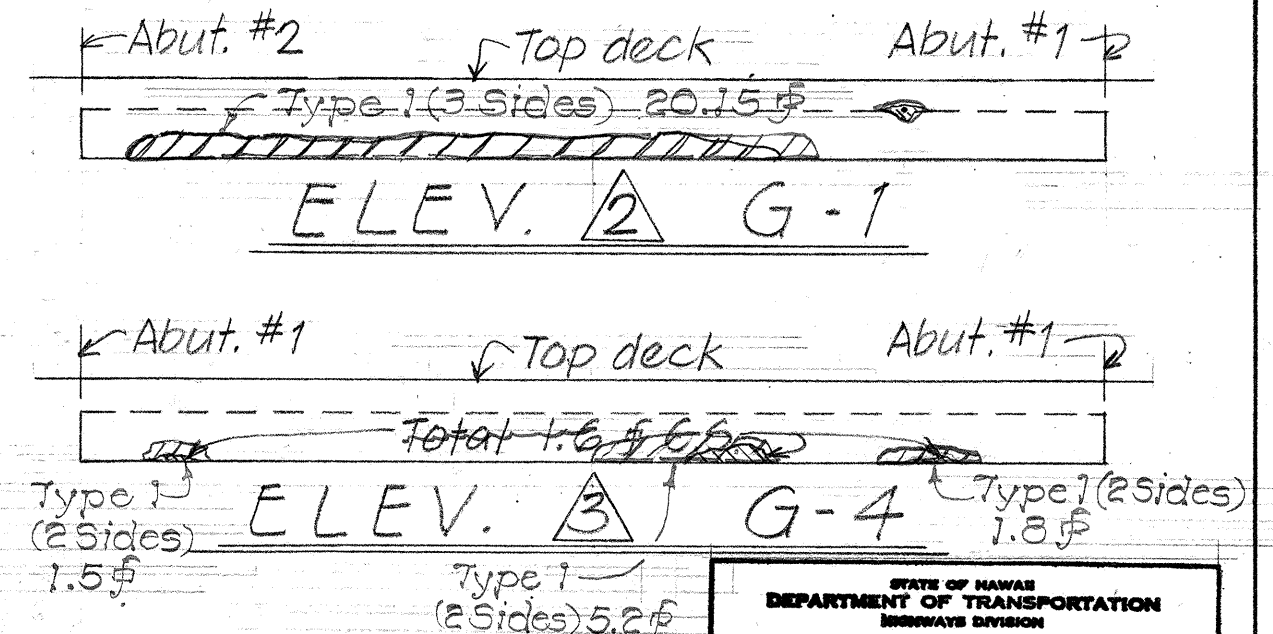

Reference Note: Refer to sheets T1 thru T4 incl. for Typical Details.

STATE OF HAWAII DEPARTMENT OF TRANSPORTATION HIGHWAYS DIVISION
REHABILITATION & REPAIRS TO WAIOKAMILO BRIDGE
PROJ. NO. HWY M-01-74 Nov. 1973

SHEET No. 1 OF 1 SHEETS