

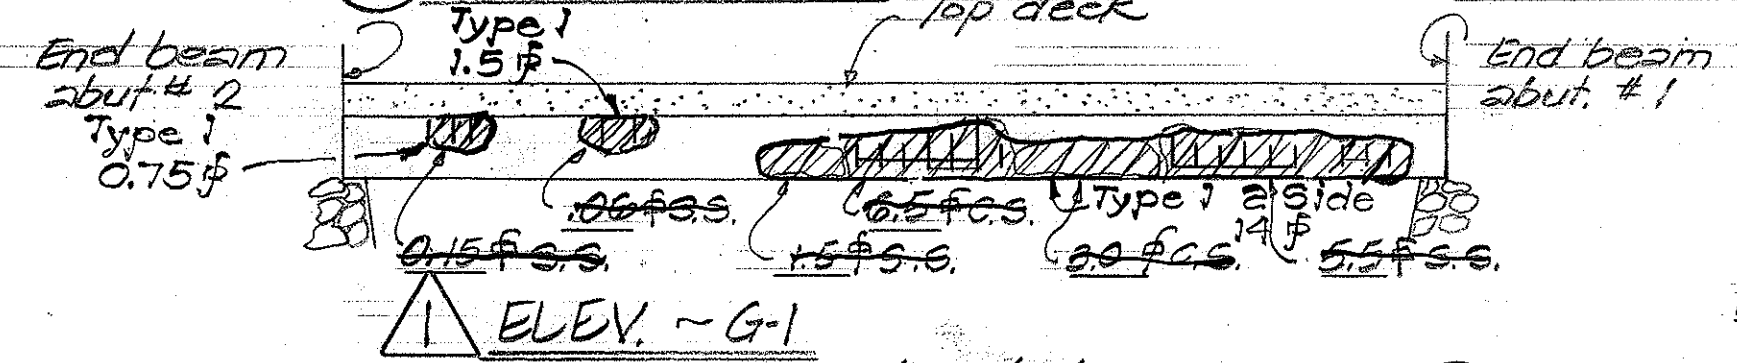
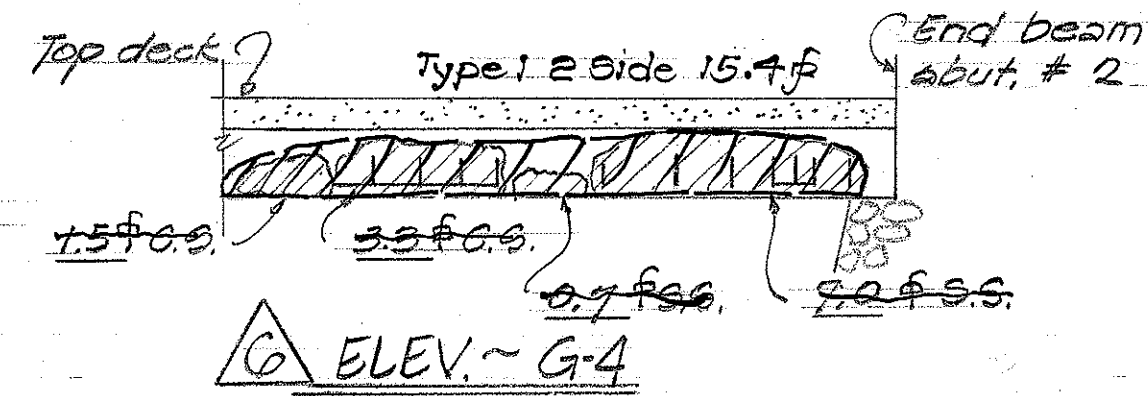
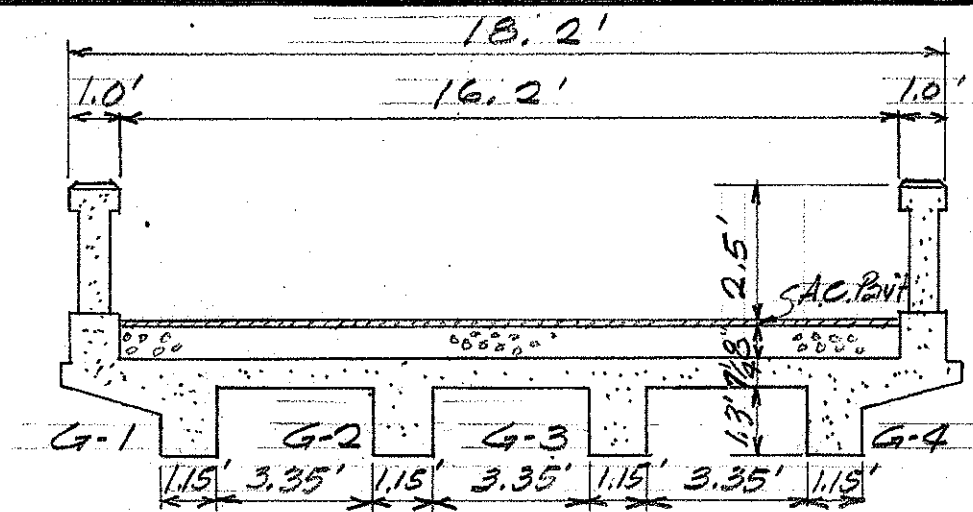
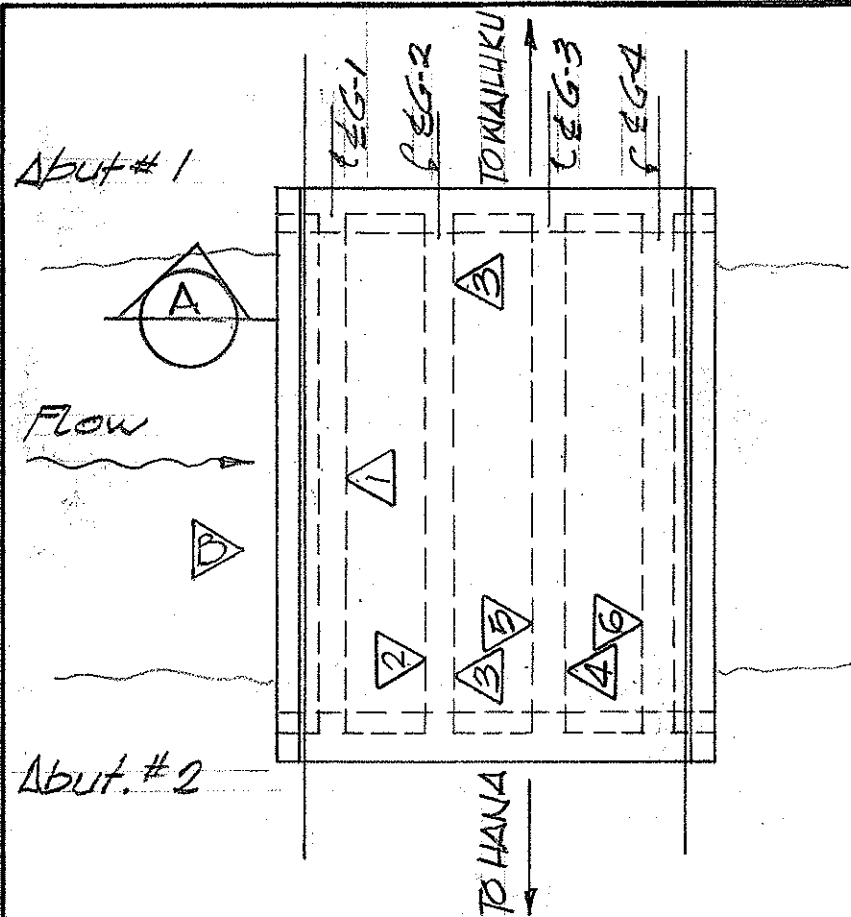
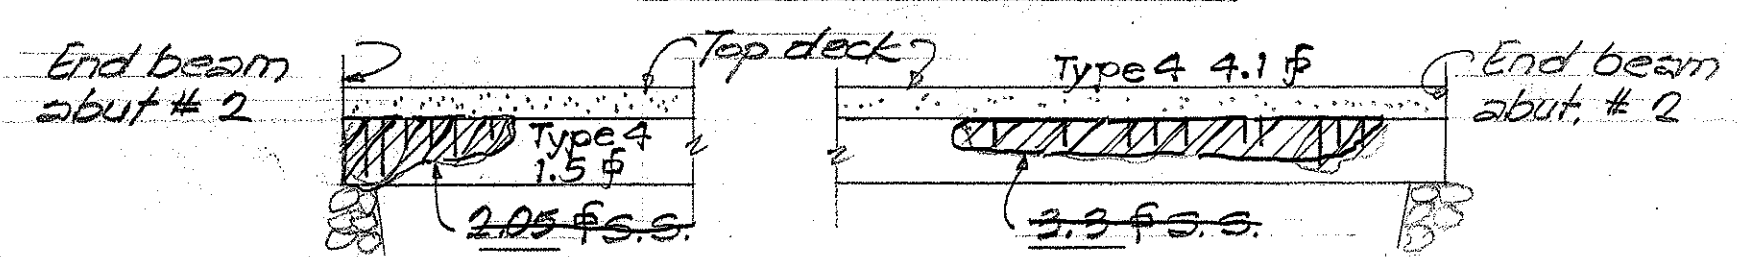
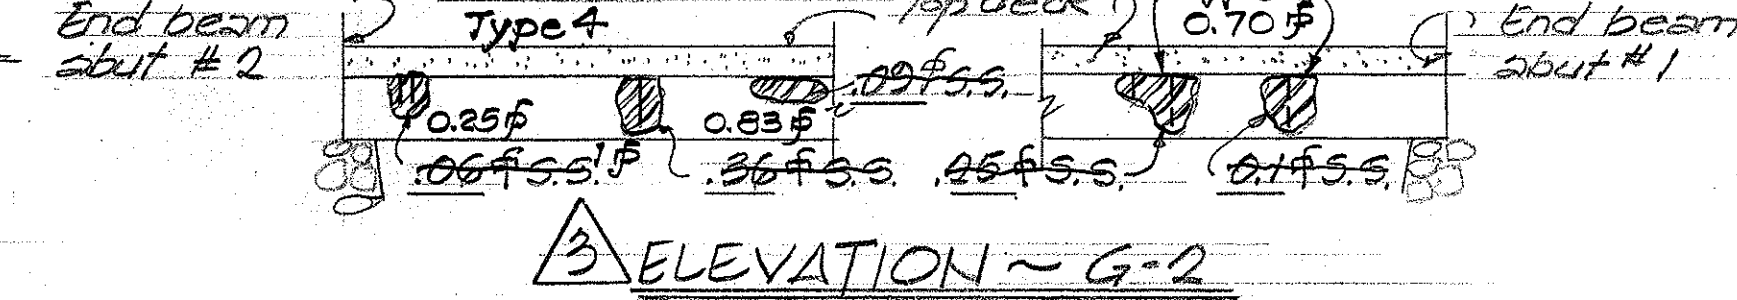


FED. ROAD DIST. NO.	STATE	FED-AID PROJ. NO.	FISCAL YEAR	SHEET NO.	TOTAL SHEETS
HAWAII	HAW.	HWY M-01-74	1974	44	50

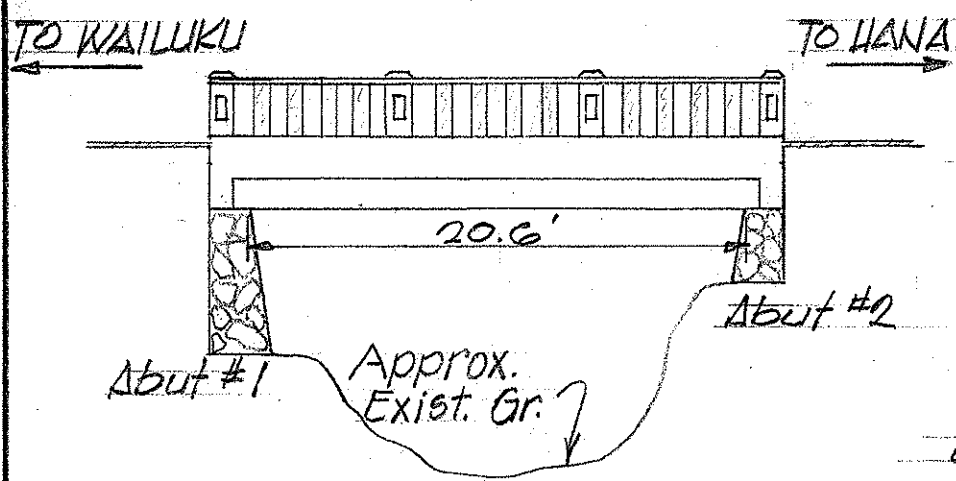

Reference Note:
Refer to Sheets T-1 thru T-4 Incl. for Typical Details.

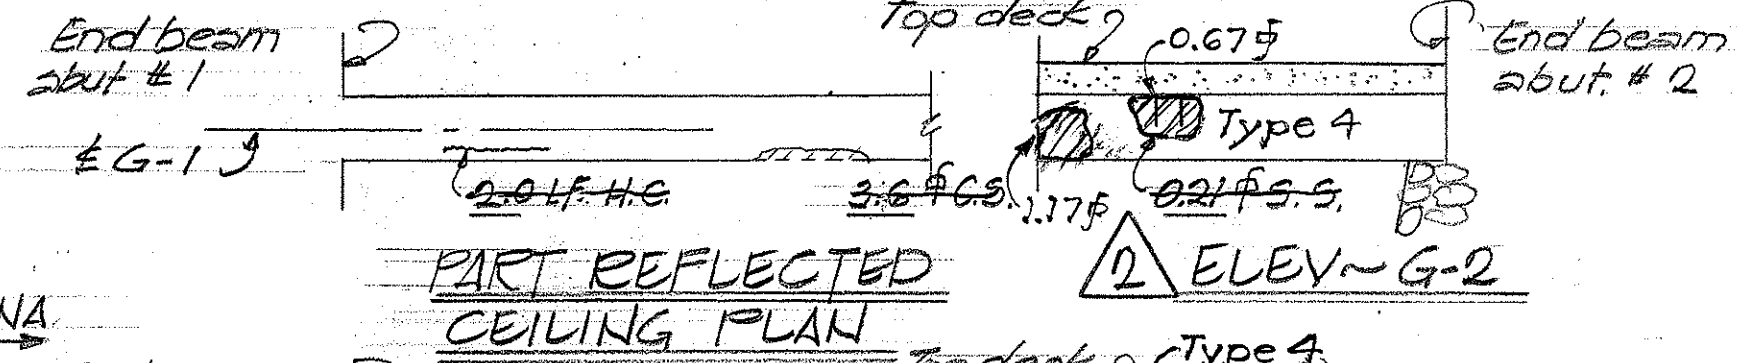

STATE OF HAWAII
DEPARTMENT OF TRANSPORTATION
HIGHWAYS DIVISION

REHABILITATION & REPAIRS
TO WAIONI BRIDGE

Proj. No. HWY M-01-74 Nov. 1973

SHEET No. 44 OF 50 SHEETS

DATE 11-22-73
DRAWN BY JY
DESIGNED BY JY
CHECKED BY JY
ORIGINAL PLAN
NOTES BOOK