
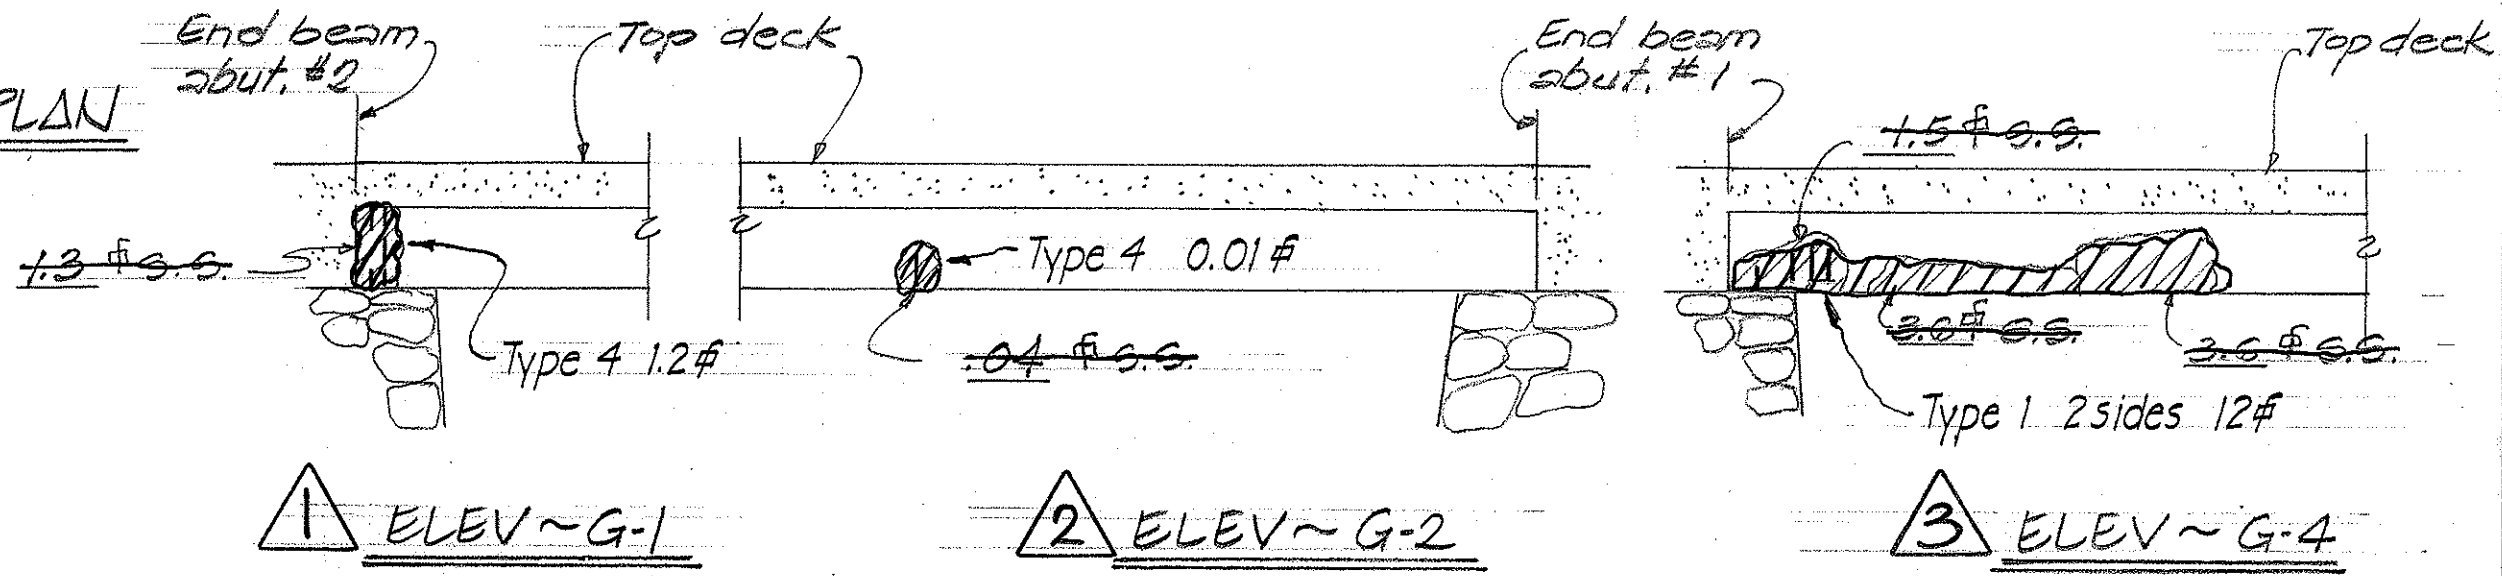
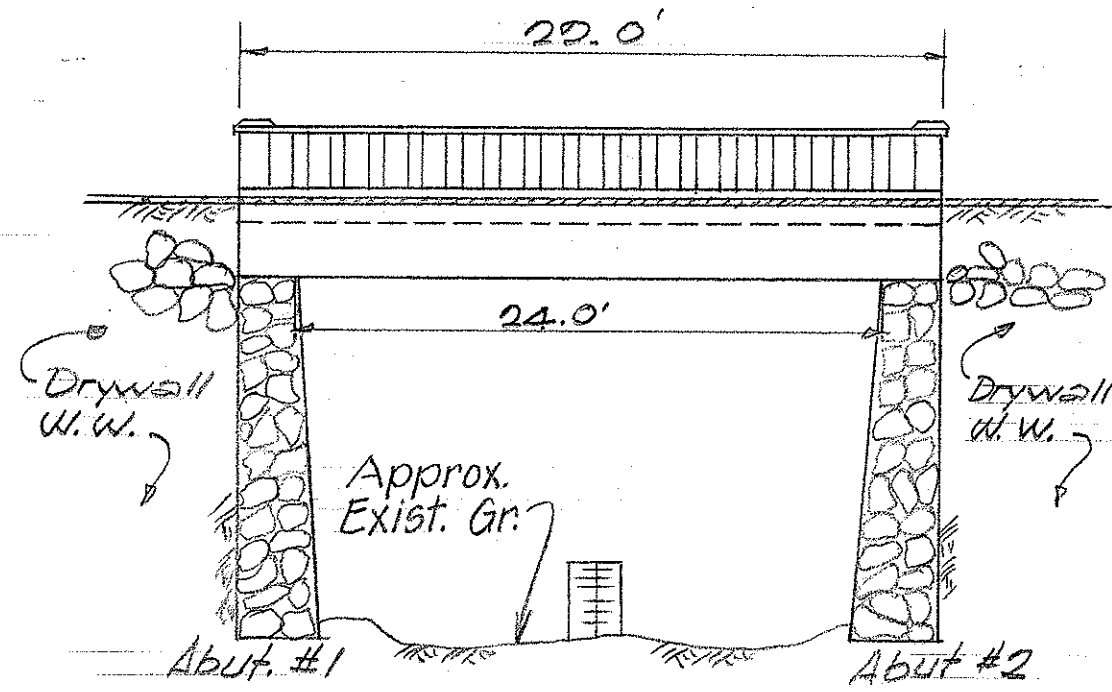
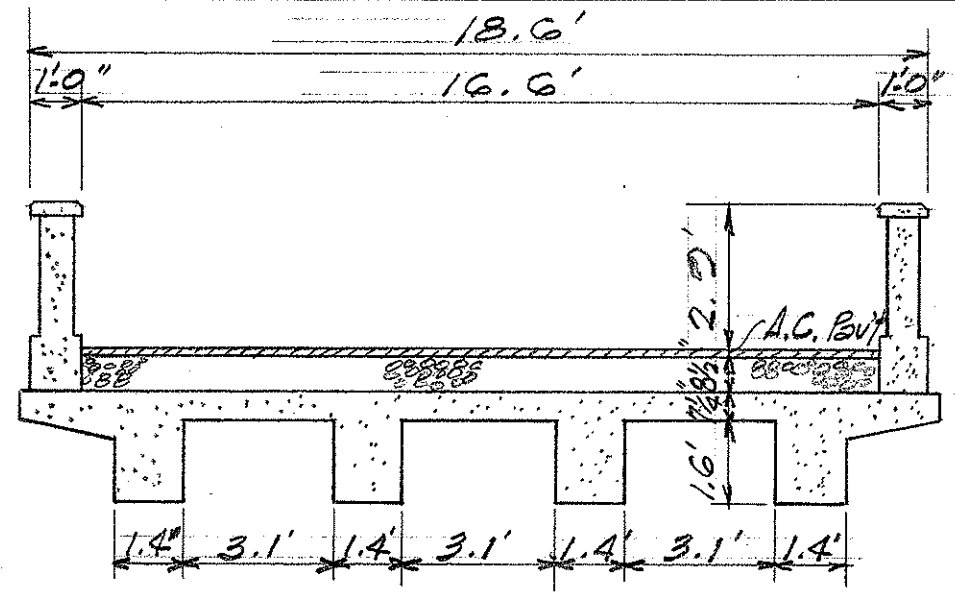


| FED. ROAD DIST. NO. | STATE | FED-AID PROJ. NO. | FISCAL YEAR | SHEET NO. | TOTAL SHEETS |
|---------------------|-------|-------------------|-------------|-----------|--------------|
| HAWAII              | HAW.  | HWY M-01-74       | 1974        | 43        | 50           |

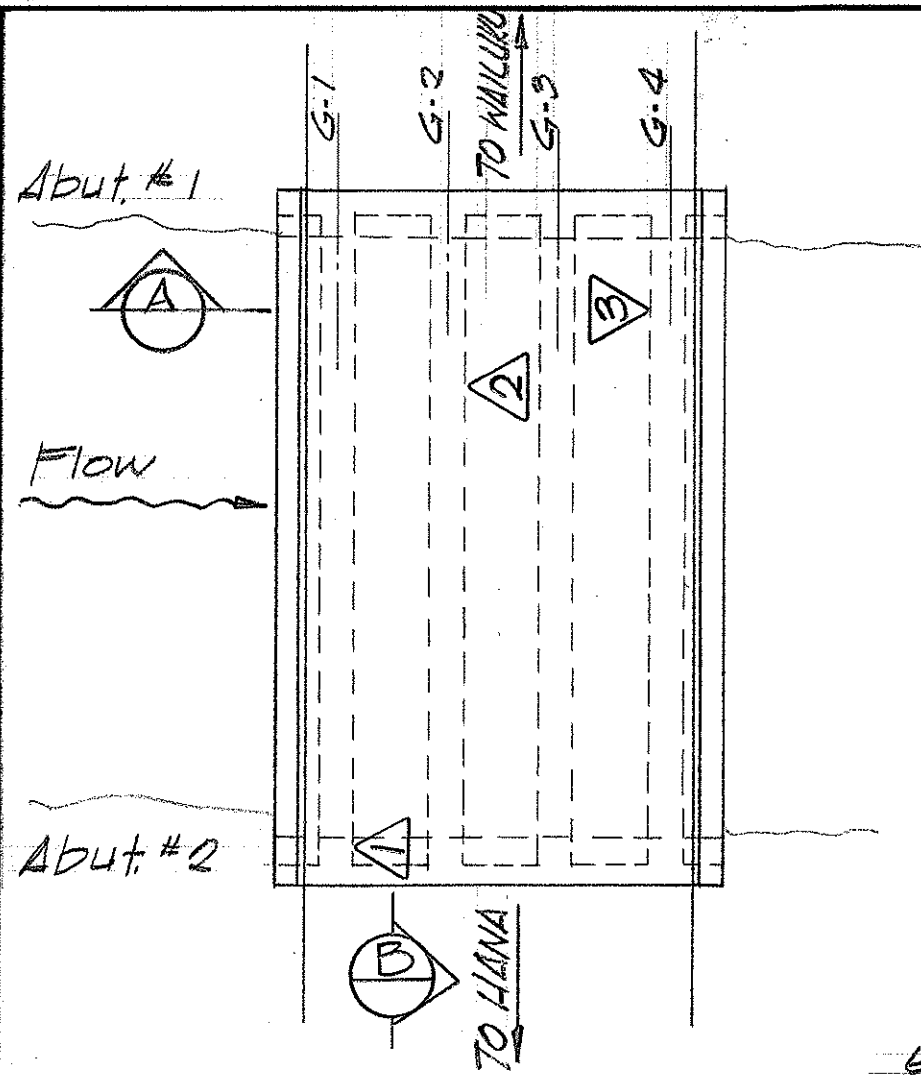

Reference Note:  
Refer to Sheets T-1 thru T-4 incl.  
for Typical Details.

STATE OF HAWAII  
DEPARTMENT OF TRANSPORTATION  
HIGHWAYS DIVISION

REHABILITATION & REPAIRS  
TO W. WAIONEI BRIDGE  
Proj. No. HWY M-01-74 Nov. 1973  
SHEET No. 43 OF 50 SHEETS

|             |      |
|-------------|------|
| DESIGNED BY | DATE |
| DRAWN BY    | 7/73 |
| CHECKED BY  |      |
| NOTED BY    |      |
| APPROVED BY |      |