



| FED. ROAD DIST. NO. | STATE | PROJ. NO. | FISCAL YEAR | SHEET NO. | TOTAL SHEETS |
|---------------------|-------|--------------|-------------|-----------|--------------|
| HAWAII | HAW. | STP-0900(52) | 1998 | 18 | 38 |

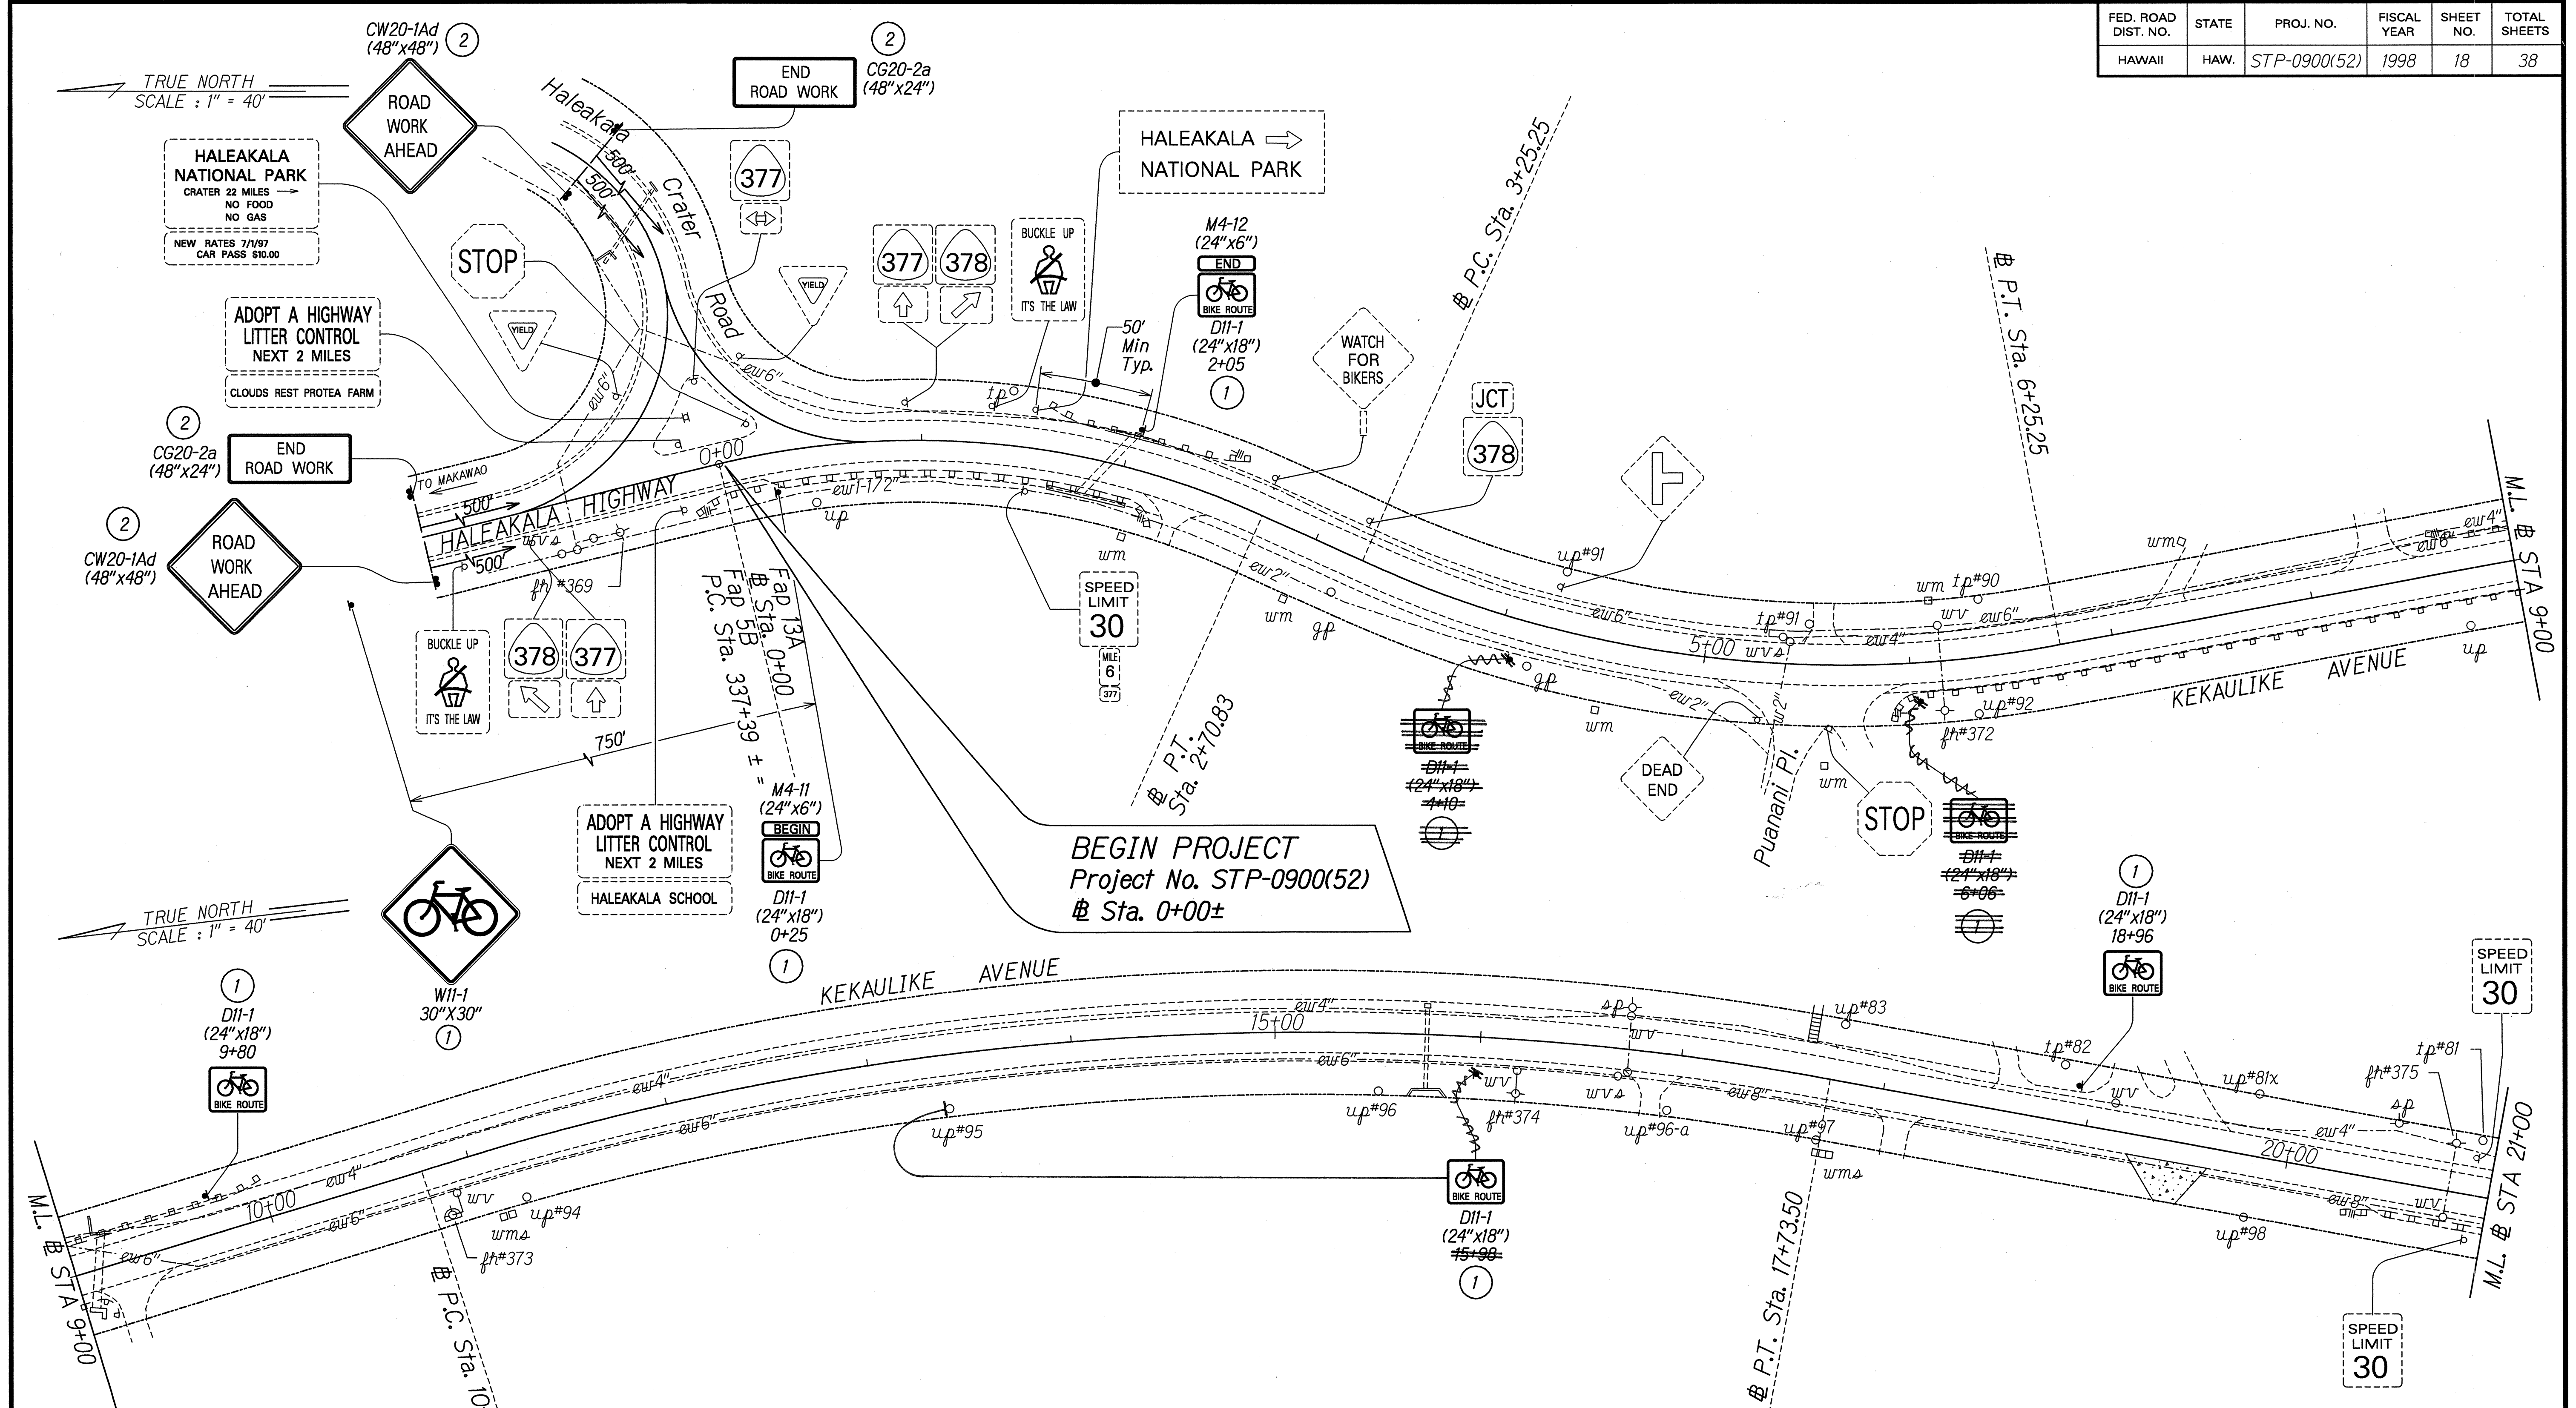

| | |
|-------------------|------|
| SURVEY PLOTTED BY | DATE |
| DESIGNED BY | |
| QUANTITIES BY | |
| CHECKED BY | |
| ORIGINAL PLAN | |
| NOTE BOOK | |
| No. | |

- KEY TO SIGNAGE:**
- ① Install New Sign (s) with Post (s).
 - ② Install Temporary Construction Sign (s) with Post (s).

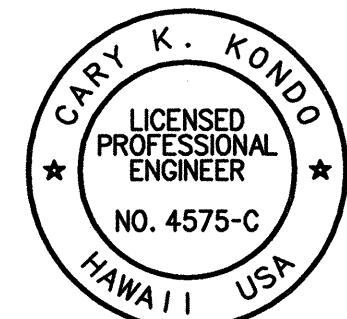

Cary K. Kondo
 THIS WORK WAS PREPARED BY ME
 OR UNDER MY SUPERVISION

STATE OF HAWAII
 DEPARTMENT OF TRANSPORTATION
 HIGHWAYS DIVISION


SIGNING PLAN
KEKAULIKE AVENUE
BIKEWAY IMPROVEMENTS,
KULA HIGHWAY TO HALEAKALA HIGHWAY
 Federal Aid Project No. STP-0900(52)

Scale: AS NOTED Date: DEC. 1997

SHEET No. 1 OF 8 SHEETS

"AS-BUILT"

| FED. ROAD DIST. NO. | STATE | PROJ. NO. | FISCAL YEAR | SHEET NO. | TOTAL SHEETS |
|---------------------|-------|--------------|-------------|-----------|--------------|
| HAWAII | HAW. | STP-0900(52) | 1998 | 19 | 38 |

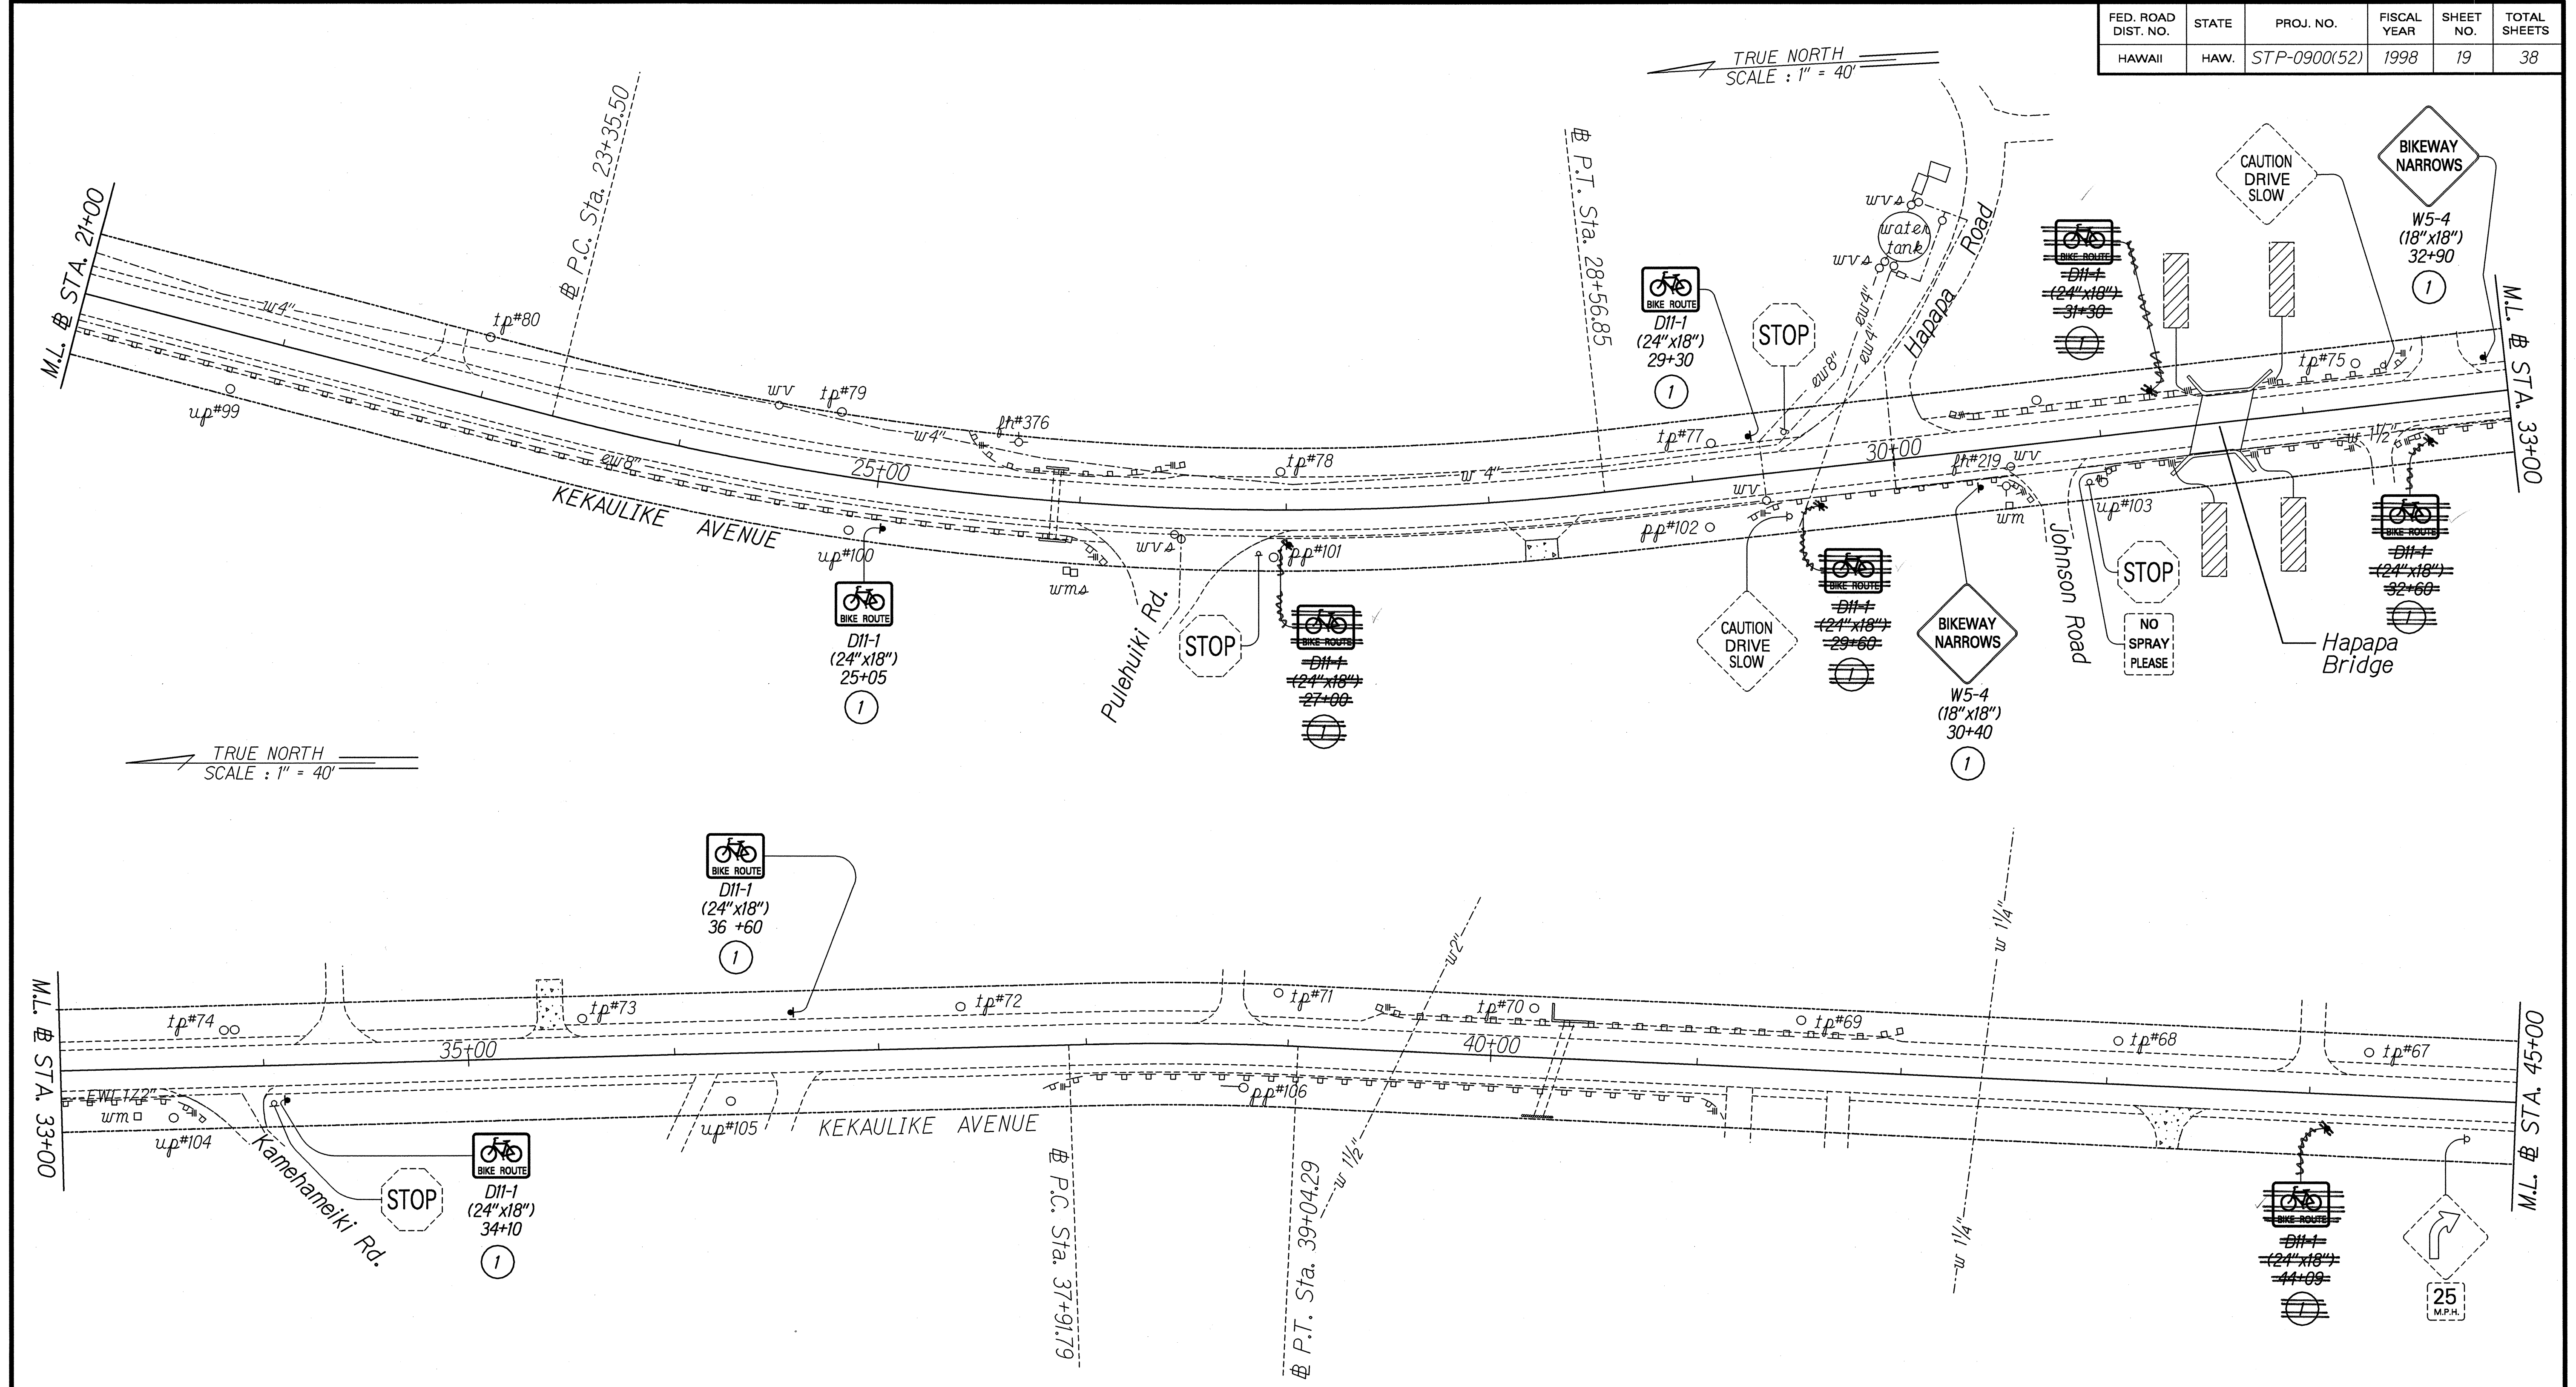

TRUE NORTH
SCALE : 1" = 40'

TRUE NORTH
SCALE : 1" = 40'

| | |
|-------------------|------|
| ORIGINAL PLAN | DATE |
| SURVEY PLOTTED BY | |
| DESIGNED BY | |
| QUANTITIES BY | |
| CHECKED BY | |

- KEY TO SIGNAGE:
- ① Install New Sign (s) with Post (s).
 - ② Install Temporary Construction Sign (s) with Post (s).



Cary K. Kondo
THIS WORK WAS PREPARED BY ME
OR UNDER MY SUPERVISION

STATE OF HAWAII
DEPARTMENT OF TRANSPORTATION
HIGHWAYS DIVISION


SIGNING PLAN
KEKAULIKE AVENUE
BIKEWAY IMPROVEMENTS,
KULA HIGHWAY TO HALEAKALA HIGHWAY
Federal Aid Project No. STP-0900(52)

Scale: AS NOTED Date: DEC. 1997

SHEET No. 2 OF 8 SHEETS


"AS-BUILT"

| FED. ROAD DIST. NO. | STATE | PROJ. NO. | FISCAL YEAR | SHEET NO. | TOTAL SHEETS |
|---------------------|-------|--------------|-------------|-----------|--------------|
| HAWAII | HAW. | STP-0900(52) | 1998 | 20 | 38 |

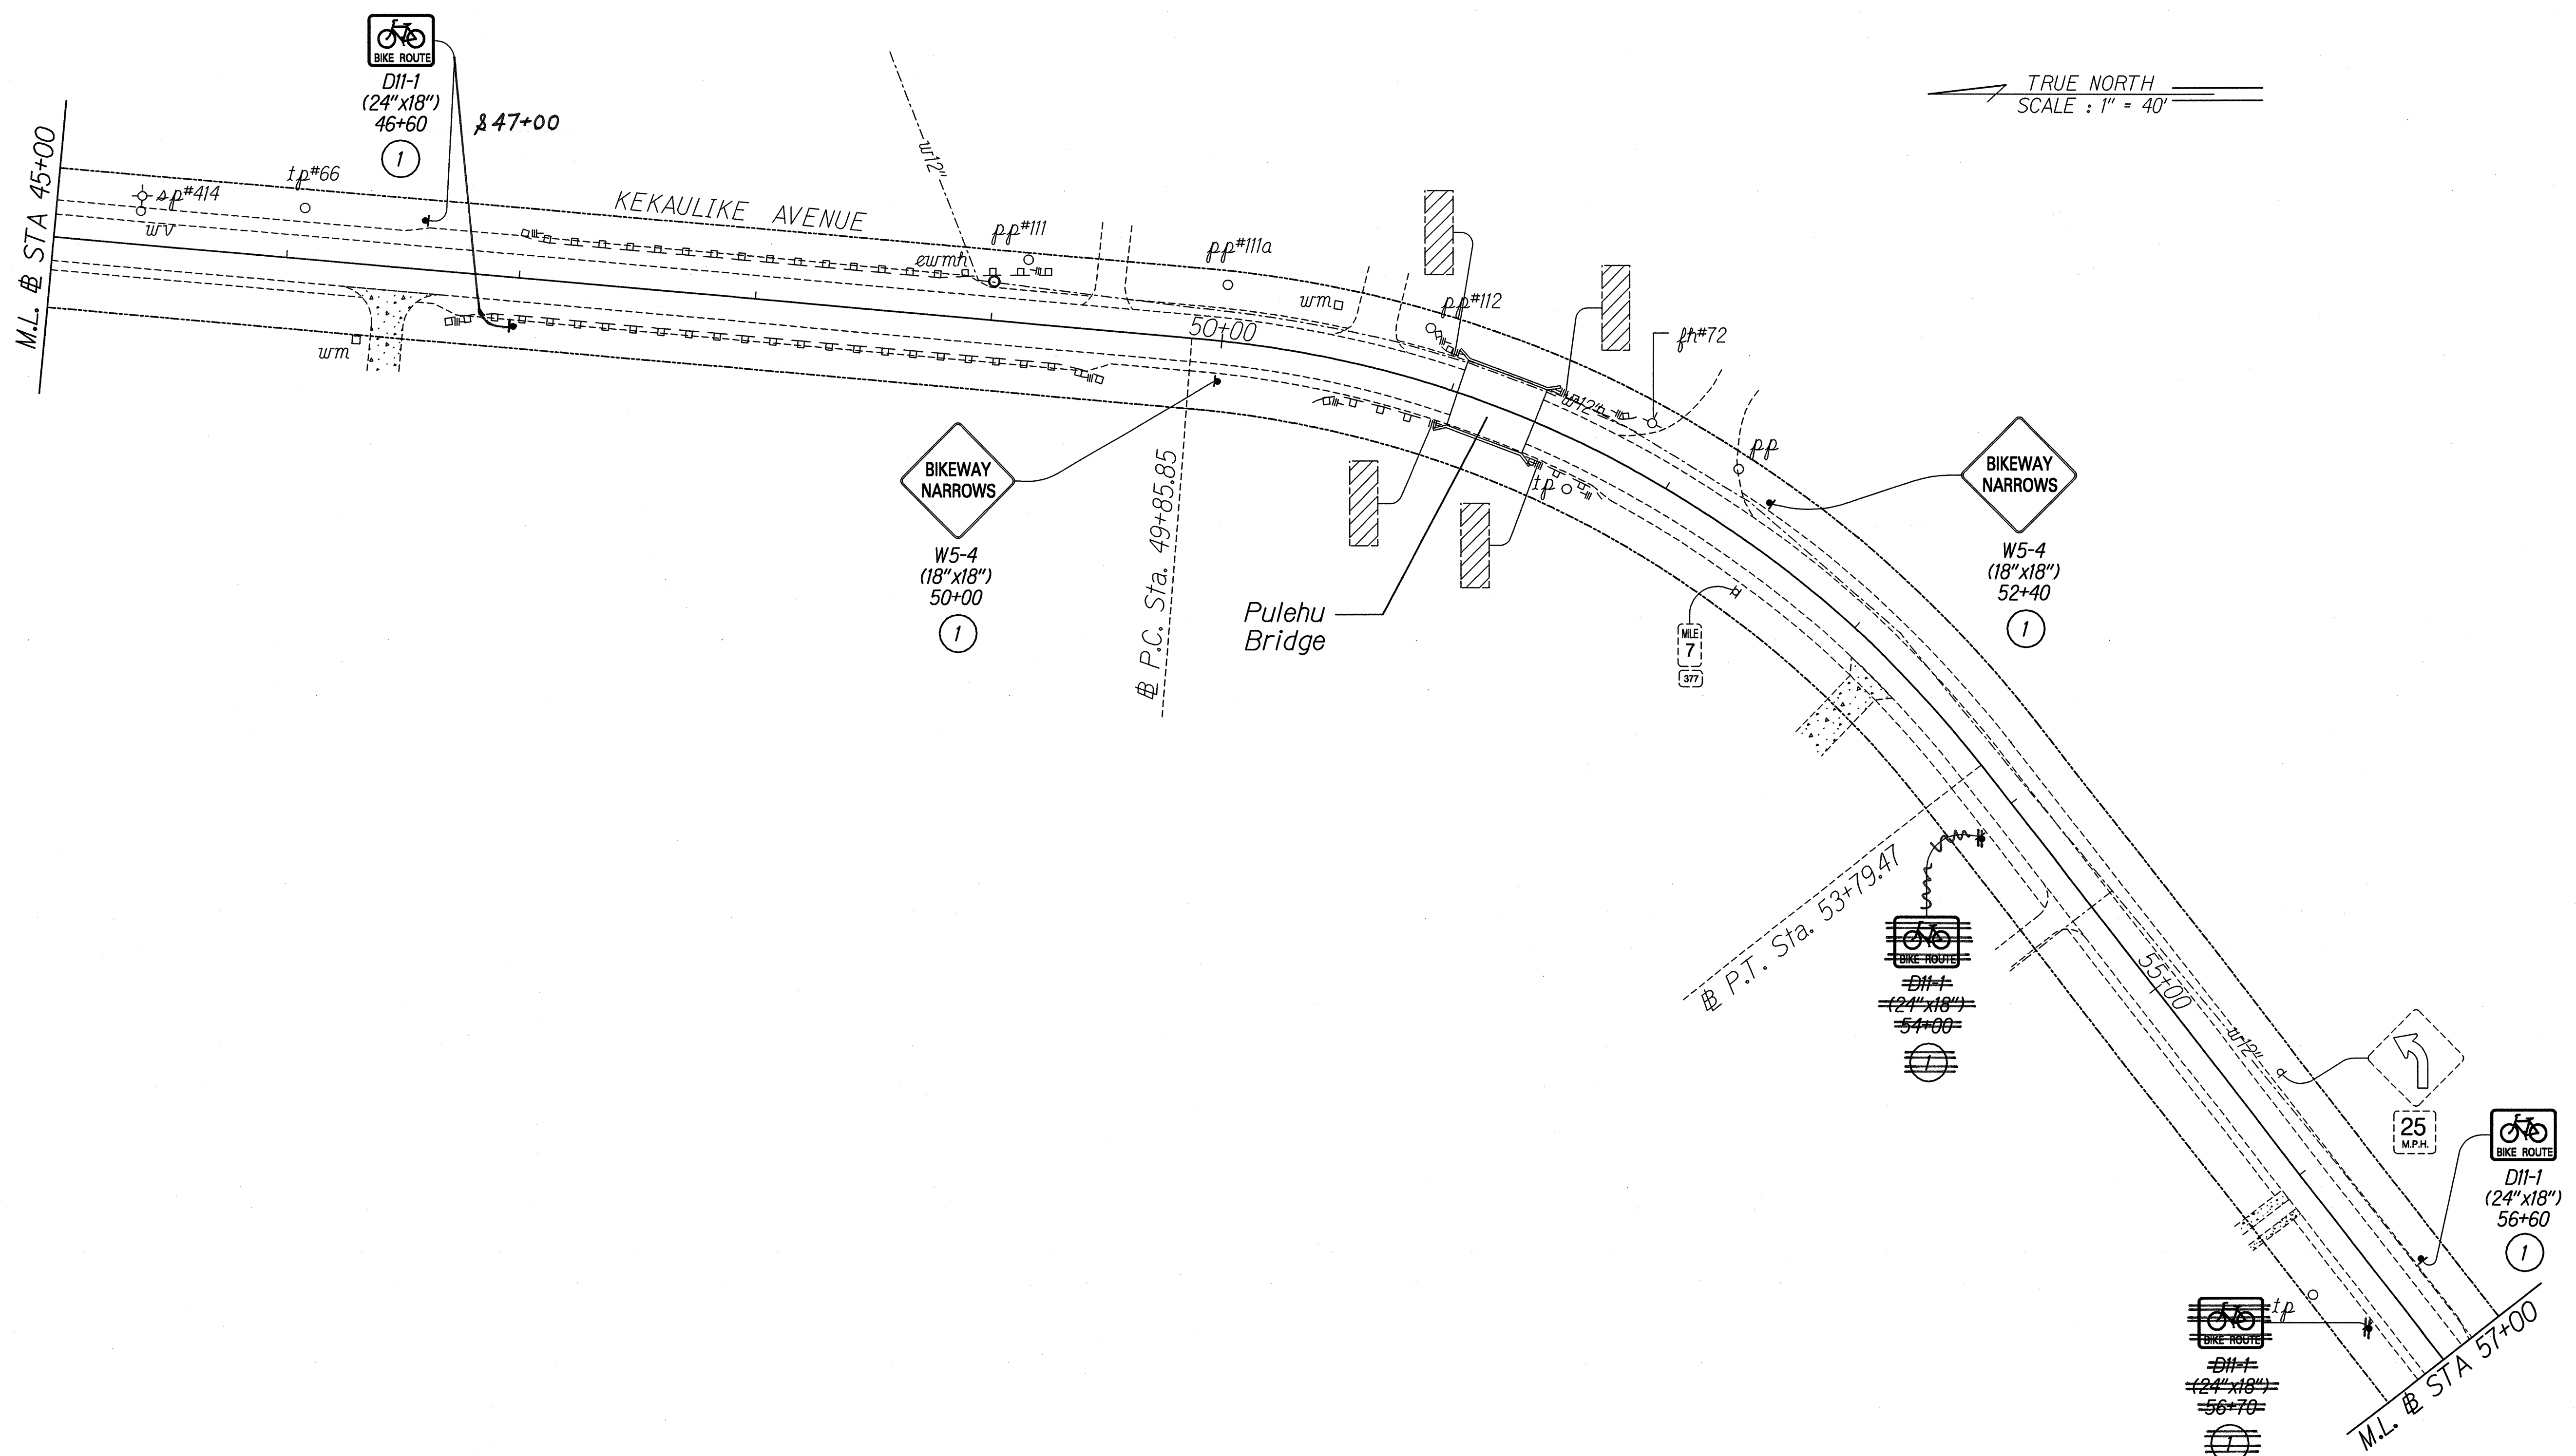

| | |
|-------------------|------|
| SURVEY PLOTTED BY | DATE |
| DESIGNED BY | |
| QUANTITIES BY | |
| CHECKED BY | |

- KEY TO SIGNAGE:**
- ① Install New Sign (s) with Post (s).
 - ② Install Temporary Construction Sign (s) with Post (s).

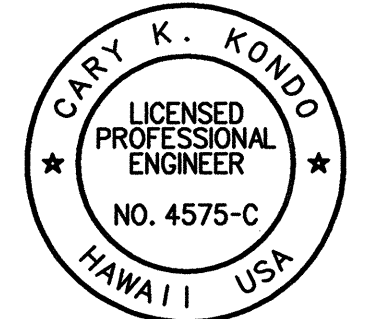


Cary K. Kondo
THIS WORK WAS PREPARED BY ME
OR UNDER MY SUPERVISION

STATE OF HAWAII
DEPARTMENT OF TRANSPORTATION
HIGHWAYS DIVISION

SIGNING PLAN
KEKAULIKE AVENUE
BIKEWAY IMPROVEMENTS,
KULA HIGHWAY TO HALEAKALA HIGHWAY
Federal Aid Project No. STP-0900(52)


Scale: AS NOTED Date: DEC. 1997

| FED. ROAD DIST. NO. | STATE | PROJ. NO. | FISCAL YEAR | SHEET NO. | TOTAL SHEETS |
|---------------------|-------|--------------|-------------|-----------|--------------|
| HAWAII | HAW. | STP-0900(52) | 1998 | 21 | 38 |

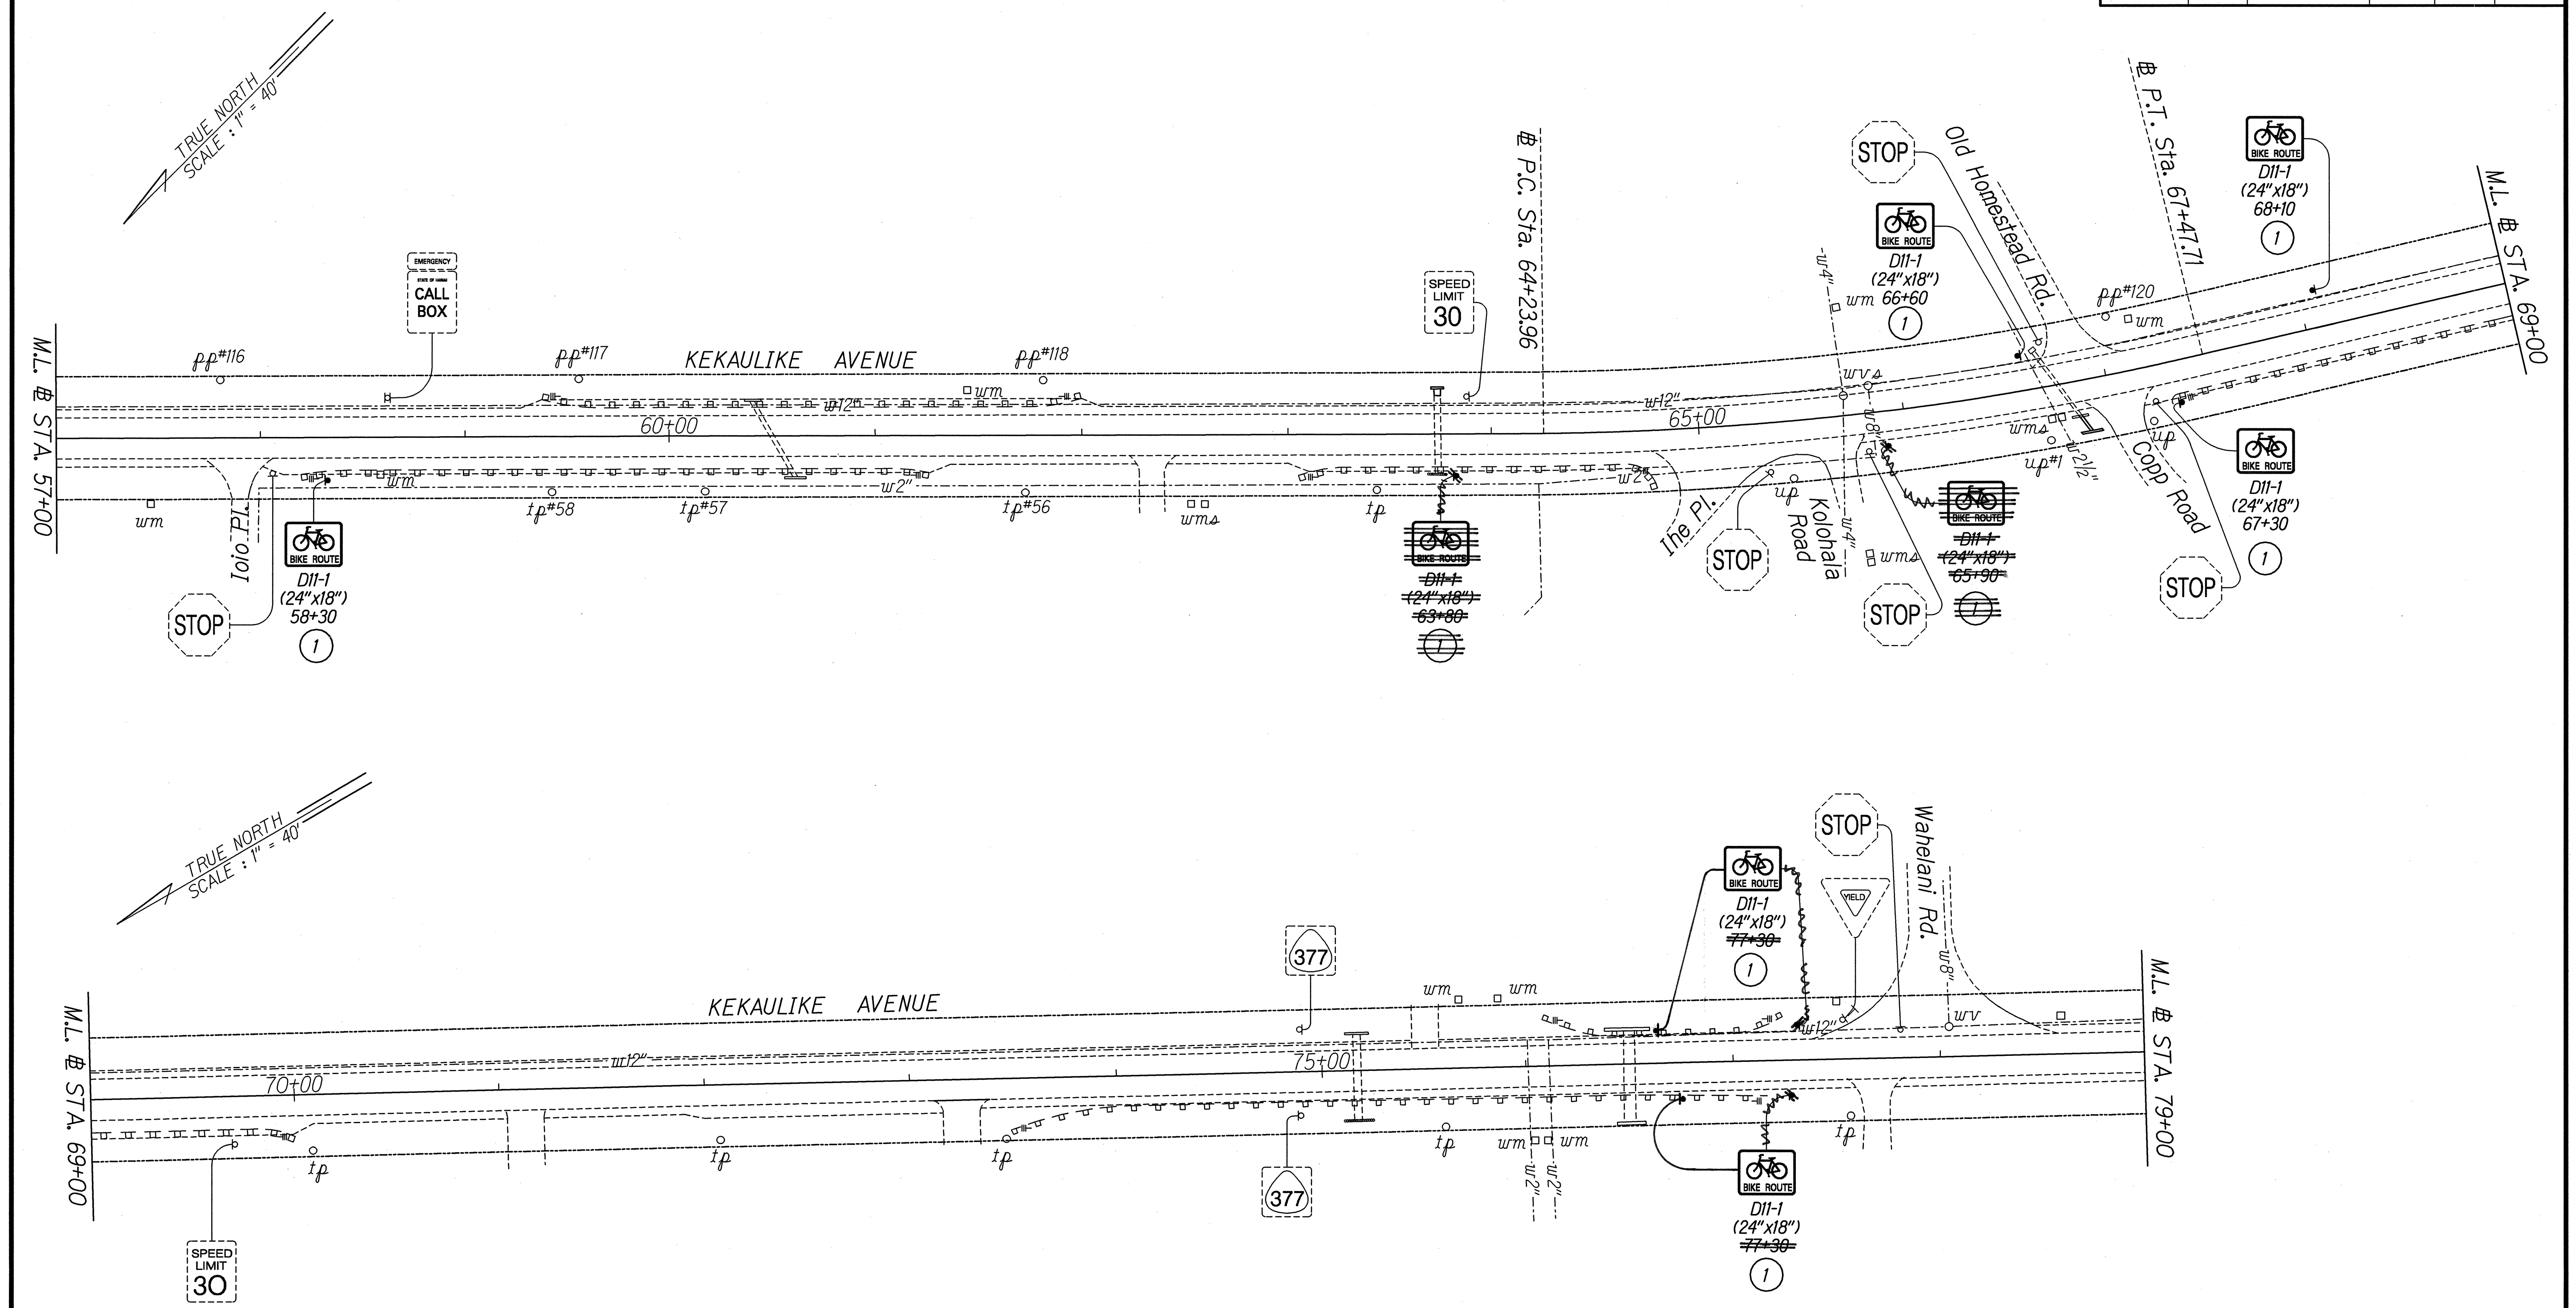

| | |
|-------------------|-------|
| DATE | _____ |
| SURVEY PLOTTED BY | _____ |
| TRACED BY | _____ |
| DESIGNED BY | _____ |
| QUANTITIES BY | _____ |
| CHECKED BY | _____ |
| ORIGINAL PLAN | _____ |
| NOTE BOOK | _____ |
| No. | _____ |

- KEY TO SIGNAGE:**
- ① Install New Sign (s) with Post (s).
 - ② Install Temporary Construction Sign (s) with Post (s).

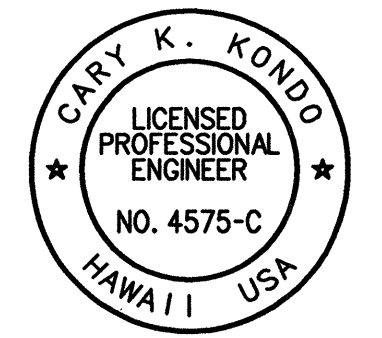

Cary K. Kondo
THIS WORK WAS PREPARED BY ME
OR UNDER MY SUPERVISION

STATE OF HAWAII
DEPARTMENT OF TRANSPORTATION
HIGHWAYS DIVISION

SIGNING PLAN
KEKAULIKE AVENUE
BIKEWAY IMPROVEMENTS,
KULA HIGHWAY TO HALEAKALA HIGHWAY
Federal Aid Project No. STP-0900(52)

Scale: AS NOTED Date: DEC. 1997


SHEET No. 4 OF 8 SHEETS

"AS-BUILT"

| FED. ROAD DIST. NO. | STATE | PROJ. NO. | FISCAL YEAR | SHEET NO. | TOTAL SHEETS |
|---------------------|-------|--------------|-------------|-----------|--------------|
| HAWAII | HAW. | STP-0900(52) | 1998 | 22 | 38 |


TRUE NORTH
SCALE: 1" = 40'

TRUE NORTH
SCALE: 1" = 40'

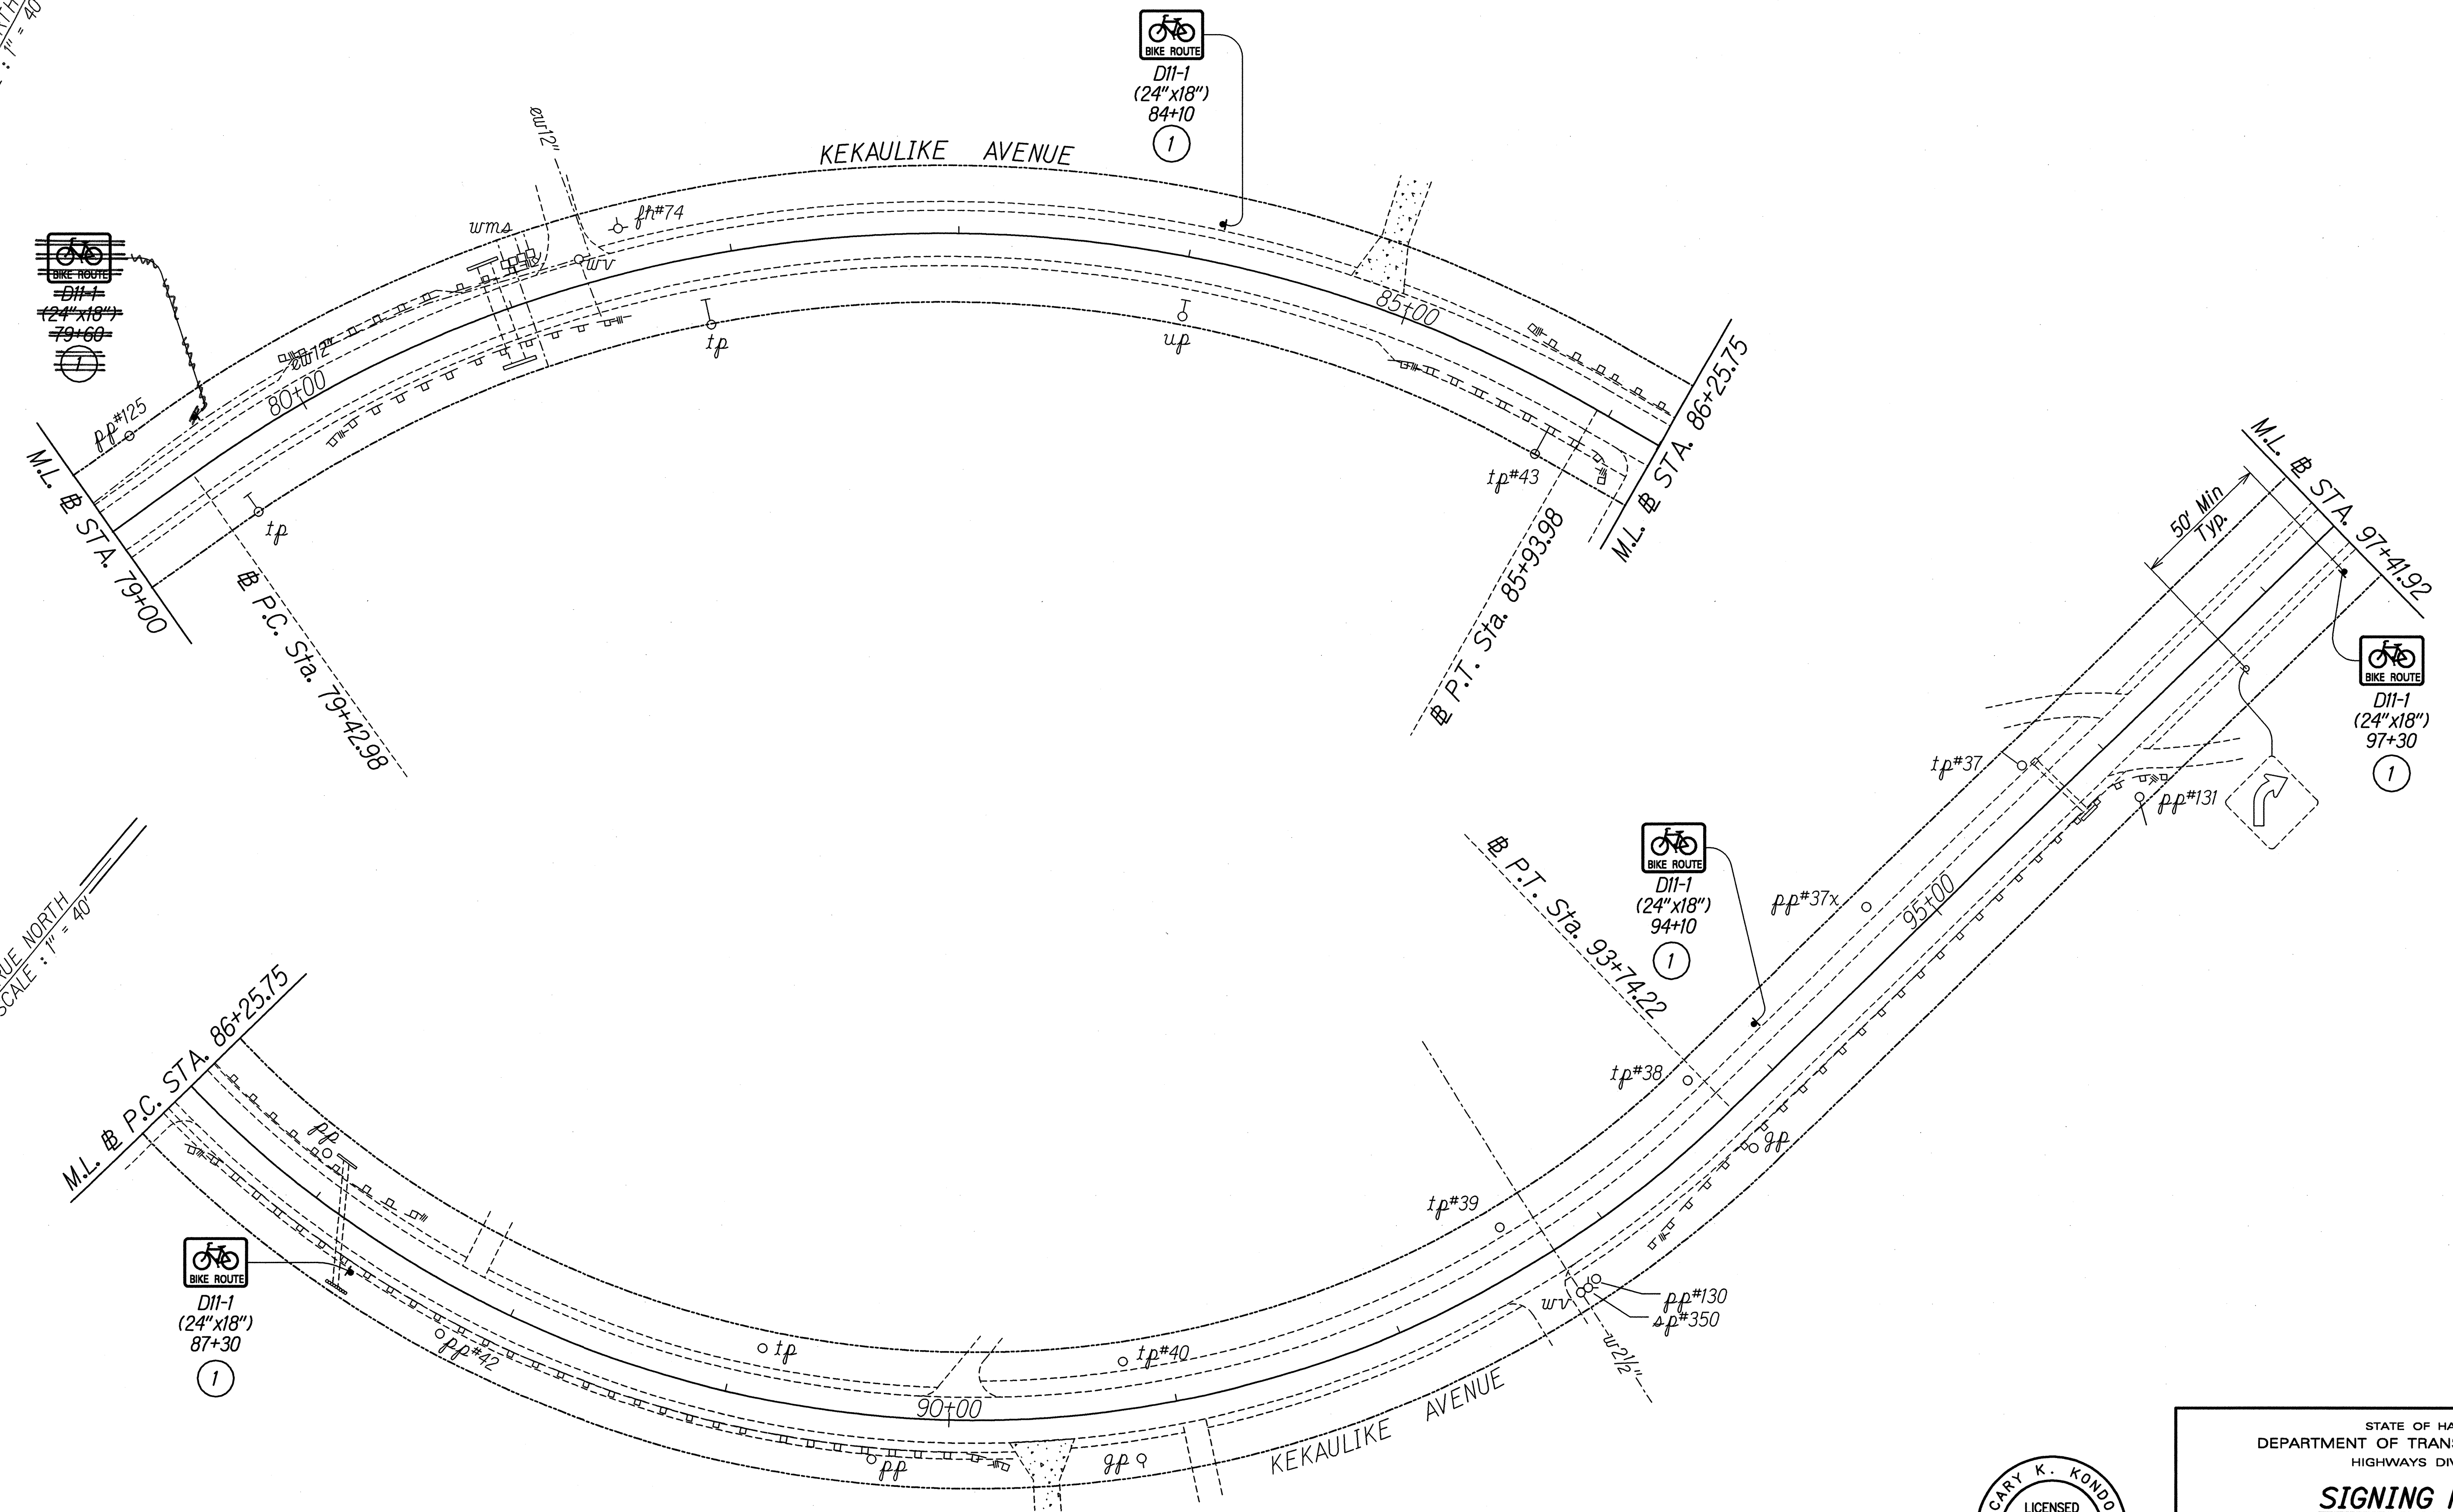

| | |
|-------------------|------|
| ORIGINAL PLAN | DATE |
| SURVEY PLOTTED BY | |
| DRAWN BY | |
| DESIGNED BY | |
| QUANTITIES BY | |
| CHECKED BY | |

- KEY TO SIGNAGE:**
- ① Install New Sign (s) with Post (s).
 - ② Install Temporary Construction Sign (s) with Post (s).

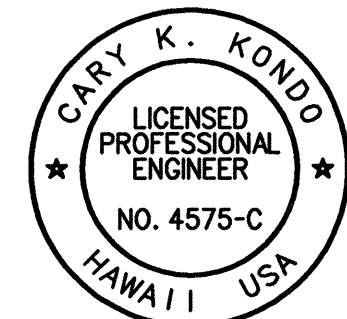

Cary K. Kondo
THIS WORK WAS PREPARED BY ME
OR UNDER MY SUPERVISION


STATE OF HAWAII
DEPARTMENT OF TRANSPORTATION
HIGHWAYS DIVISION

SIGNING PLAN
KEKAULIKE AVENUE
BIKEWAY IMPROVEMENTS,
KULA HIGHWAY TO HALEAKALA HIGHWAY
Federal Aid Project No. STP-0900(52)

Scale: AS NOTED Date: DEC. 1997

"AS-BUILT"

| FED. ROAD DIST. NO. | STATE | PROJ. NO. | FISCAL YEAR | SHEET NO. | TOTAL SHEETS |
|---------------------|-------|--------------|-------------|-----------|--------------|
| HAWAII | HAW. | STP-0900(52) | 1998 | 23 | 38 |

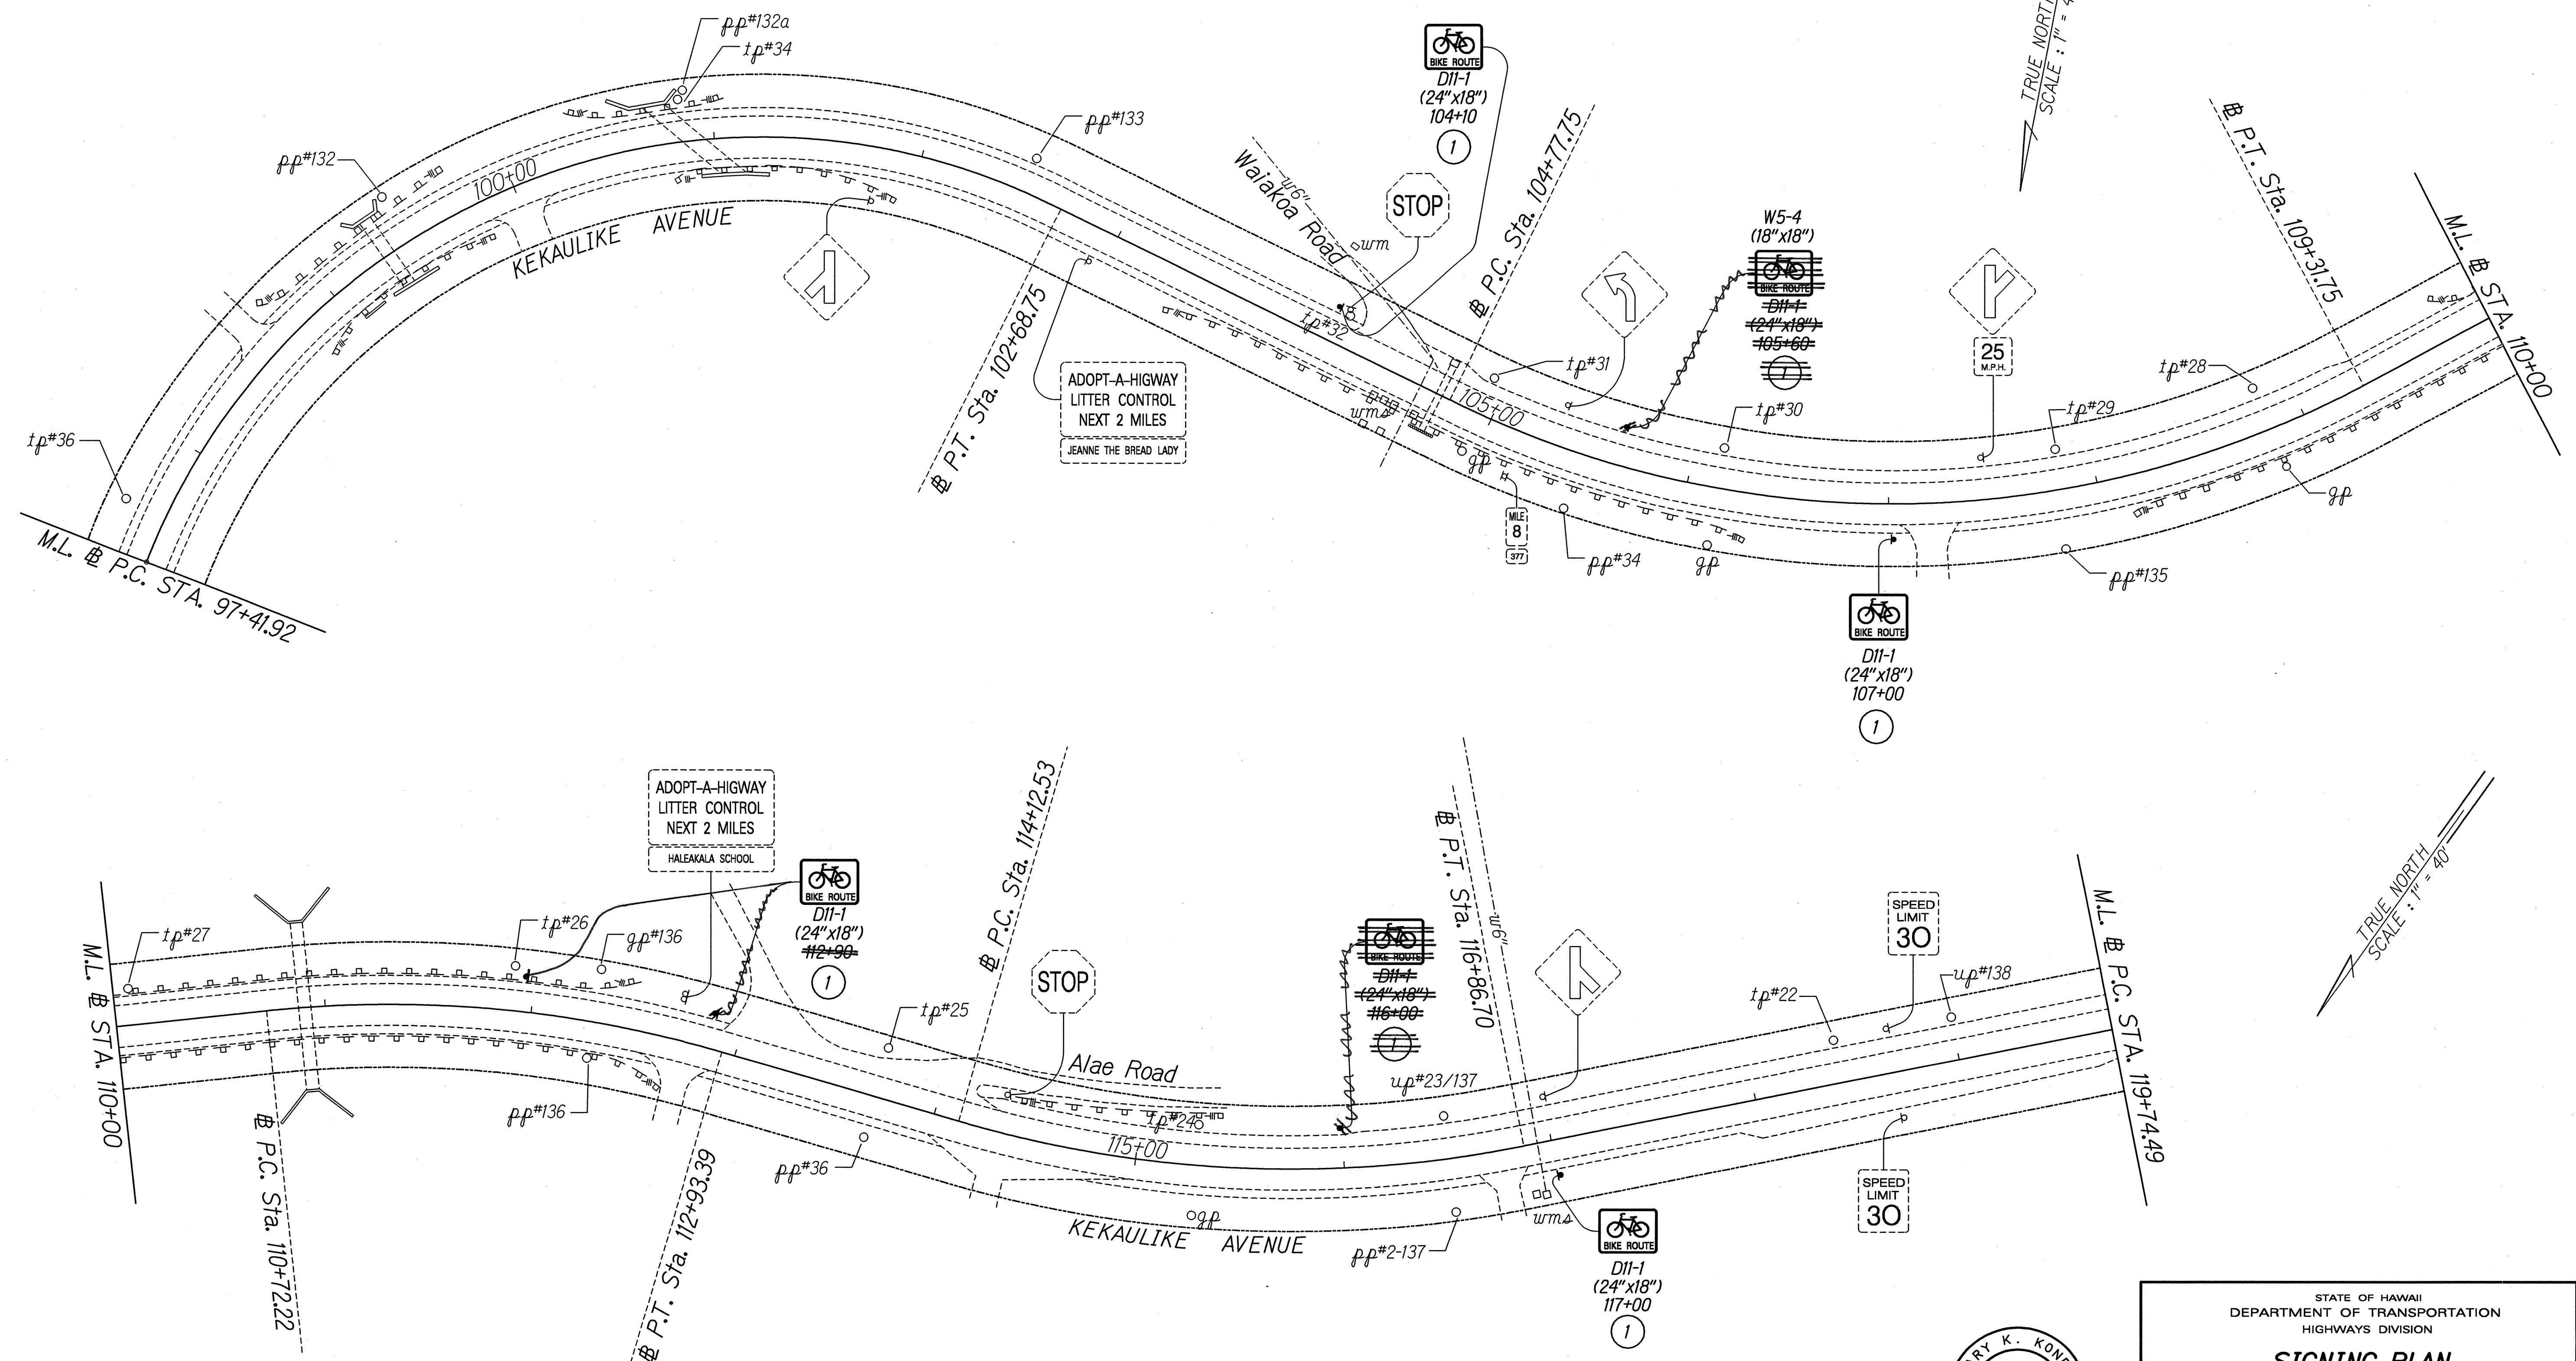

| | |
|-------------------|------|
| ORIGINAL PLAN | DATE |
| SURVEY PLOTTED BY | |
| TRACED BY | |
| DESIGNED BY | |
| QUANTITIES BY | |
| CHECKED BY | |


- KEY TO SIGNAGE:**
- ① Install New Sign (s) with Post (s).
 - ② Install Temporary Construction Sign (s) with Post (s).

GARY K. KONDO
 LICENSED PROFESSIONAL ENGINEER
 NO. 4575-C
 HAWAII, USA
 THIS WORK WAS PREPARED BY ME OR UNDER MY SUPERVISION

STATE OF HAWAII
 DEPARTMENT OF TRANSPORTATION
 HIGHWAYS DIVISION
SIGNING PLAN
KEKAULIKE AVENUE
BIKEWAY IMPROVEMENTS,
KULA HIGHWAY TO HALEAKALA HIGHWAY
 Federal Aid Project No. STP-0900(52)
 Scale: AS NOTED Date: DEC. 1997
 SHEET No. 6 OF 8 SHEETS


"AS-BUILT"

| | | | | | |
|---------------------|-------|--------------|-------------|-----------|--------------|
| FED. ROAD DIST. NO. | STATE | PROJ. NO. | FISCAL YEAR | SHEET NO. | TOTAL SHEETS |
| HAWAII | HAW. | STP-0900(52) | 1998 | 24 | 38 |

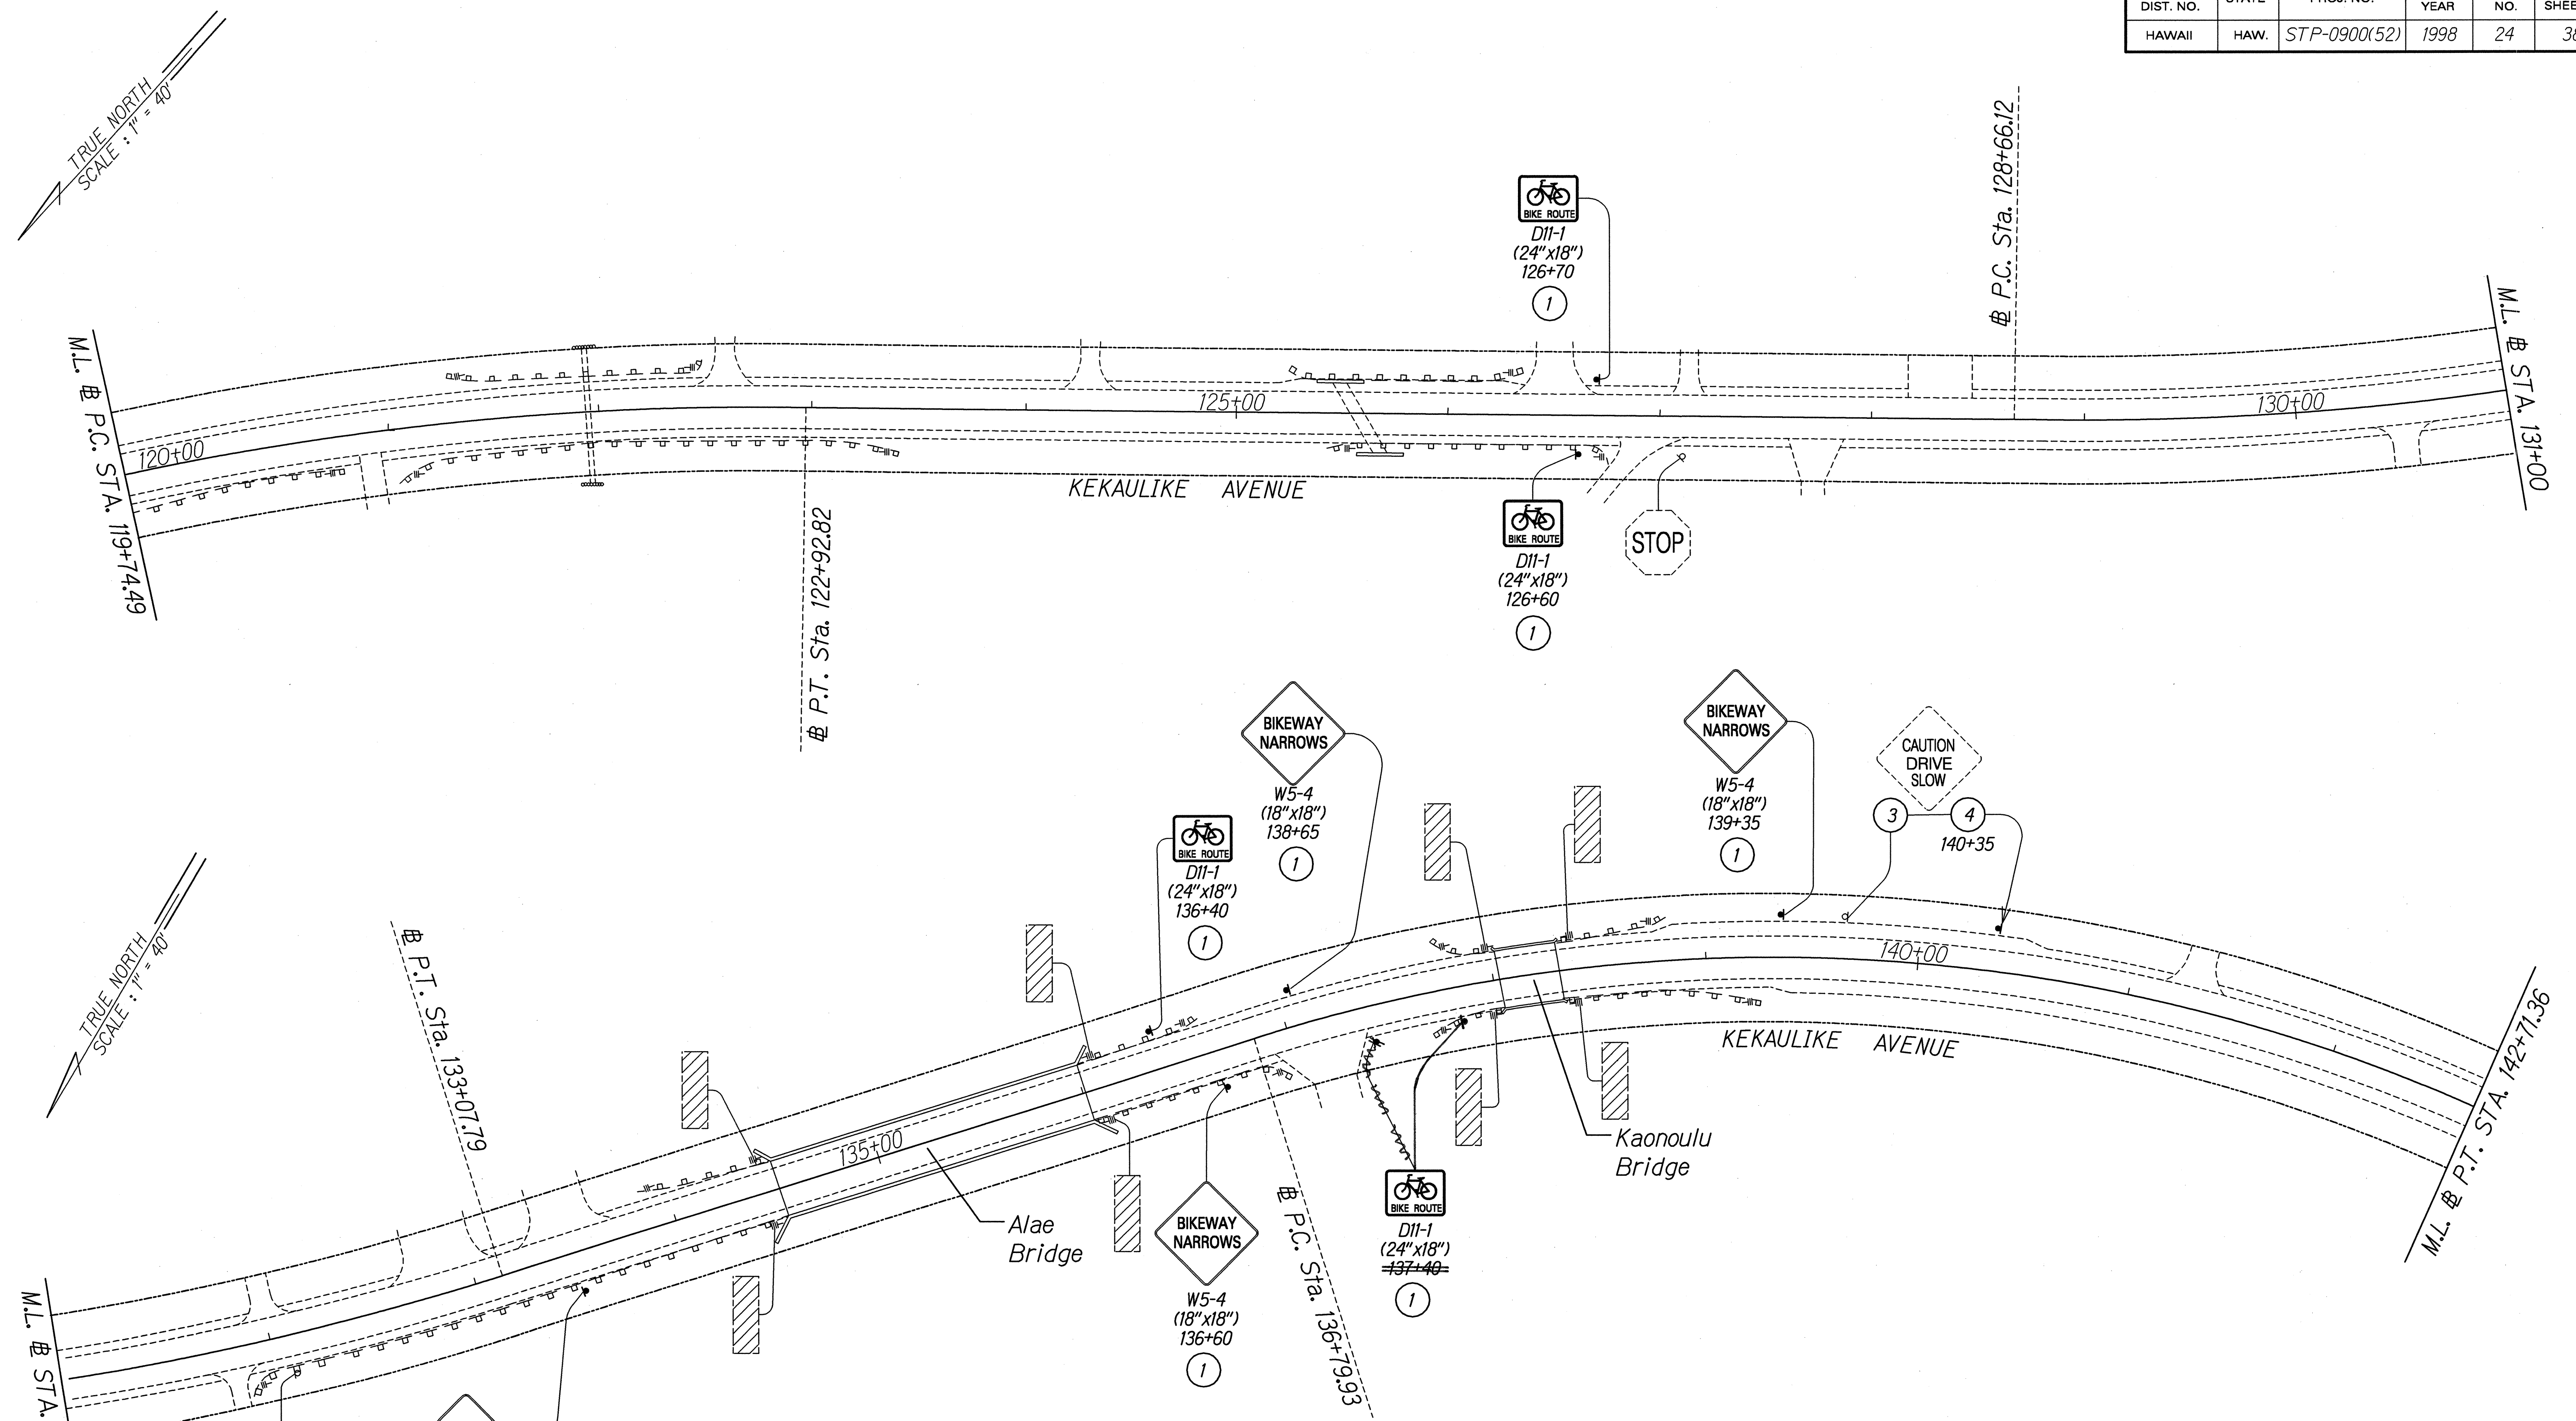

| | |
|-------------------|------|
| SURVEY PLOTTED BY | DATE |
| DESIGNED BY | |
| TRACED BY | |
| DESIGNED BY | |
| QUANTITIES BY | |
| CHECKED BY | |
| ORIGINAL PLAN | |
| NOTE BOOK | |
| No. | |

- KEY TO SIGNAGE:**
- ① Install New Sign (s) with Post (s).
 - ② Install Temporary Construction Sign (s) with Post (s).
 - ③ Existing Sign (s) to be Relocated and Post (s) Removed.
 - ④ Relocated Existing Sign (s) with New Post (s).

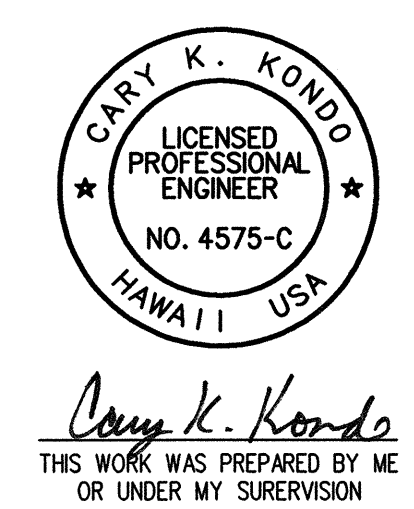

STATE OF HAWAII
DEPARTMENT OF TRANSPORTATION
HIGHWAYS DIVISION


SIGNING PLAN
KEKAULIKE AVENUE
BIKEWAY IMPROVEMENTS,
KULA HIGHWAY TO HALEAKALA HIGHWAY
Federal Aid Project No. STP-0900(52)

Scale: AS NOTED Date: DEC. 1997

SHEET No. 7 OF 8 SHEETS


"AS-BUILT"

| FED. ROAD DIST. NO. | STATE | PROJ. NO. | FISCAL YEAR | SHEET NO. | TOTAL SHEETS |
|---------------------|-------|--------------|-------------|-----------|--------------|
| HAWAII | HAW. | STP-0900(52) | 1998 | 25 | 38 |

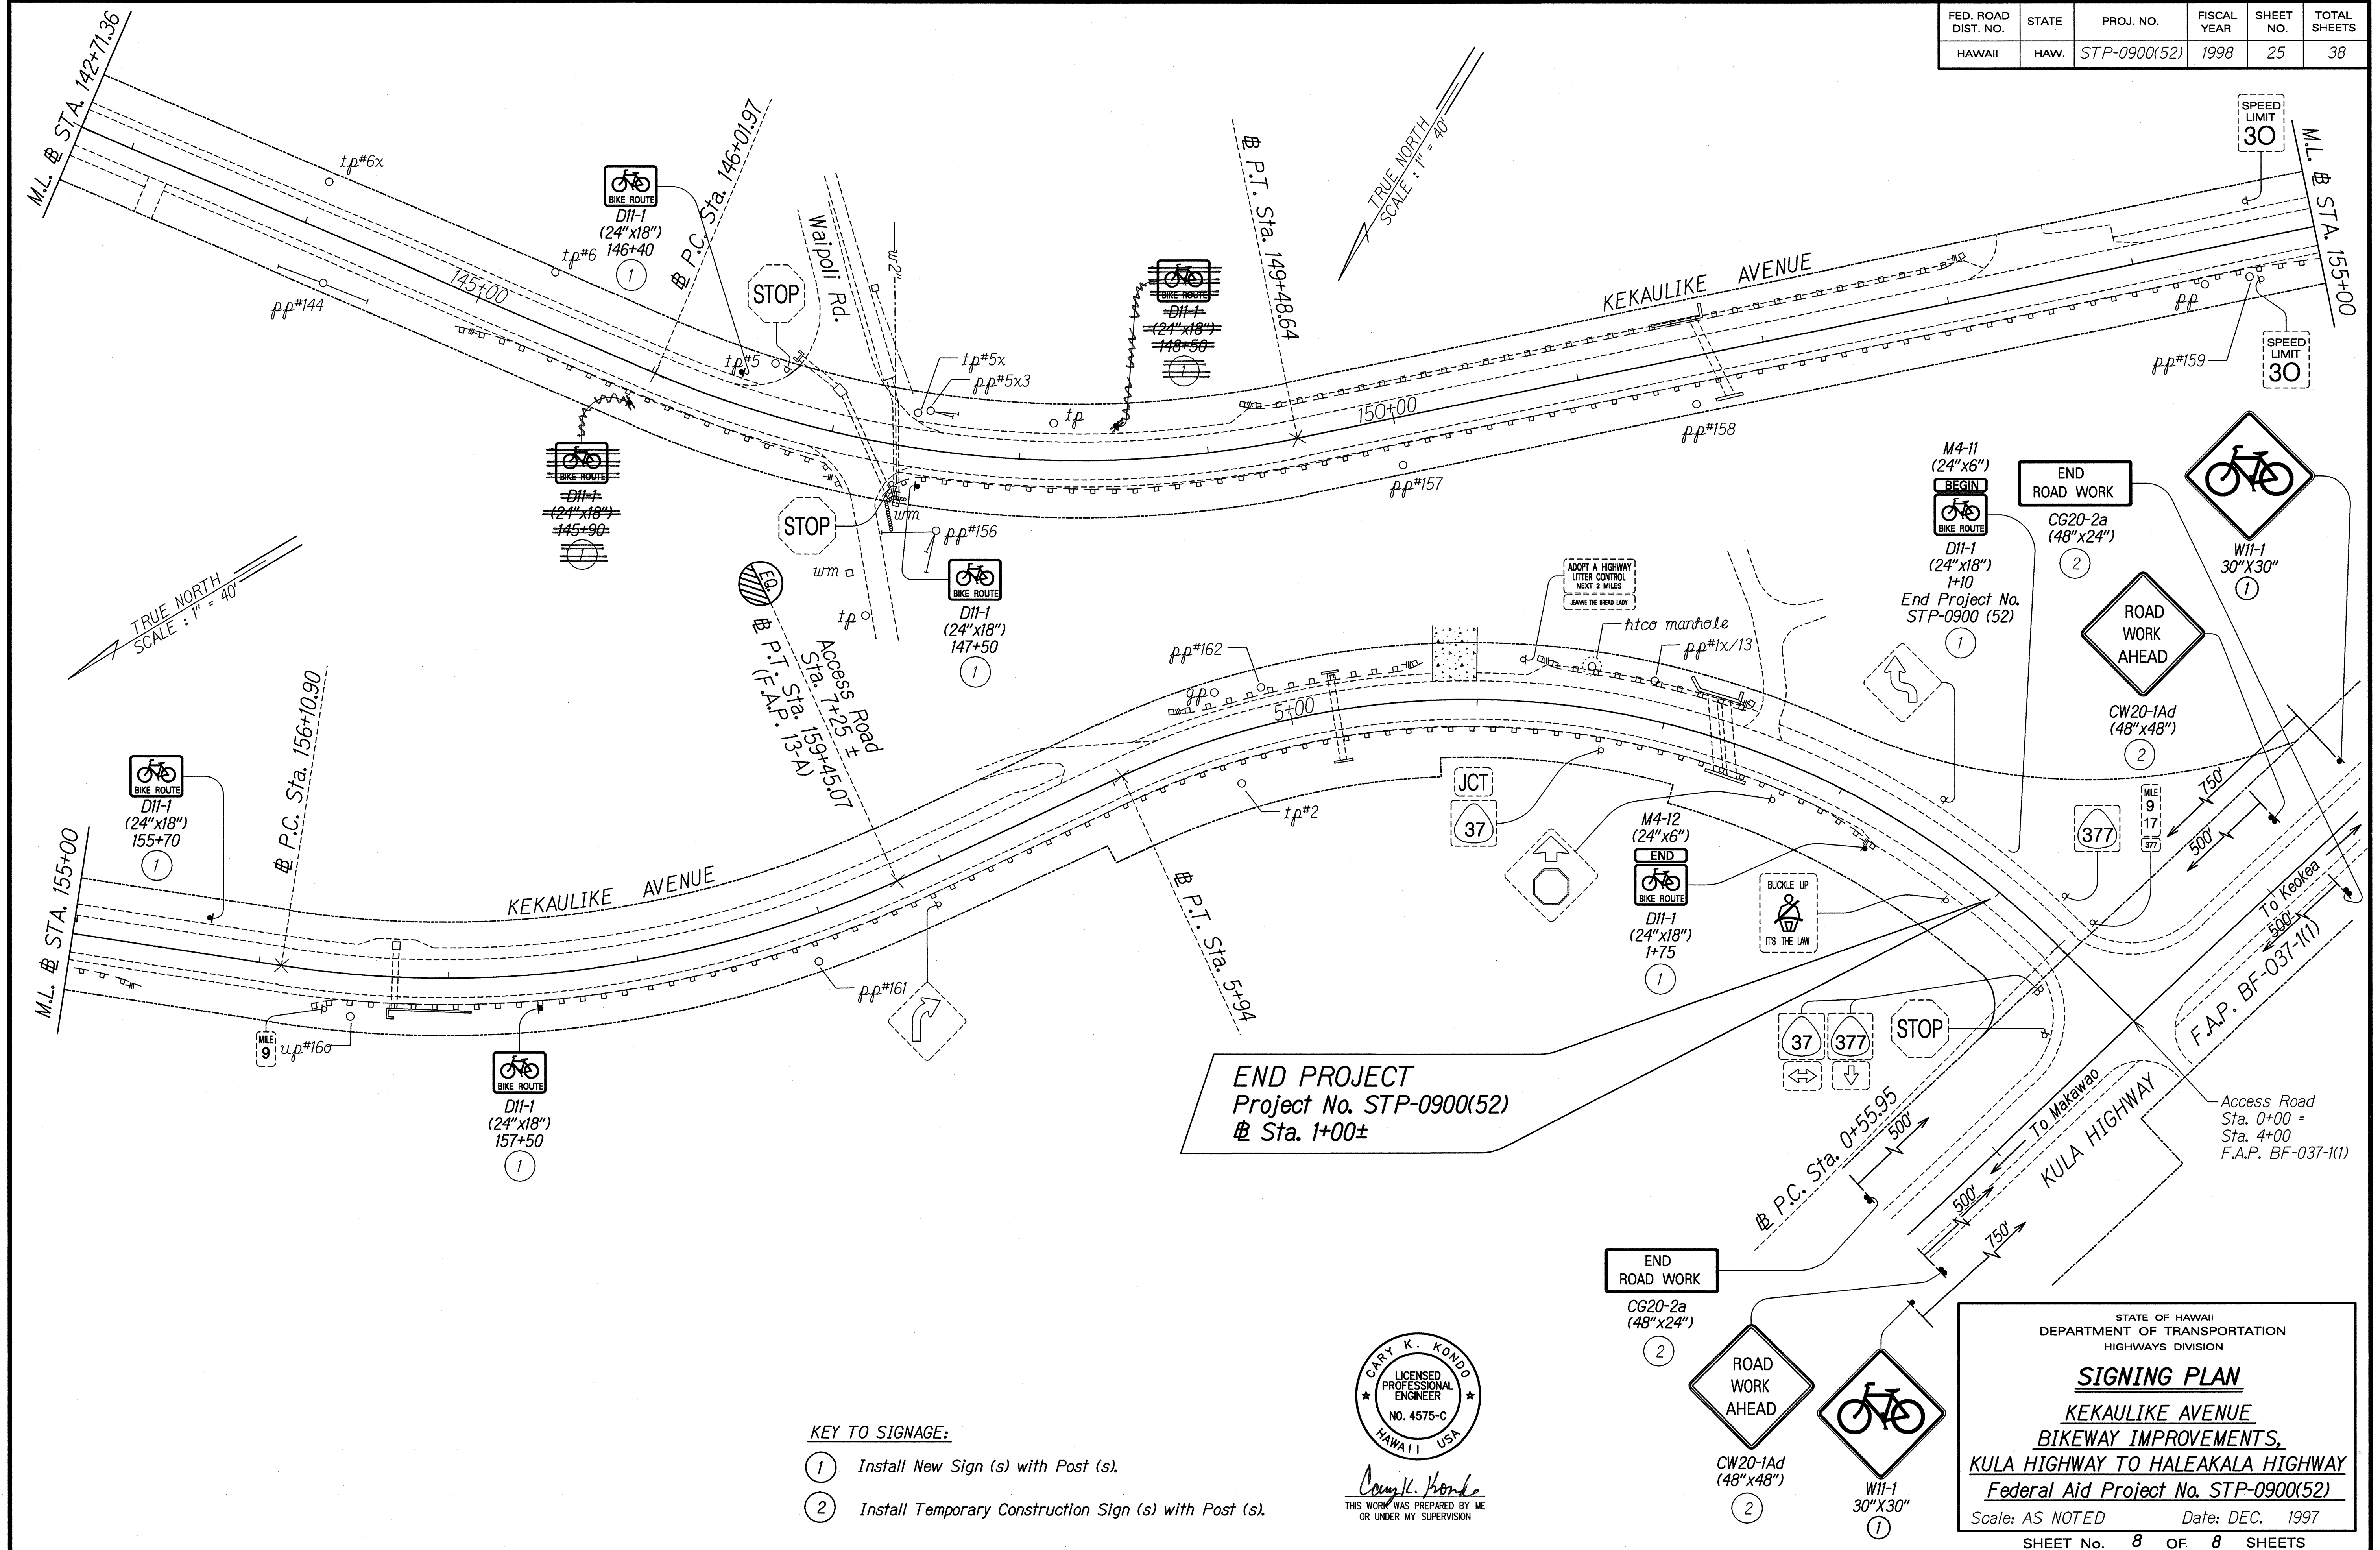

| | |
|-------------------------|------------|
| SURVEY PLOTTED BY _____ | DATE _____ |
| DESIGNED BY _____ | |
| QUANTITIES BY _____ | |
| CHECKED BY _____ | |
| ORIGINAL PLAN No. _____ | |

- KEY TO SIGNAGE:**
- ① Install New Sign (s) with Post (s).
 - ② Install Temporary Construction Sign (s) with Post (s).

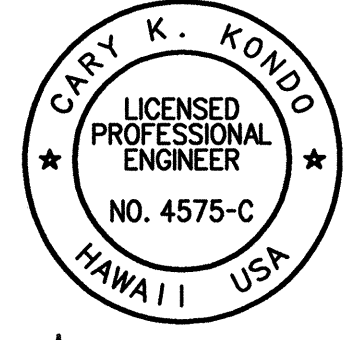

Cary K. Kondo
THIS WORK WAS PREPARED BY ME OR UNDER MY SUPERVISION

STATE OF HAWAII
DEPARTMENT OF TRANSPORTATION
HIGHWAYS DIVISION

SIGNING PLAN
KEKAULIKE AVENUE
BIKEWAY IMPROVEMENTS,
KULA HIGHWAY TO HALEAKALA HIGHWAY
Federal Aid Project No. STP-0900(52)

Scale: AS NOTED Date: DEC. 1997

"AS-BUILT"