



FED. ROAD DIST. NO.	STATE	PROJ. NO.	FISCAL YEAR	SHEET NO.	TOTAL SHEETS
HAWAII	HAW.	STP-0900(52)	1998	27	38

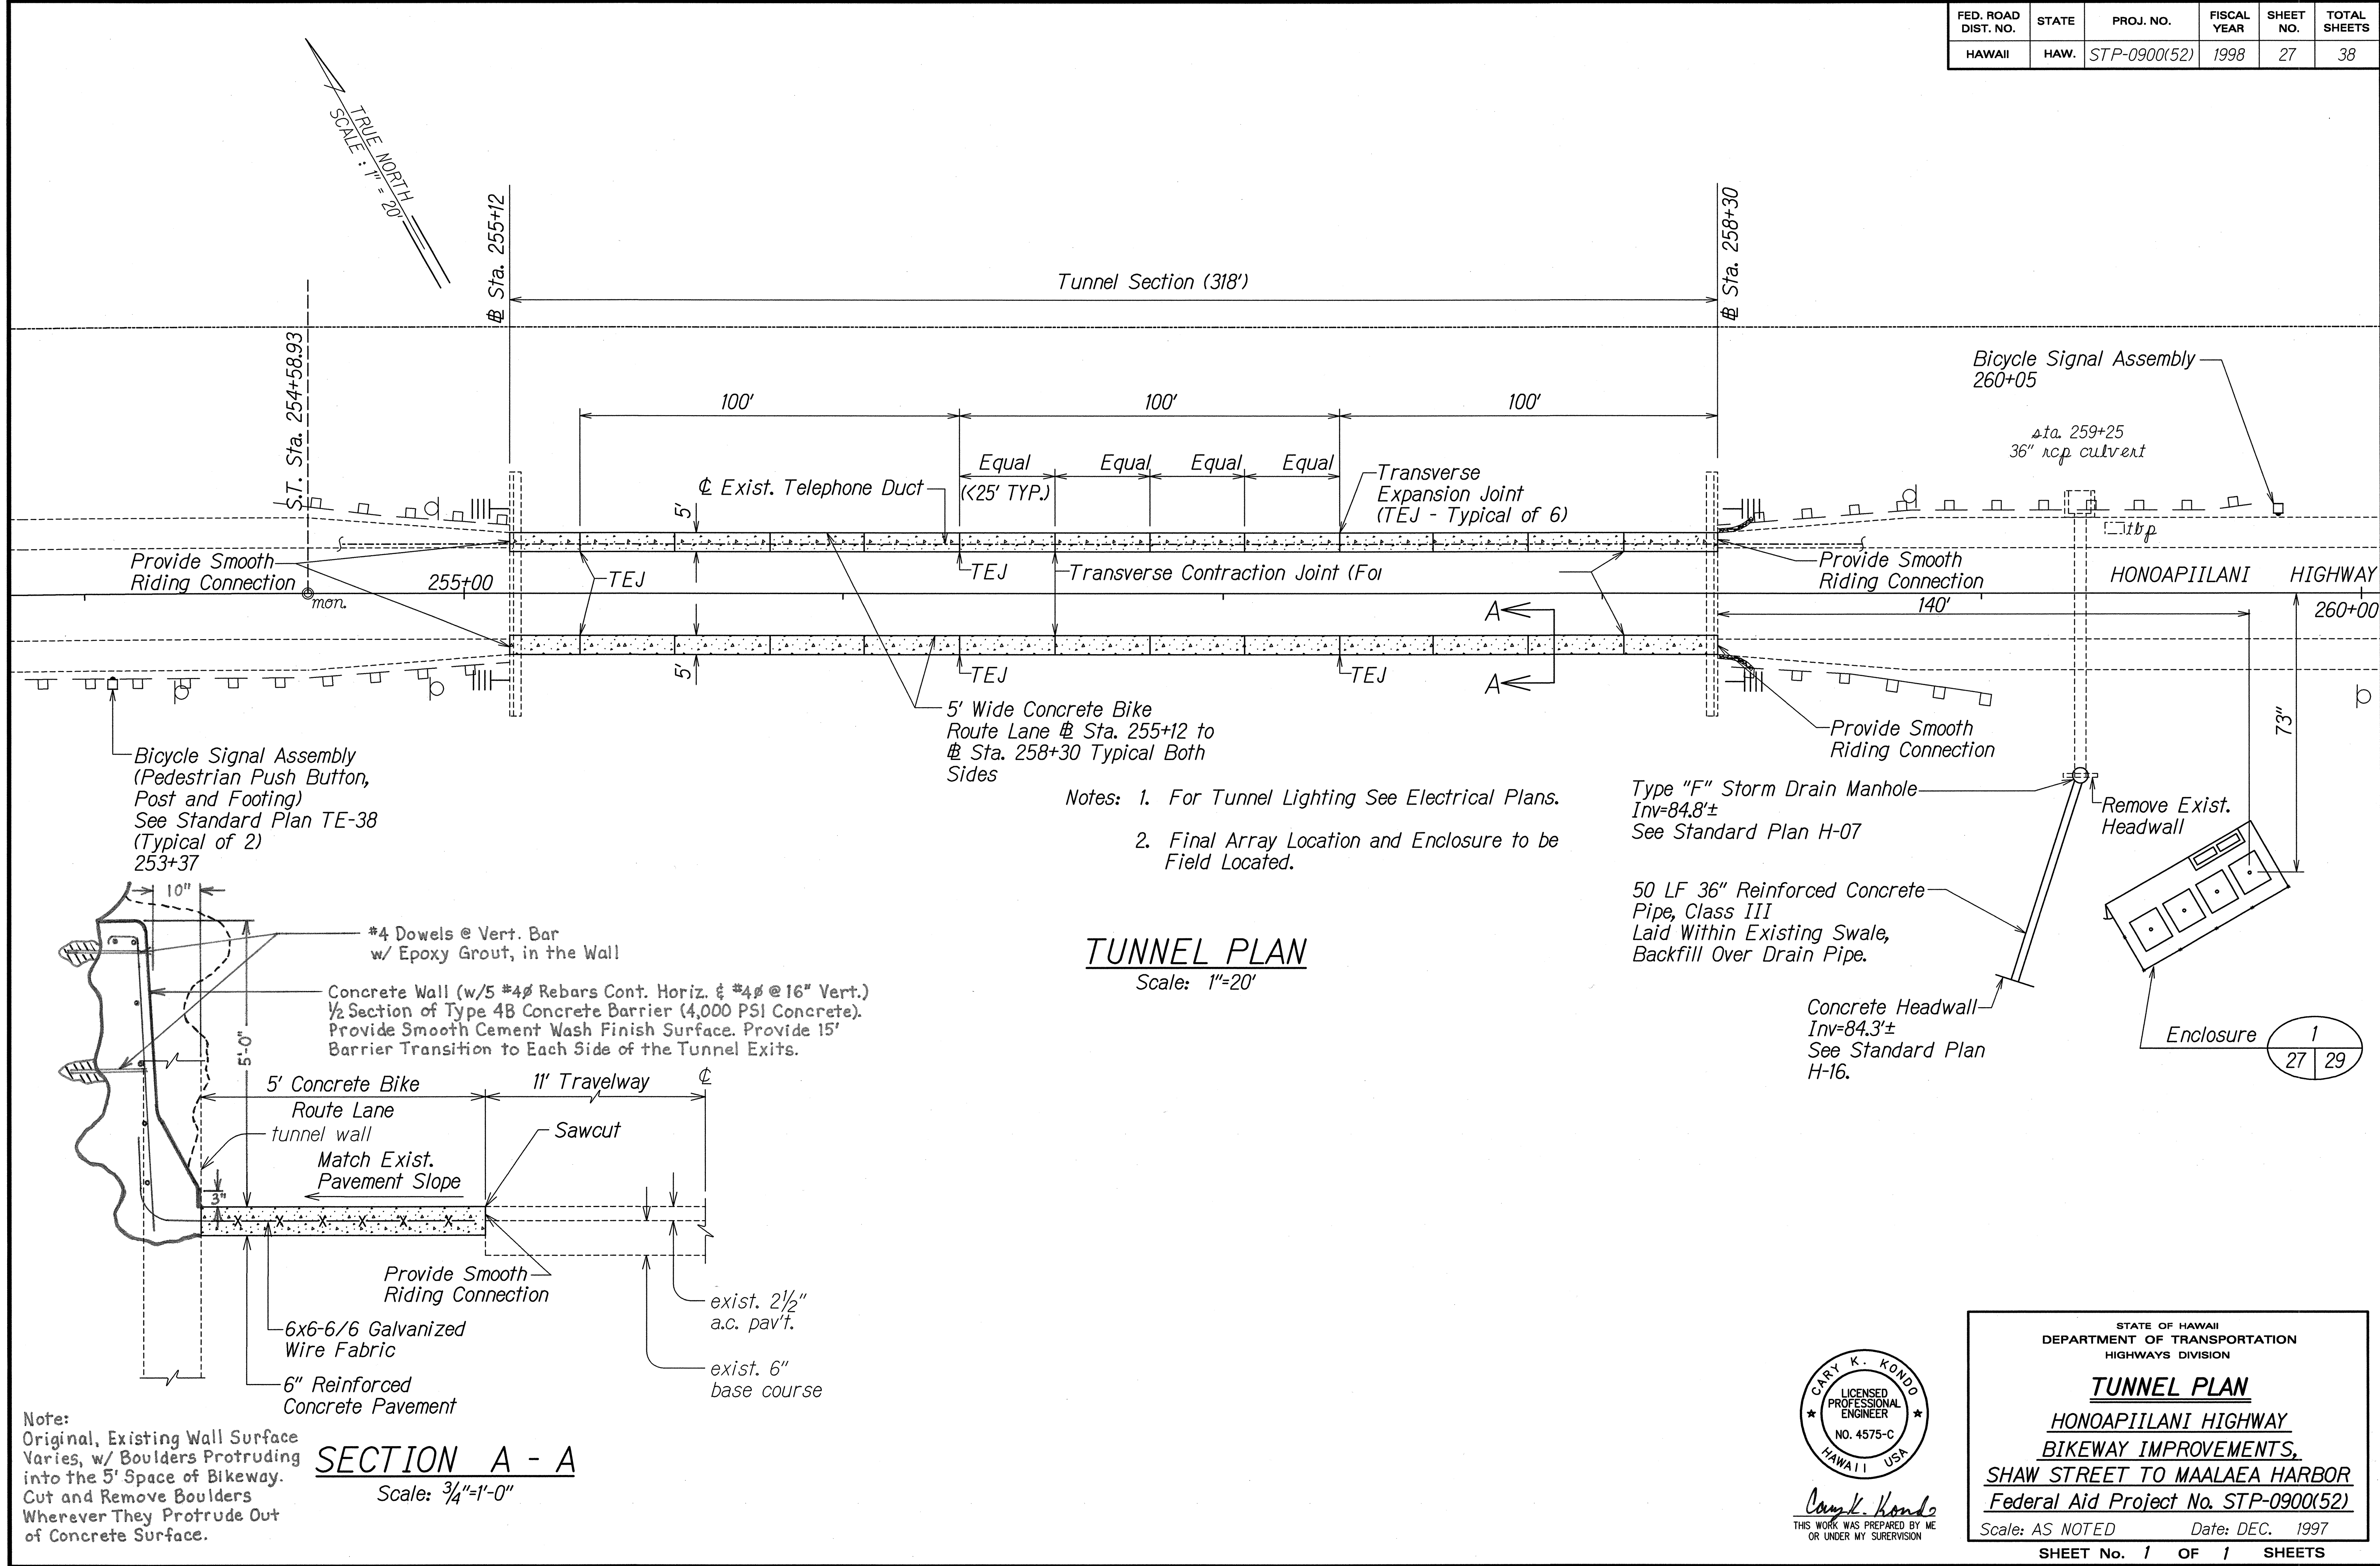

DATE	_____
SURVEY PLOTTED BY	_____
DESIGNED BY	_____
QUANTITIES BY	_____
CHECKED BY	_____
ORIGINAL PLAN	_____
NOTE BOOK	_____
No.	_____

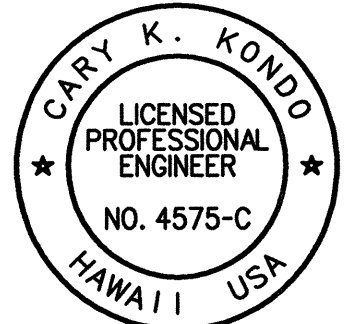

Gary K. Kondo
THIS WORK WAS PREPARED BY ME
OR UNDER MY SUPERVISION

STATE OF HAWAII
DEPARTMENT OF TRANSPORTATION
HIGHWAYS DIVISION
TUNNEL PLAN
HONOAPIILANI HIGHWAY
BIKEWAY IMPROVEMENTS,
SHAW STREET TO MAALAEA HARBOR
Federal Aid Project No. STP-0900(52)
Scale: AS NOTED Date: DEC. 1997
SHEET No. 1 OF 1 SHEETS

Gary K. Kondo
THIS WORK WAS PREPARED BY ME
OR UNDER MY SUPERVISION

"AS-BUILT"