
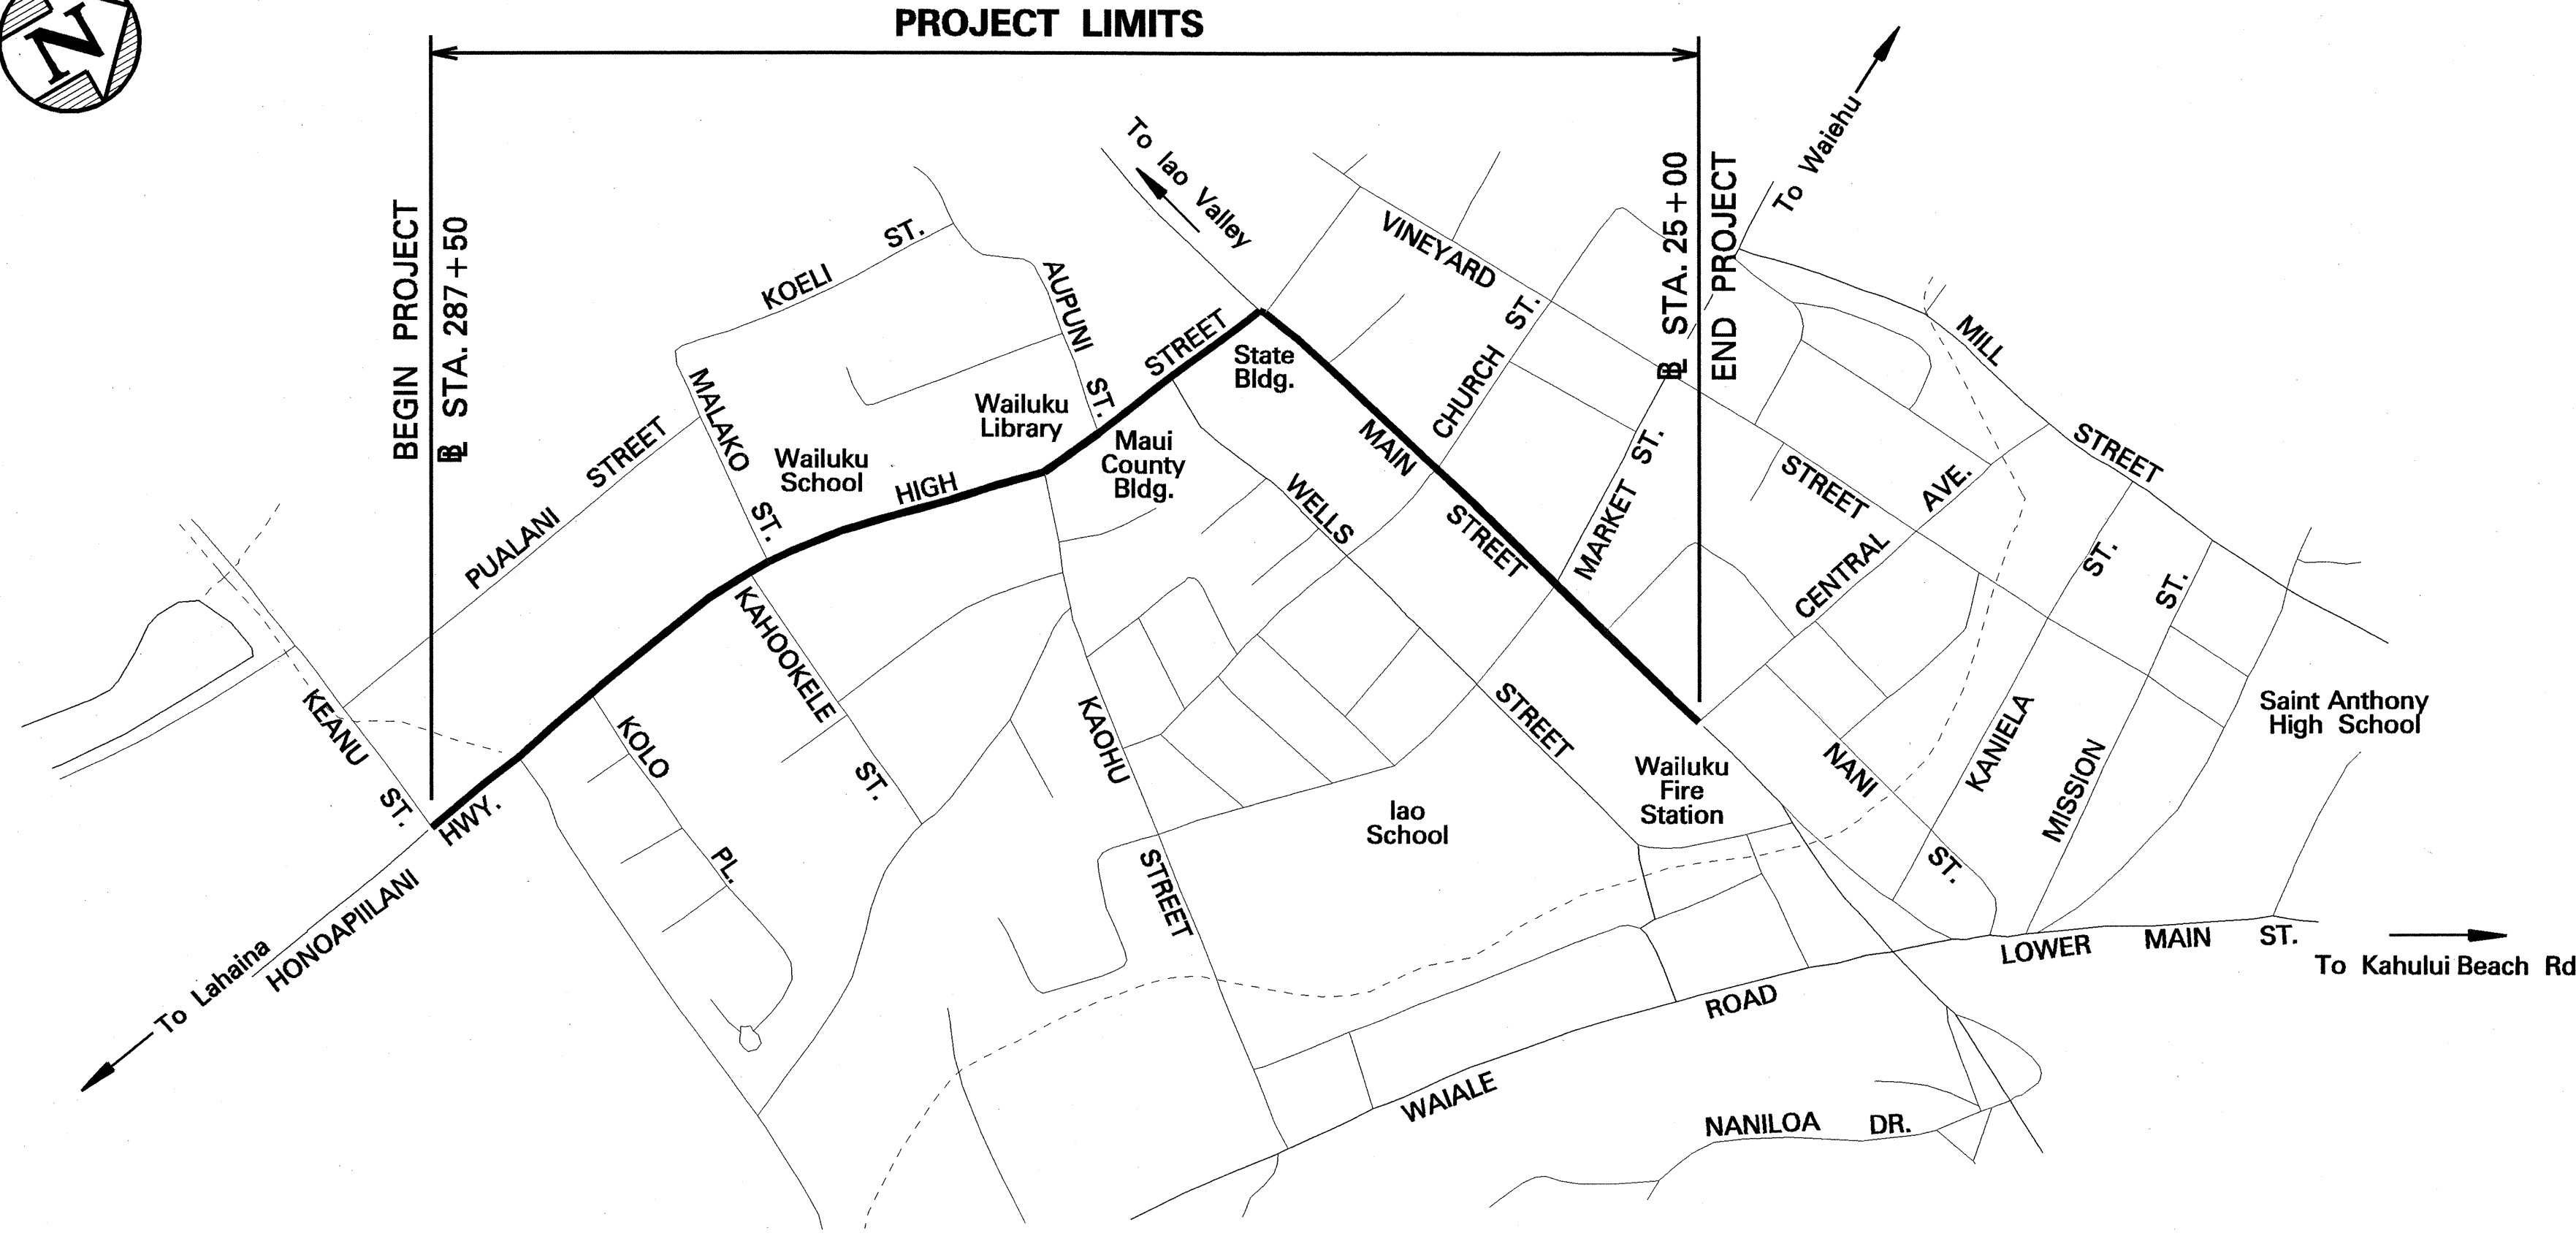
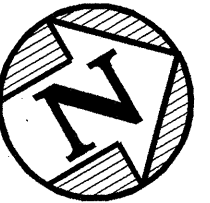
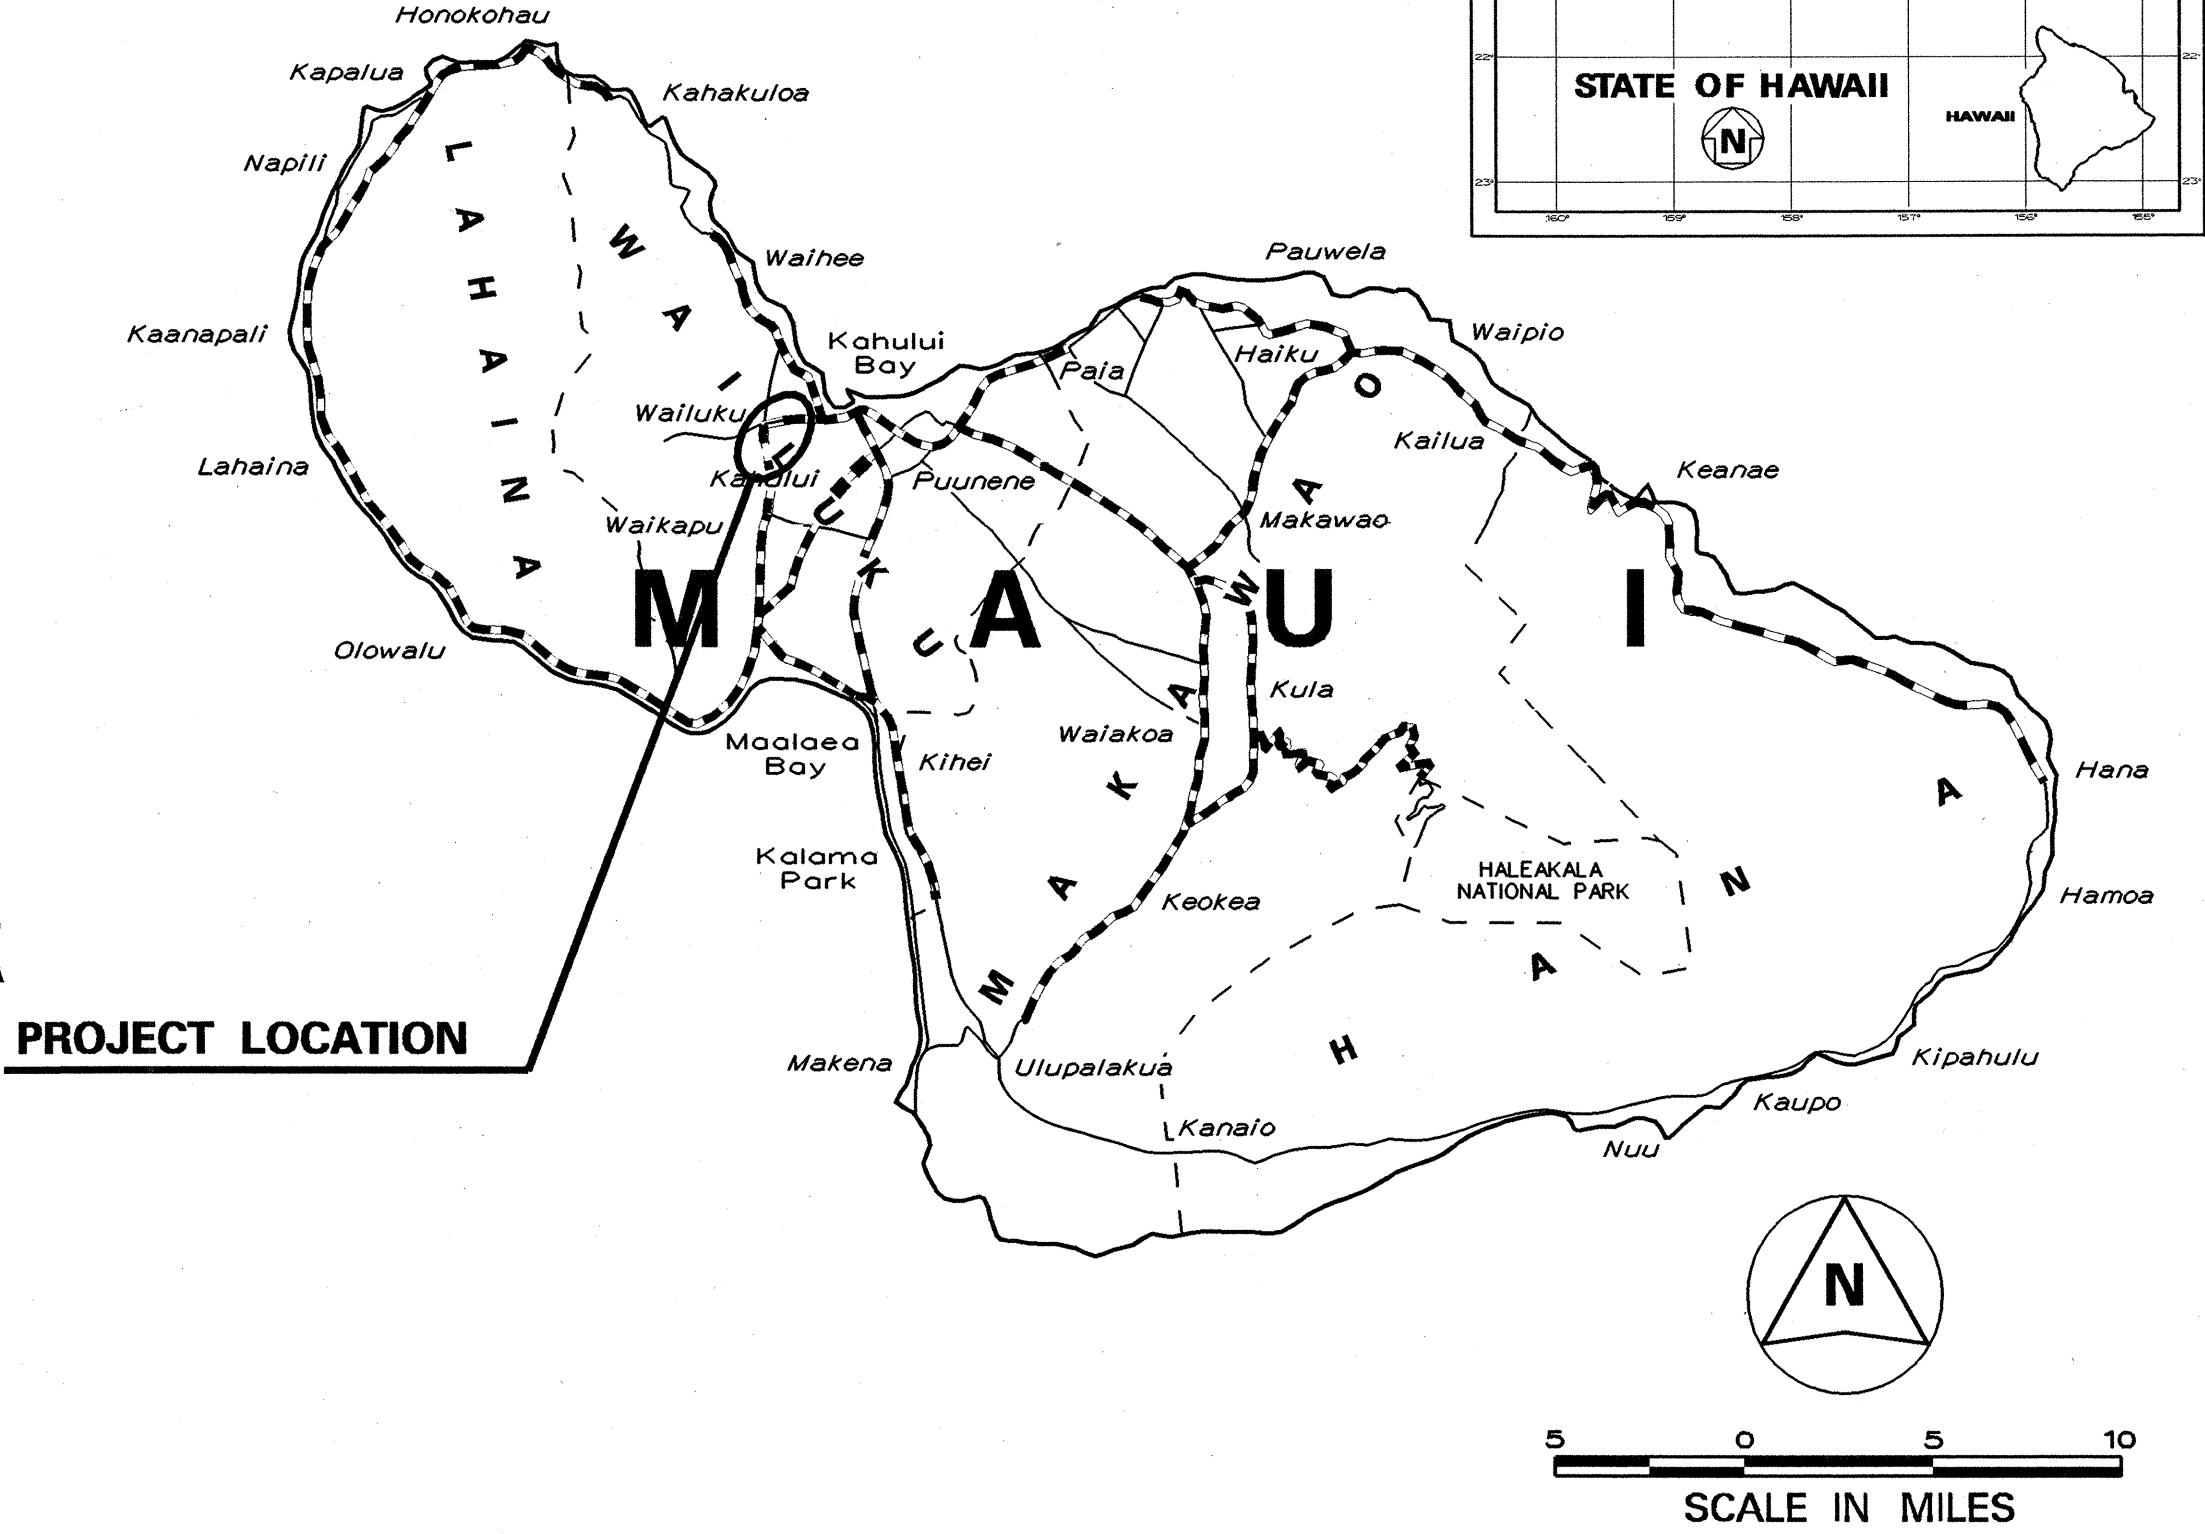
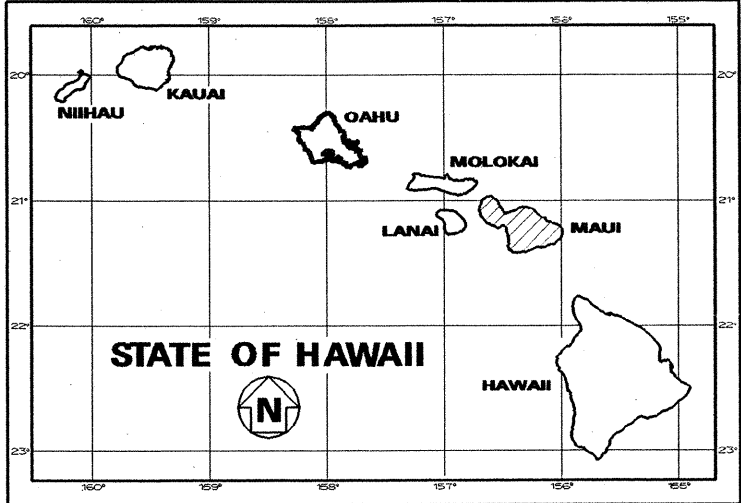


INDEX TO DRAWINGS	
SHEET NO.	DESCRIPTION
1	TITLE SHEET
2	STANDARD PLANS SUMMARY
3	GENERAL NOTES, UTILITY NOTES & LEGEND
4 - 5	WATER POLLUTION & EROSION CONTROL NOTES
6 - 9	CURB RAMP AND SIDEWALK NOTES
10 - 13	TYPICAL SECTIONS & DETAILS
14 - 18	DRAINAGE PLAN & DETAILS
19	DETOUR PLAN
20 - 22	SPOT ELEVATIONS
23 - 25	ROADWAY PLANS
26	PAVEMENT MARKING LEGEND, DETAILS AND NOTES
27 - 29	SIGNING AND PAVEMENT MARKING PLAN
30	SIGN DETAILS
31 - 32	MISCELLANEOUS SUMMARIES
33 - 34	SPOT GRADE SUMMARY

STATE OF HAWAII
DEPARTMENT OF TRANSPORTATION
HIGHWAYS DIVISION
HONOLULU, HAWAII
AS-BUILT
PLANS FOR
**HIGH STREET RESURFACING
MAIN STREET TO KEANU STREET AND
MAIN STREET RESURFACING
HIGH STREET TO CENTRAL AVENUE**
FEDERAL AID PROJECT NO. STP-NH-0900(62)R
DISTRICT OF WAILUKU
ISLAND OF MAUI

FED. ROAD DIST. NO.	STATE	FED. AID PROJ. NO.	FISCAL YEAR	SHEET NO.	TOTAL SHEETS
HAWAII	HAW.	STP-NH-0900(62)R	2003	1	34

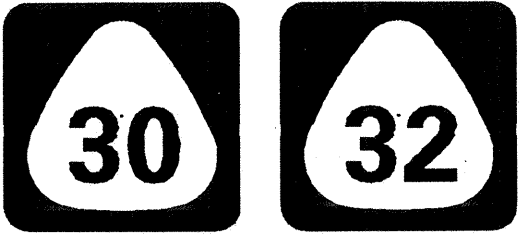

----- FEDERAL AID PROJECTS PREVIOUSLY CONSTRUCTED OR UNDER CONSTRUCTION

(HIGH STREET) MILE POST 0.00 TO MILE POST 0.53
(MAIN STREET) MILE POST 0.00 TO MILE POST 0.38

DESIGN DESIGNATION


	HIGH STREET MAIN STREET TO KEANU STREET	MAIN STREET HIGH STREET TO MARKET STREET	MAIN STREET MARKET STREET TO CENTRAL STREET
ADT (2002)	15,900	15,400	21,300
ADT (2012)	17,500	17,000	23,500
DHV	1,660	1,450	2,000
DESIGN _K	9.5	8.5	8.5
DESIGN _D	60/40	60/40	55/45
DESIGN _T	2.0	1.0	1.0
T ₂₄	2.5	1.5	1.5
V	35 M.P.H.	25 M.P.H.	25 M.P.H.

CHANGES MADE DURING CONSTRUCTION HAVE BEEN INCORPORATED ON THESE PLANS EXCEPT CHANGES IN THE ORIGINAL THEORETICAL QUANTITIES. FOR ACTUAL QUANTITIES, REFER TO PROJECT LEGEND.

DEPARTMENT OF TRANSPORTATION
STATE OF HAWAII
APPROVED: *[Signature]* 5-13-02
for DIR. OF TRANSPORTATION DATE

HWY-M
DESIGNED BY
PAUL CHUNG
P.S. & E.BY
873-3535
OCTOBER, 2002
DATE
PHONE

LAYOUT PLAN

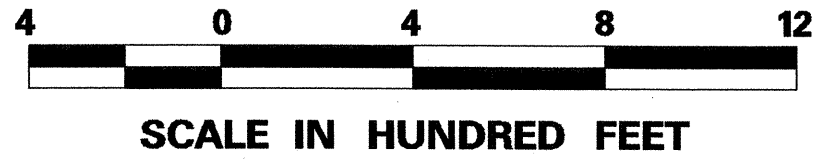

GROSS LENGTH OF PROJECT..... 0.91 MILES
NET LENGTH OF PROJECT..... 0.91 MILES