
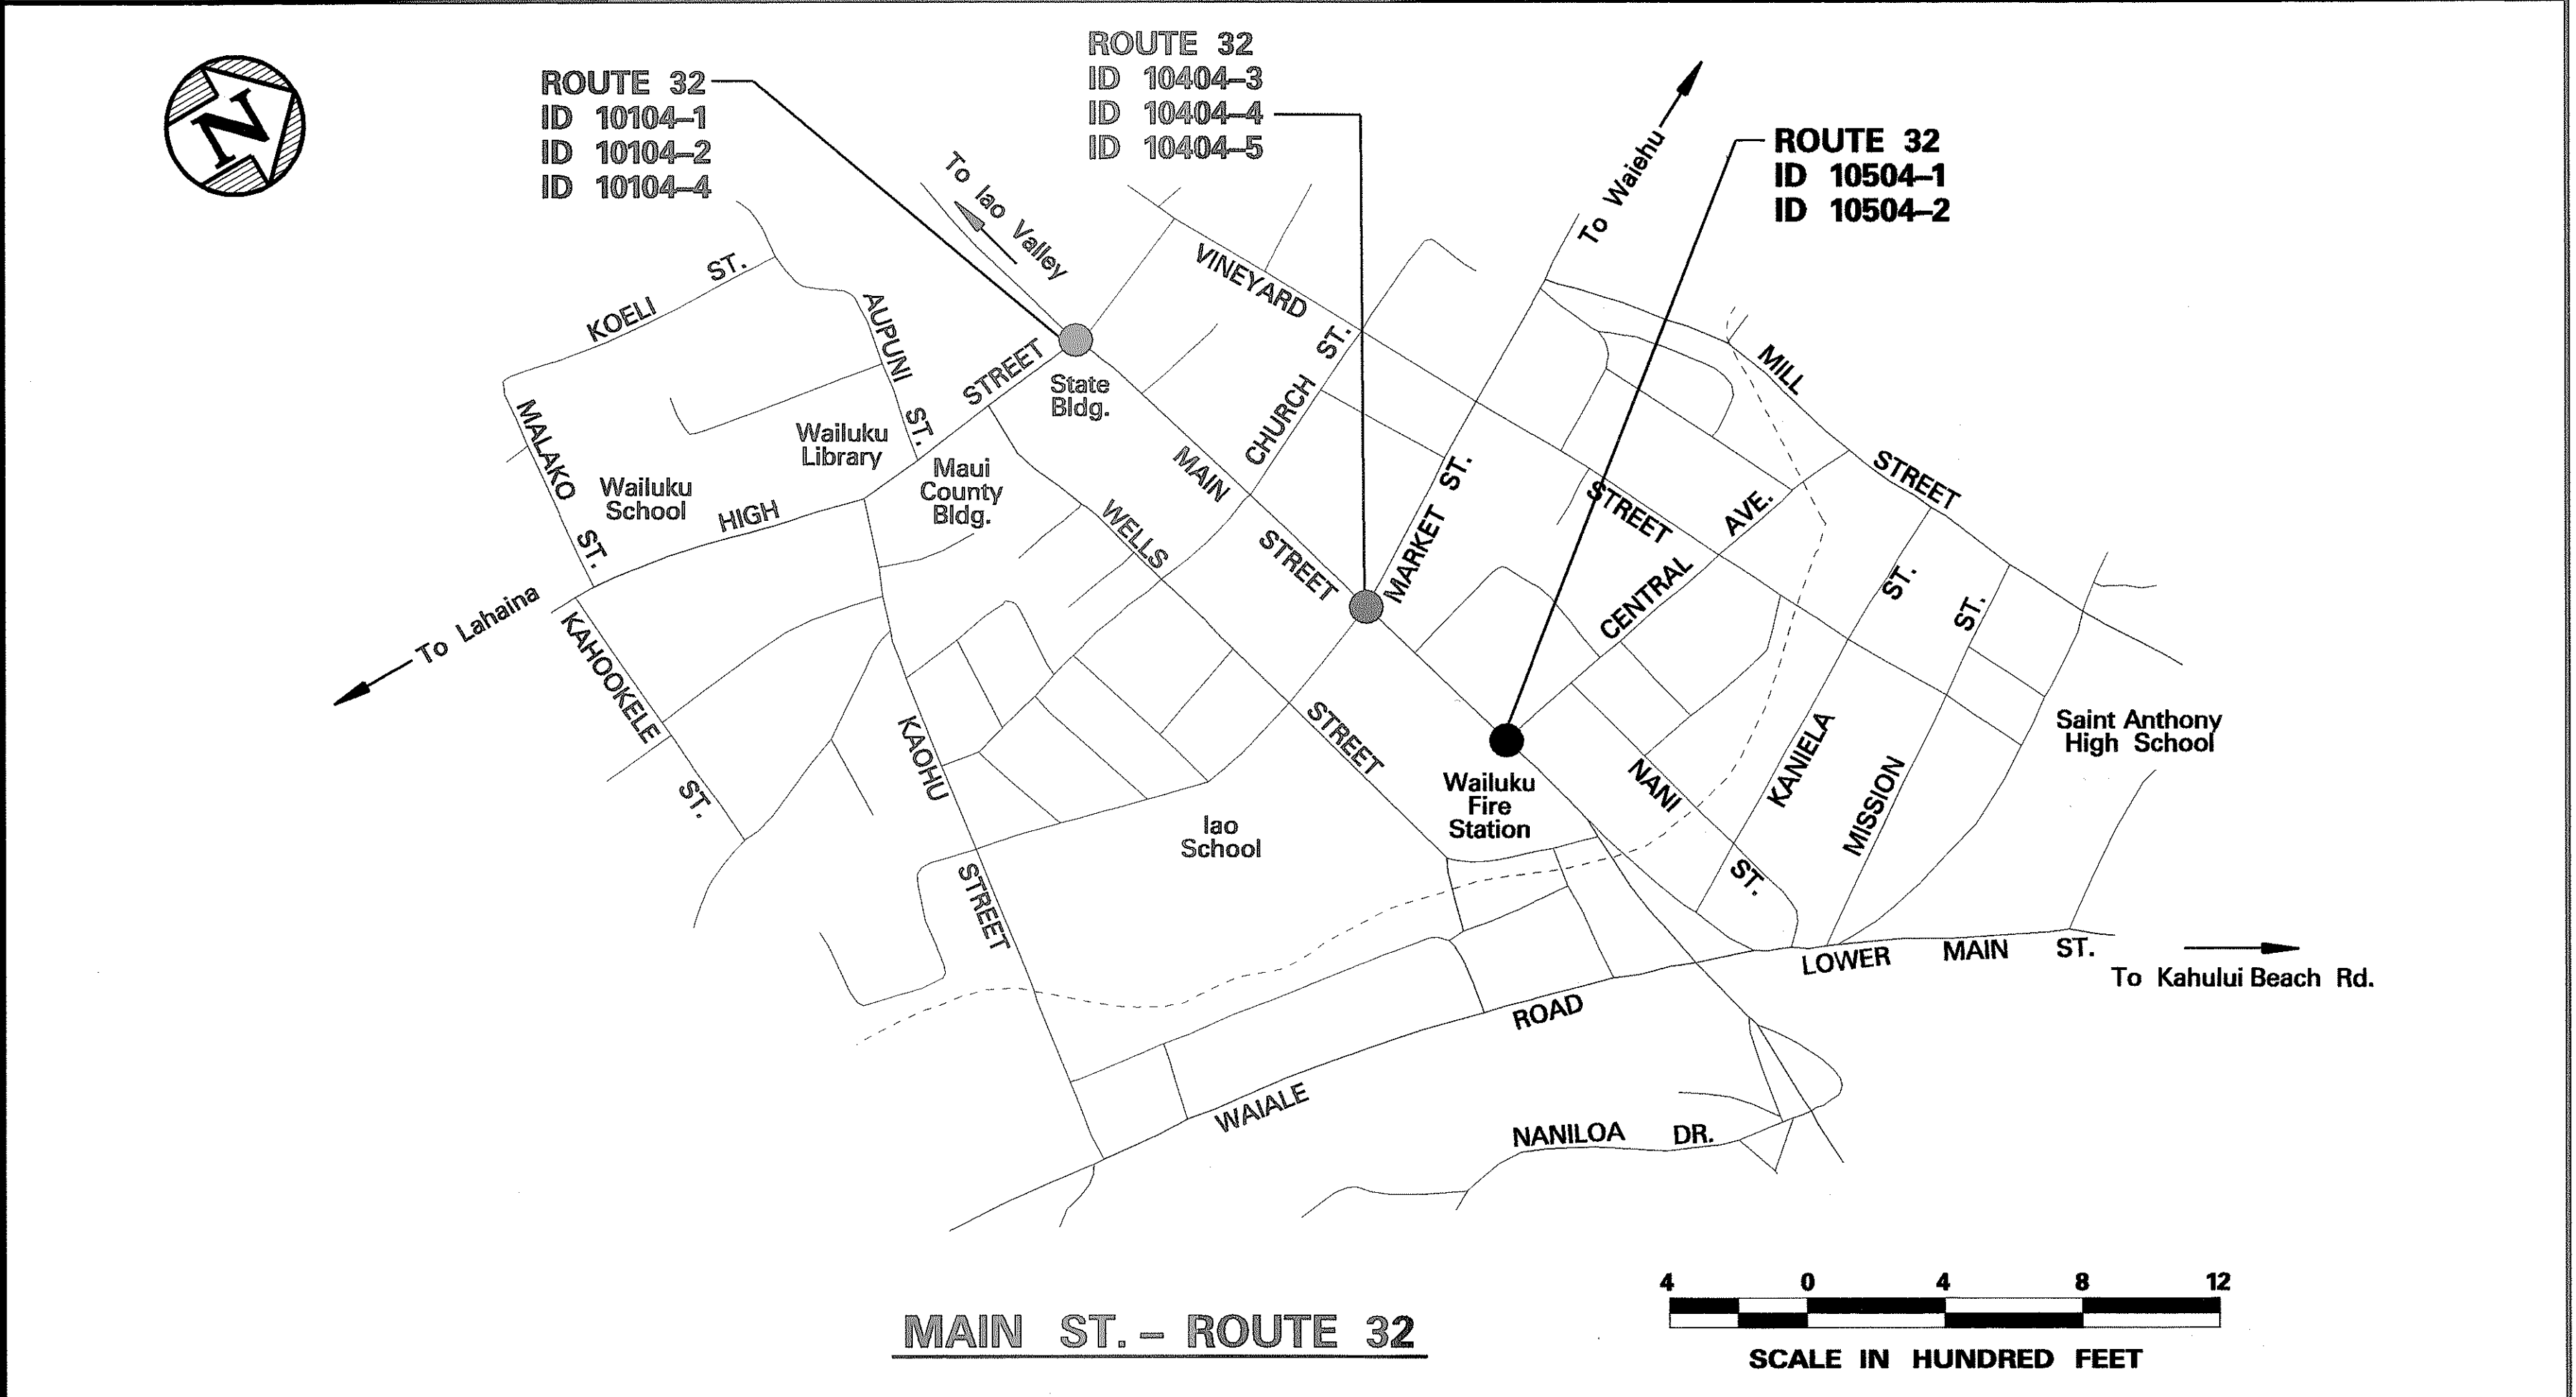
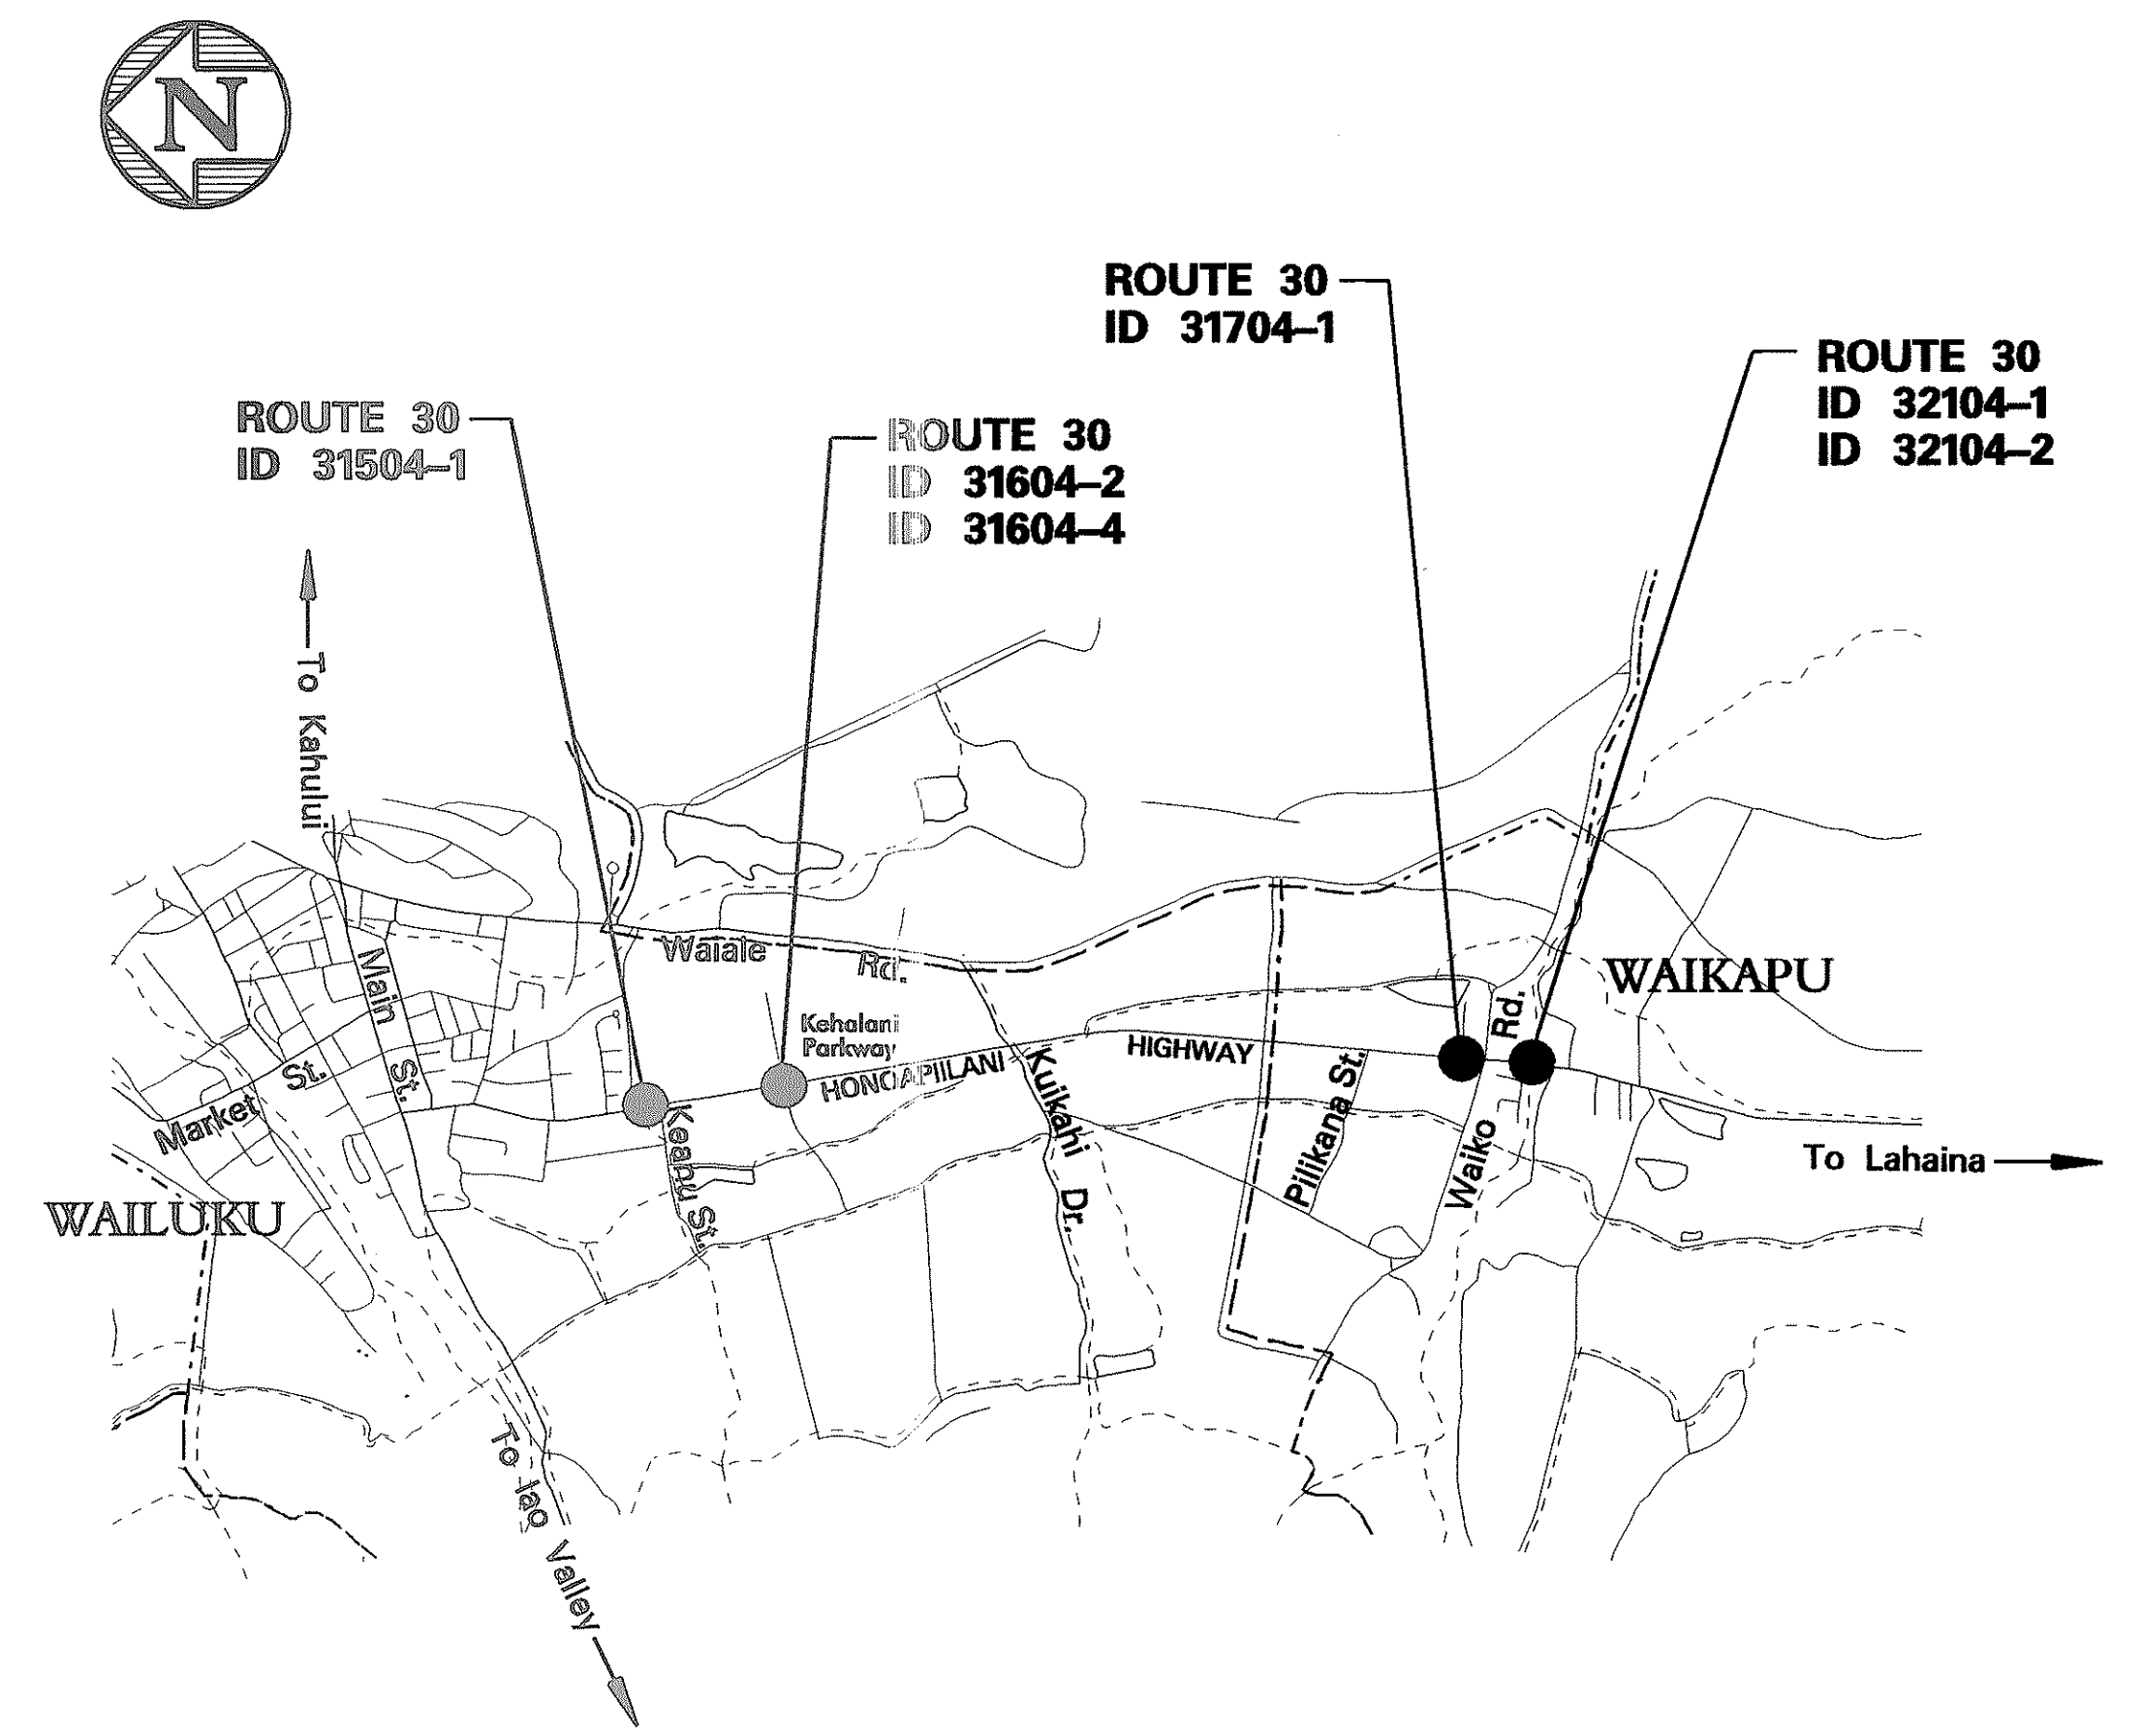


FED. ROAD DIST. NO.	STATE	PROJ. NO.	FISCAL YEAR	SHEET NO.	TOTAL SHEETS
HAWAII	HAW.	HWY-M-02-05M	2005	15	44

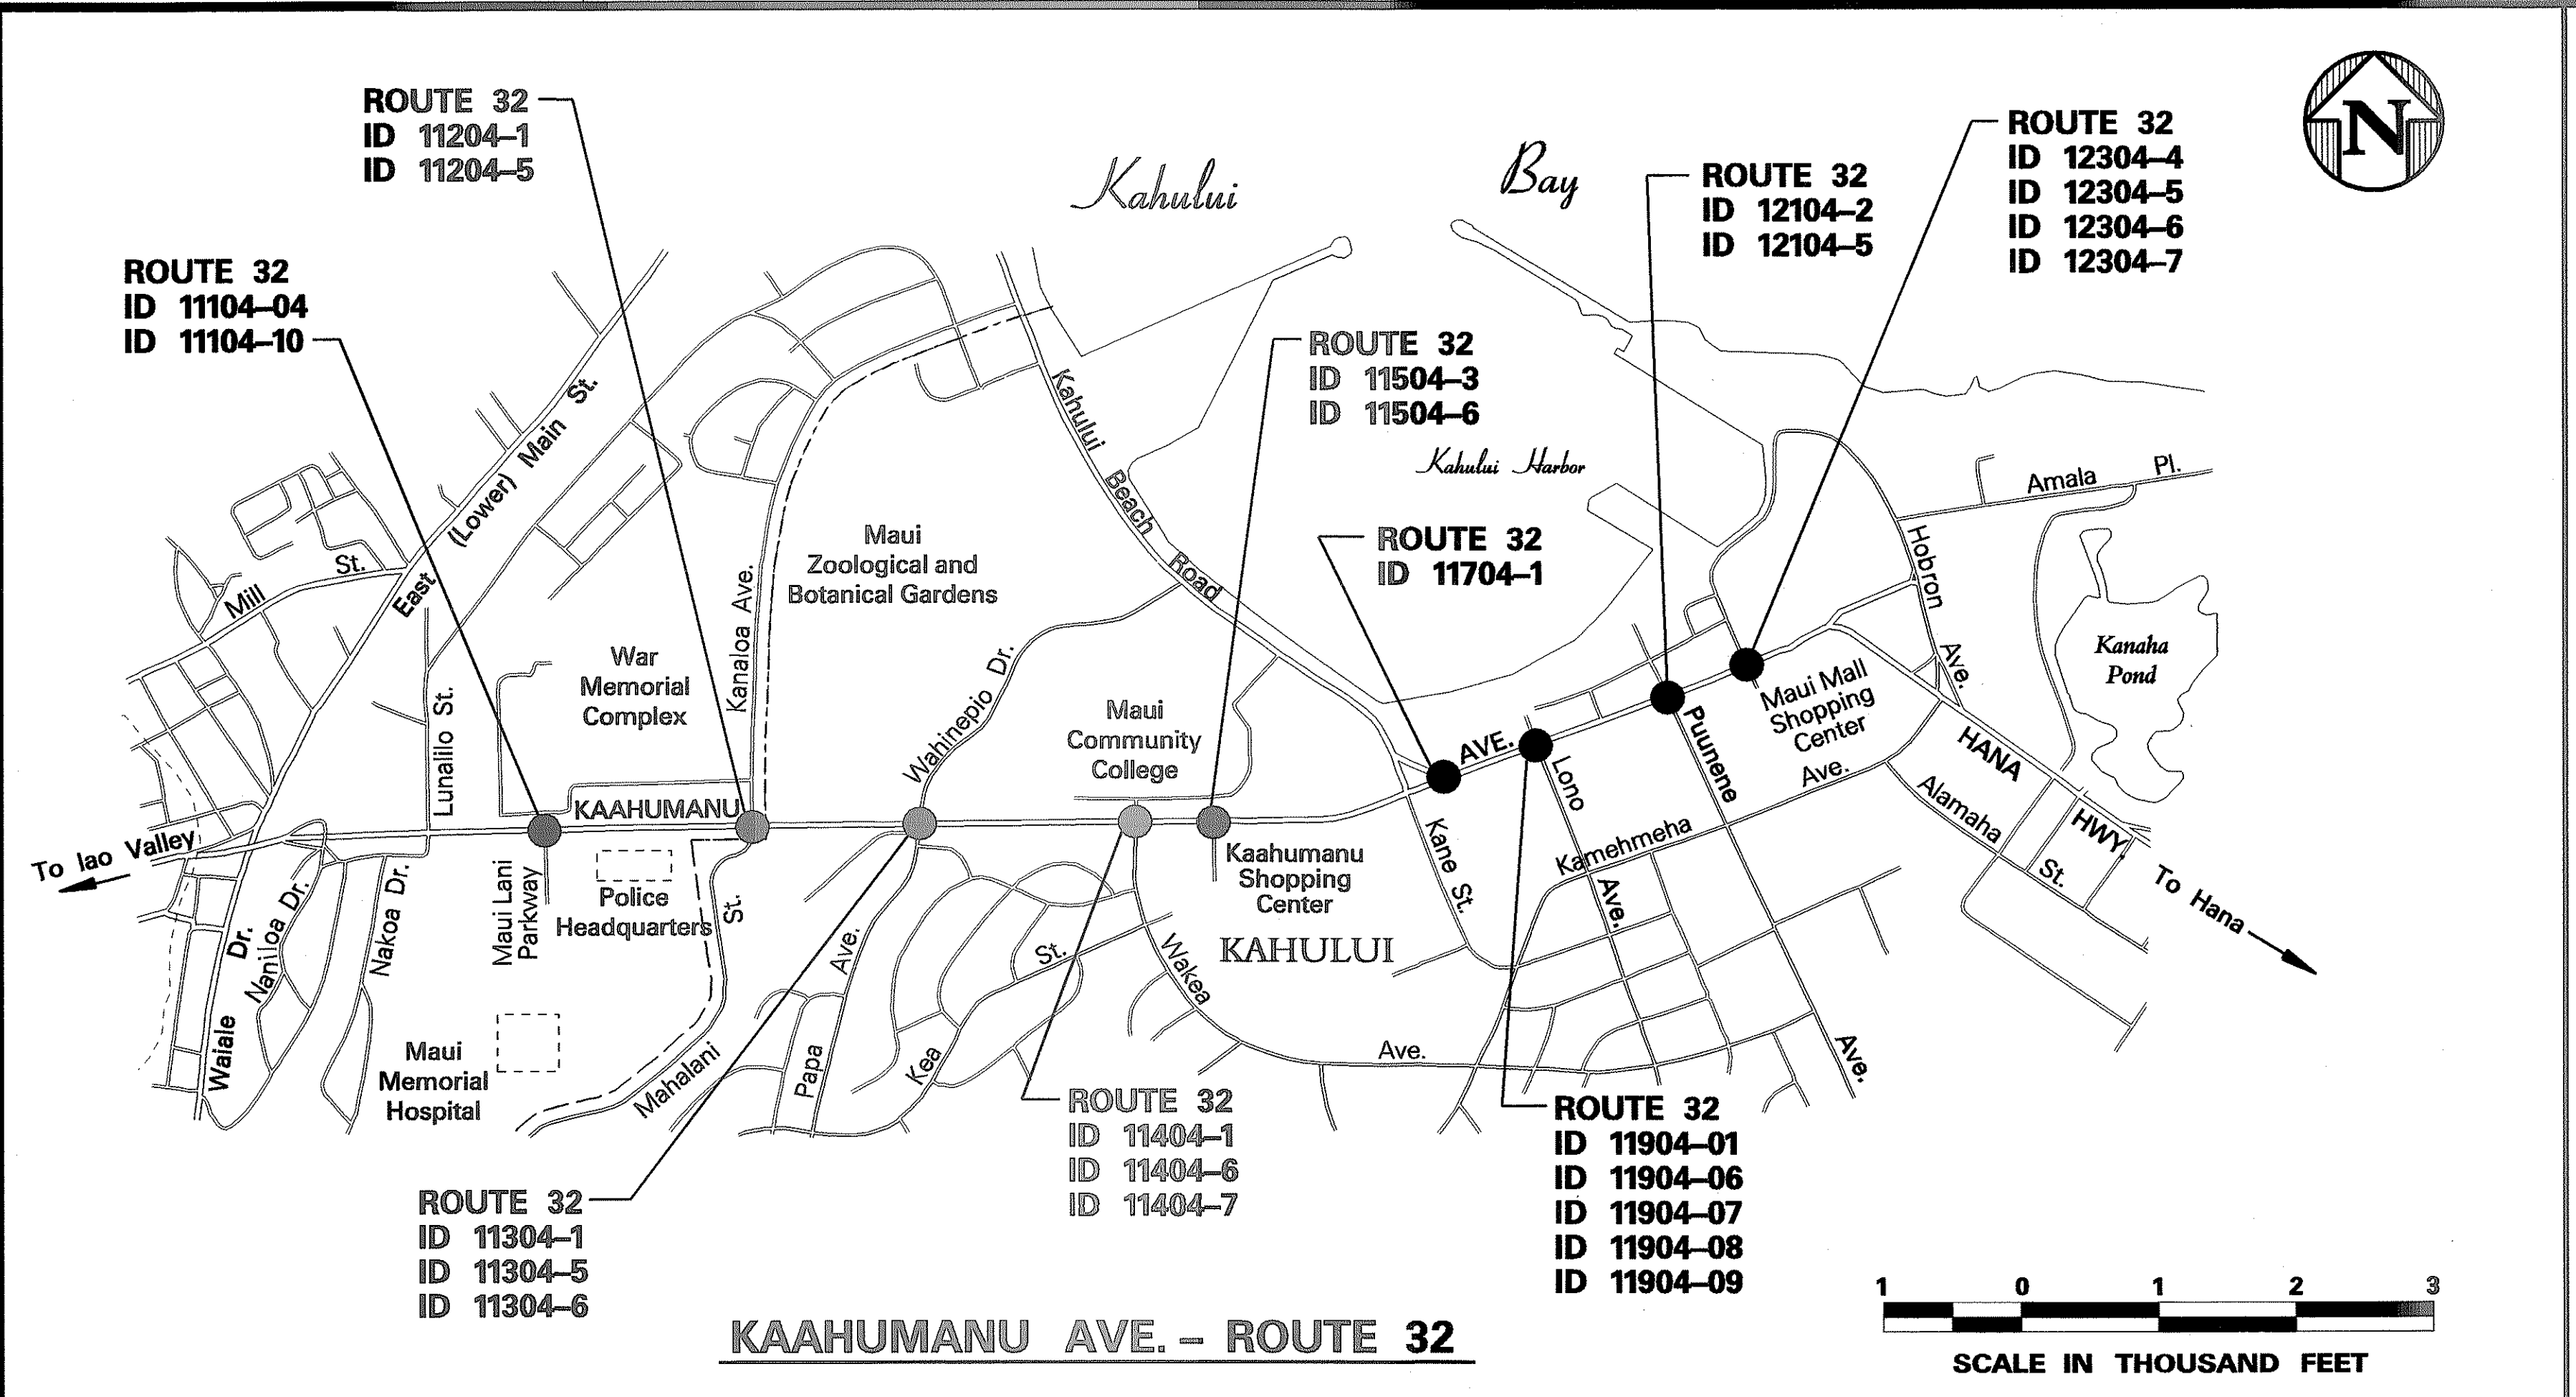

ORIGINAL PLAN	DATE
DESIGNED BY	3/05
DRAWN BY	
CHECKED BY	
APPROVED BY	

STATE OF HAWAII
DEPARTMENT OF TRANSPORTATION
HIGHWAYS DIVISION

LOCATION MAPS

**CURB RAMP REPAIRS AT
VARIOUS LOCATIONS, MAUI**

Project No. HWY-M-02-05M

Scale: As Shown Date: February, 2005

SHEET No. CC-1 OF 19 SHEETS