



DESIGNED BY	HWY-M	PAUL CHUNG	873-3535	April, 2000
		P. S. & E. BY	PHONE	DATE

DEPARTMENT OF TRANSPORTATION
HIGHWAYS DIVISION
HONOLULU, HAWAII

"AS-BUILT" PLANS FOR

DISTRICTS OF WAILUKU AND MAKAWAO
ISLAND OF MAUI

31 36

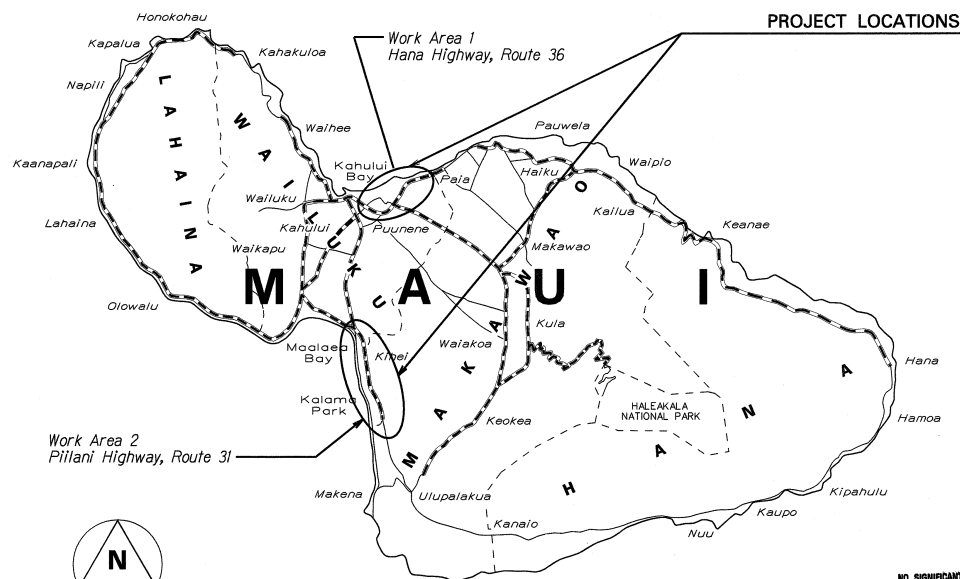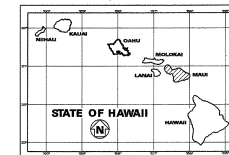

PROJECT LOCATIONS

----- FEDERAL AID PROJECTS PREVIOUSLY CONSTRUCTED
OR UNDER CONSTRUCTION

HANA HIGHWAY MILE POST 0.87 TO MILE POST 6.83
 PIILANI HIGHWAY MILE POST 0.00 TO MILE POST 7.20

DESIGN DESIGNATION

	HANA HWY.	PIILANI HWY.
ADT (1999).....	43,800	28,100
ADT (2009).....	58,500	39,800
DHV	5,000	3,400
D	75/25	55/45
T	3.5 %	3.0 %
V	50 M.P.H.	50 M.P.H.

NO SIGNIFICANT CHANGES WERE MADE DURING CONSTRUCTION ON THESE PLANS EXCEPT CHANGES IN THE ORIGINAL THEORETICAL QUANTITIES. FOR ACTUAL QUANTITIES REFER TO PROJECT LEDGER AND/OR COMPUTATION BOOK.

[Signature] 3/18/68

 ASSISTANT ENGINEER DATE

DEPARTMENT OF TRANSPORTATION
STATE OF HAWAII
APPROVED: Henry O. Chiu 9-27-
DIR. OF TRANSPORTATION DATE