

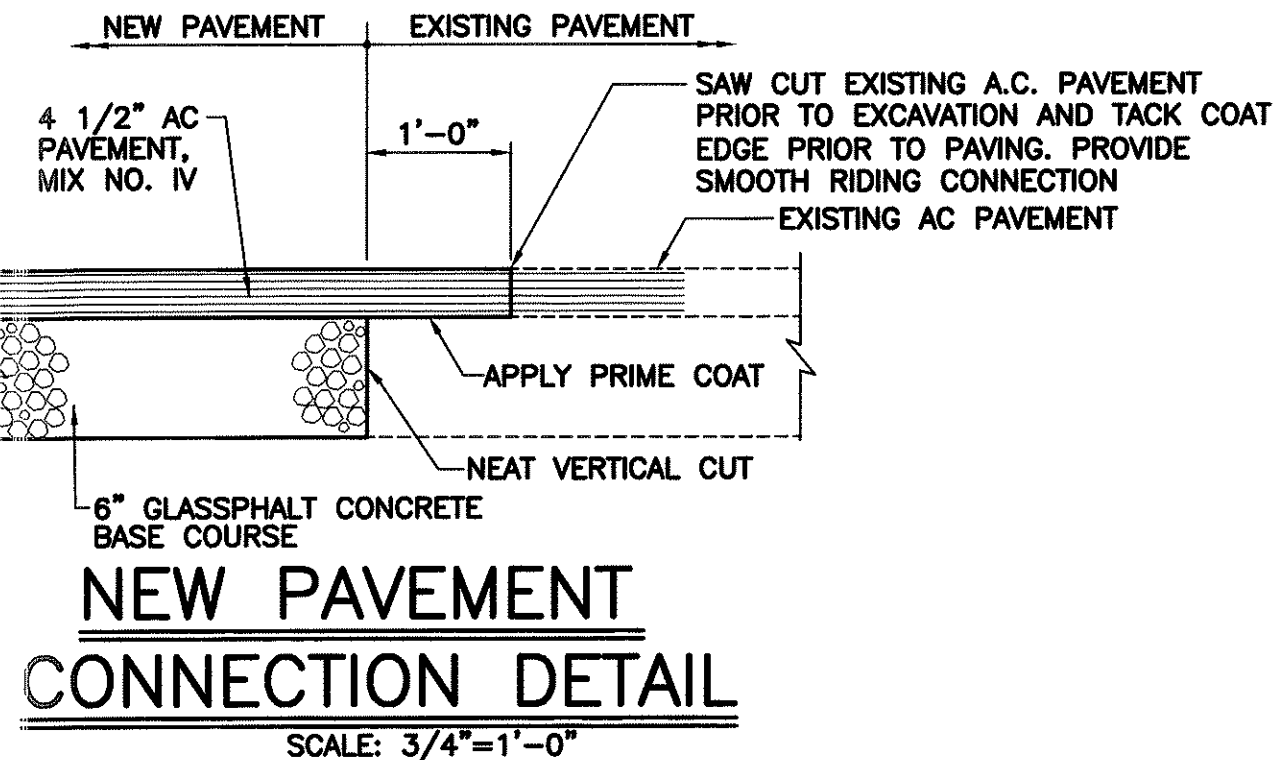
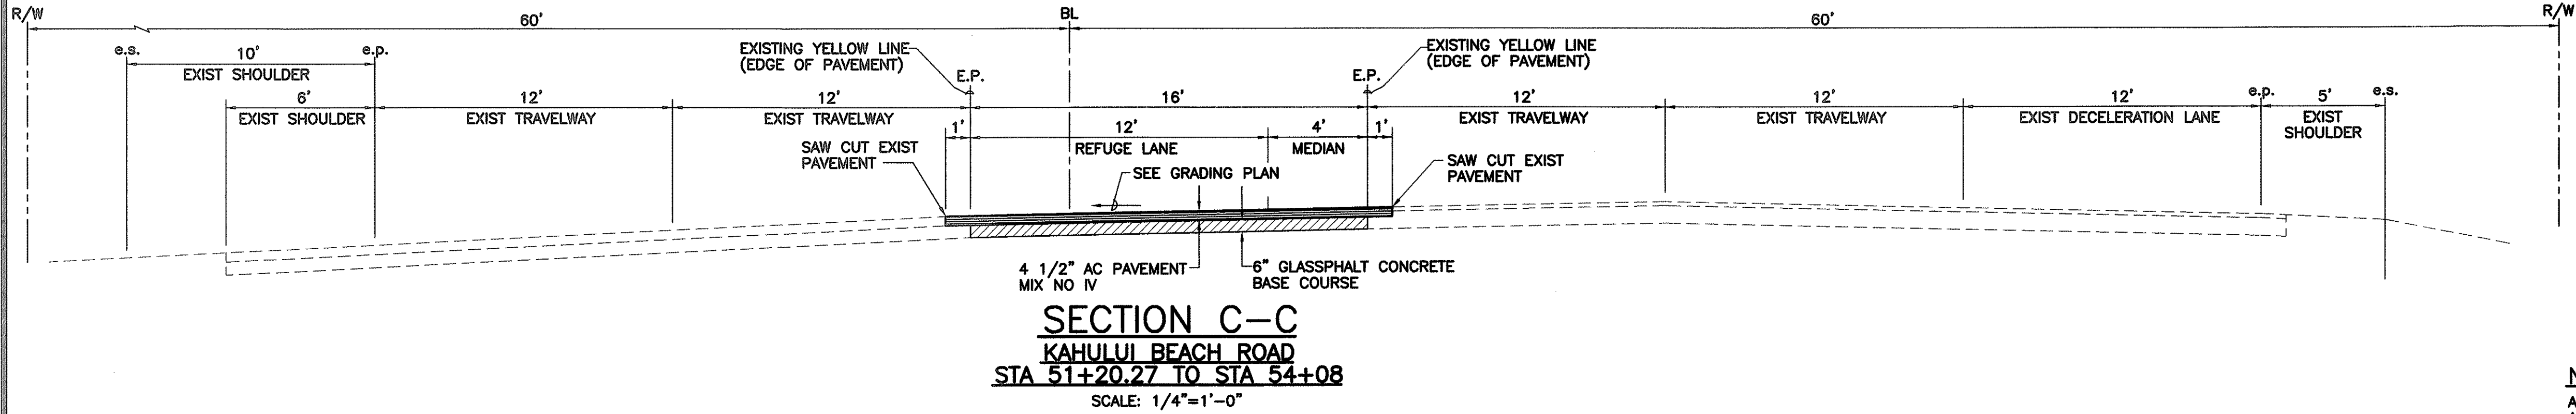
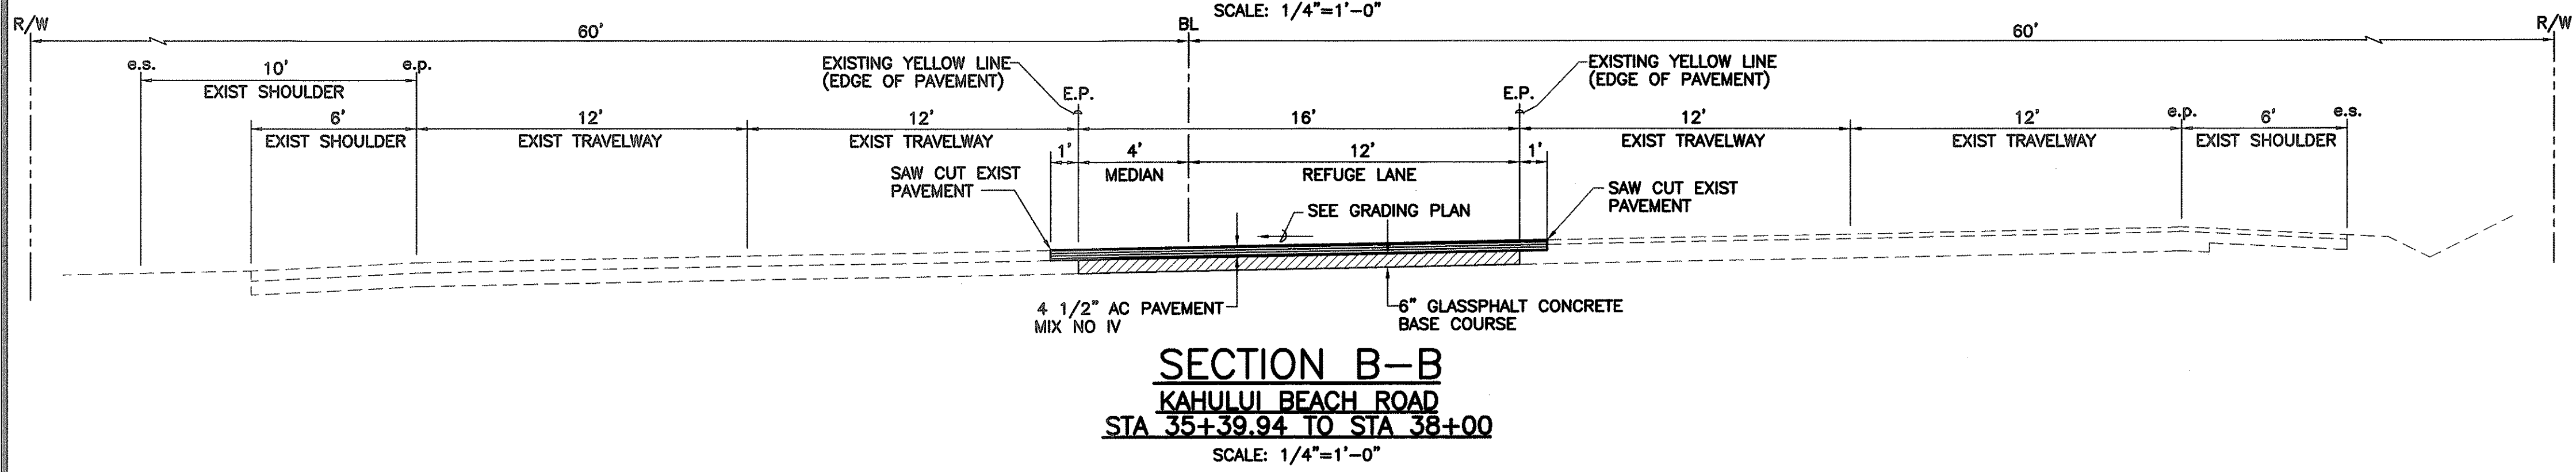



FED. ROAD DIST. NO.	STATE	PROJ. NO.	FISCAL YEAR	SHEET NO.	TOTAL SHEETS
HAWAII	HAW.	HWY-M-05-04	2004	26	33

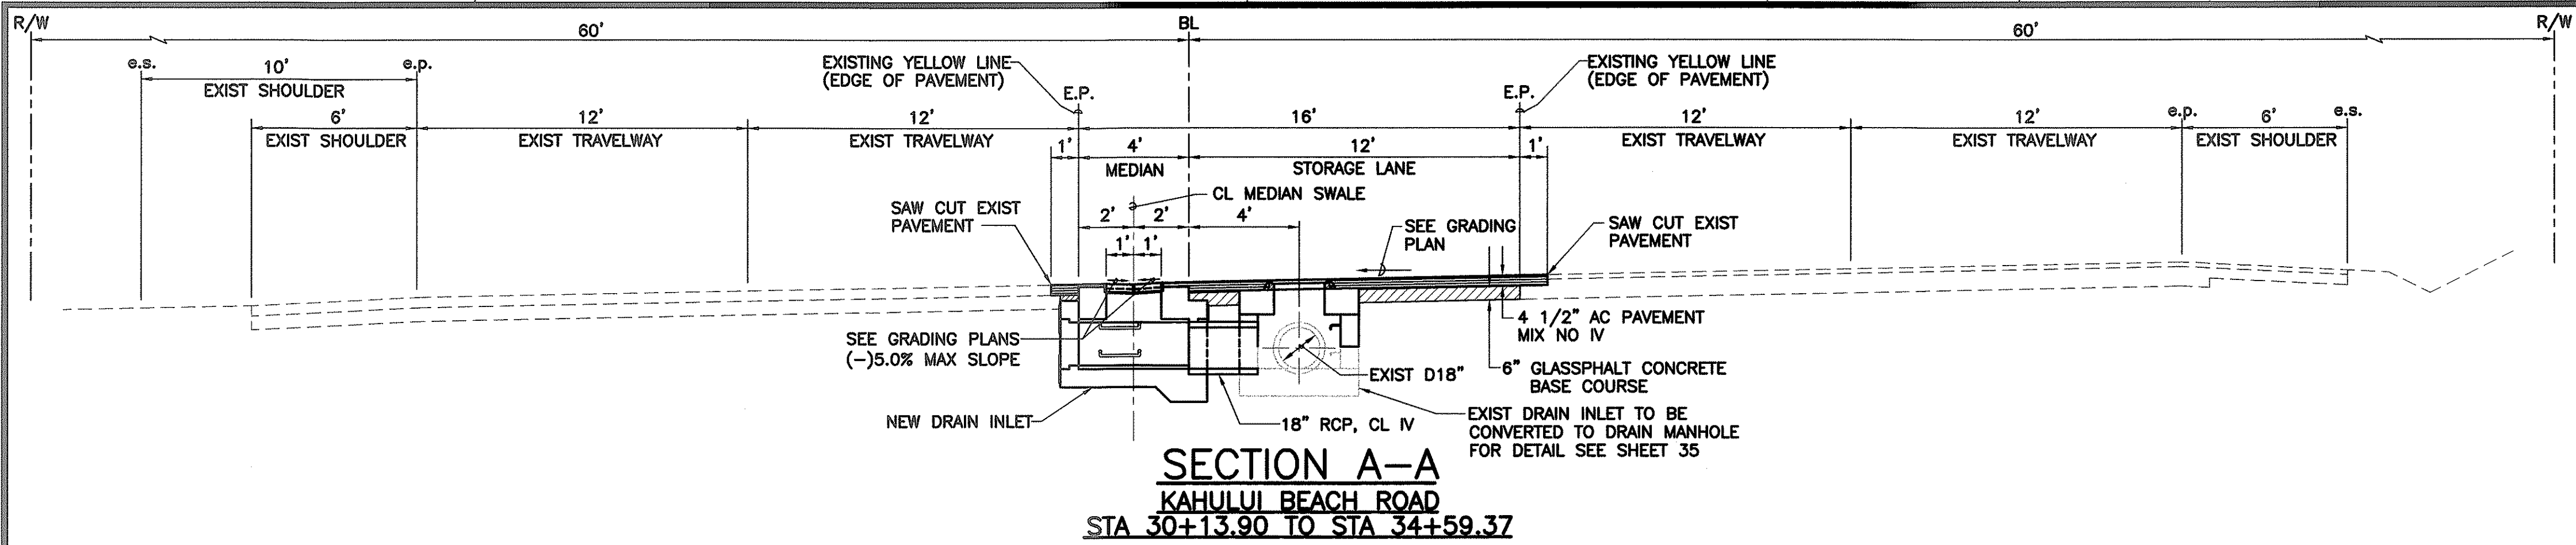


NOTE:
ALL PAVEMENT SECTIONS SHALL BE AS INDICATED OR MATCH EXISTING THICKNESS WHICHEVER IS GREATER.

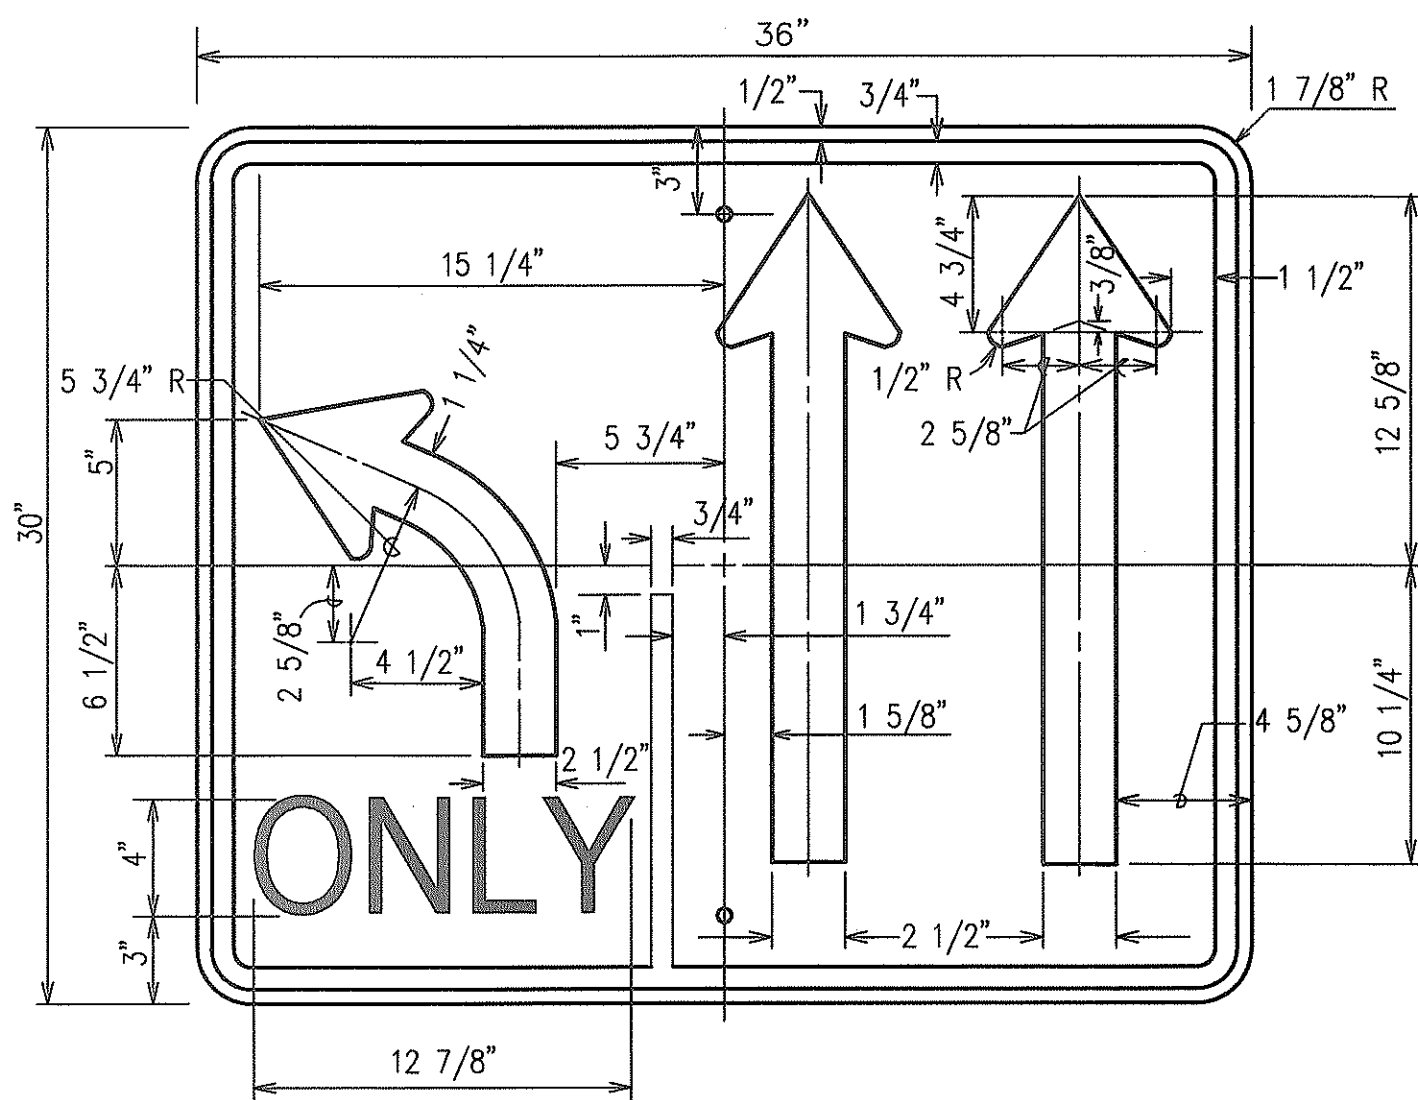

R3-8A(L)

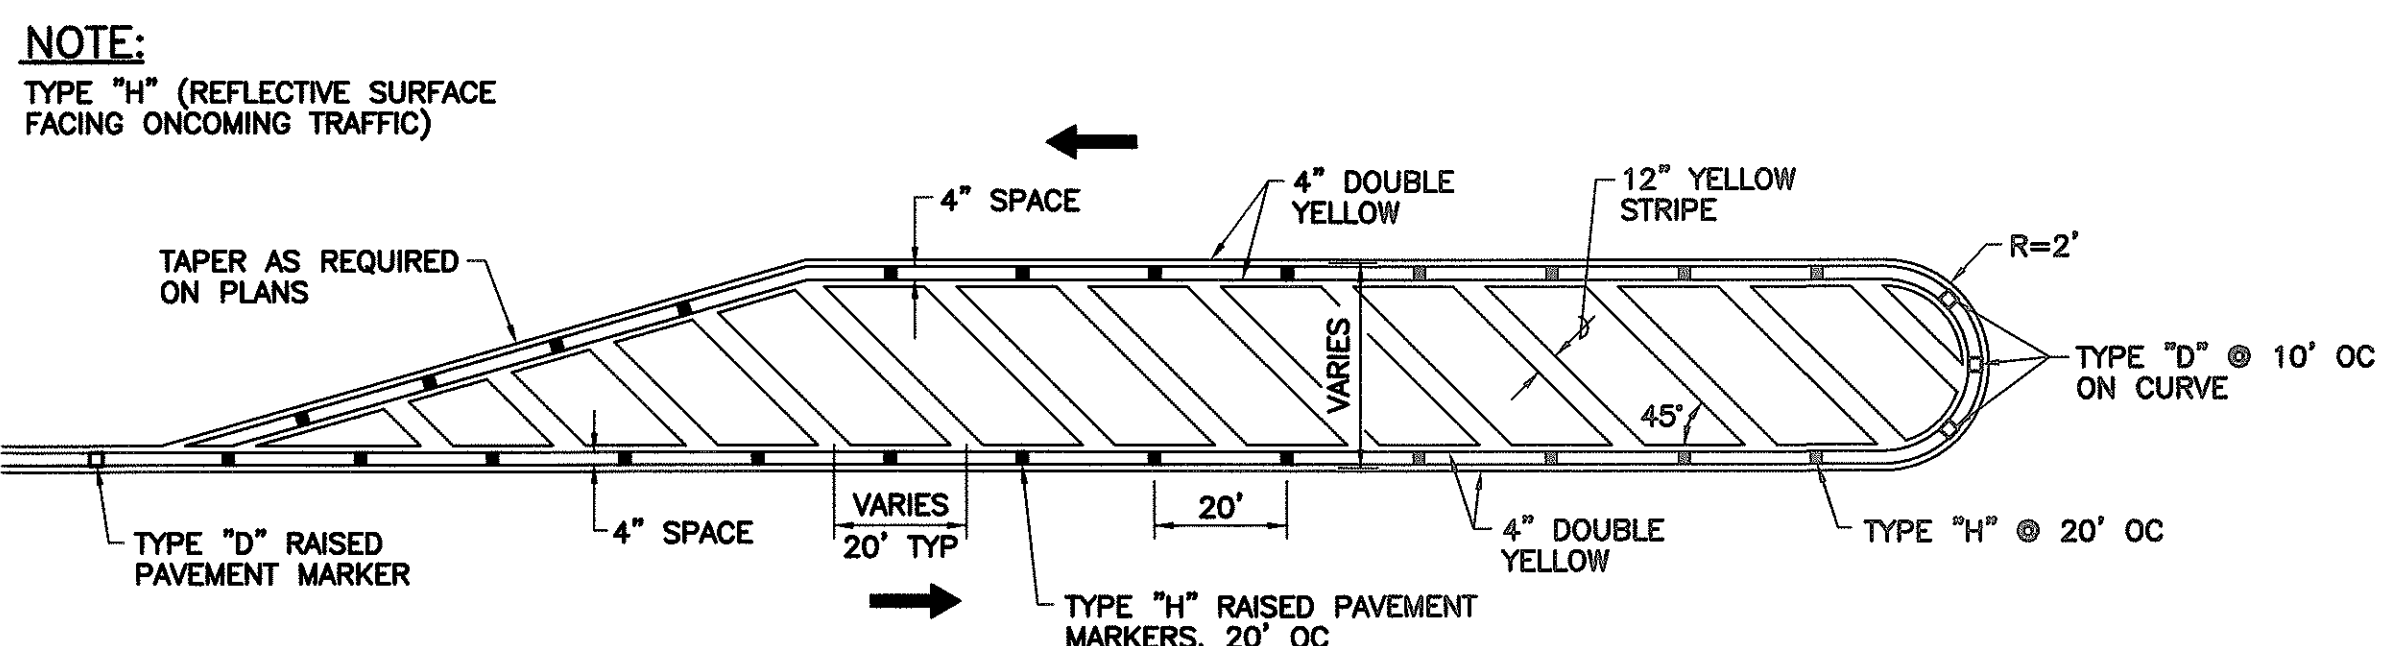

TRANSVERSE MEDIAN MARKING
NOT TO SCALE

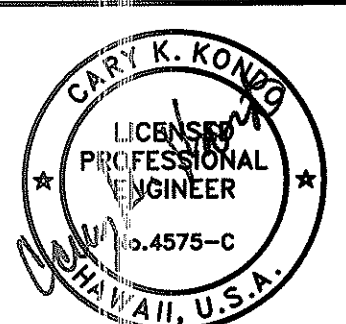

STATE OF HAWAII
DEPARTMENT OF TRANSPORTATION
HIGHWAYS DIVISION

TYPICAL SECTIONS AND DETAILS
TRAFFIC OPERATIONAL IMPROVEMENTS
AT VARIOUS LOCATIONS
KAHULUI BEACH ROAD
AT SMALL BOAT HARBOR ROAD
Project No. HWY-M-05-04
Scale: AS NOTED Date: May 2004
SHEET No. 1 OF 1 SHEETS