
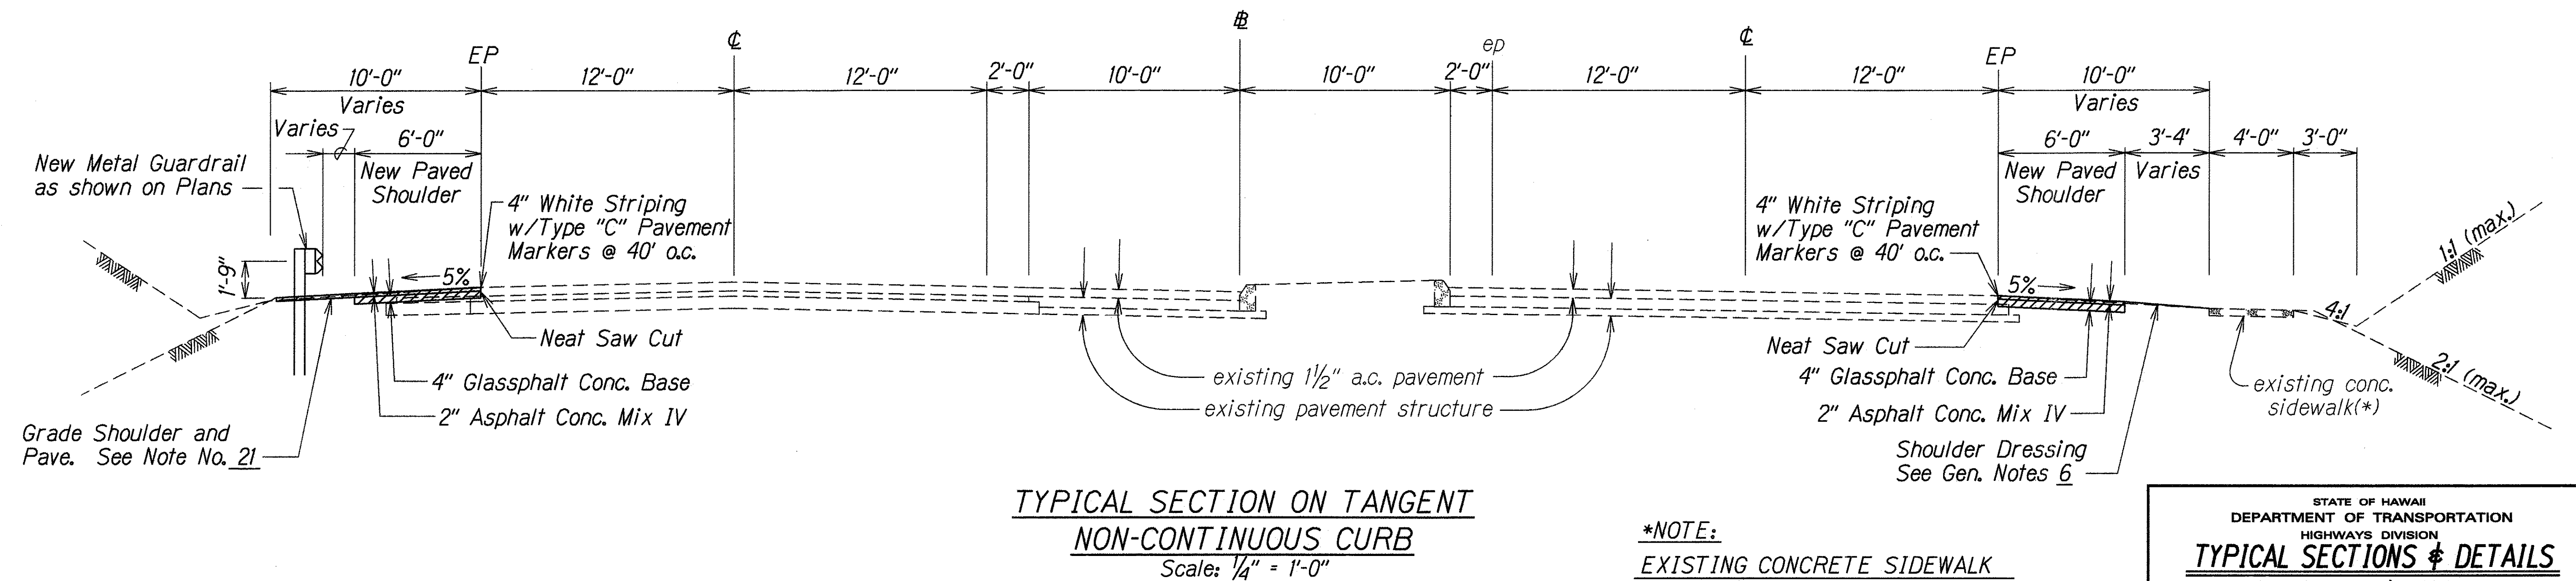


FED. ROAD DIST. NO.	STATE	FED. AID PROJ. NO.	FISCAL YEAR	SHEET NO.	TOTAL SHEETS
HAWAII	HAW.	STP-0900(34)	1997	4	20

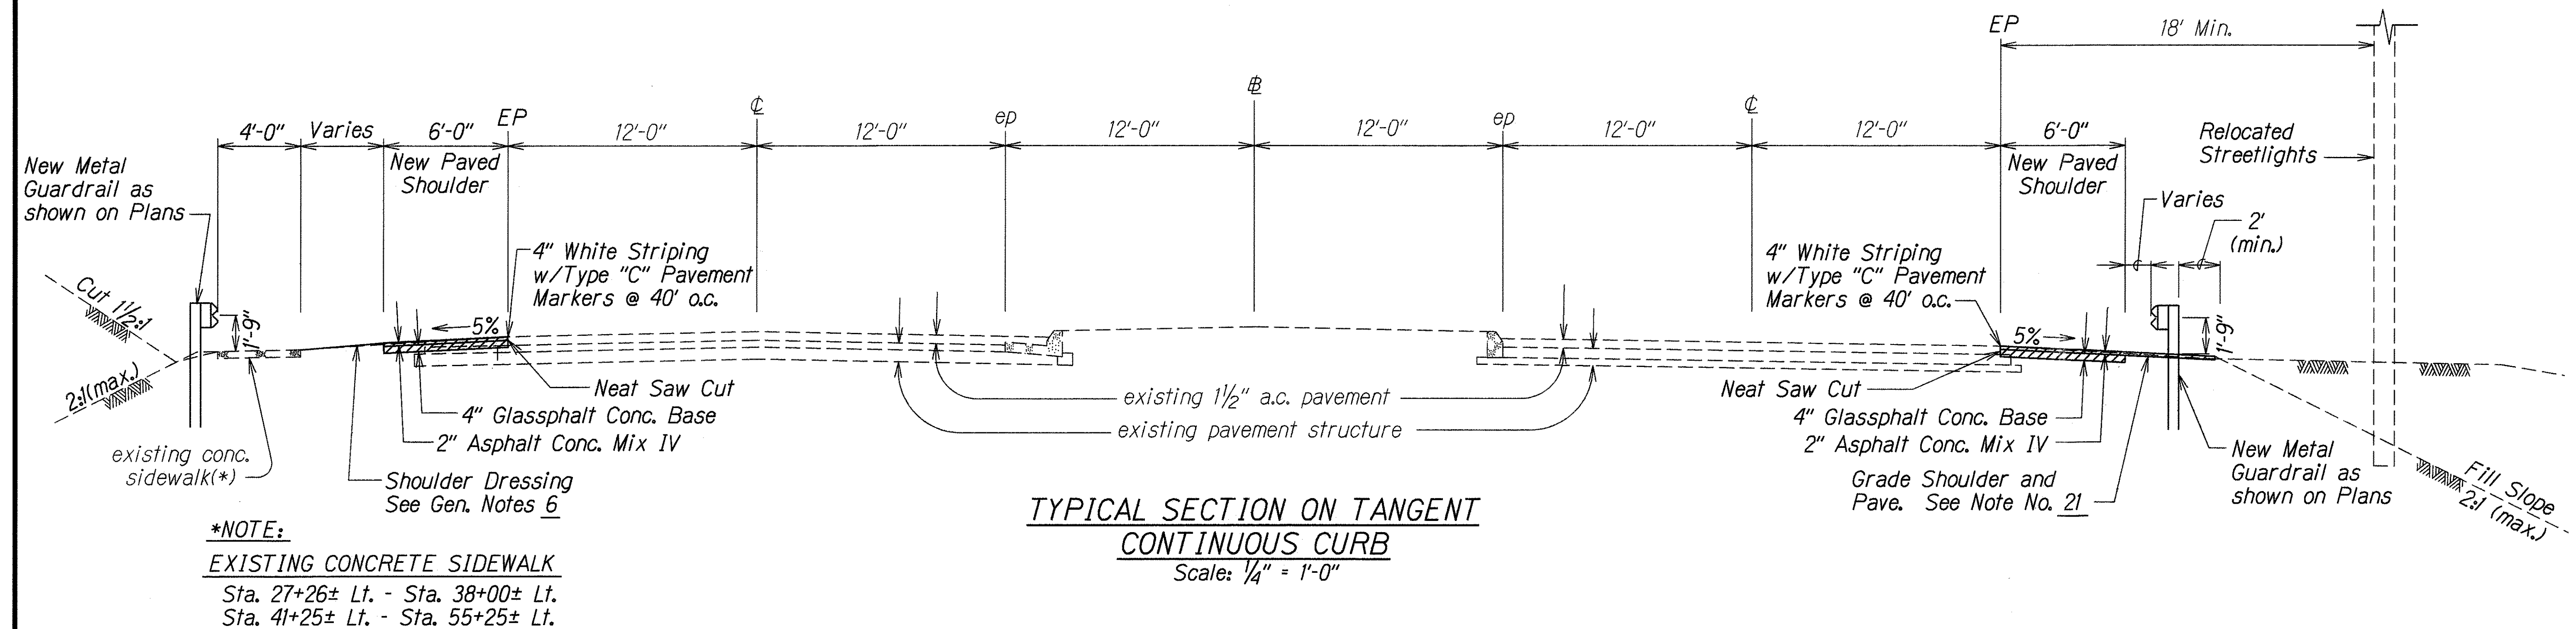

ORIGINAL PLAN	DATE	Dec. 1995
SURVEY PLOTTED BY		
DRAWN BY		
DESIGNED BY		
QUANTITIES BY		
CHECKED BY		

STATE OF HAWAII
DEPARTMENT OF TRANSPORTATION
HIGHWAYS DIVISION






TYPICAL SECTIONS & DETAILS

KAAHUMANU AVENUE & HANA HIGHWAY
GUARDRAIL & SHOULDER IMPROVEMENTS
Naniloa Drive to Kahului Beach Road &
Kahumanu Avenue to Dairy Road
Fed. Aid Project No. STP-0900(34)

Scale: As Shown Date: December, 1995

SHEET No. 1 OF 2 SHEETS

FED. ROAD DIST. NO.	STATE	FED. AID PROJ. NO.	FISCAL YEAR	SHEET NO.	TOTAL SHEETS
HAWAII	HAW.	STP-0900(34)	1997	5	20

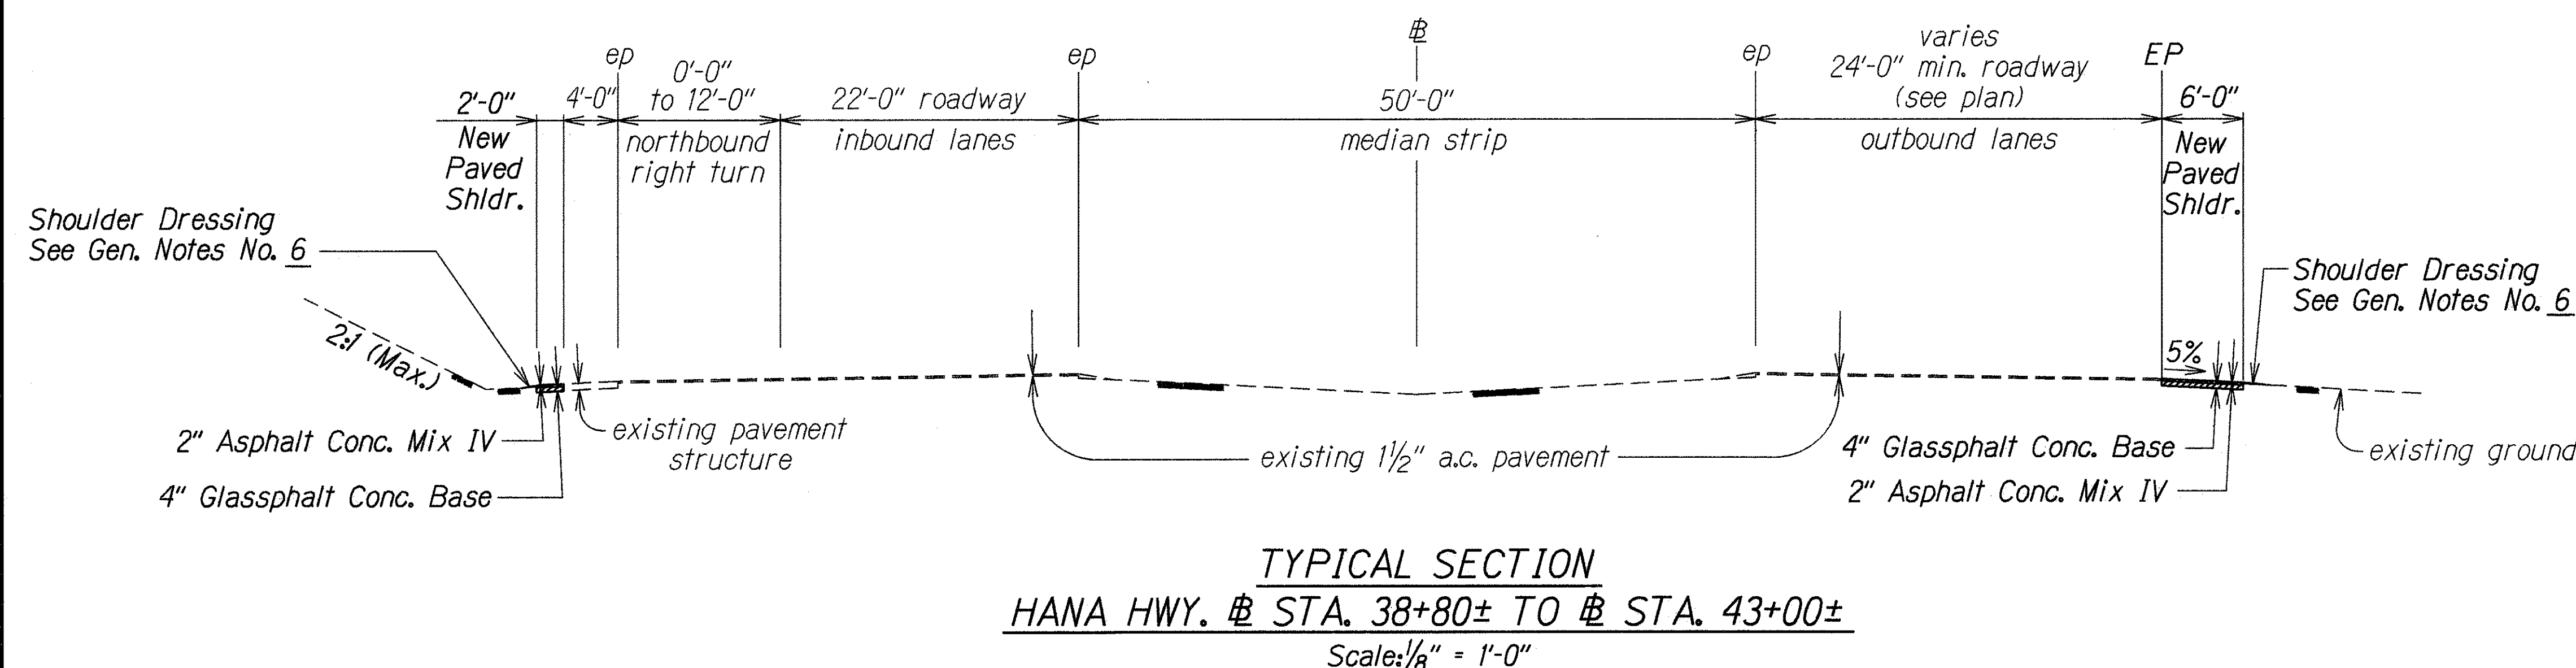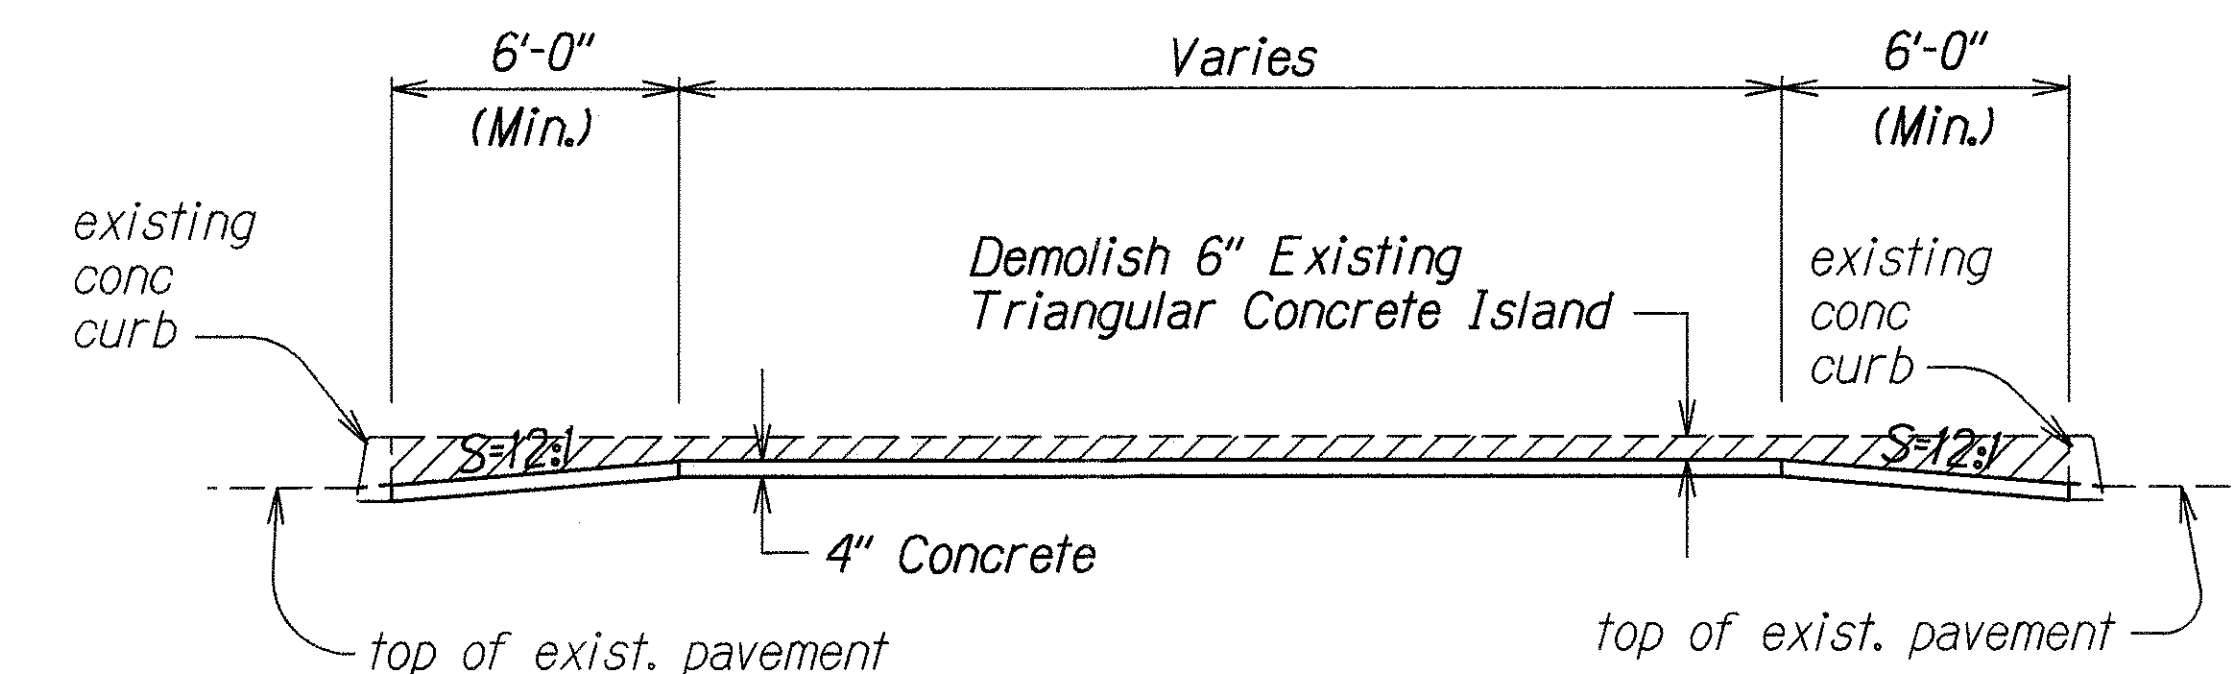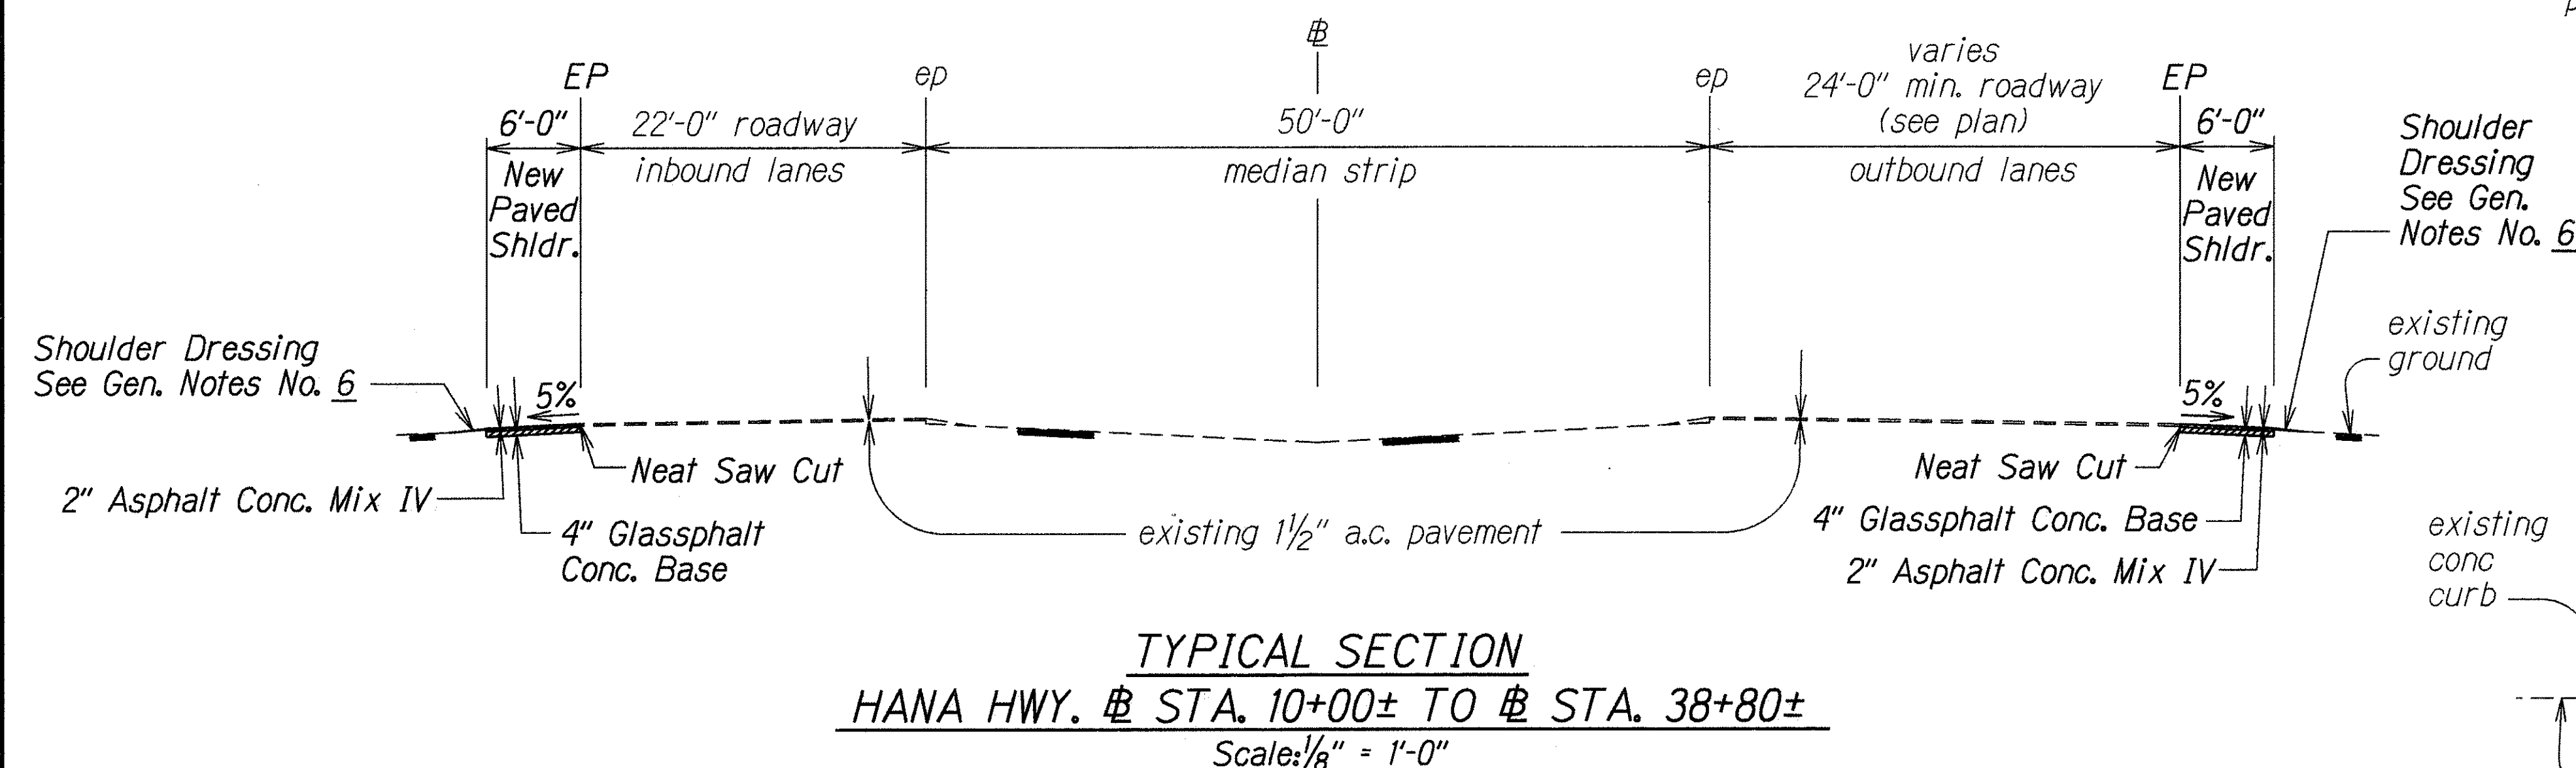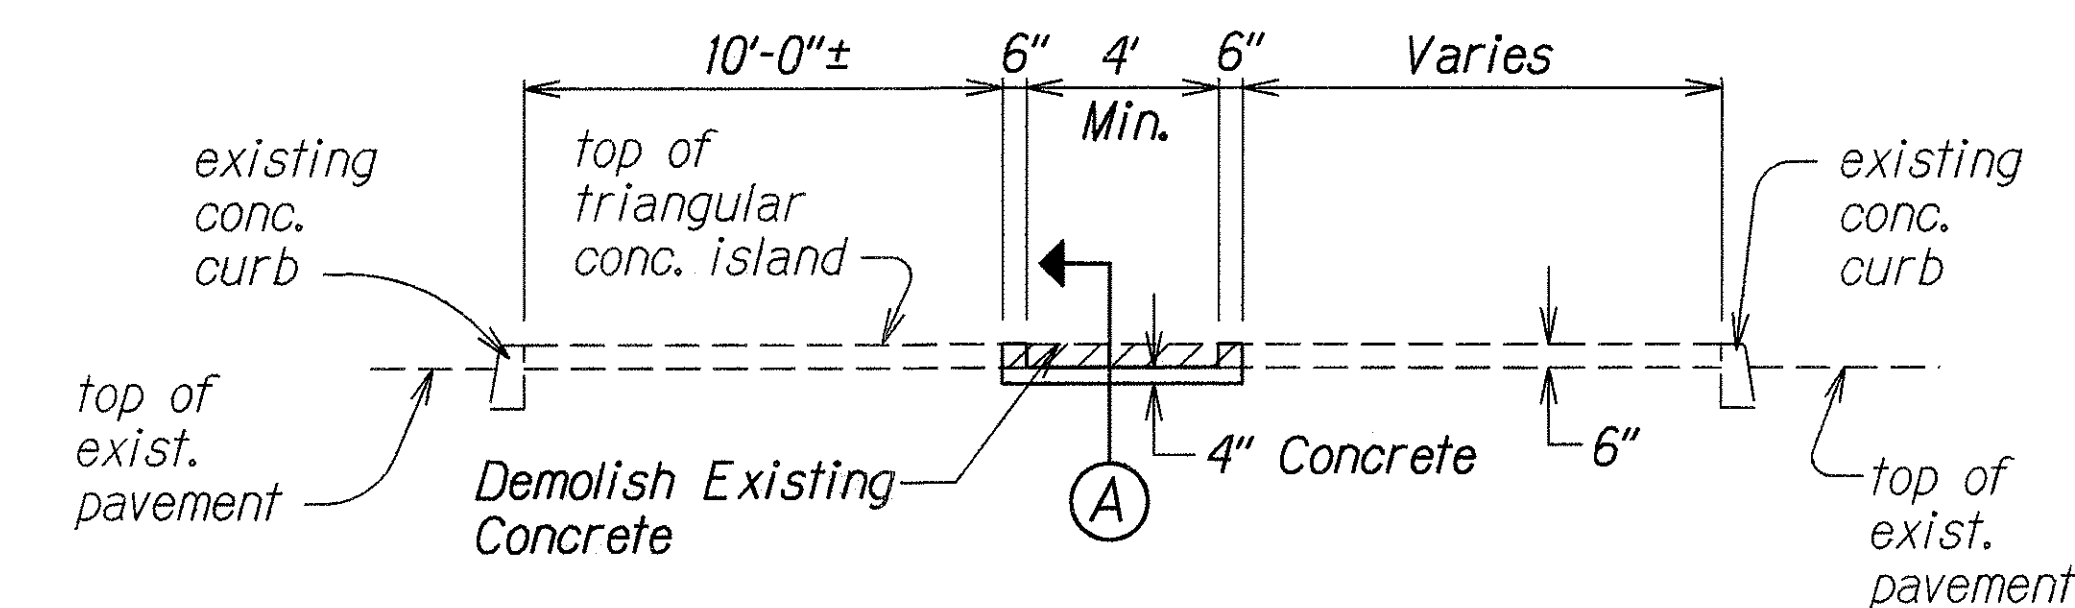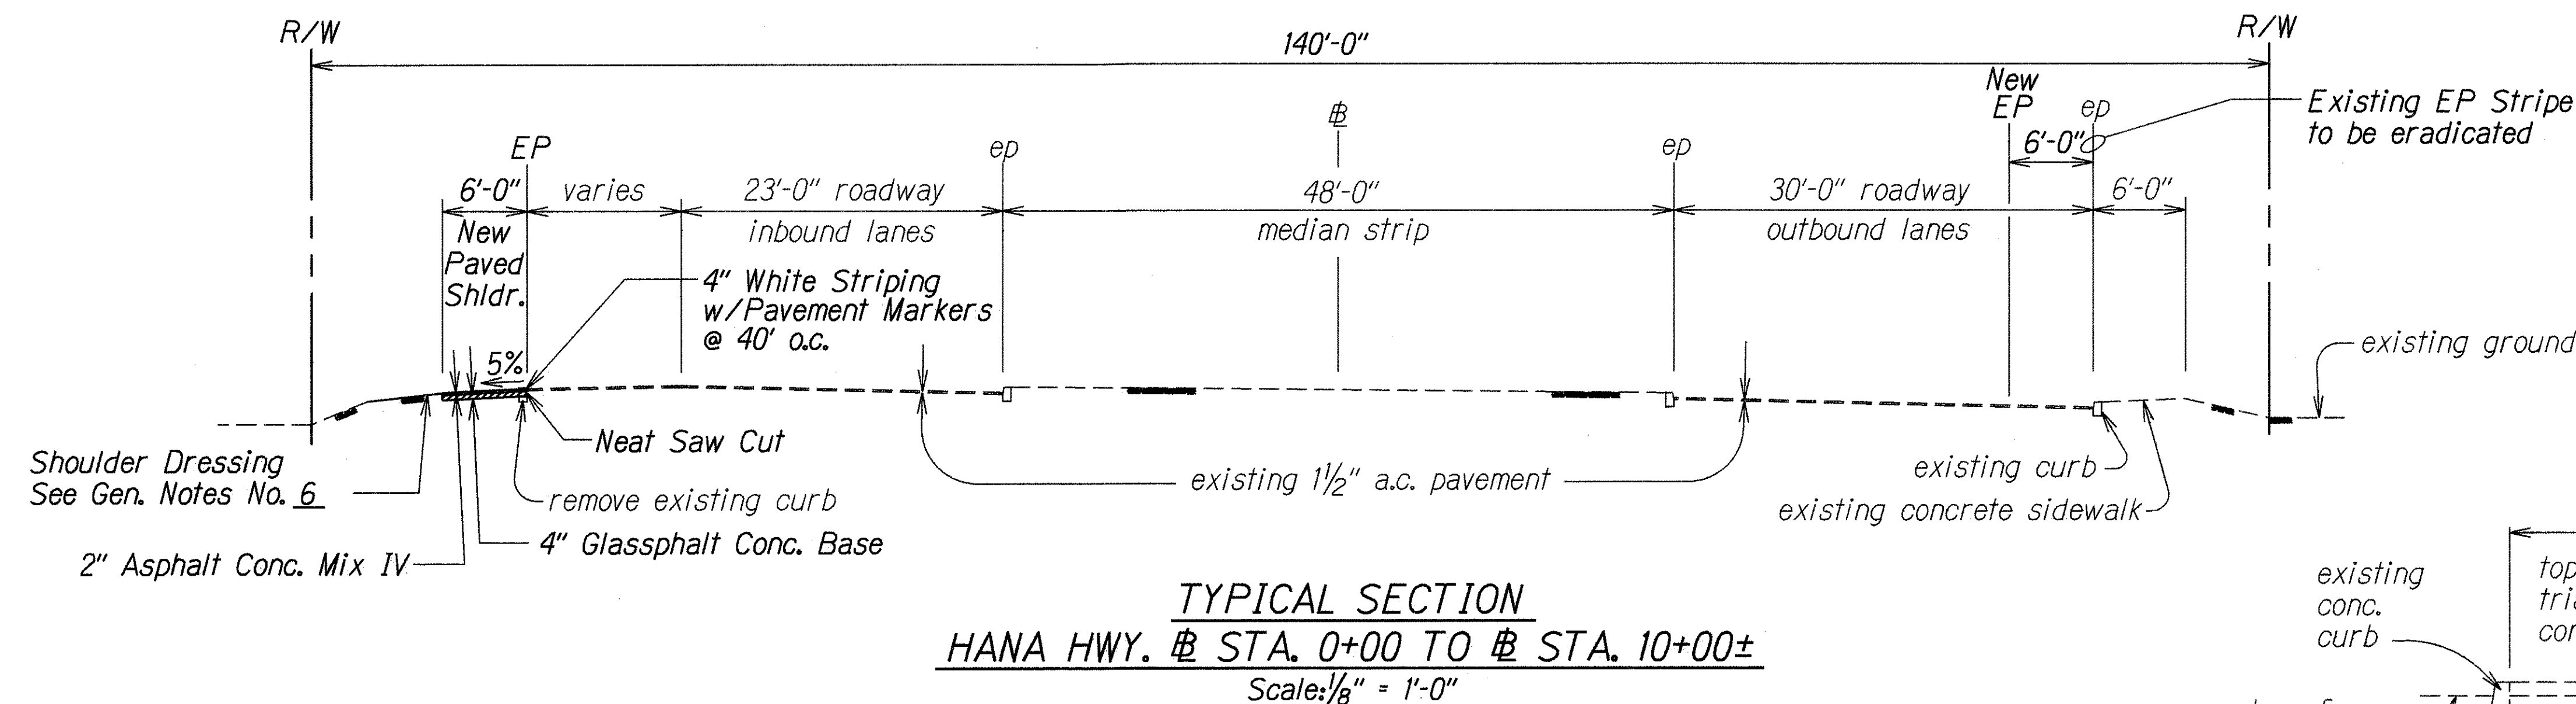

SURVEY PLOTTED BY	DATE
DRAWN BY	Dec. 1995
TRACED BY	
CHECKED BY	
QUANTITIES BY	
ORIGINAL PLAN	
NOTE BOOK	
STAMPED BY	
CHECKED BY	

STATE OF HAWAII
 DEPARTMENT OF TRANSPORTATION
 HIGHWAYS DIVISION

TYPICAL SECTIONS & DETAILS
KAAHUMANU AVENUE & HANA HIGHWAY
GUARDRAIL & SHOULDER IMPROVEMENTS
 Naniloa Drive to Kahului Beach Road &
 Kaahumanu Avenue to Dairy Road
 Fed. Aid Project No. STP-0900(34)

Scale: As Shown Date: December, 1995

SHEET No. 2 OF 2 SHEETS