


FED. ROAD DIST. NO.	STATE	FED. AID PROJ. NO.	FISCAL YEAR	SHEET NO.	TOTAL SHEETS
HAWAII	HAW.	STP-0900(60)	2002	7	33

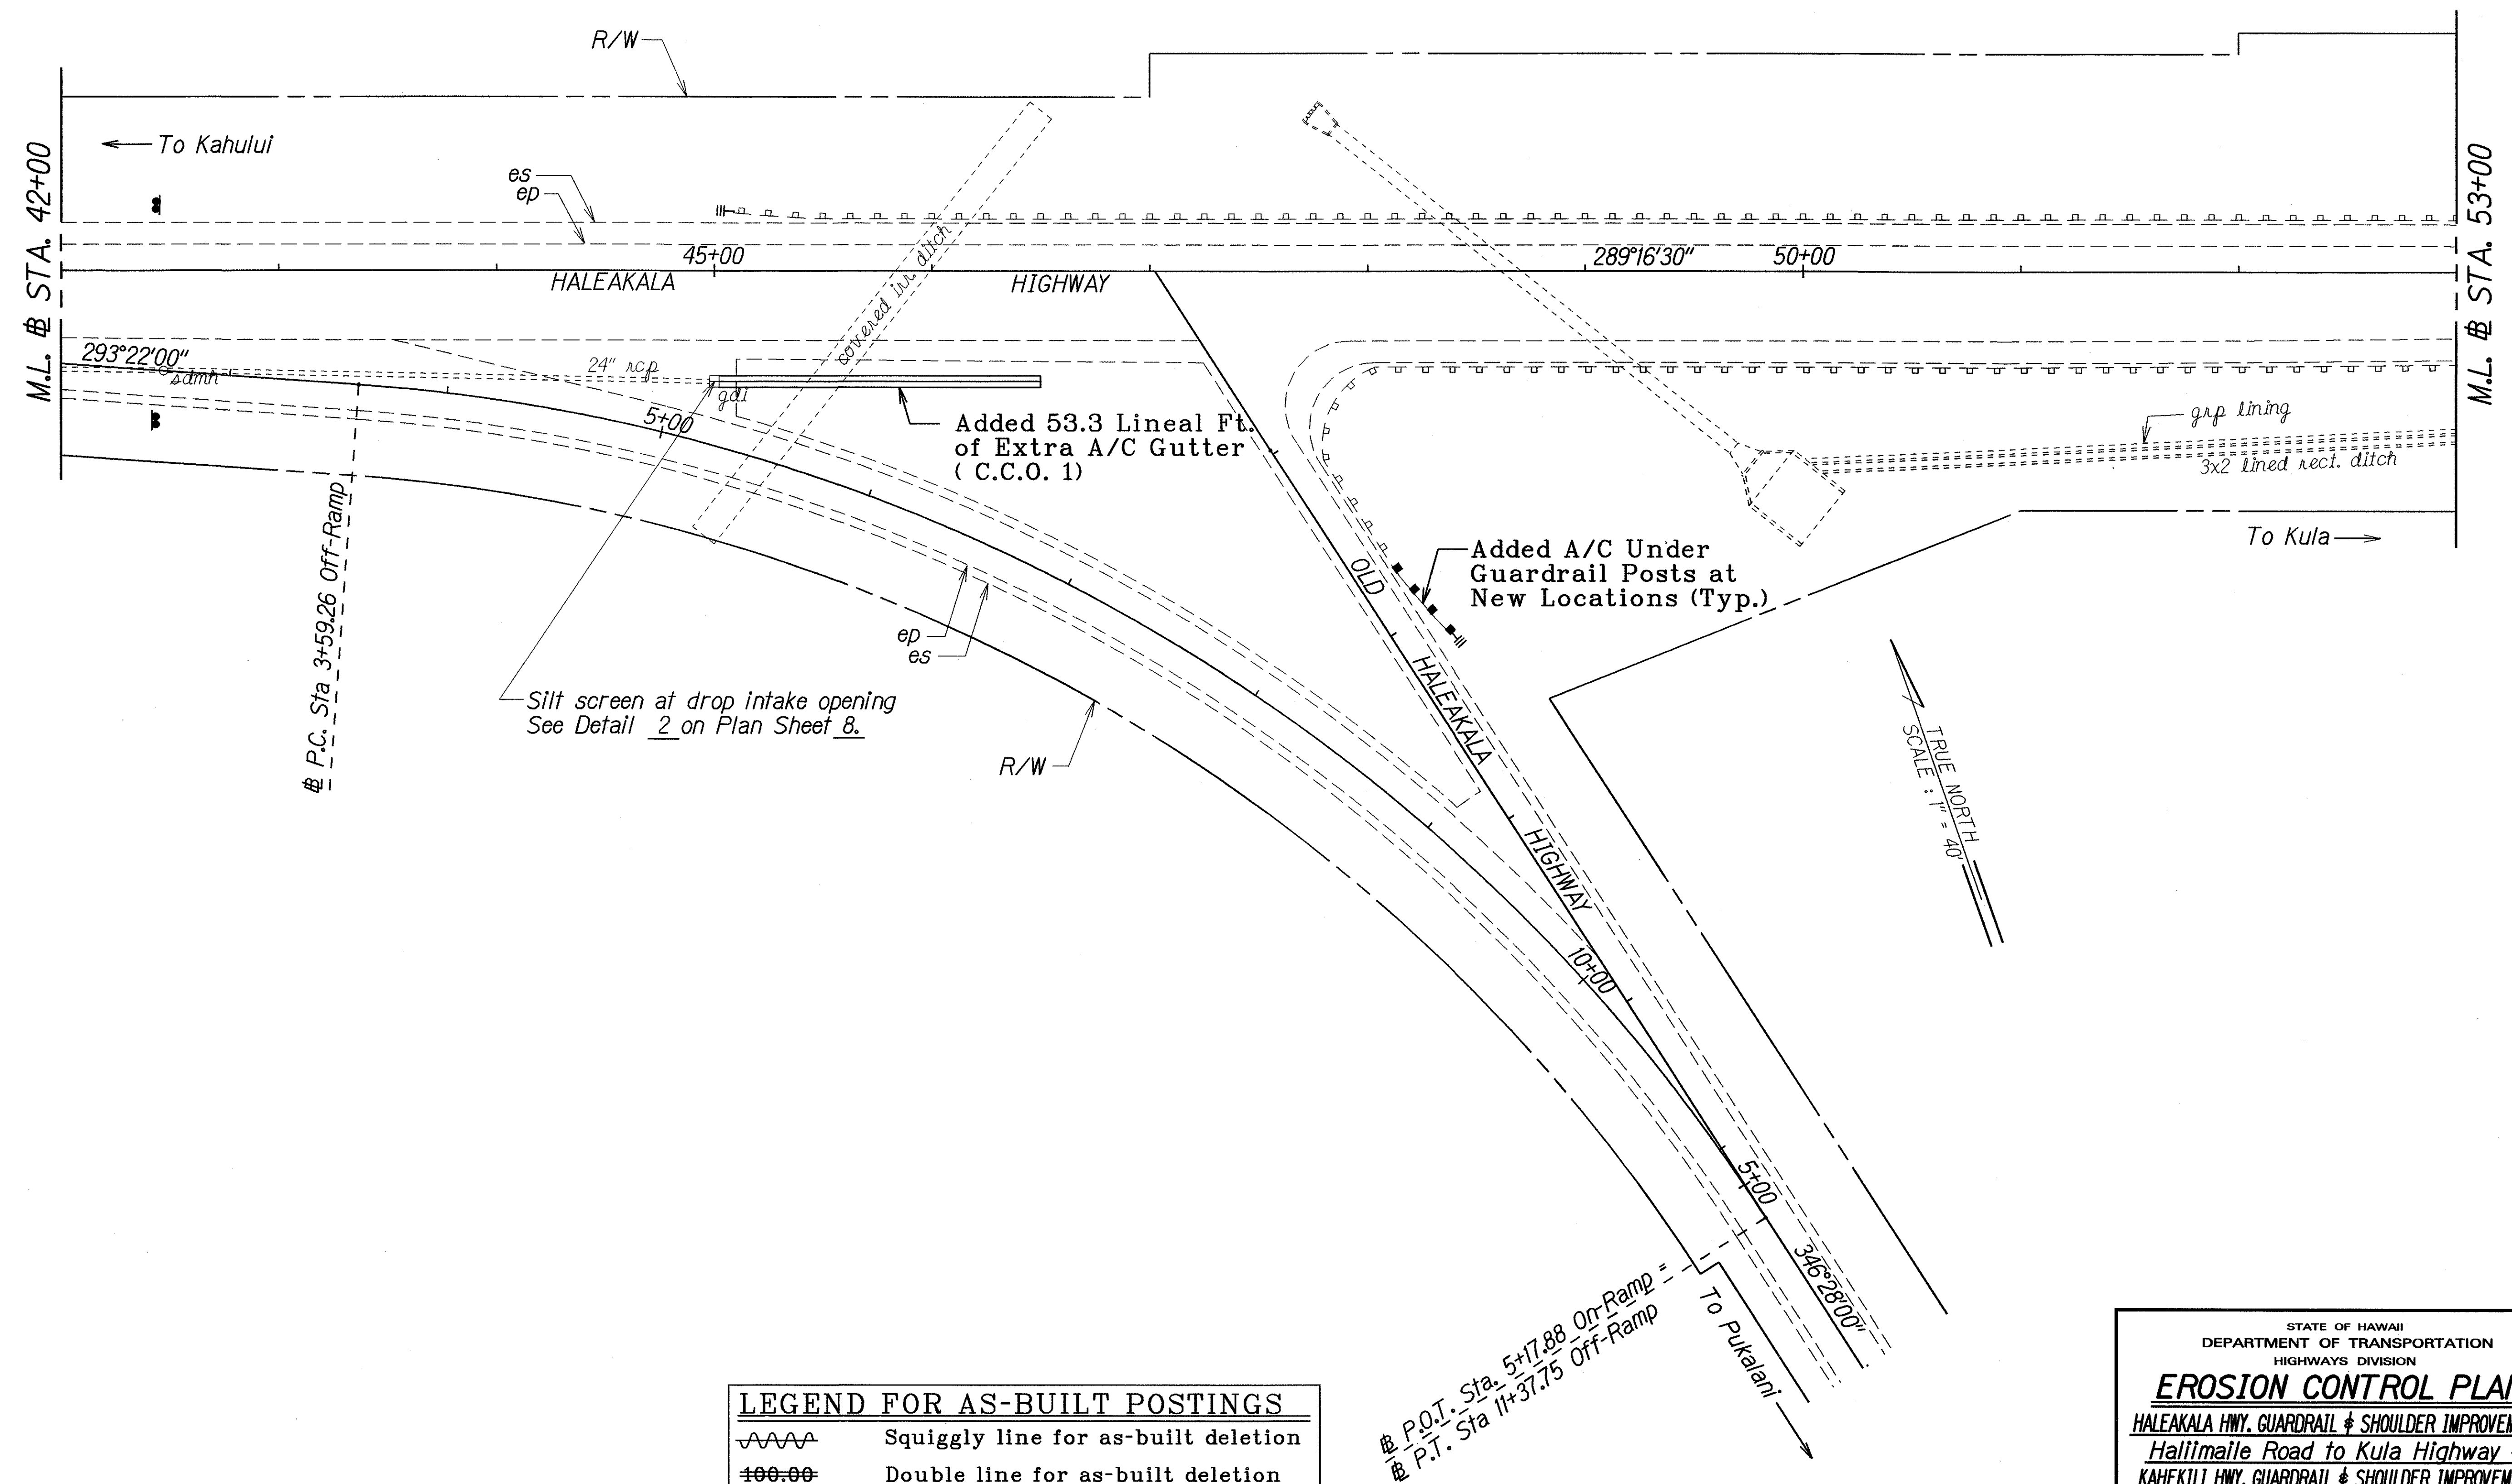

TRUE NORTH
SCALE: 1" = 40'

LEGEND FOR AS-BUILT POSTINGS	
	Squiggly line for as-built deletion
	Double line for as-built deletion
Roadway	Text for as-built posting

STATE OF HAWAII
DEPARTMENT OF TRANSPORTATION
HIGHWAYS DIVISION

EROSION CONTROL PLANS
HALEAKALA HWY. GUARDRAIL & SHOULDER IMPROVEMENTS
Haliimaile Road to Kula Highway &
KAHEKILI HWY. GUARDRAIL & SHOULDER IMPROVEMENTS
at Waihee Bridge and Approaches
Federal Aid Proj. No. STP-0900(60)
Scale: 1" = 40' Date: Jan., 2001

SHEET No. 1 OF 2 SHEETS

SURVEY PLOTTED BY	DATE
DRAWN BY	DEC 01
DESIGNED BY	
NOTED BY	
QUANTITIES BY	
CHECKED BY	


"AS-BUILT"

FED. ROAD DIST. NO.	STATE	FED. AID PROJ. NO.	FISCAL YEAR	SHEET NO.	TOTAL SHEETS
HAWAII	HAW.	STP-0900(60)	2002	8	33

☺ CURVE DATA
 $\Delta = 21^{\circ}15'00''$
 $R = 100.00'$
 $T = 18.76'$
 $C = 36.88'$
 $L = 37.09'$


☺ CURVE DATA
 $\Delta = 82^{\circ}49'00''$
 $R = 50.00'$
 $T = 44.09'$
 $C = 66.14'$
 $L = 72.27'$

☺ CURVE DATA
 $\Delta = 66^{\circ}00'00''$
 $R = 175.00'$
 $T = 113.65'$
 $C = 190.62'$
 $L = 201.59'$

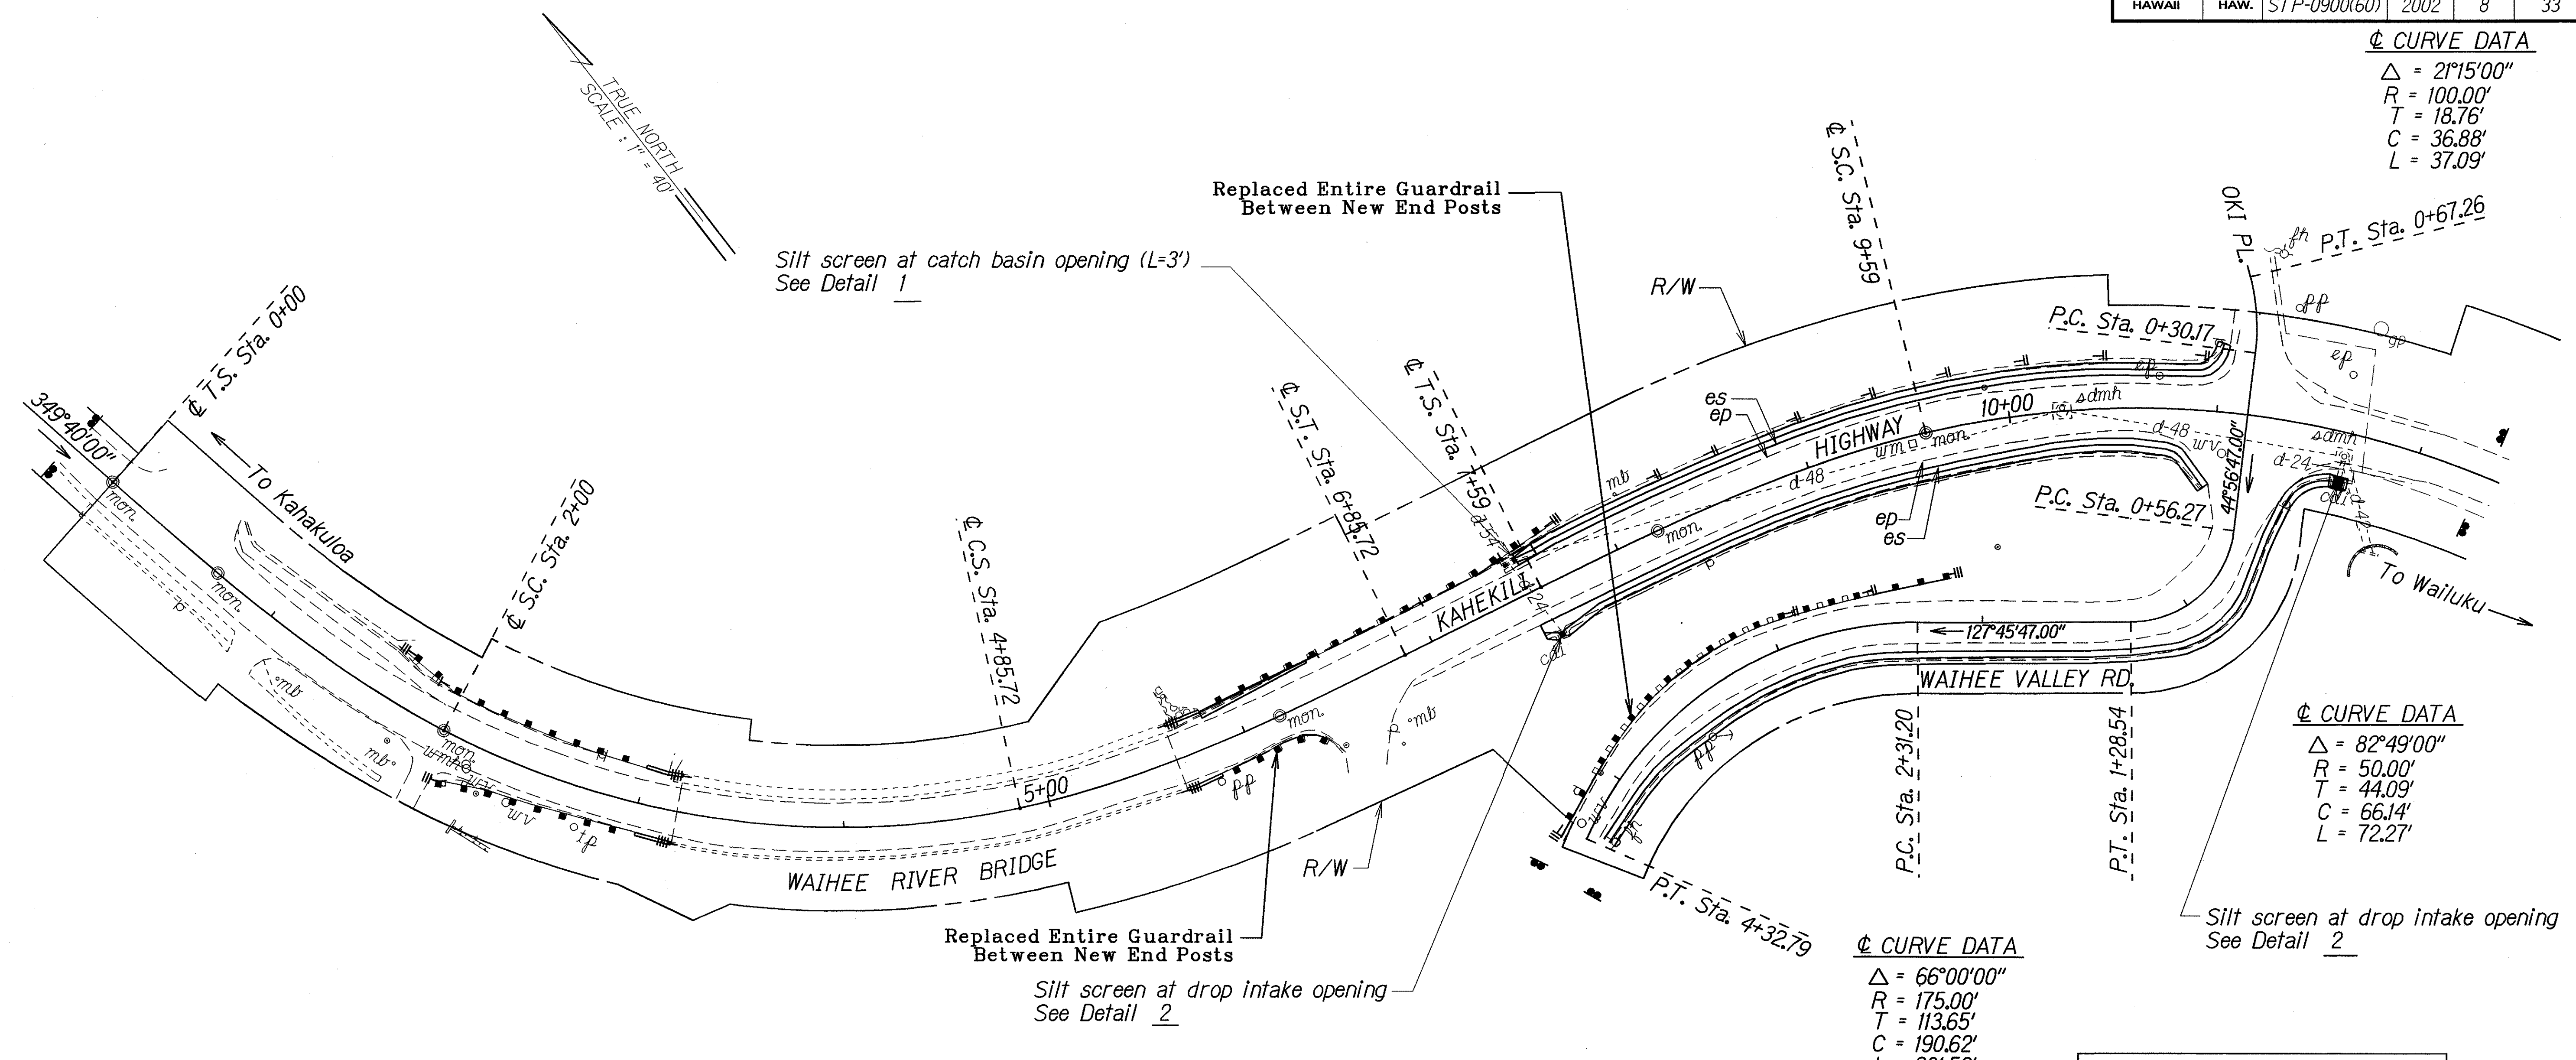


LEGEND FOR AS-BUILT POSTINGS

	Squiggly line for as-built deletion
	Double line for as-built deletion
Roadway	Text for as-built posting

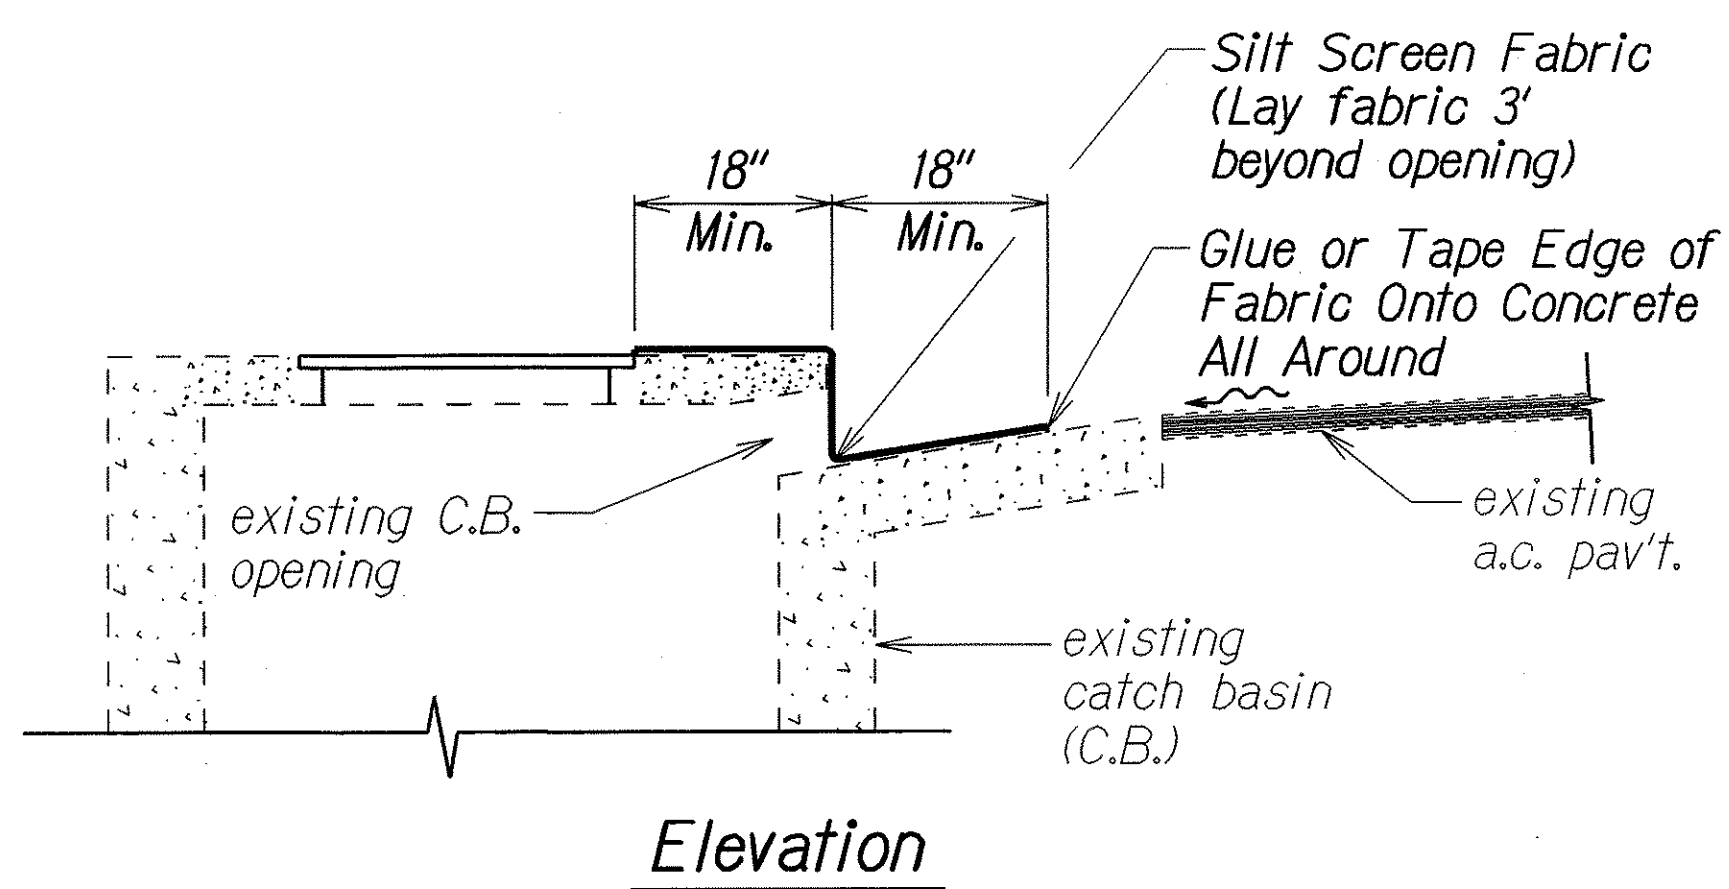

DETAIL 1 - SILT SCREEN AT C.B. OPENING
 Not to Scale

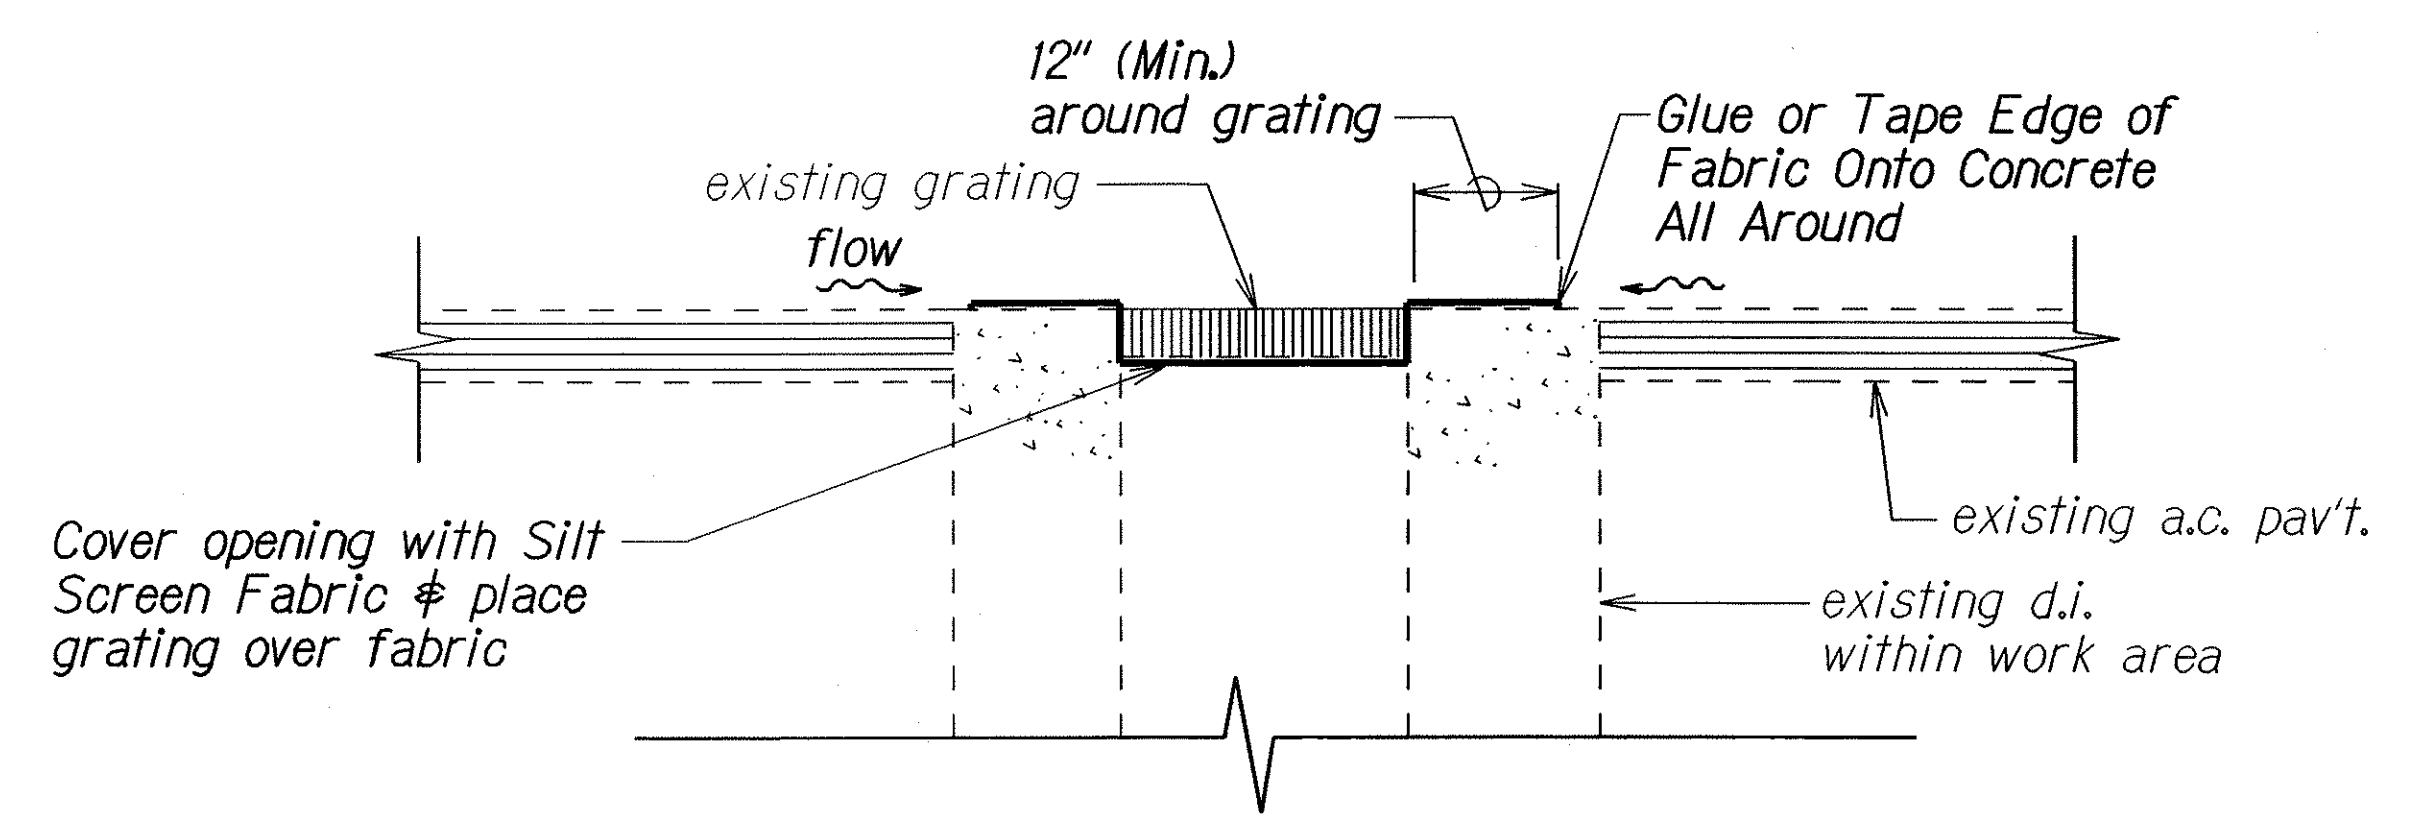

DETAIL 2 - SILT SCREEN AT D.I. WITHIN WORK AREA
 Not to Scale

STATE OF HAWAII
 DEPARTMENT OF TRANSPORTATION
 HIGHWAYS DIVISION

EROSION CONTROL PLANS
HALEAKALA HWY. GUARDRAIL & SHOULDER IMPROVEMENTS
Haliimaile Road to Kula Highway &
KAHEKILI HWY. GUARDRAIL & SHOULDER IMPROVEMENTS
at Waihee Bridge and Approaches
 Federal Aid Proj. No. STP-0900(60)
 Scale: 1" = 40' Date: Jan., 2001

DATE	12/1/01
SURVEY PLOTTED BY	TRC/LL
DESIGNED BY	TRC/LL
TRACED BY	TRC/LL
NOTE BOOK	10/20/01
QUANTITIES BY	TRC/LL
CHECKED BY	TRC/LL