




INDEX TO DRAWINGS	
SHEET NO.	DESCRIPTION
1	TITLE SHEET
2	STANDARD PLANS SUMMARY
3	GENERAL NOTES AND LEGEND
4	TYPICAL SECTIONS
5 - 6	WATER POLLUTION & EROSION CONTROL NOTES
7 - 8	EROSION CONTROL PLANS
9 - 12	ROADWAY & DRAINAGE PLANS
13 - 14	DRAINAGE DETAILS
15 - 30	WAIHEE RIVER BRIDGE
31 - 33	GUARDRAIL DETAILS

STATE OF HAWAII
DEPARTMENT OF TRANSPORTATION
HIGHWAYS DIVISION
HONOLULU, HAWAII
PLANS FOR

**HALEAKALA HIGHWAY GUARDRAIL AND SHOULDER IMPROVEMENTS
HALIIMAILE ROAD TO KULA HIGHWAY AND
KAHEKILI HIGHWAY GUARDRAIL AND SHOULDER IMPROVEMENTS
AT WAIHEE BRIDGE AND APPROACHES
FEDERAL-AID PROJECT NO. STP-0900(60)**

DISTRICT OF MAKAWAO AND WAILUKU
ISLAND OF MAUI

FED. ROAD DIST. NO.	STATE	FED. AID PROJ. NO.	FISCAL YEAR	SHEET NO.	TOTAL SHEETS
HAWAII	HAW.	STP-0900(60)	2002	1	33

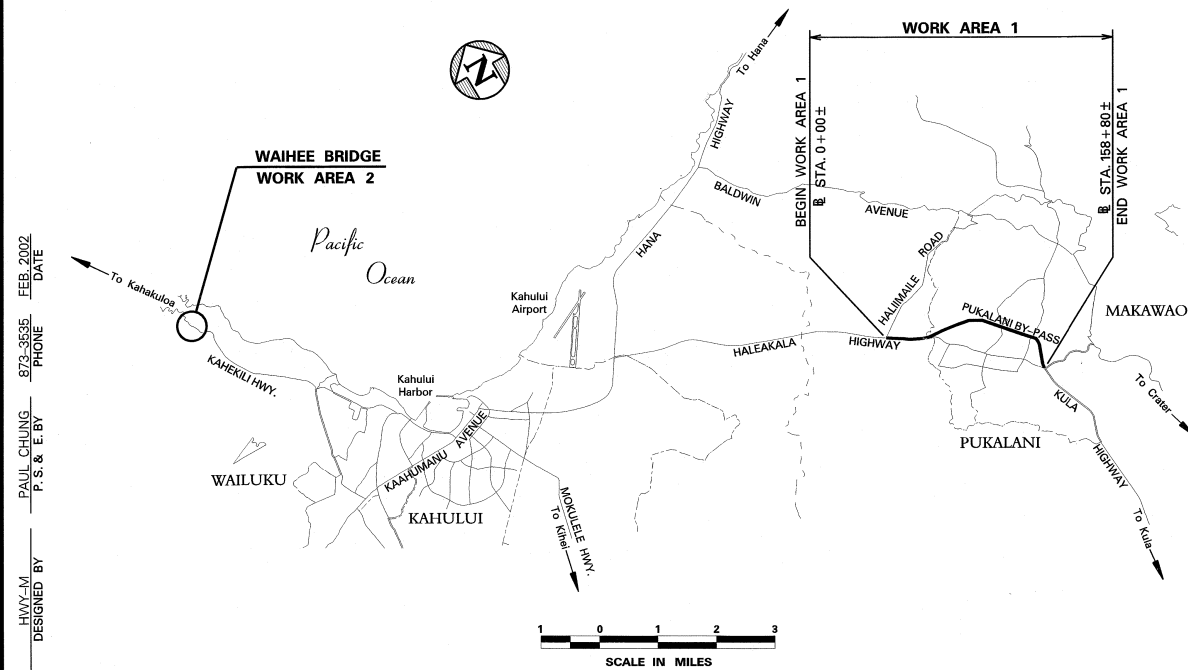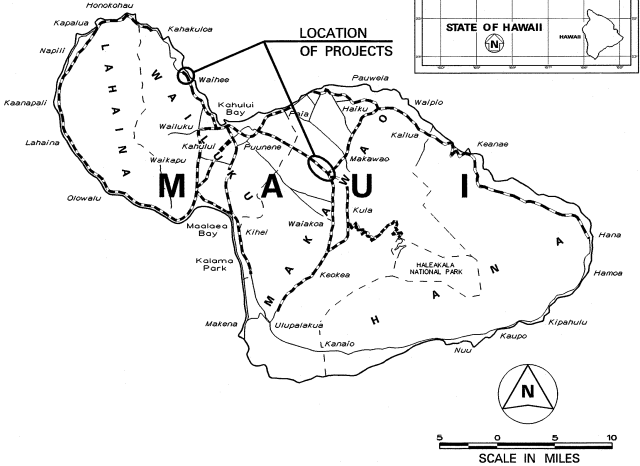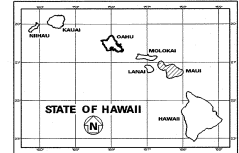

----- FEDERAL AID PROJECTS PREVIOUSLY CONSTRUCTED OR UNDER CONSTRUCTION

WORK AREA 1 MILE POST 4.76 TO MILE POST 7.76
WORK AREA 2 MILE POST 2.30 TO MILE POST 2.38

DESIGN	DESIGNATION	ROUTE 37	ROUTE 340
ADT (2001)		25,450	1,230
ADT (2011)		33,500	1,710
DHV		3,180	180
D		85/15	60/40
T		3.0 %	4.0 %
V		55 M.P.H.	40 M.P.H.

CHANGES MADE DURING CONSTRUCTION HAVE BEEN INCORPORATED ON THESE PLANS EXCEPT CHANGES IN THE ORIGINAL THEORETICAL QUANTITIES. FOR ACTUAL QUANTITIES, REFER TO PROJECT DESIGN AND/OR CONSTRUCTION RECORDS.
DESIGNED BY: [Signature] DATE: 5/1/02

DEPARTMENT OF TRANSPORTATION
STATE OF HAWAII
APPROVED: [Signature] 02-15-02
AS DIR. OF TRANSPORTATION DATE

DESIGNED BY: HWY-M
PAUL CHUNG
P.S. & E.B.Y.
873-3535
FEB. 2002
DATE