



PROJECT	DATE	BY
SURVEY	1980	W. J. ...
DESIGN	1980	W. J. ...
CONSTRUCTION	1980	W. J. ...
REVISION	1980	W. J. ...
NO.	1000	1000

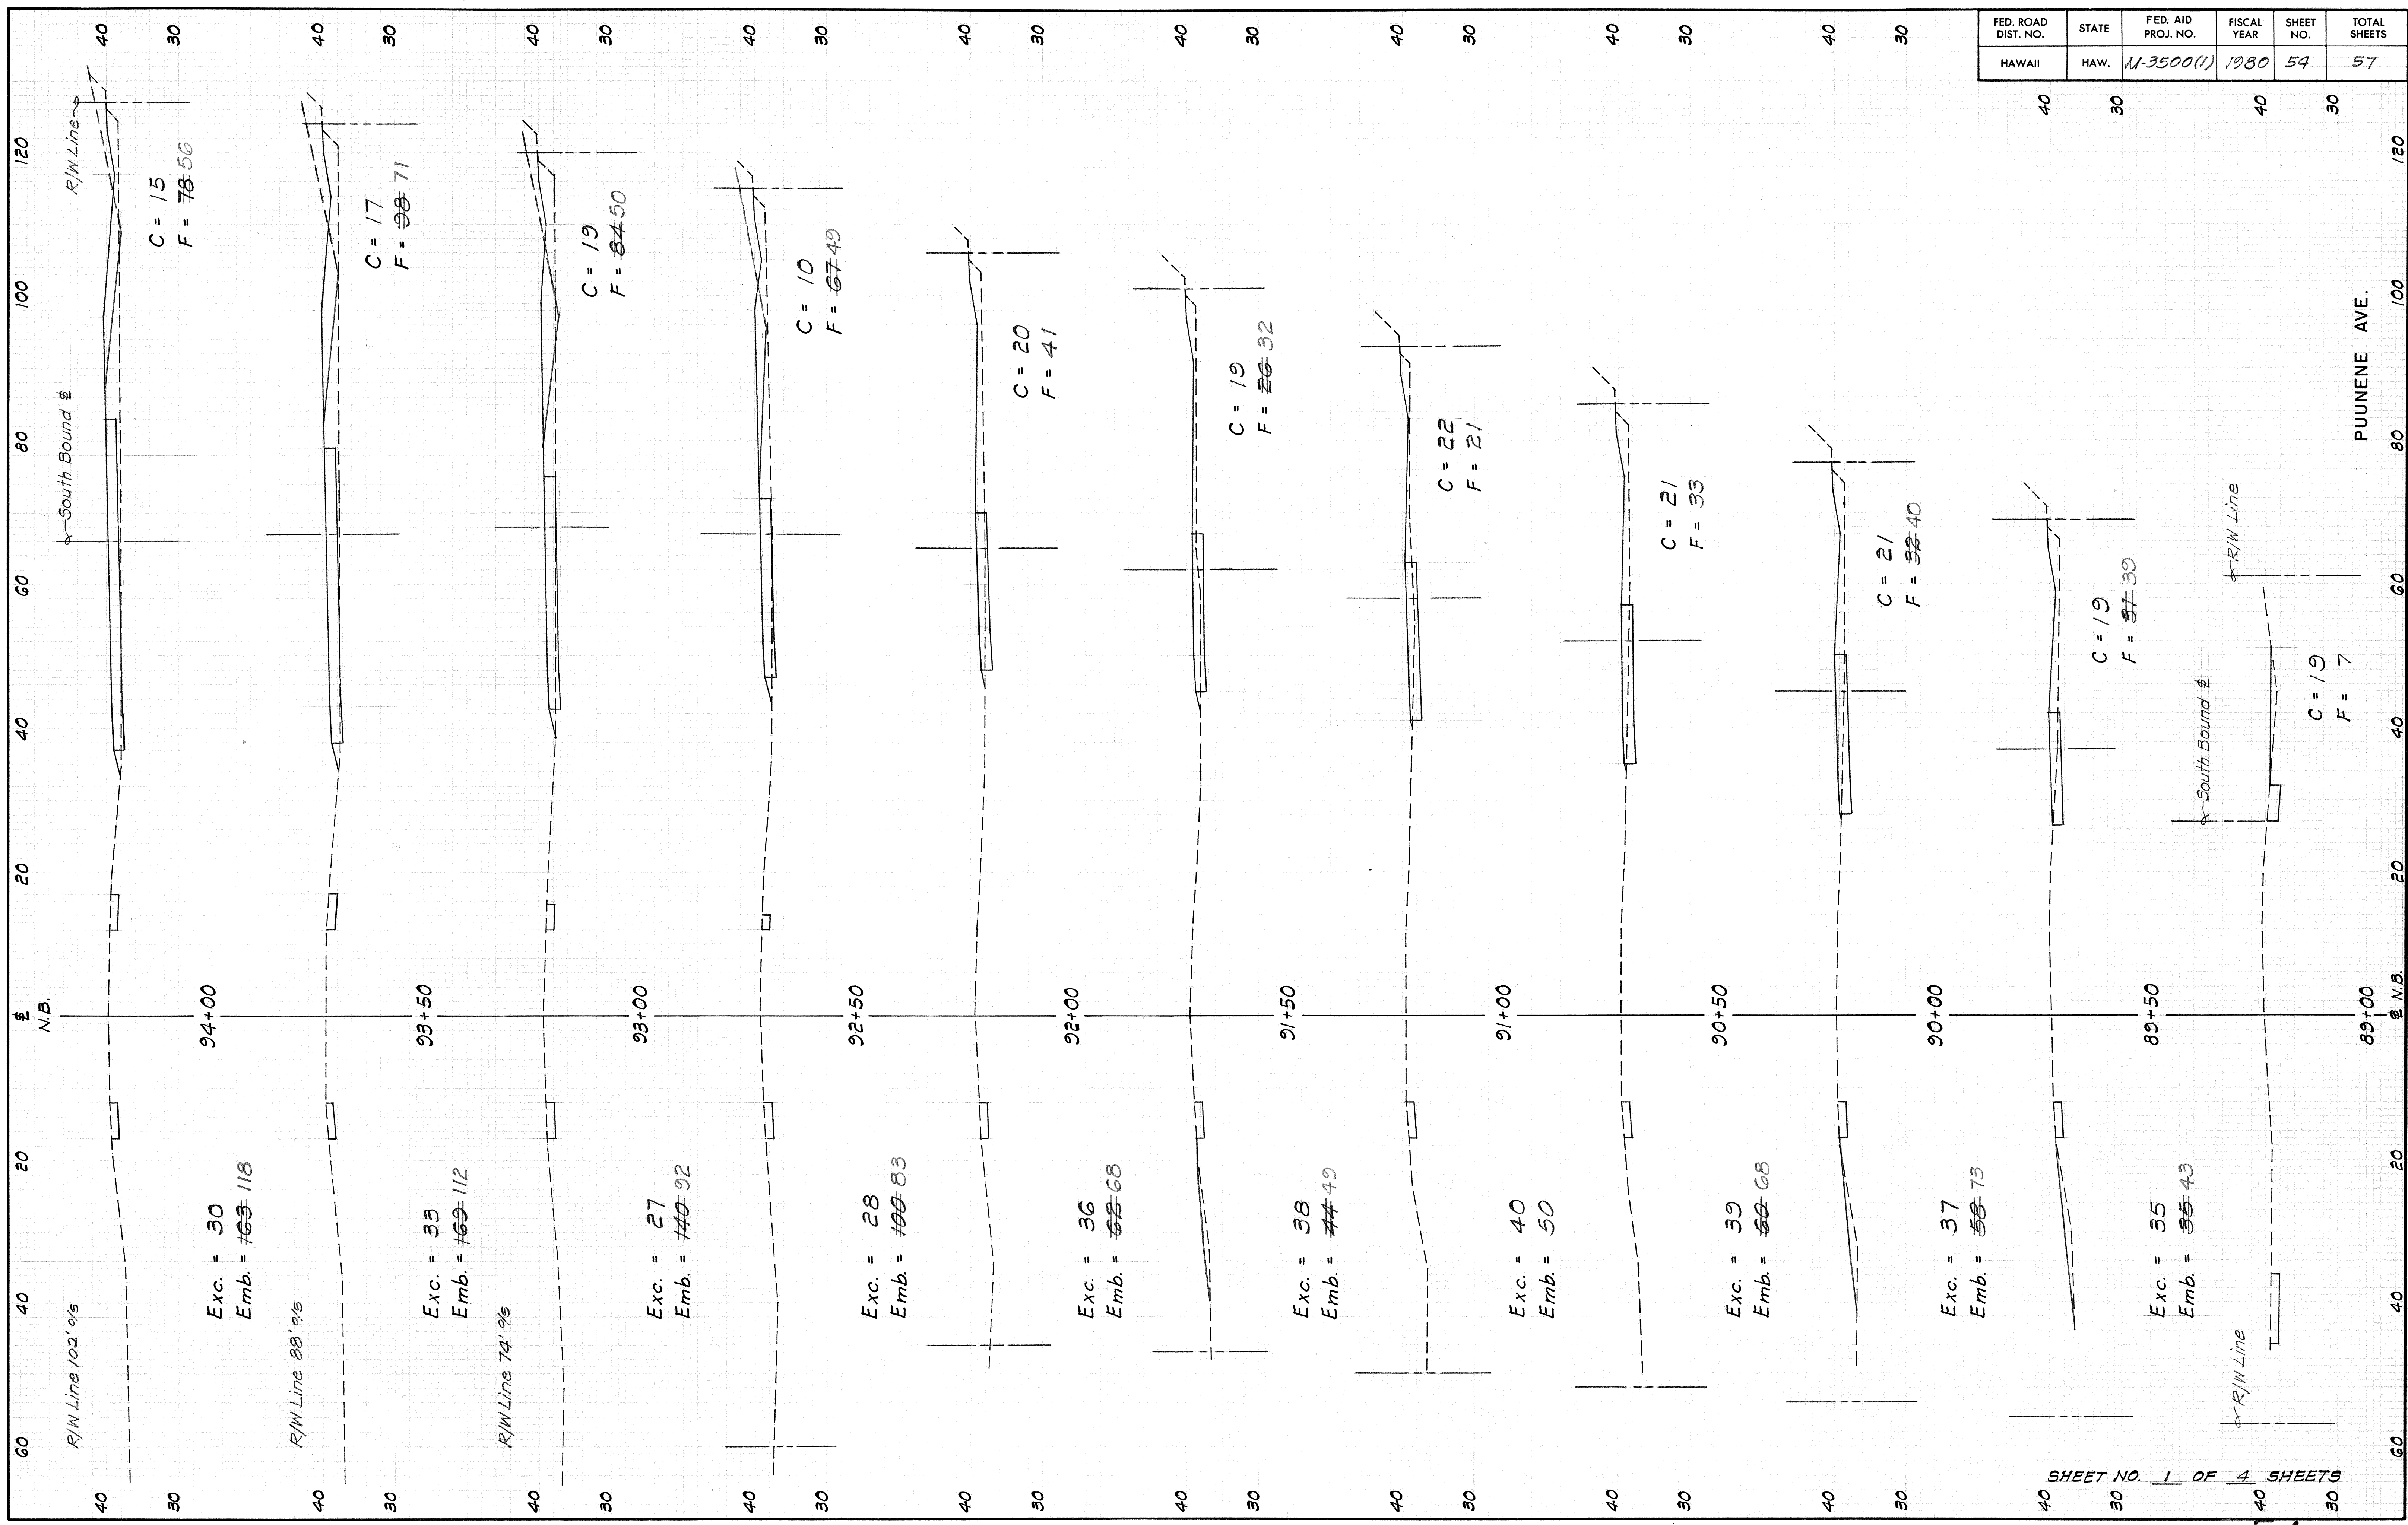

FED. ROAD DIST. NO.	STATE	FED. AID PROJ. NO.	FISCAL YEAR	SHEET NO.	TOTAL SHEETS
HAWAII	HAW.	11-3500(1)	1980	54	57

DESIGNED BY	DATE
CHECKED BY	DATE
APPROVED BY	DATE
NOTED BY	DATE
REVISIONS	



PROJECT NO.	DATE
SHEET NO.	DATE
SECTION	DATE
DATE	DATE
DATE	DATE

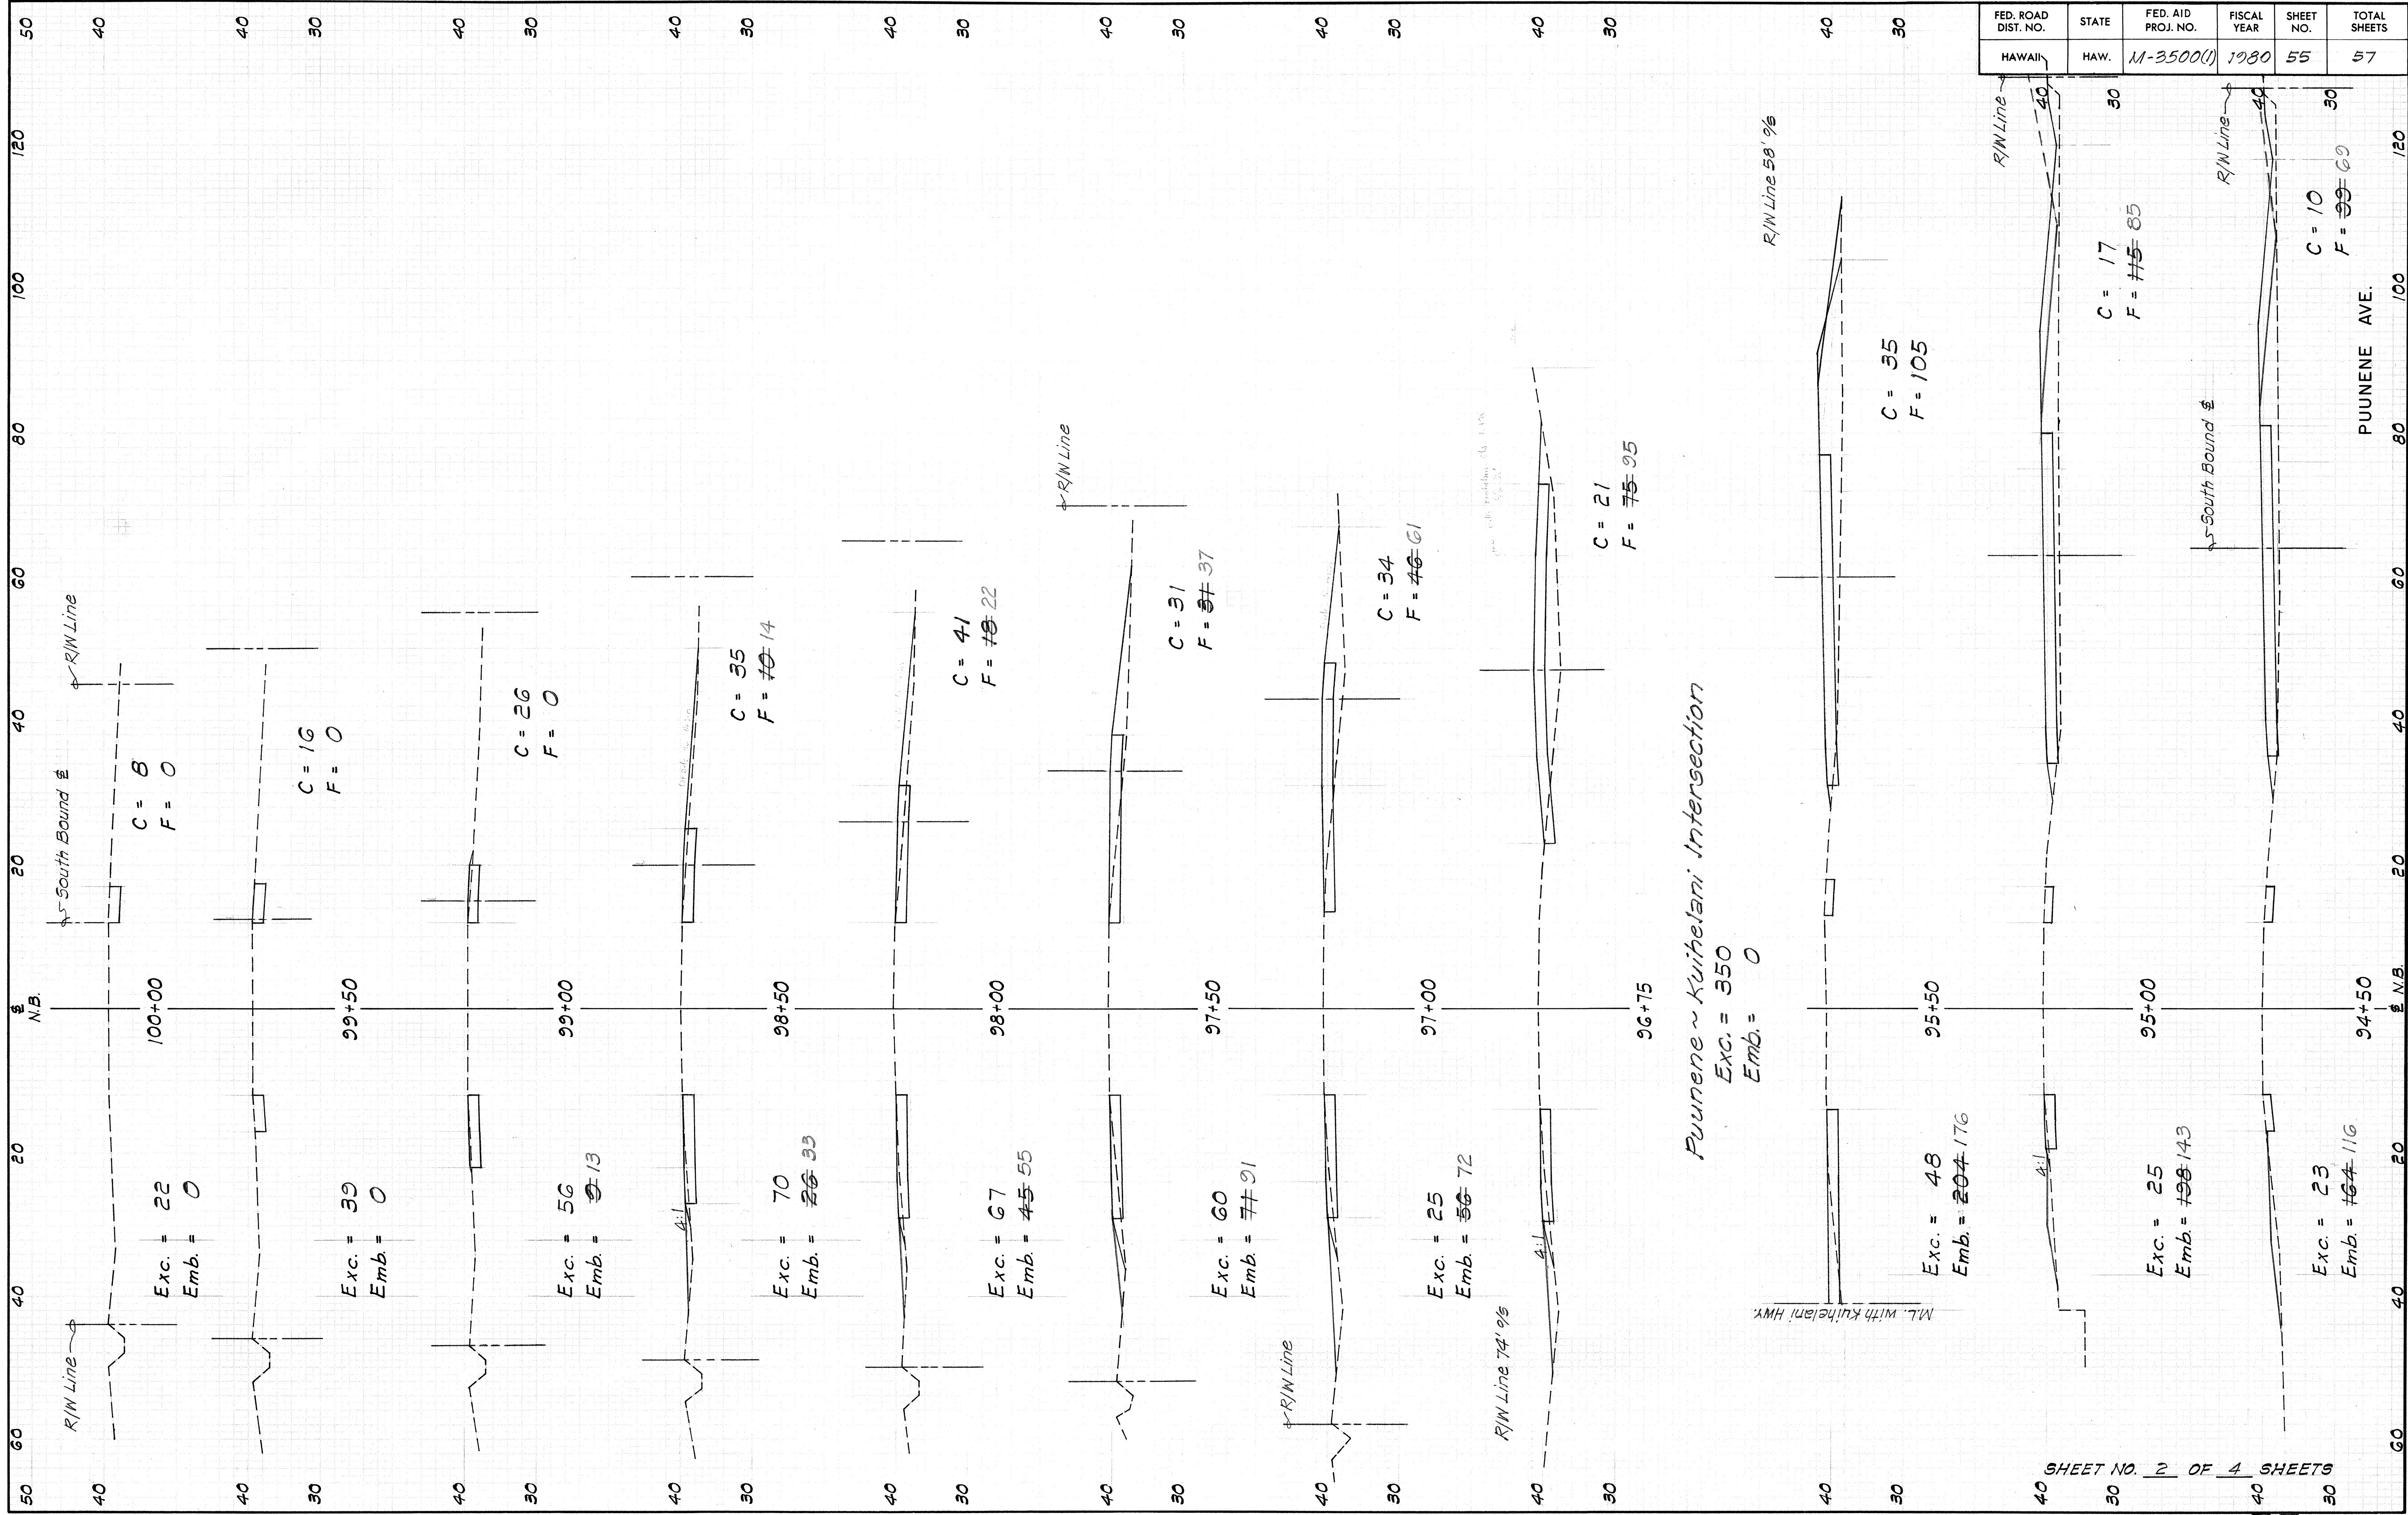



FED. ROAD DIST. NO.	STATE	FED. AID PROJ. NO.	FISCAL YEAR	SHEET NO.	TOTAL SHEETS
HAWAII	HAW.	M-3500(1)	1980	55	57

SHEET NO. 2 OF 4 SHEETS

FED. ROAD DIST. NO.	STATE	FED. AID PROJ. NO.	FISCAL YEAR	SHEET NO.	TOTAL SHEETS
HAWAII	HAW.	M-3500(1)	1980	56	57

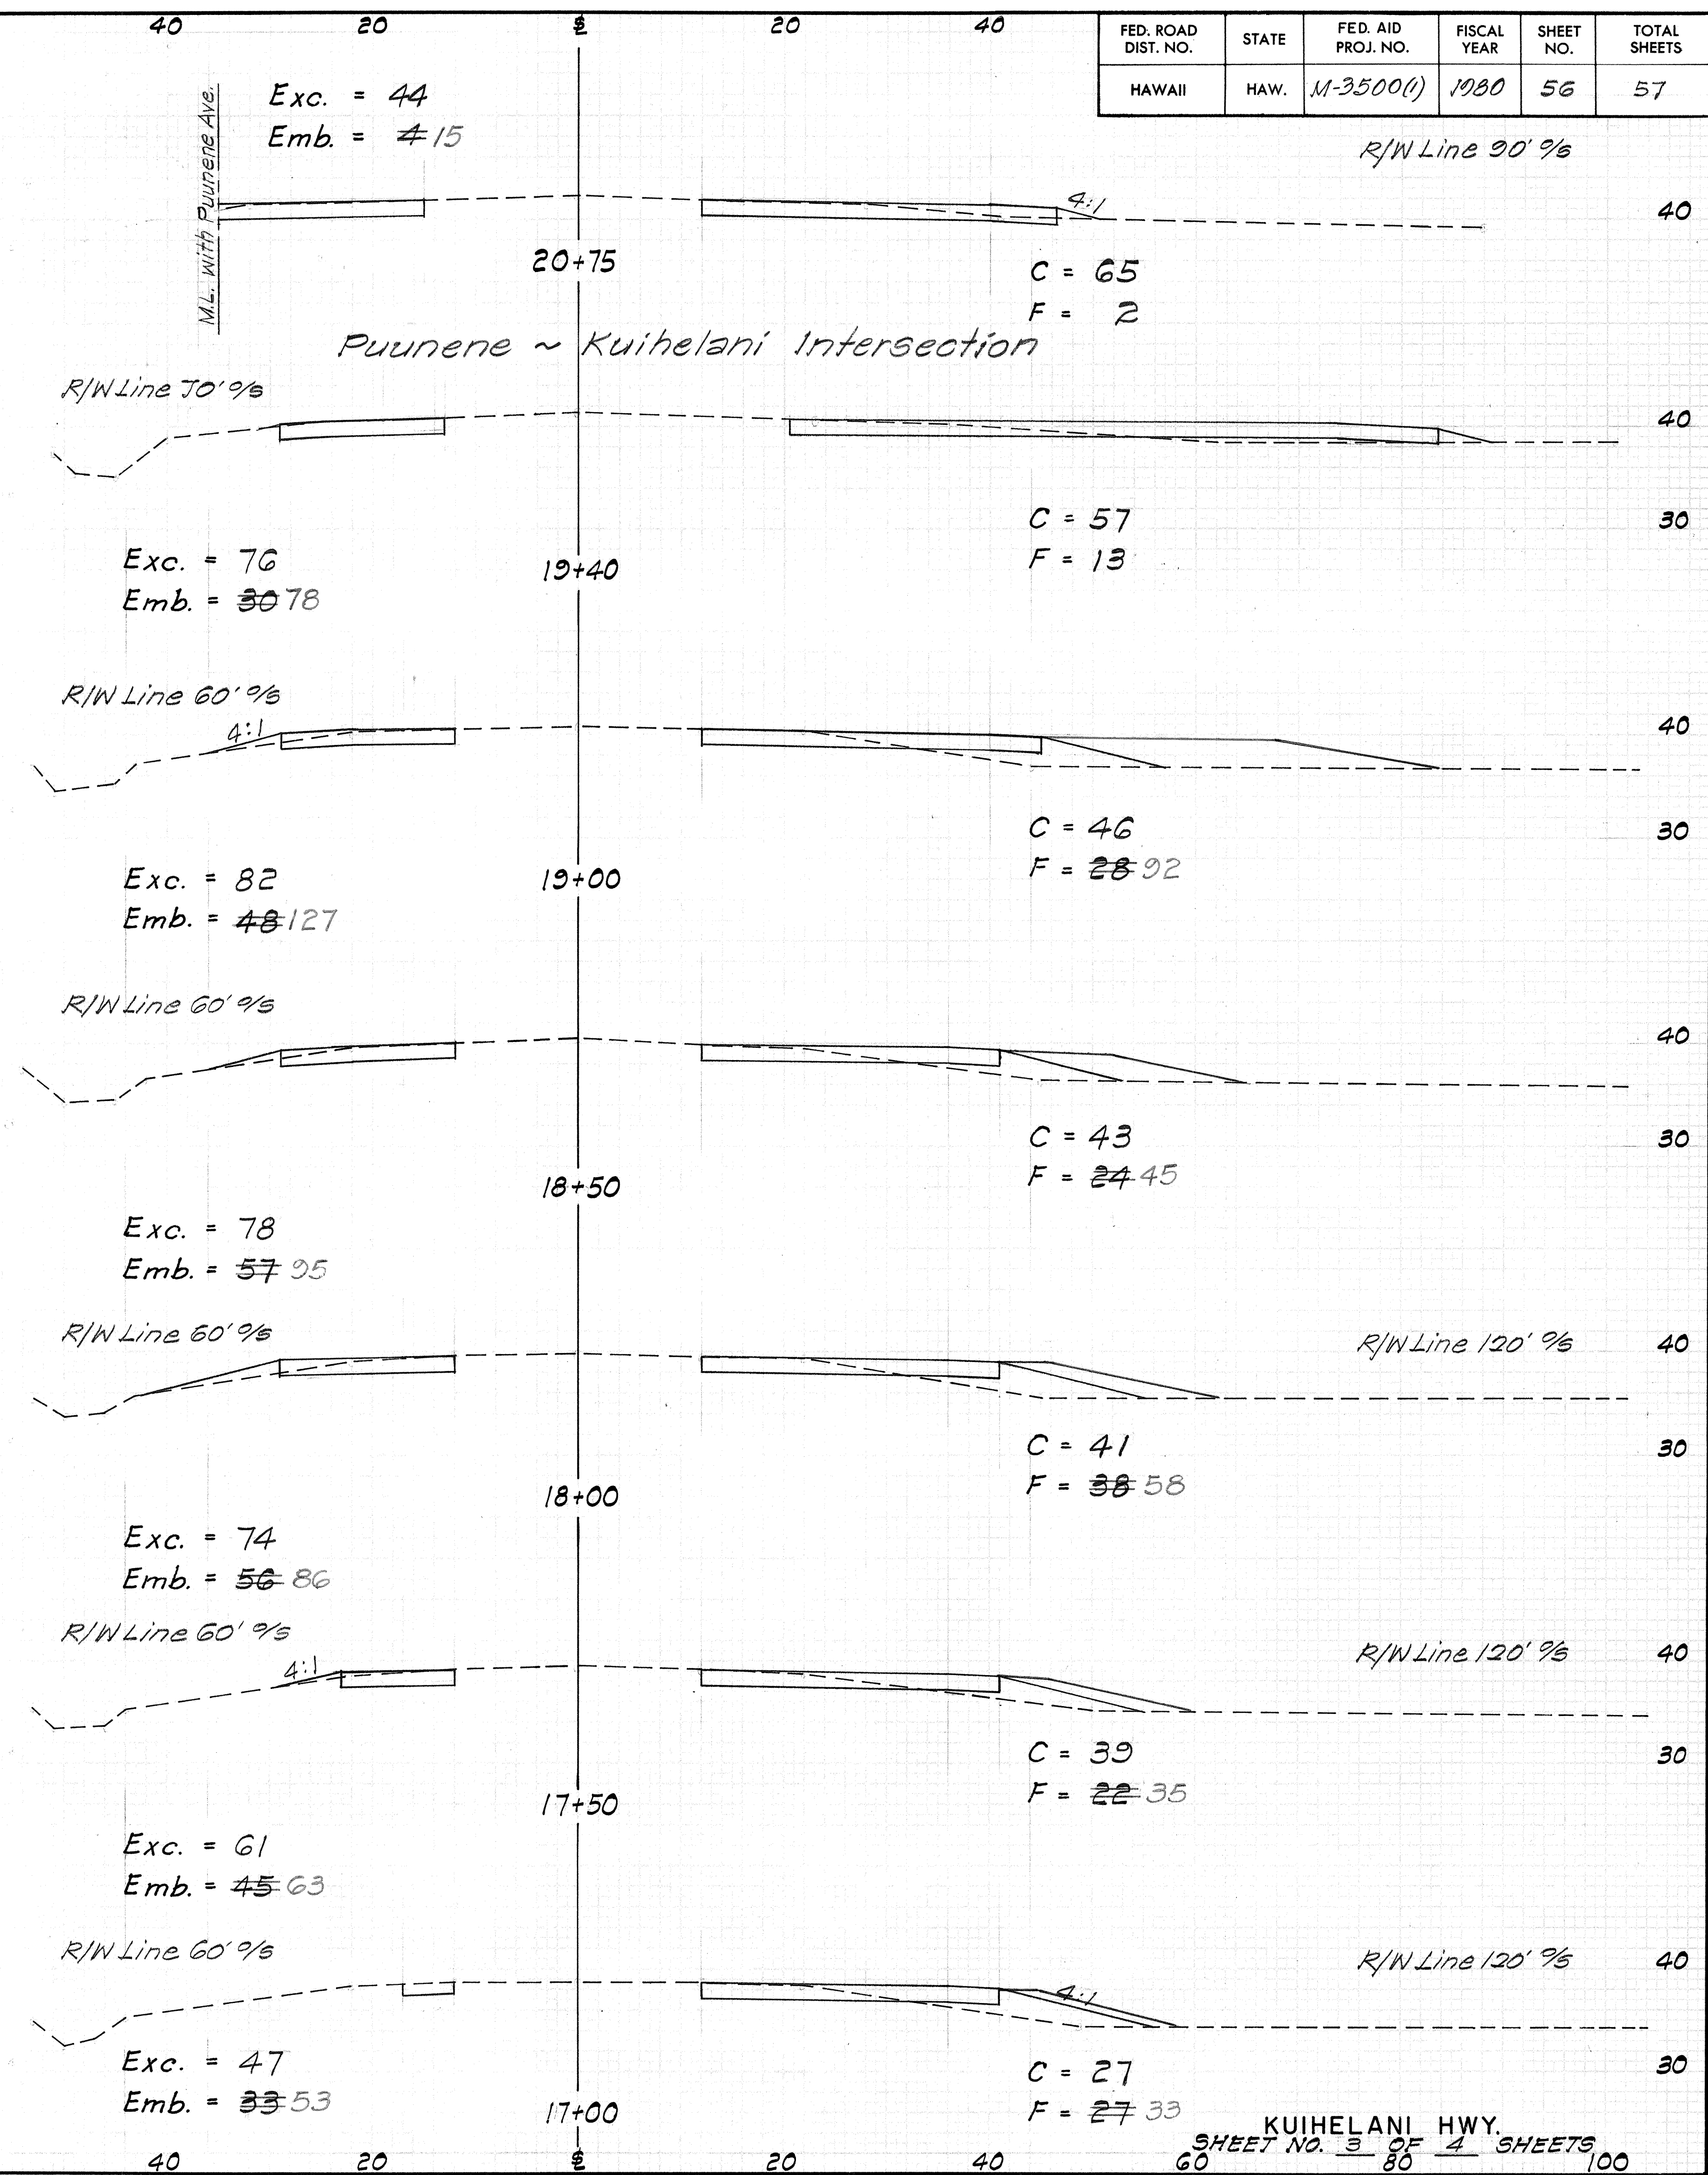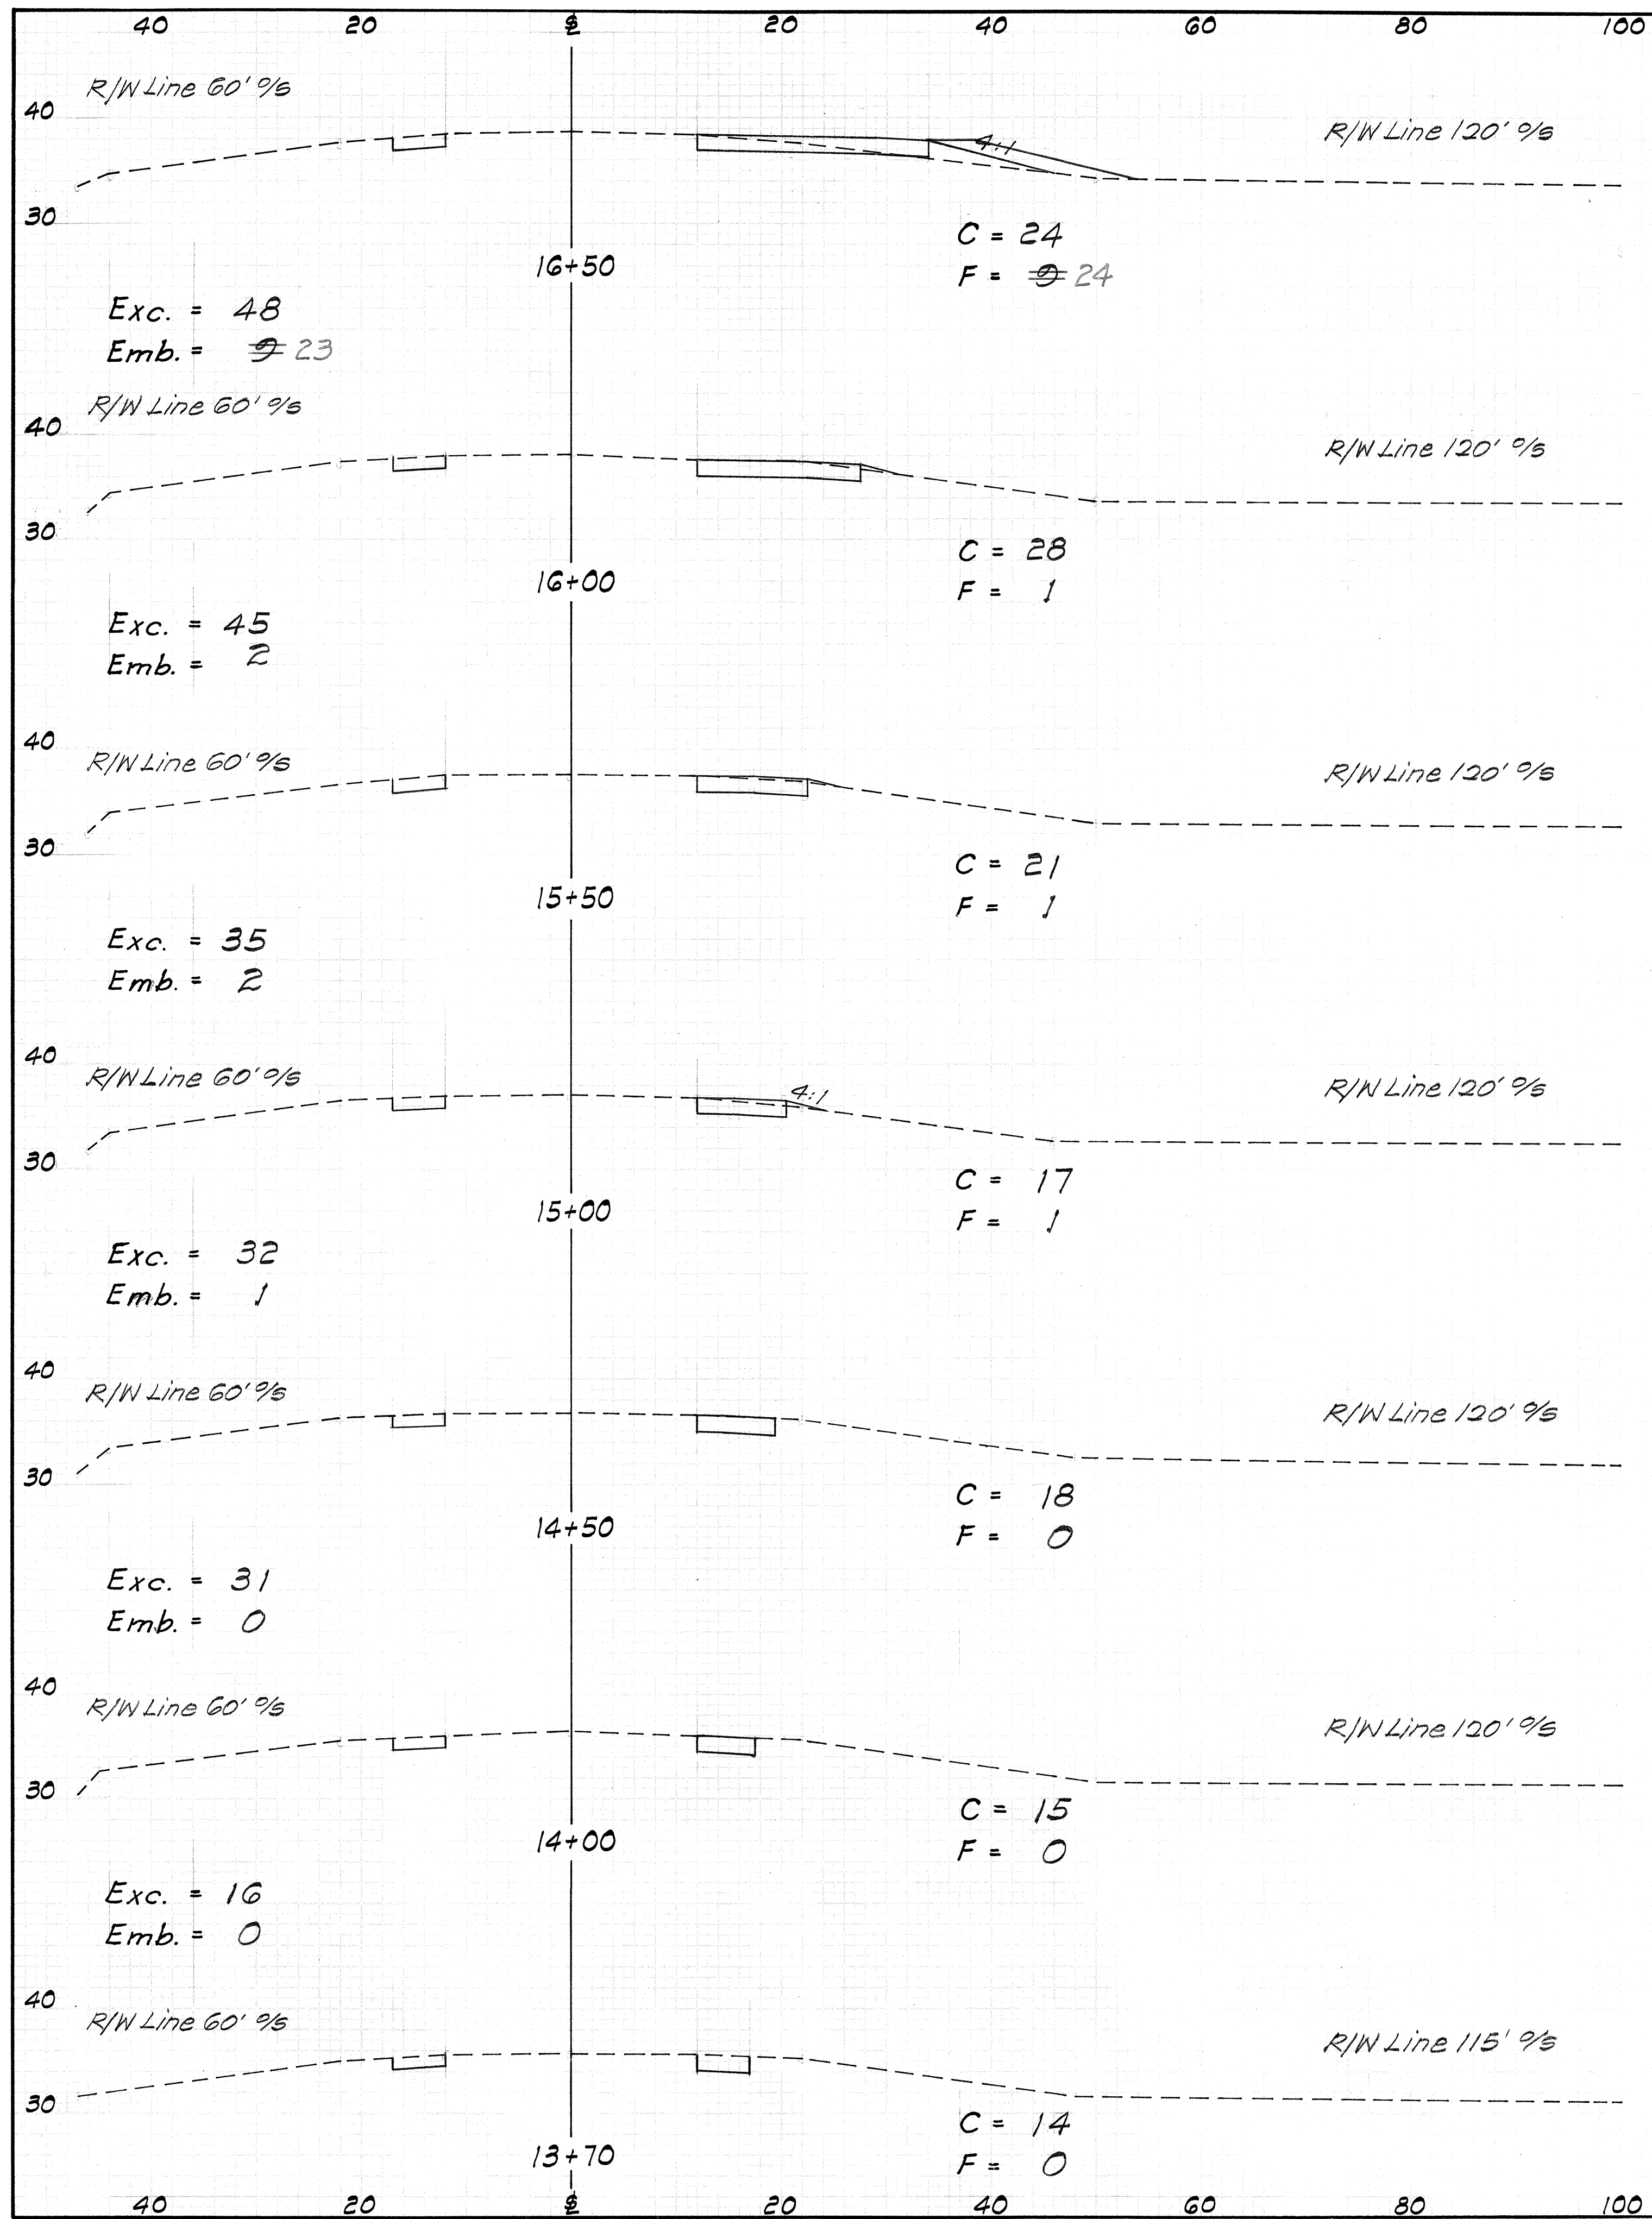

FED. ROAD DIST. NO.	STATE	FED. AID PROJ. NO.	FISCAL YEAR	SHEET NO.	TOTAL SHEETS
HAWAII	HAW.	M-3500(1)	1980	57	57

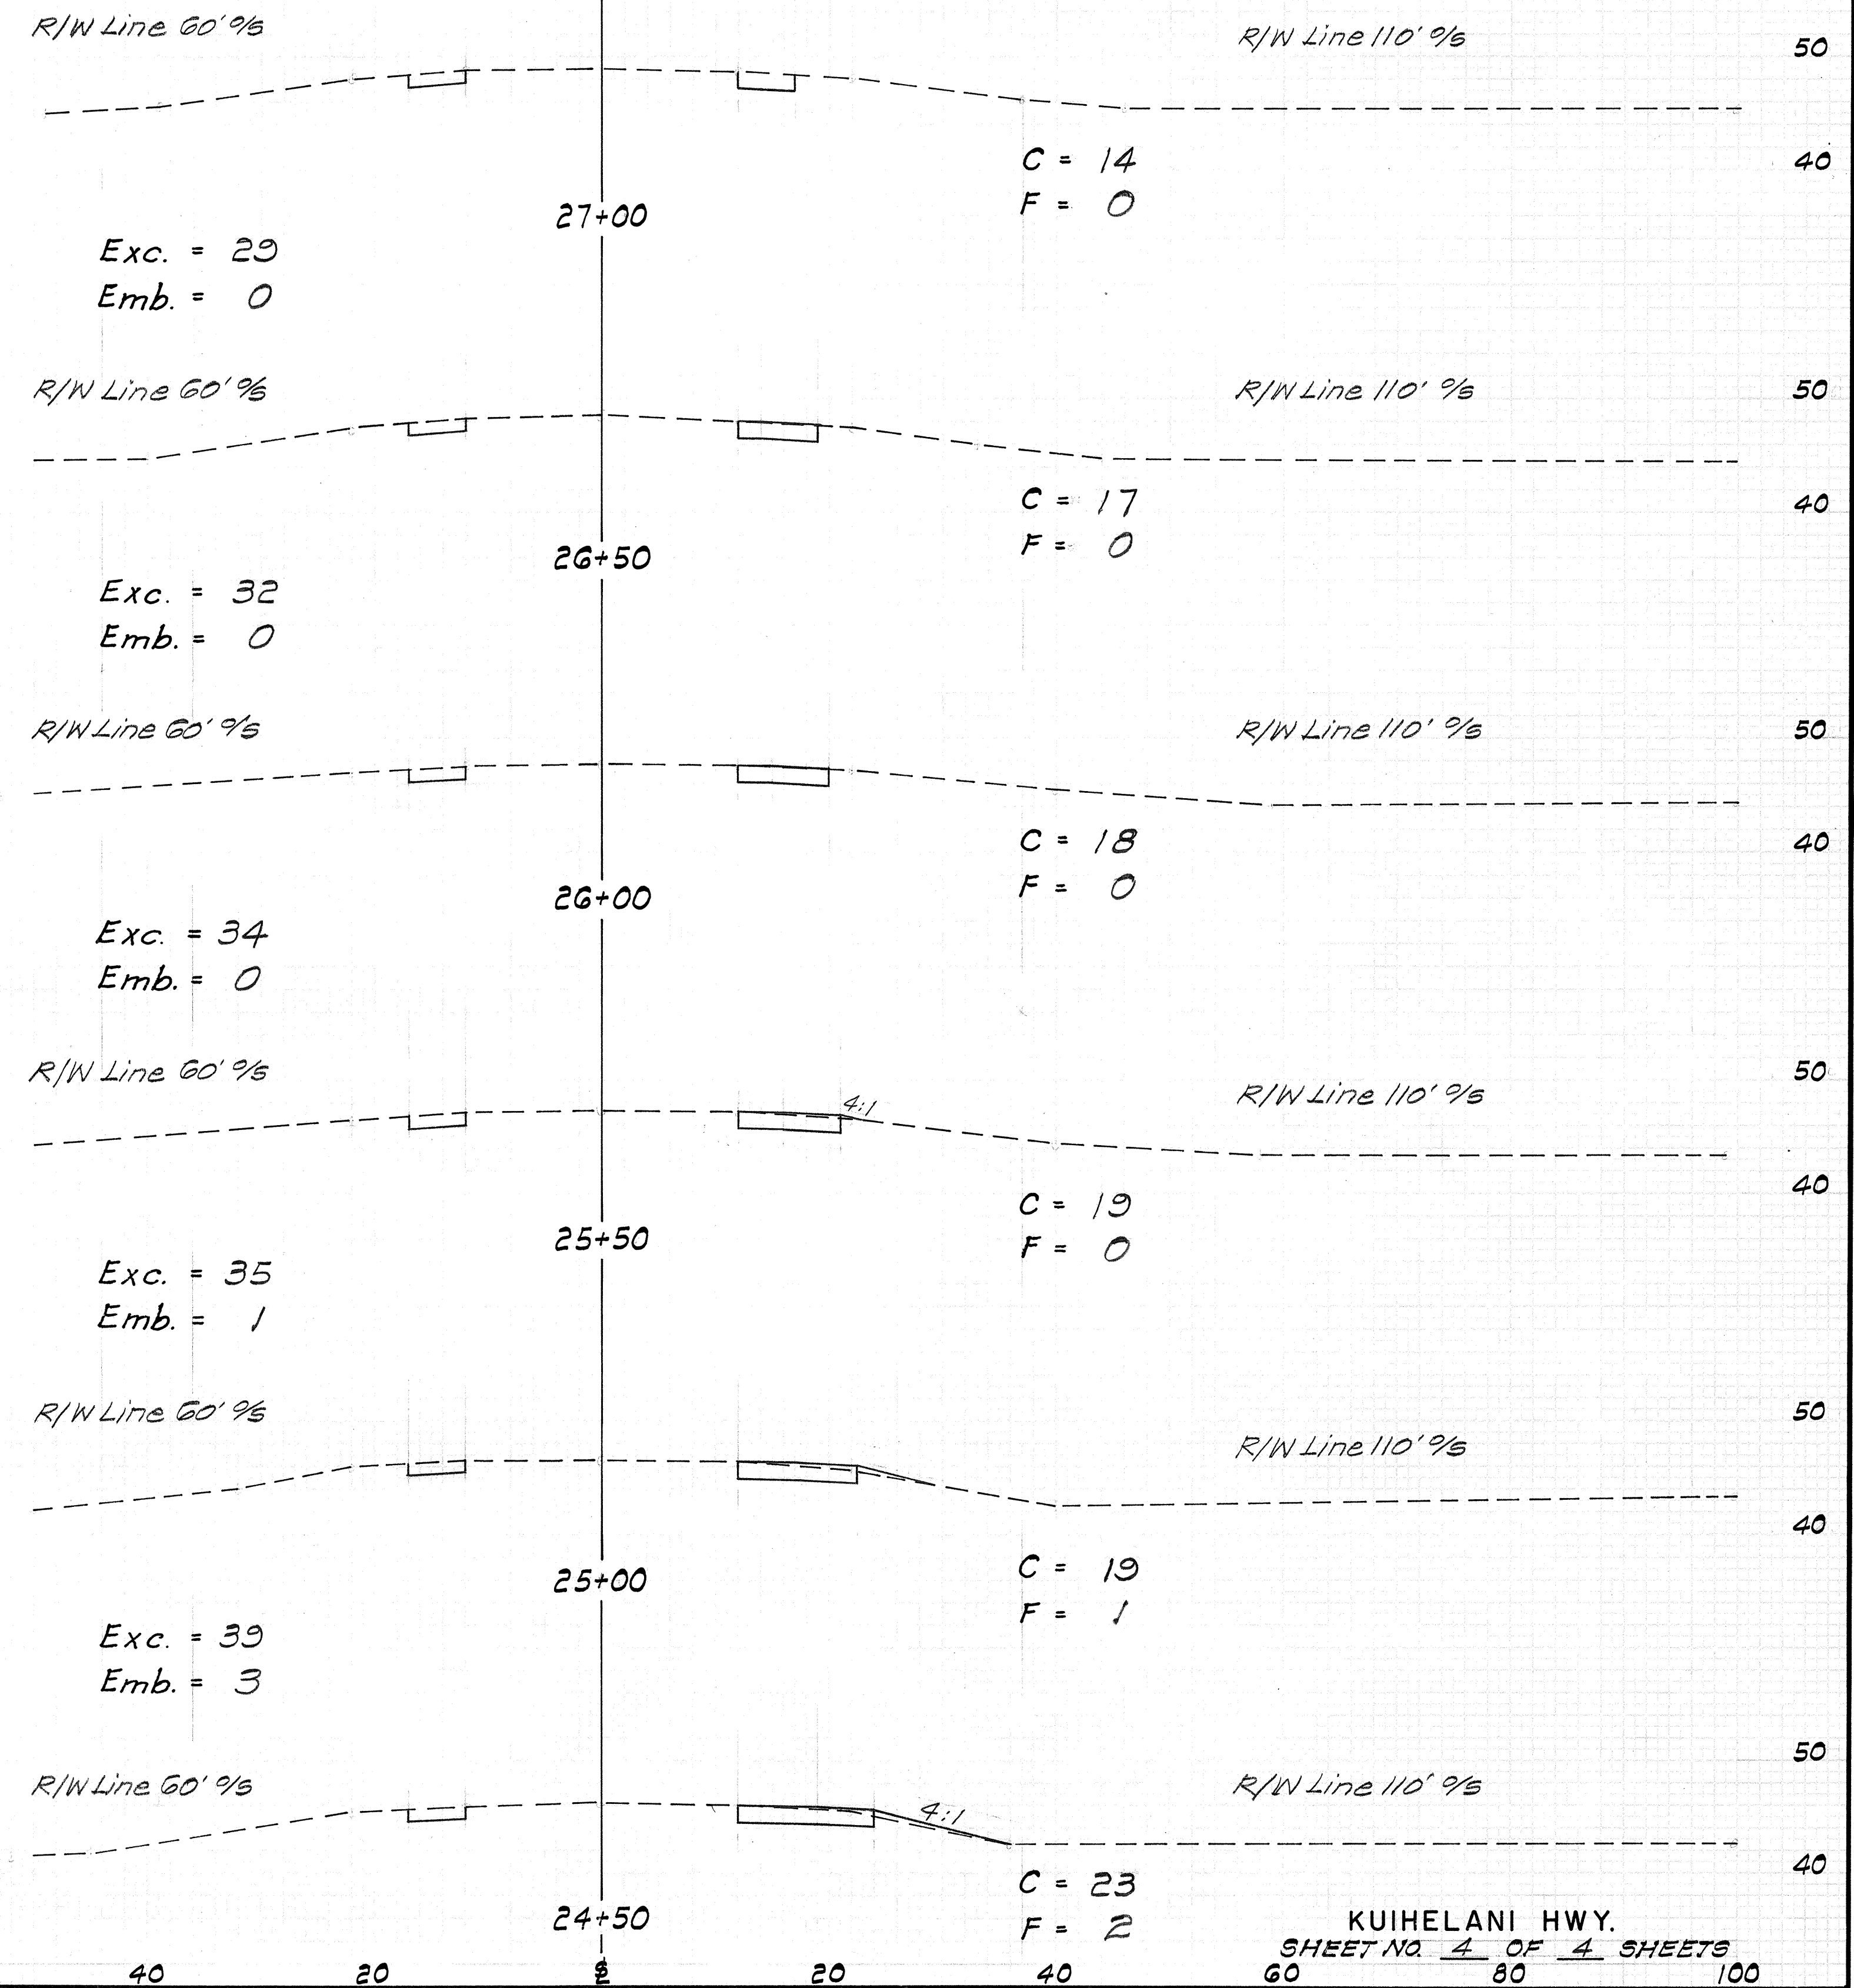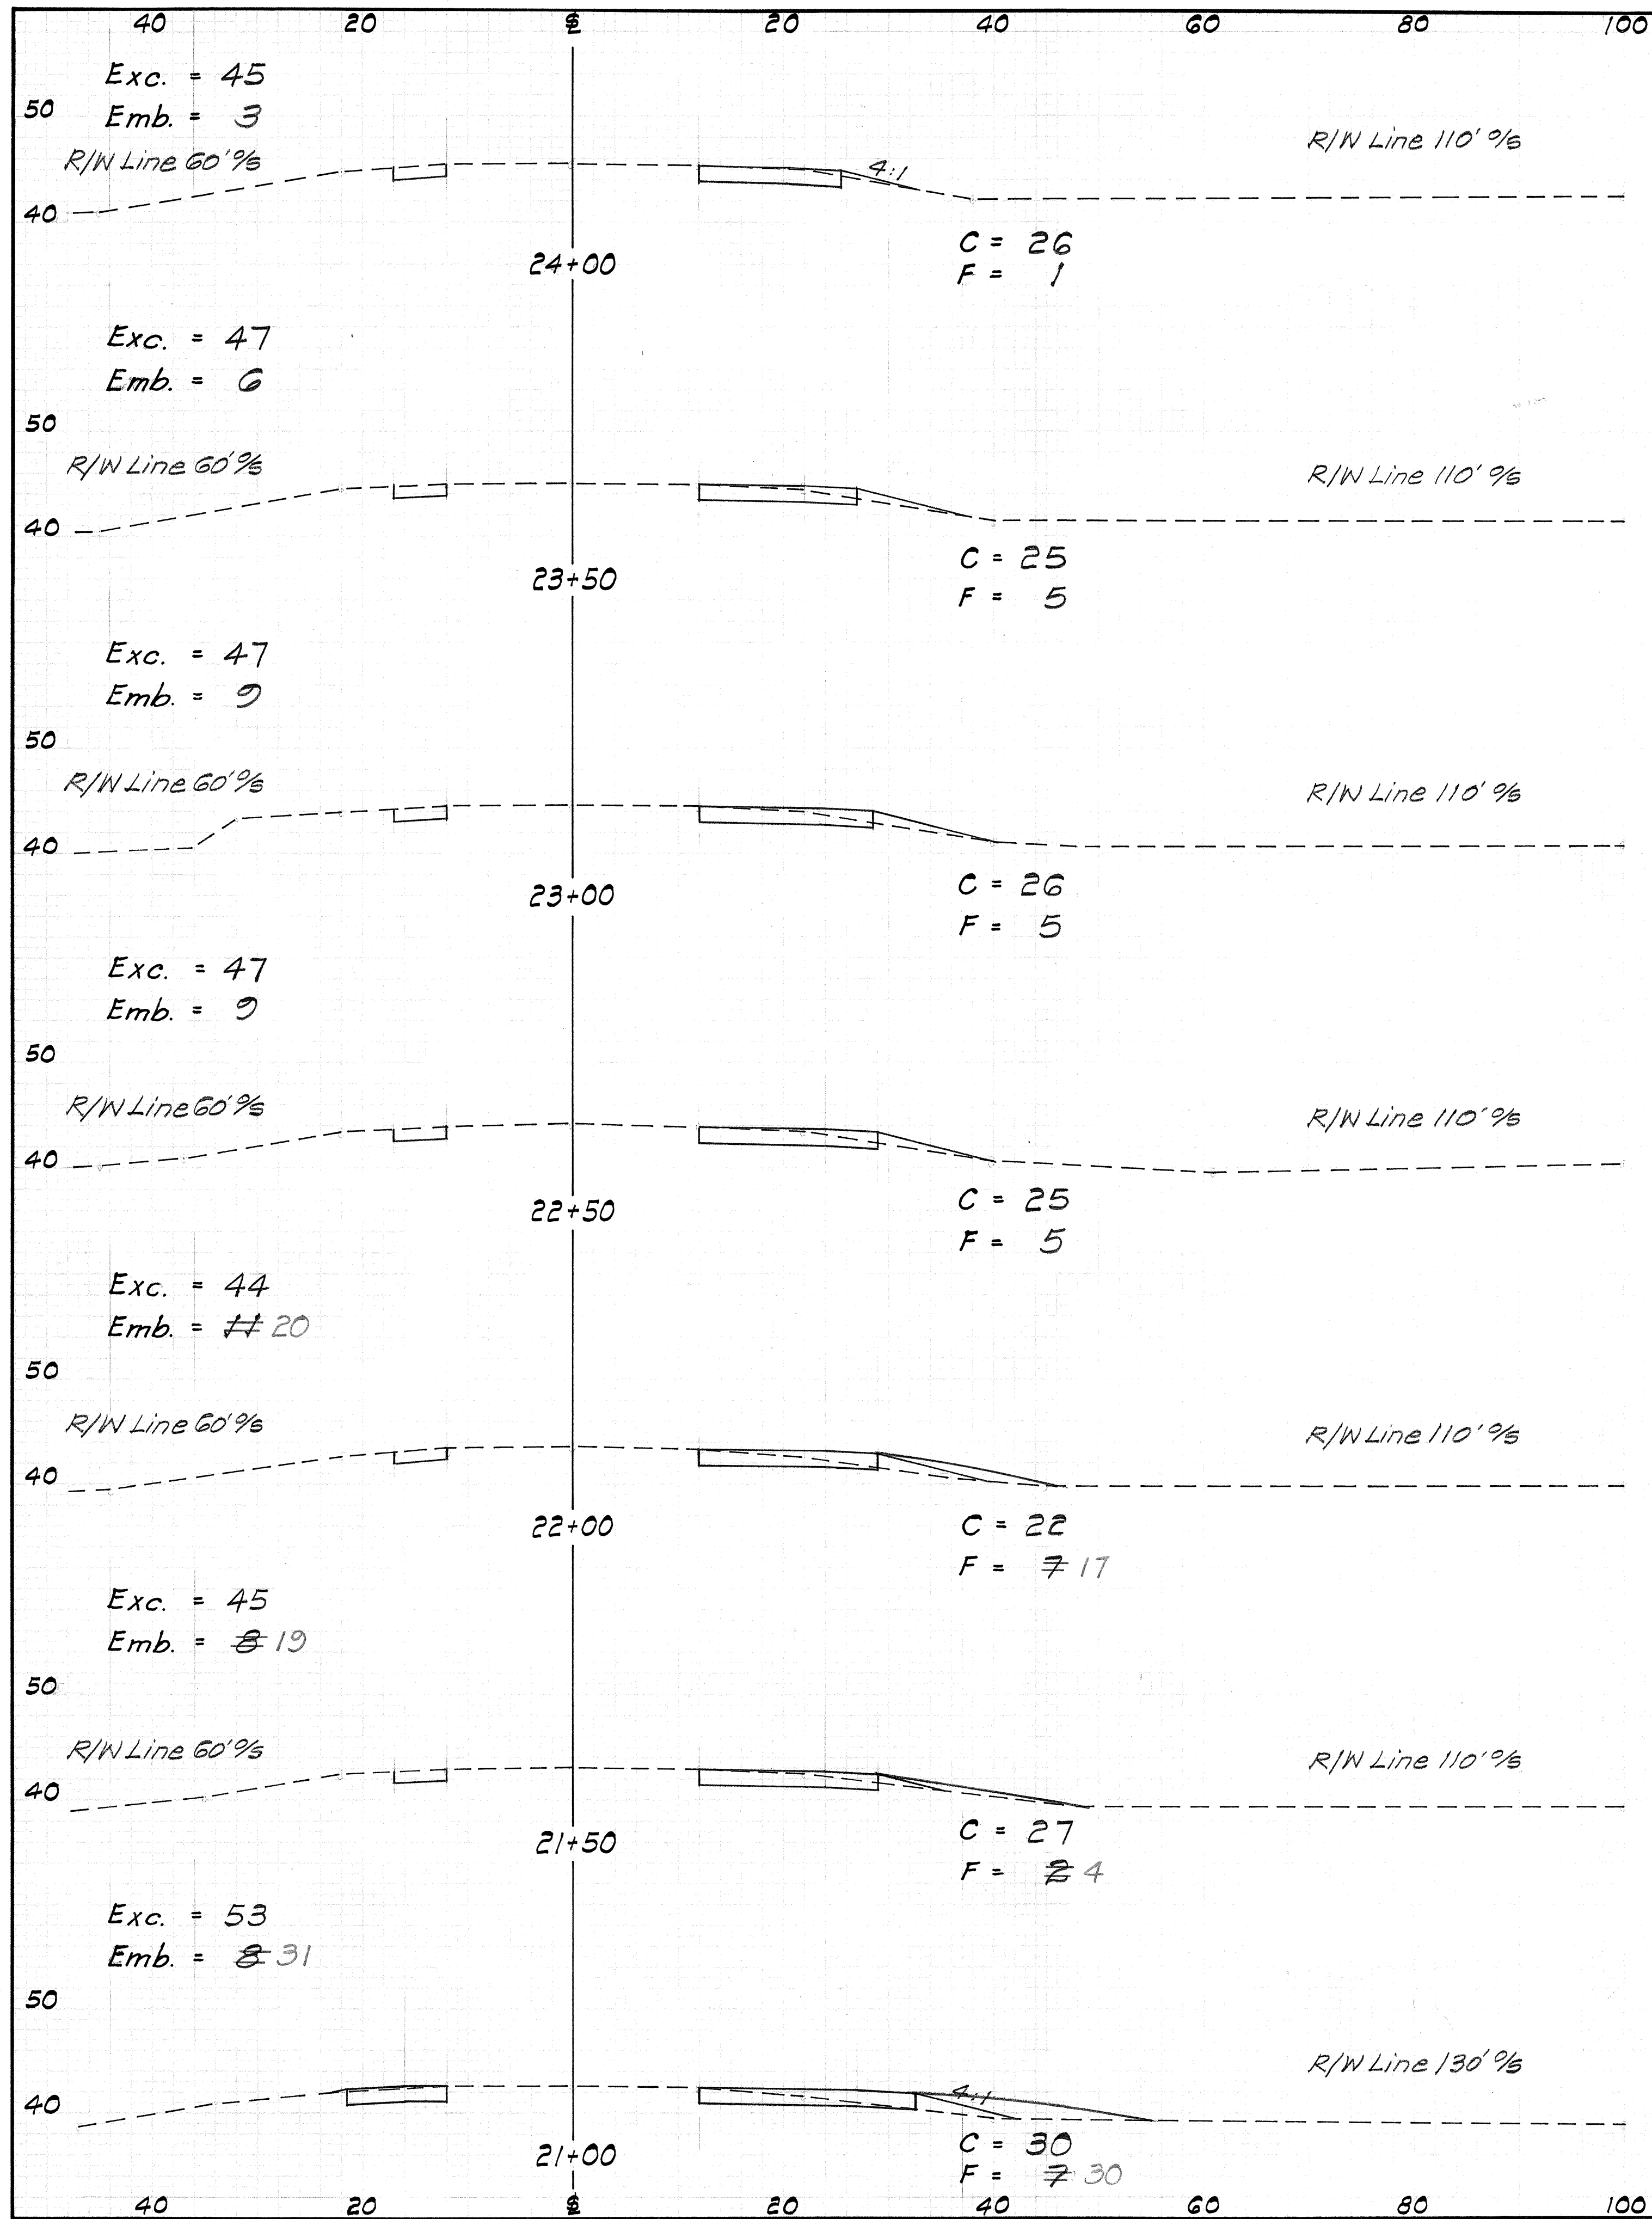

KUIHELANI HWY.
SHEET NO. 4 OF 4 SHEETS
60 80 100