
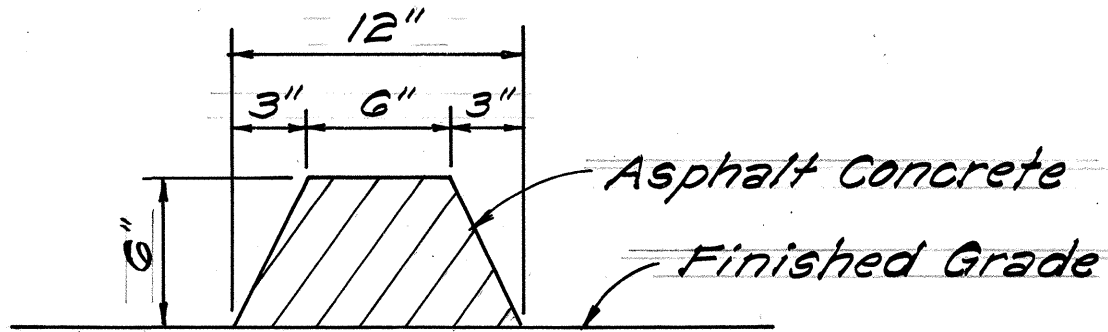


FED. ROAD DIST. NO.	STATE	FED. AID PROJ. NO.	FISCAL YEAR	SHEET NO.	TOTAL SHEETS
HAWAII	HAW.	M-3500(1)	1980	6	57

CURVE DATA TABLE									
NO.		N. COORD.	E. COORD.	DATA	NO.		N. COORD.	E. COORD.	DATA
P-3	P.C.	-1,364.25	12,143.01	Δ 9°13'37"	P-8	P.C.	-1,341.65	12,325.60	Δ 107°23'30"
	P.T.	-1,565.36	12,276.36	R 1,500.00'		P.T.	-1,323.23	12,206.13	R 75.00'
	C.C.	-638.56	13,455.79	T 121.04'		C.C.	-1,288.55	12,272.63	T 102.09'
	P.I.	-1,470.18	12,201.57	L 241.56'		P.I.	-1,413.75	12,253.33	L 140.58'
P-4	P.C.	-1,565.36	12,276.36	Δ 10°37'07"	P-10	P.C.C.	-1,424.92	12,206.70	Δ 102°44'28"
	P.T.	-1,798.56	12,426.94	R 1,500.00'		P.T.	-1,433.68	12,284.33	R 50.00'
	C.C.	-2,492.15	11,096.93	T 139.40'		C.C.	-1,398.28	12,249.01	T 62.57'
	P.I.	-1,674.96	12,362.49	L 278.00'		P.I.	-1,477.87	12,240.03	L 89.66'
P-5	P.R.C.	-1,432.90	12,169.26	Δ 76°45'32"	P-11	P.C.	-1,443.36	12,274.62	Δ 82°06'58"
	P.T.	-1,525.40	12,158.41	R 75.00'		P.R.C.	-1,535.09	12,268.19	R 70.00'
	C.C.	-1,472.30	12,105.44	T 59.40'		C.C.	-1,492.91	12,324.06	T 60.98'
	P.I.	-1,483.44	12,200.46	L 100.48'		P.I.	-1,486.42	12,231.46	L 100.32'
P-6	P.C.	-1,549.19	12,185.54	Δ 97°17'49"	P-12	P.C.	-1,508.12	12,275.48	Δ 107°23'30"
	P.R.C.	-1,554.54	12,267.94	R 55.00'		P.T.	-1,497.07	12,203.80	R 45.00'
	C.C.	-1,588.12	12,224.38	T 62.49'		C.C.	-1,528.93	12,235.58	T 61.25'
	P.I.	-1,505.05	12,229.78	L 93.40'		P.I.	-1,453.81	12,247.16	L 84.35'
P-7	P.C.	-1,421.70	12,330.32	Δ 72°36'30"	P-13	P.C.	-1,401.70	12,219.98	Δ 72°36'30"
	P.T.	-1,509.47	12,316.79	R 75.00'		P.T.	-1,425.32	12,205.55	R 80.00'
	C.C.	-1,474.79	12,383.29	T 55.10'		C.C.	-1,438.69	12,149.05	T 58.78'
	P.I.	-1,460.61	12,291.31	L 95.04'		P.I.	-1,453.81	12,247.16	L 101.38'

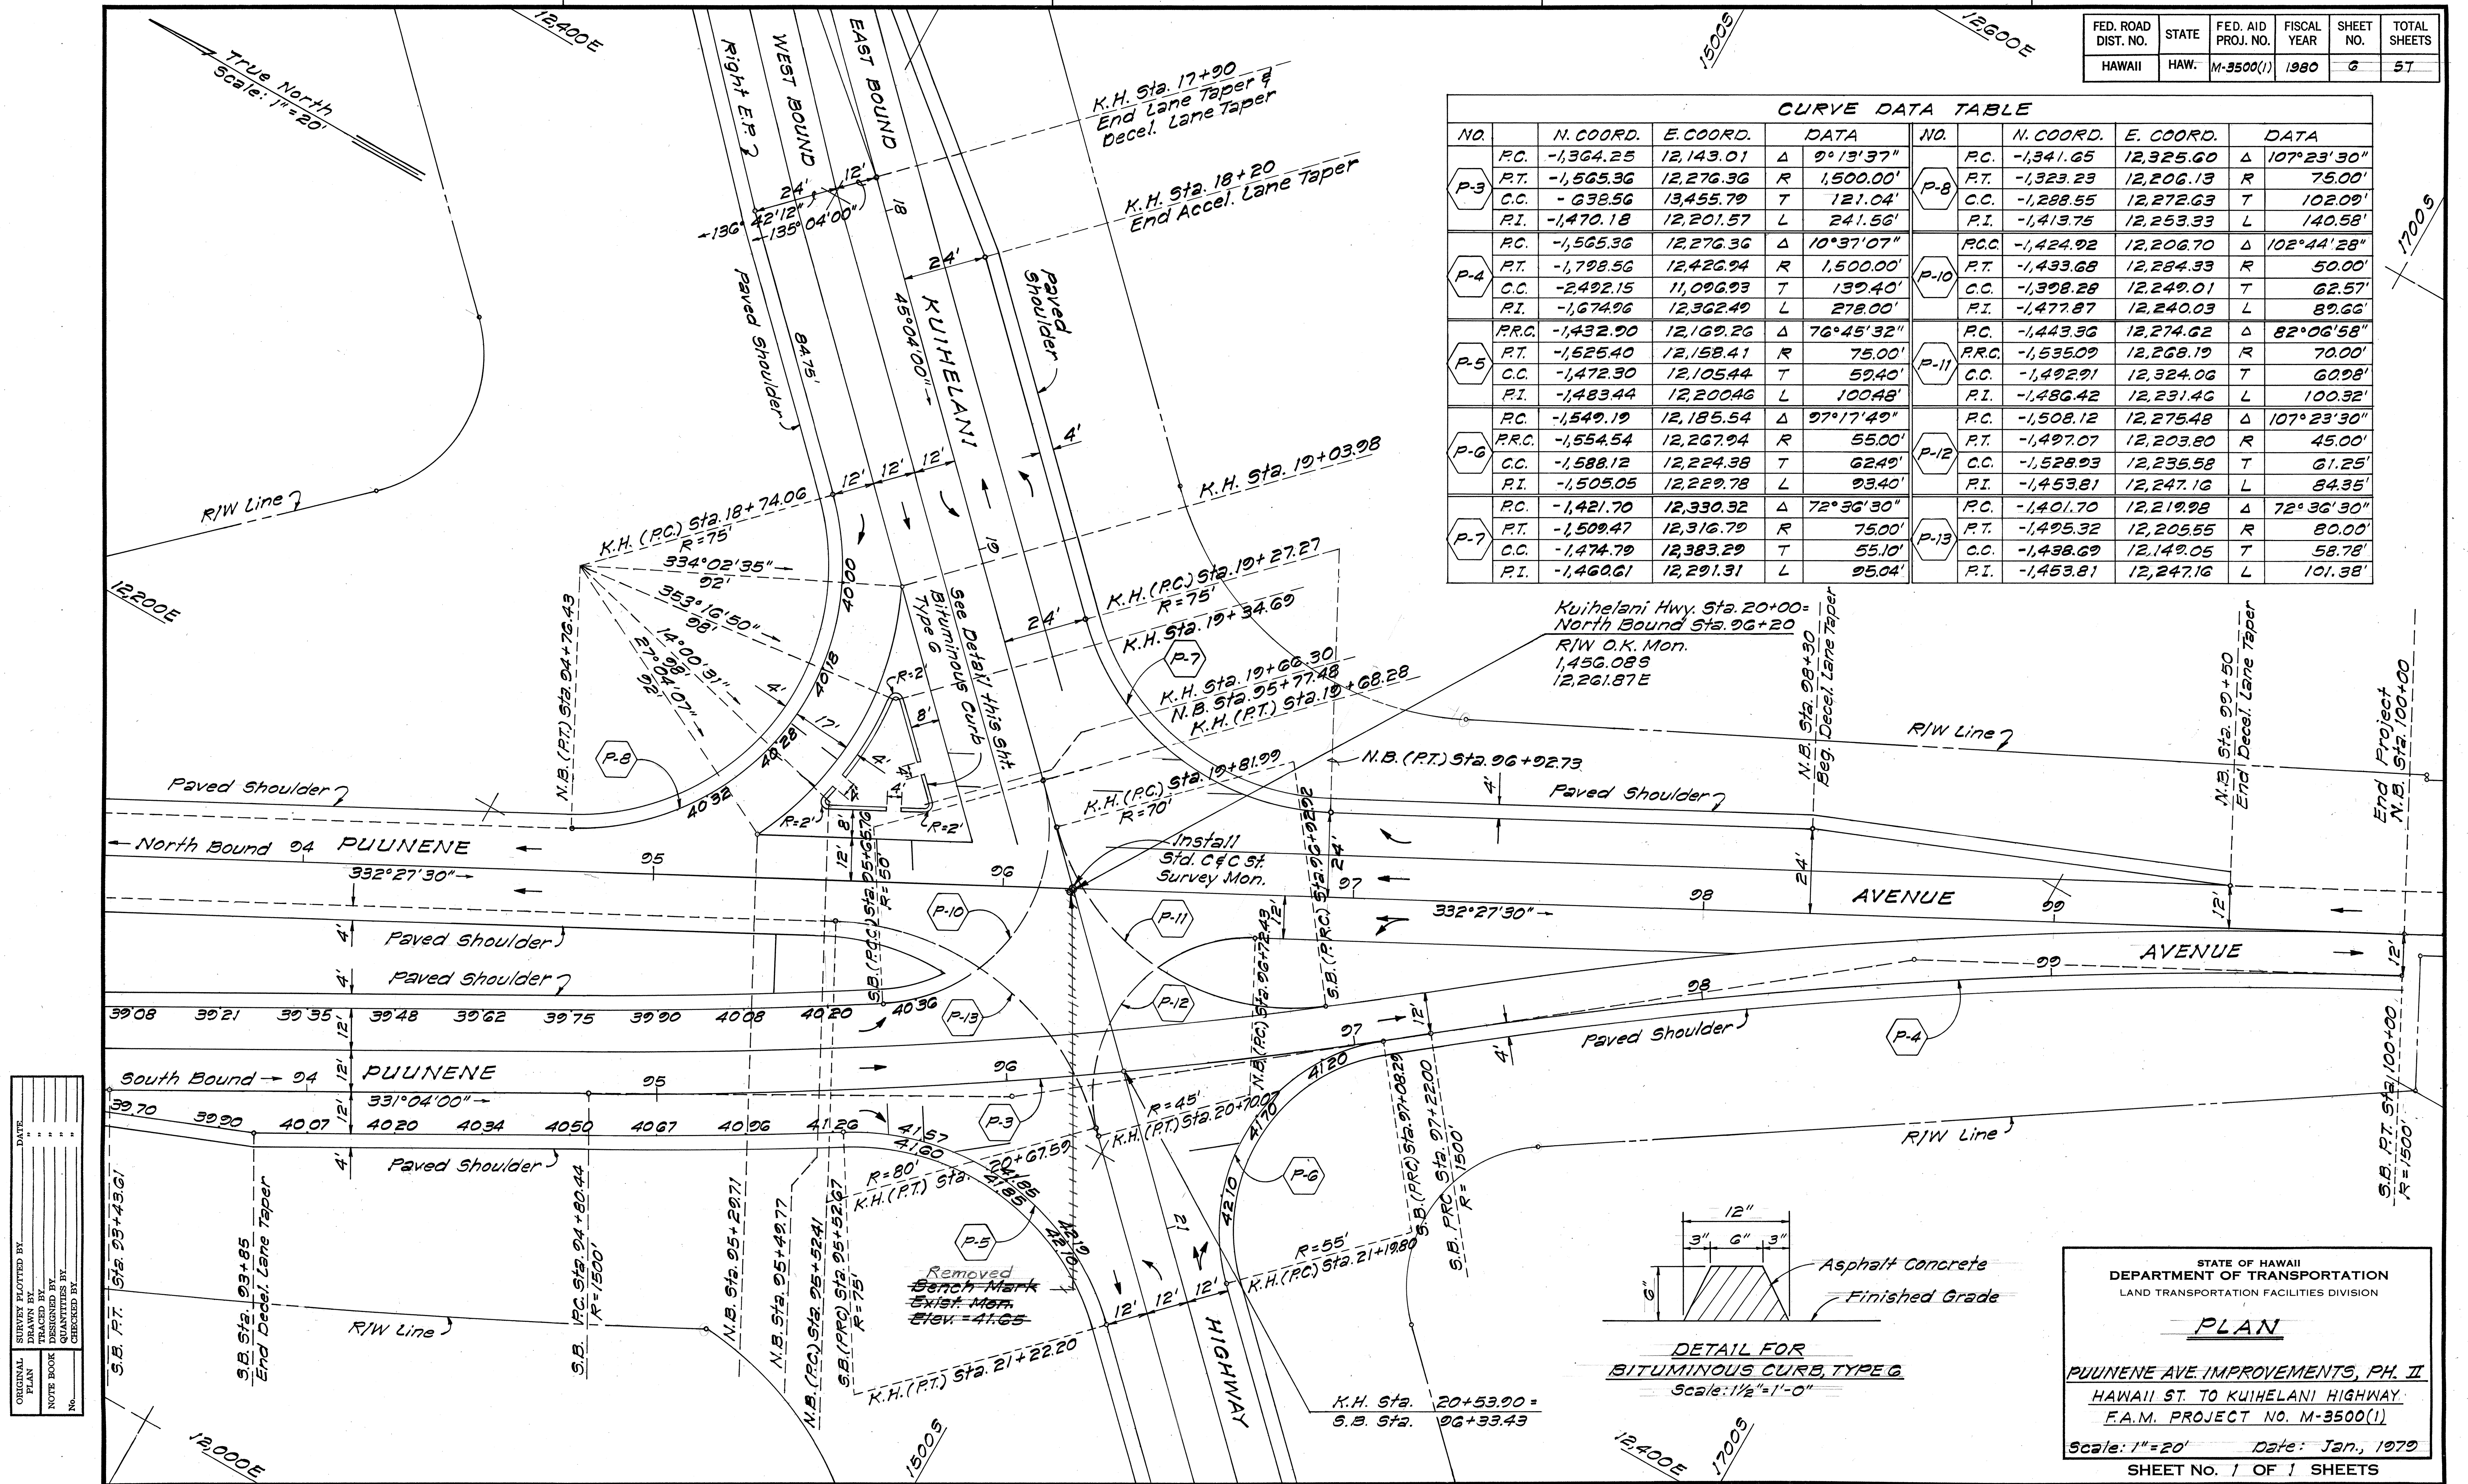

STATE OF HAWAII
DEPARTMENT OF TRANSPORTATION
LAND TRANSPORTATION FACILITIES DIVISION

PLAN

PUUNENE AVE IMPROVEMENTS, PH. II
HAWAII ST. TO KUIHELANI HIGHWAY
F.A.M. PROJECT NO. M-3500(1)

Scale: 1" = 20' Date: Jan., 1979
SHEET NO. 1 OF 1 SHEETS

DATE	
SURVEY PLOTTED BY	
DRAWN BY	
TRACED BY	
CHECKED BY	
NO.	