

FED. ROAD DIST. NO.	STATE	FED. AID PROJ. NO.	FISCAL YEAR	SHEET NO.	TOTAL SHEETS
HAWAII	HAW.	M-3500(1)	1980	15	57

True North
Scale: 1"=50'

BEGIN PROJECT
N.B. STA. 85+74.56

END PROJECT
N.B. STA. 100+00

14,282 Sq. Ft.

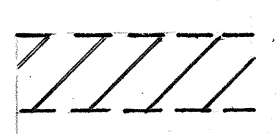
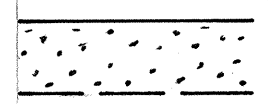
44,405 Sq. Ft.

29,072 Sq. Ft.

Begin Resurfacing
N.B. STA. 88+00

MLNB STA. 87+00

LEGEND

-  Areas to be resurfaced
-  Areas to be grassed

NOTE: No Grass Planting
Sta. 25+68 to Sta. 27+00

STATE OF HAWAII
DEPARTMENT OF TRANSPORTATION
LAND TRANSPORTATION FACILITIES DIVISION

RESURFACING AND GRASSED SURFACES PLAN

PUUNENE AVE IMPROVEMENTS, PH. II
HAWAII ST. TO KUIHELANI HIGHWAY
F.A.M. PROJECT NO. M-3500(1)

Scale: 1"=50' Date: Apr. 1979

SHEET NO. 1 OF 1 SHEETS