



FED. ROAD DIST. NO.	STATE	FED. AID PROJ. NO.	FISCAL YEAR	SHEET NO.	TOTAL SHEETS
HAWAII	HA	DA-NCB(1)	1943	13A	#3

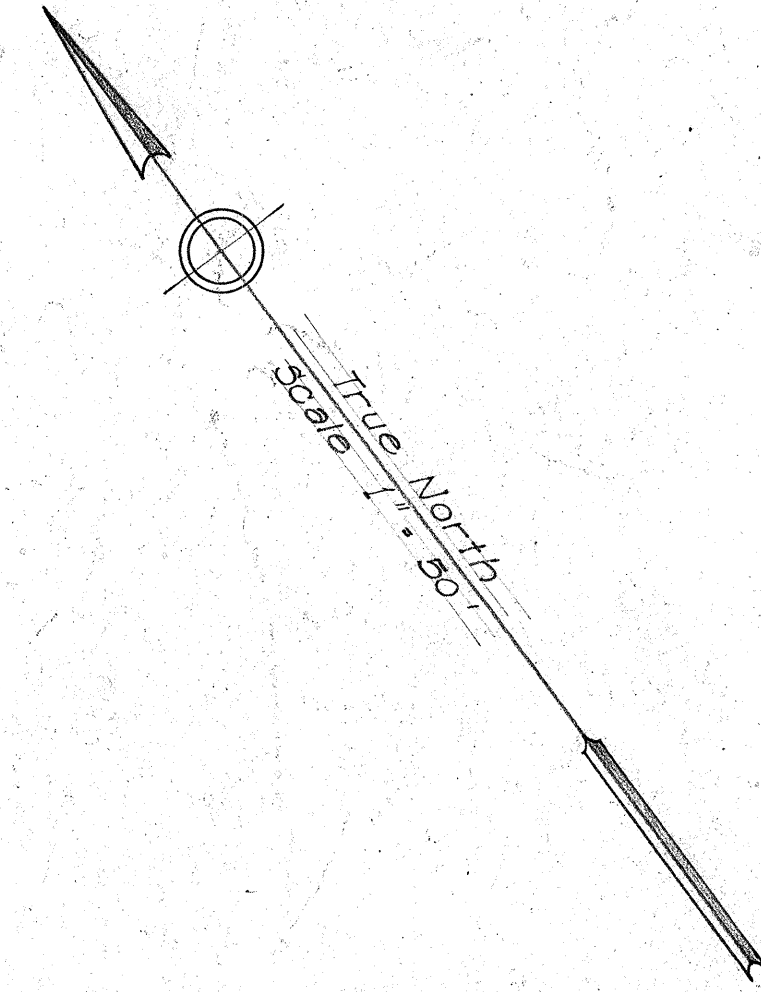

ORIGINAL	SURVEY PLOTTED BY	DATE
DESIGNED BY		
TRACED BY		
QUANTITIES BY		
CHECKED BY		
INCHES		

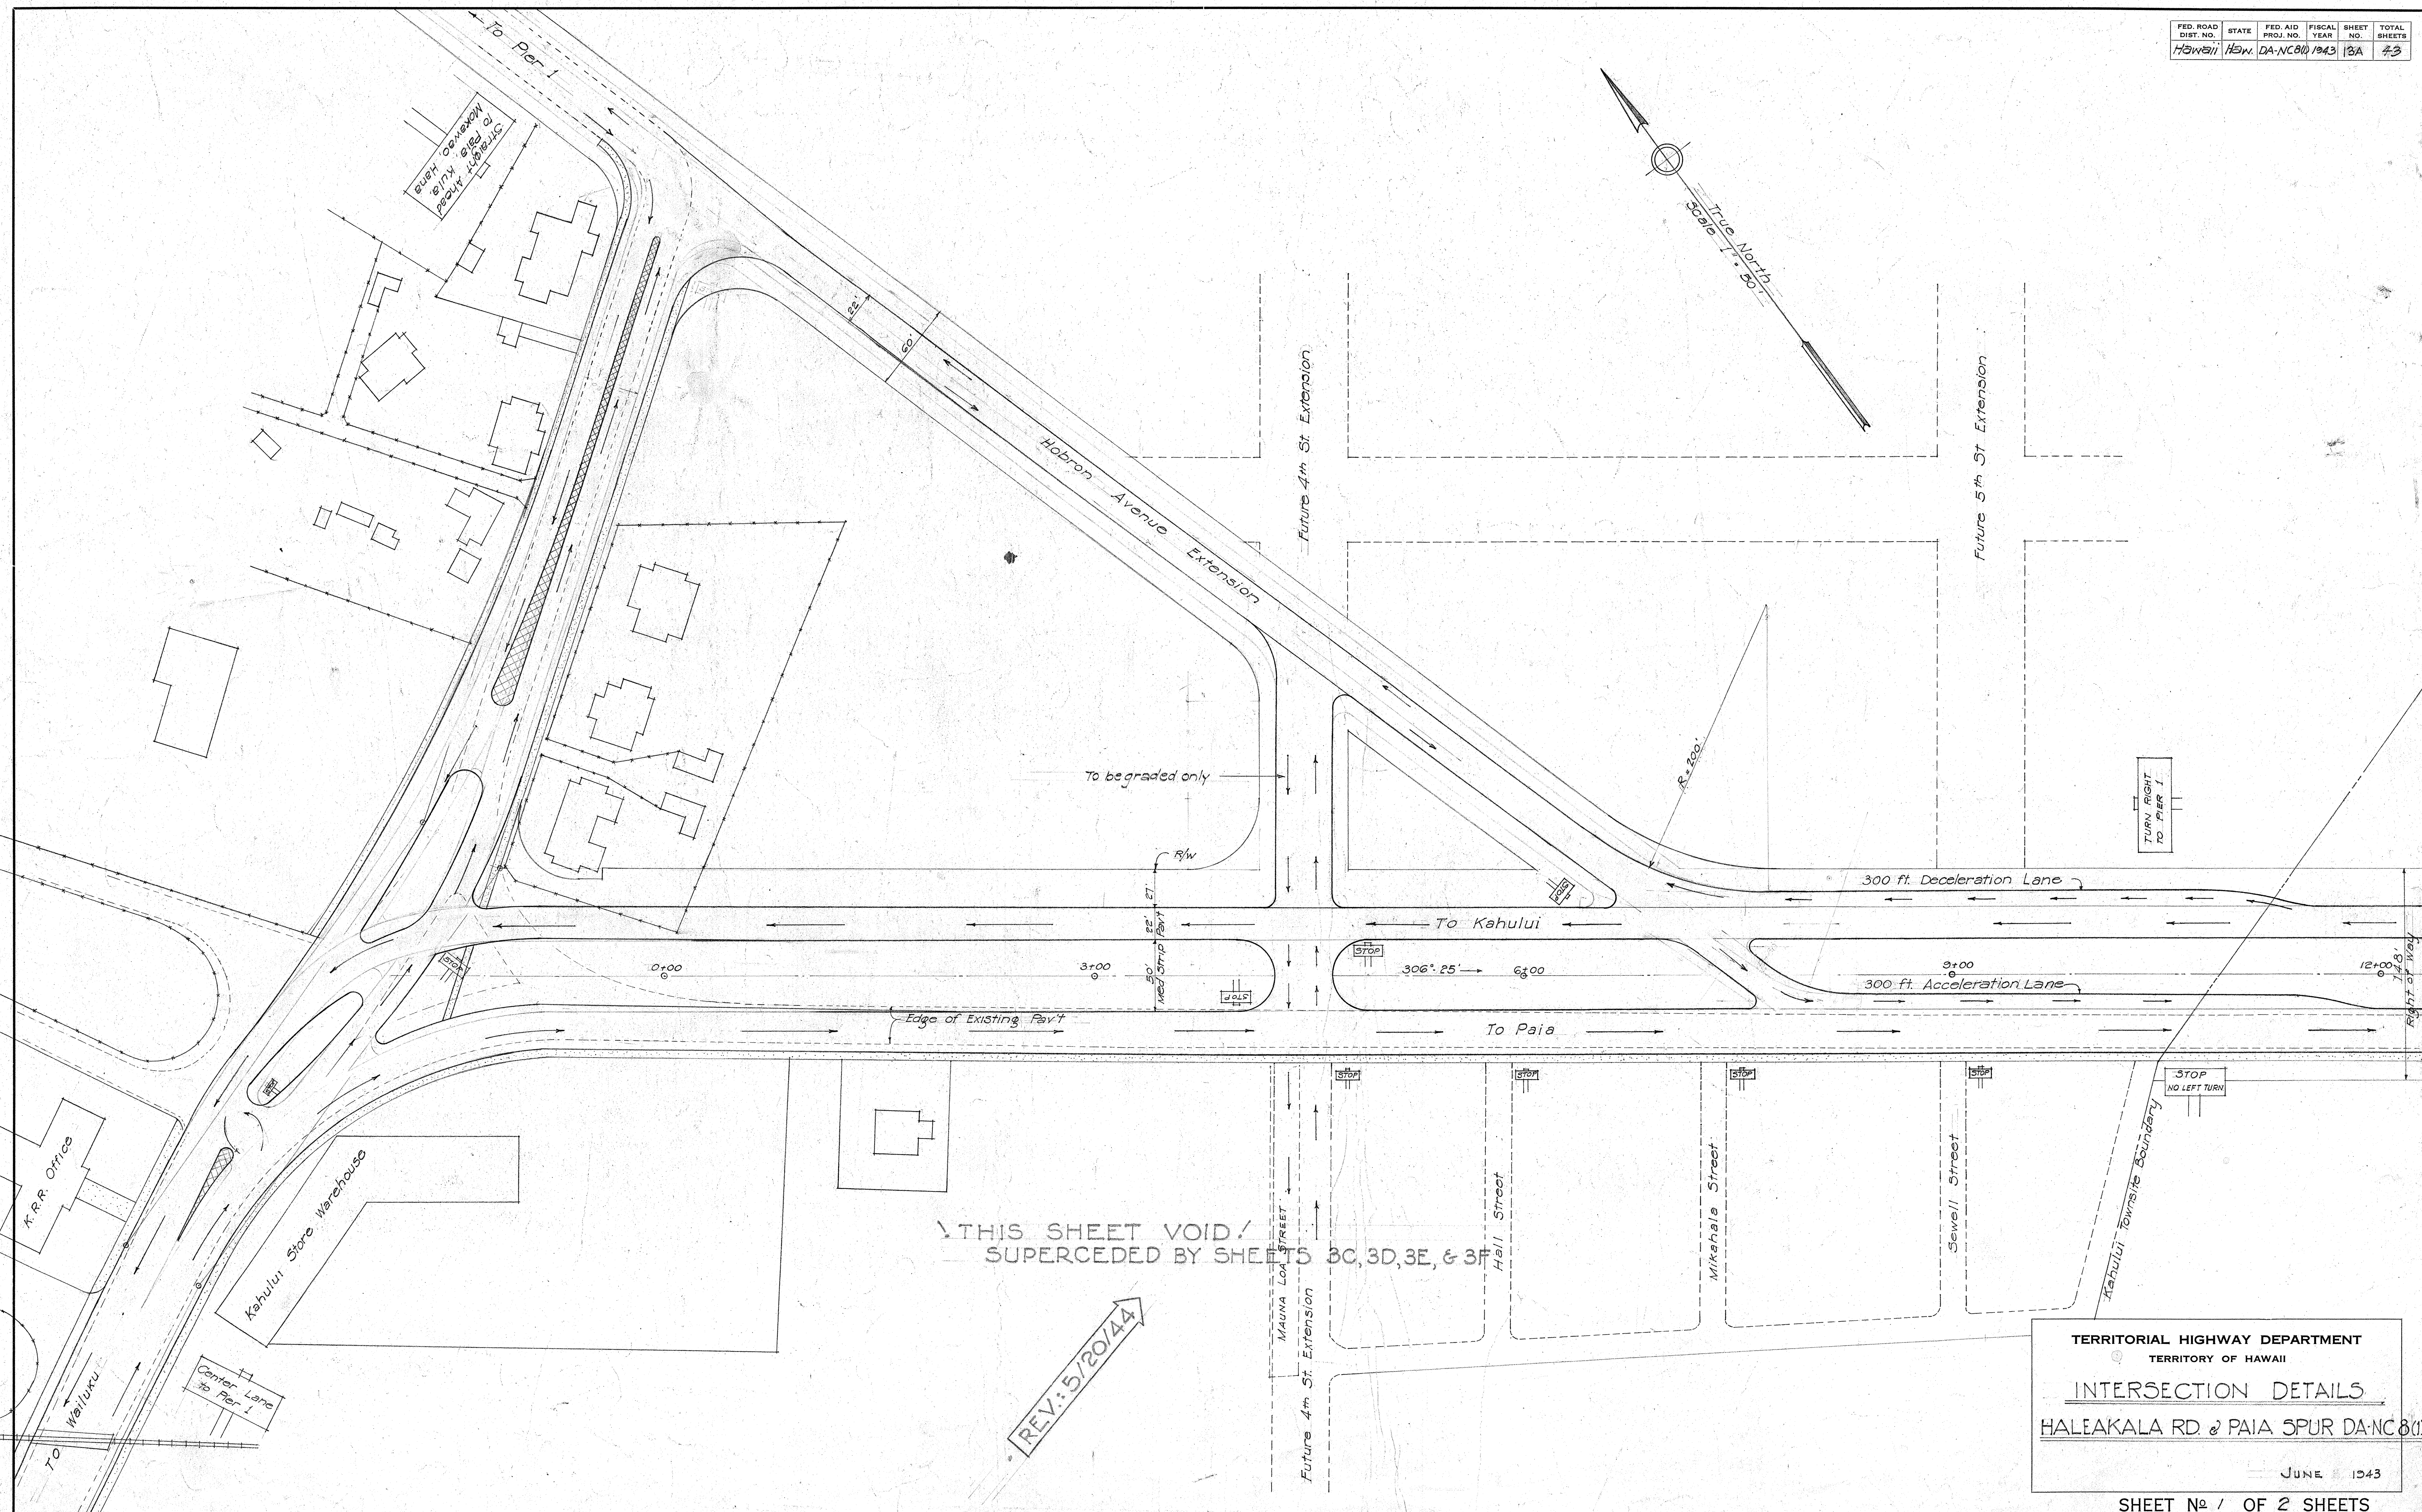

THIS SHEET VOID!
SUPERCEDED BY SHEETS 3B, 3D, 3E, & 3F

REV: 5/20/44

TERRITORIAL HIGHWAY DEPARTMENT
TERRITORY OF HAWAII

INTERSECTION DETAILS

HALEAKALA RD & PAIA SPUR DA-NCB(1)

JUNE 1943


SHEET No 1 OF 2 SHEETS

FED. ROAD DIST. NO.	STATE	FED. AID PROJ. NO.	FISCAL YEAR	SHEET NO.	TOTAL SHEETS
HAWAII	HAW.	DA-NC-8(1)	1943	13B	43

- LEGEND
- RP - Power Pole (Electric)
 - C.P. - Cable Pole (Telephone)
 - G.P. - Guy Pole
 - Anchor - Guy Wire Anchor
 - 6" Conc. Curb
 - 4" Conc. Rolled Curb

NOTE:
Power poles and anchors to be moved to new locations by others.
Where 6" conc. curb is installed, pavement shall be widened by 1'-0".


Black Letters on white background

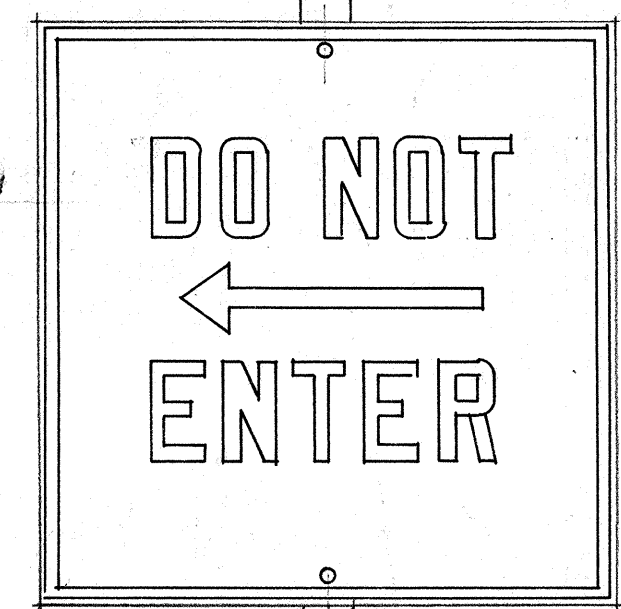


Black Letters on yellow background. 1/2" black border

W.O. NO. 10 7/12/44

24" x 24" Waterproof plywood about 3/8" thick.

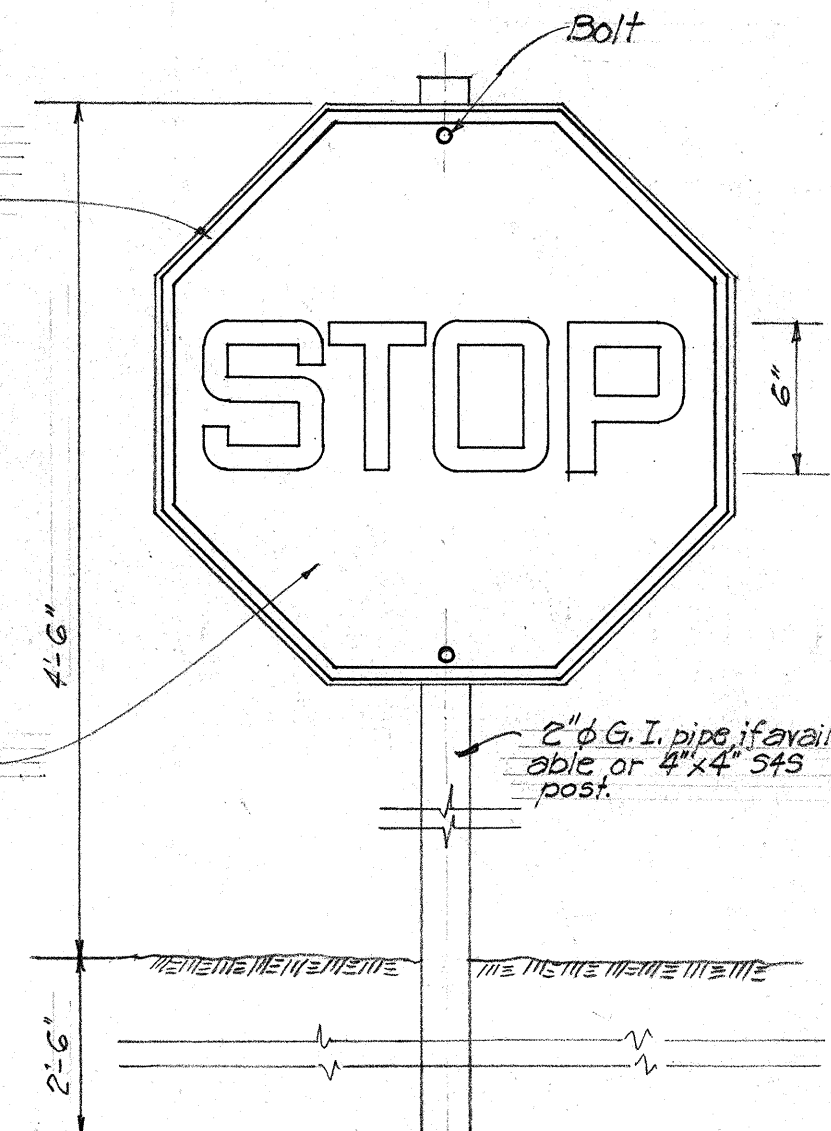

Scale: 1 1/2" = 1'-0"

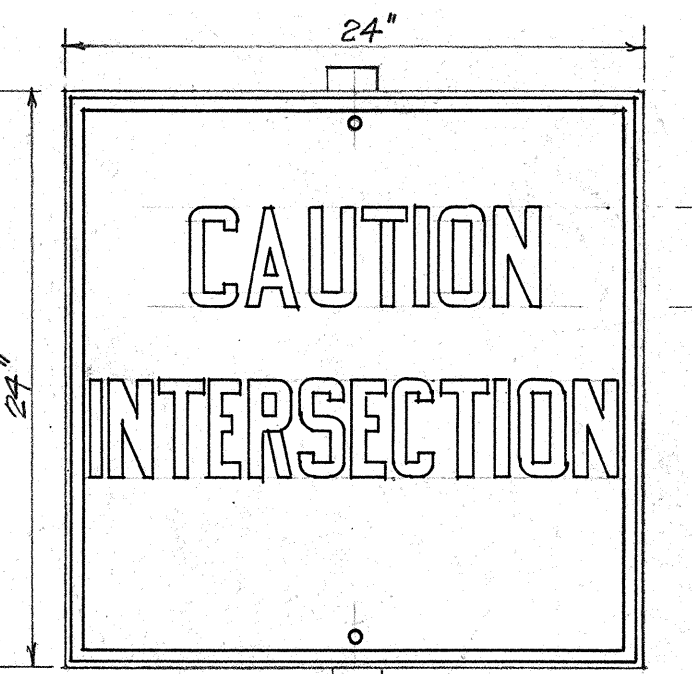


DETAIL OF SIGNS

NOTE: All signs to be built as incidental to intersection.

Revised: July 12, 1944

ORIGINAL SURVEY REPORT BY	DATE
DESIGNED BY	
NOTED BY	
QUANTITIES BY	
CHECKED BY	

NOTE: This intersection to be adjusted in field as directed by the Engineer.

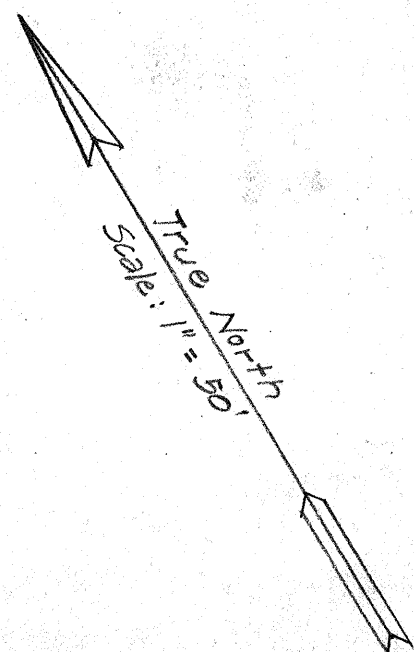


REV. 4-27-45





REV. 4-27-45

TERRITORIAL HIGHWAY DEPARTMENT
TERRITORY OF HAWAII
INTERSECTION DETAILS
HALEAKALA RD. & PAIA SPUR DA-NC8(1)

5119.1313

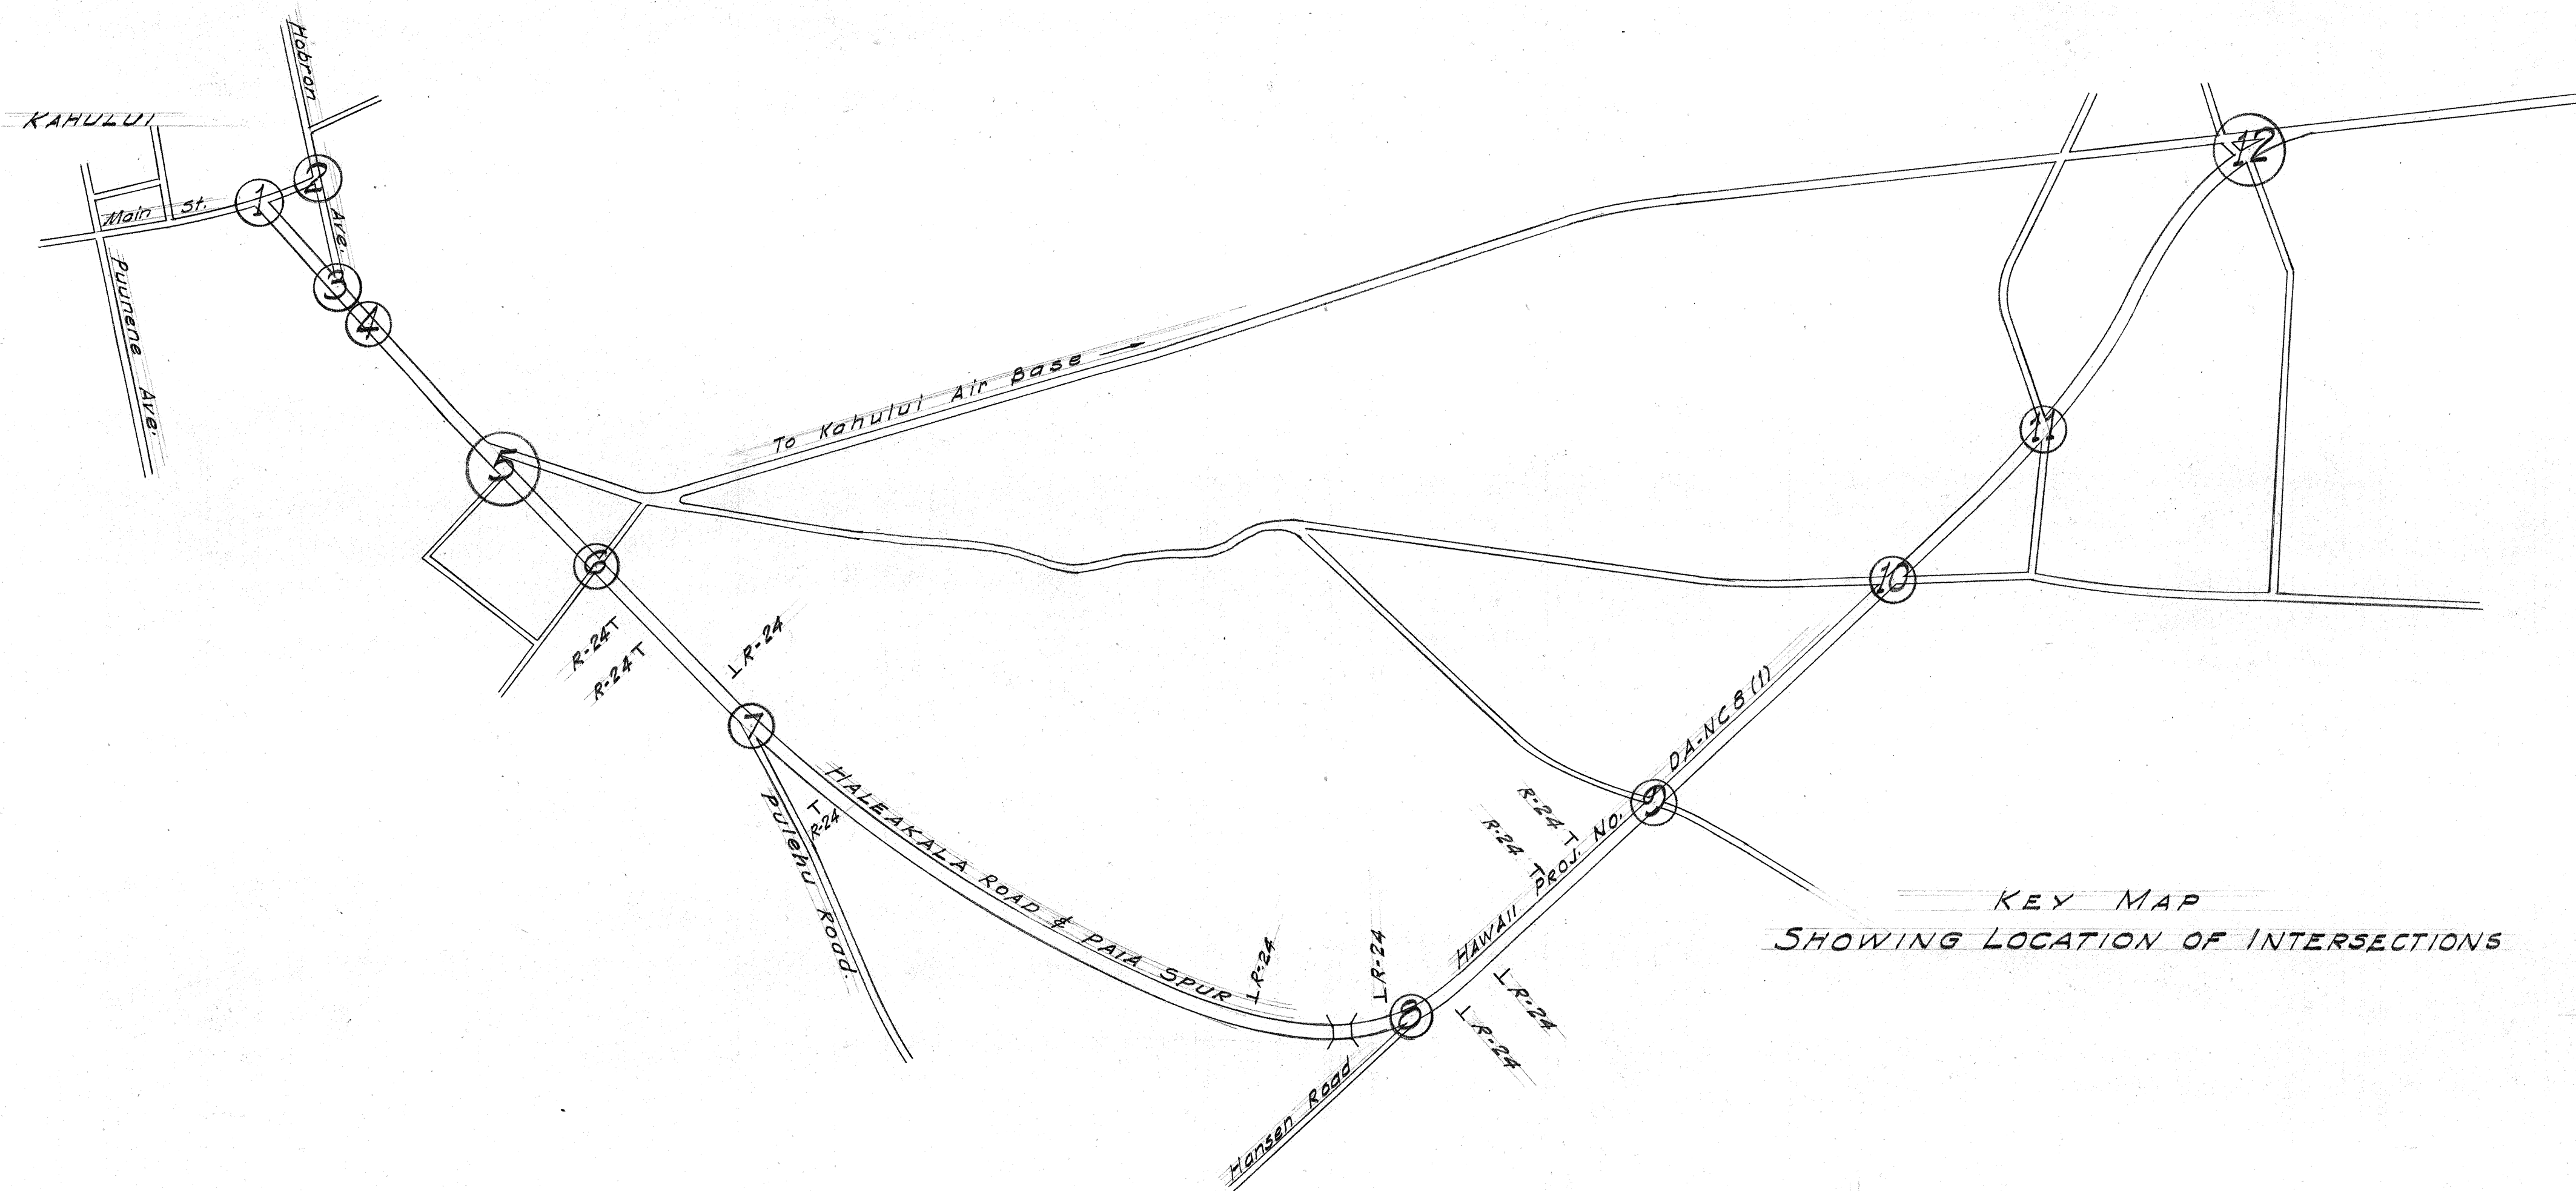


KEY MAP
SHOWING LOCATION OF INTERSECTIONS

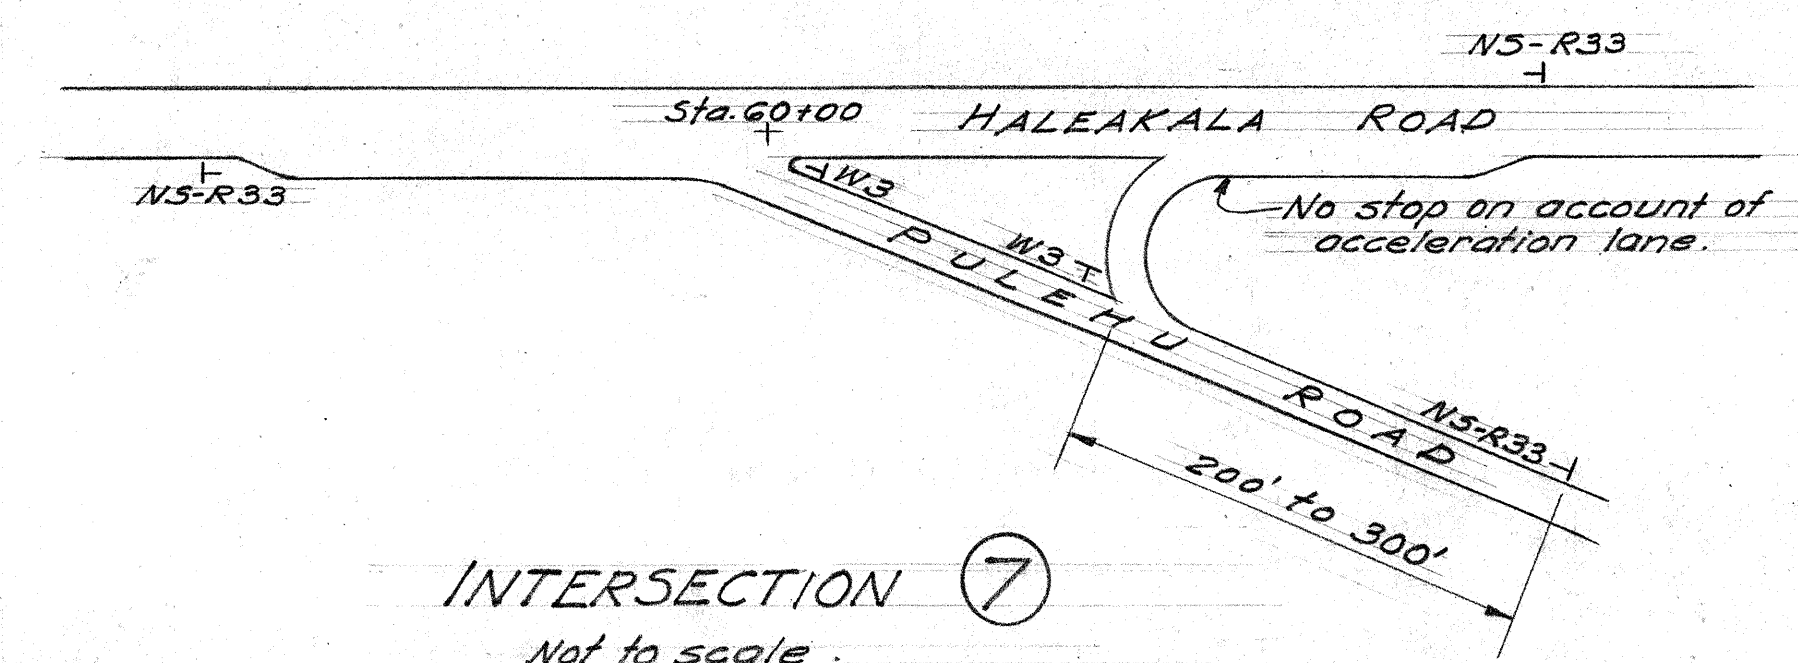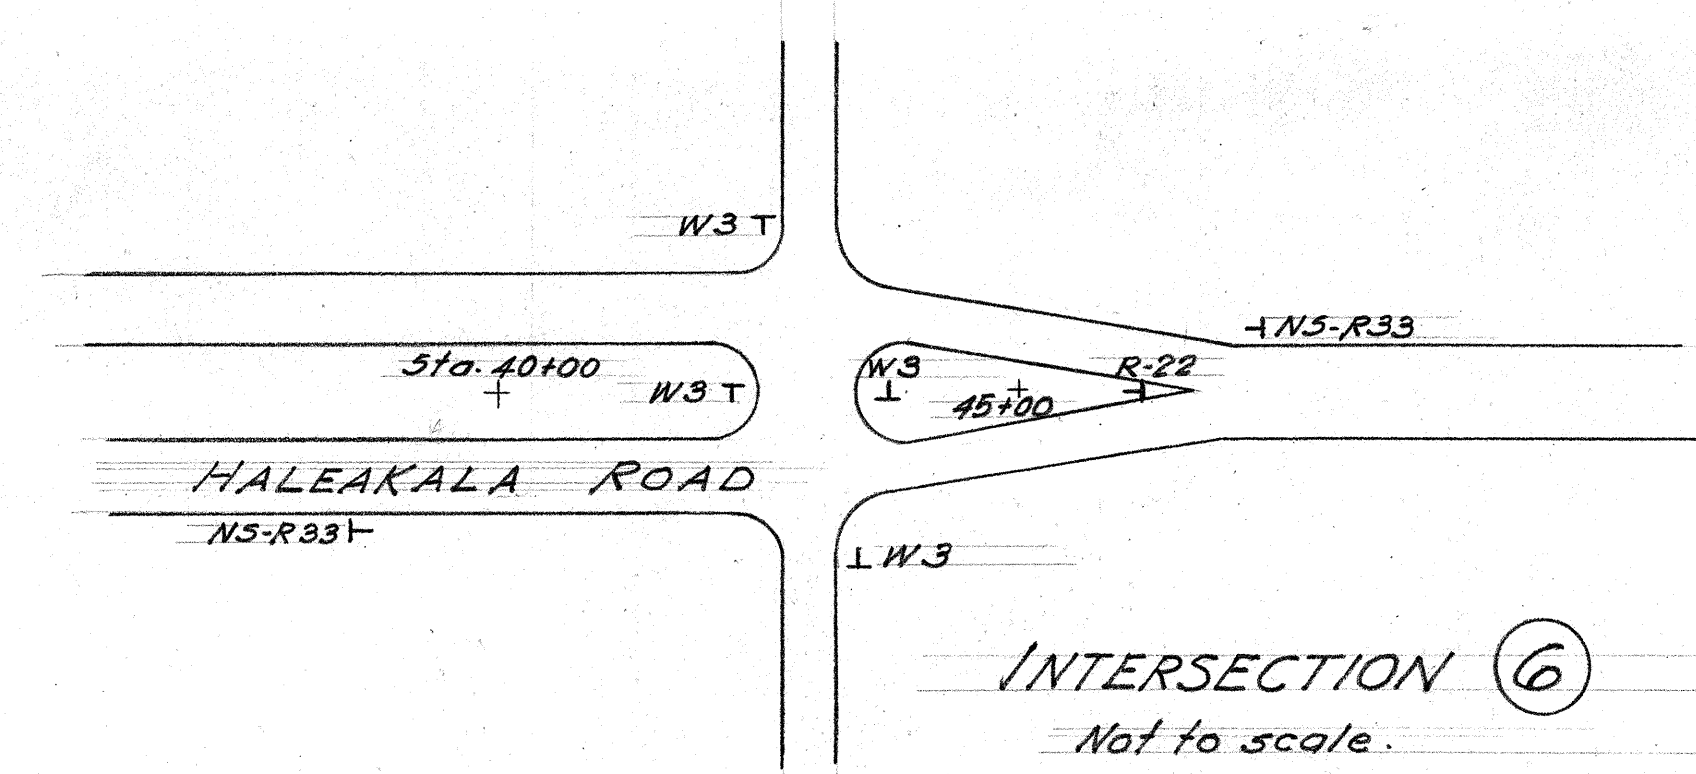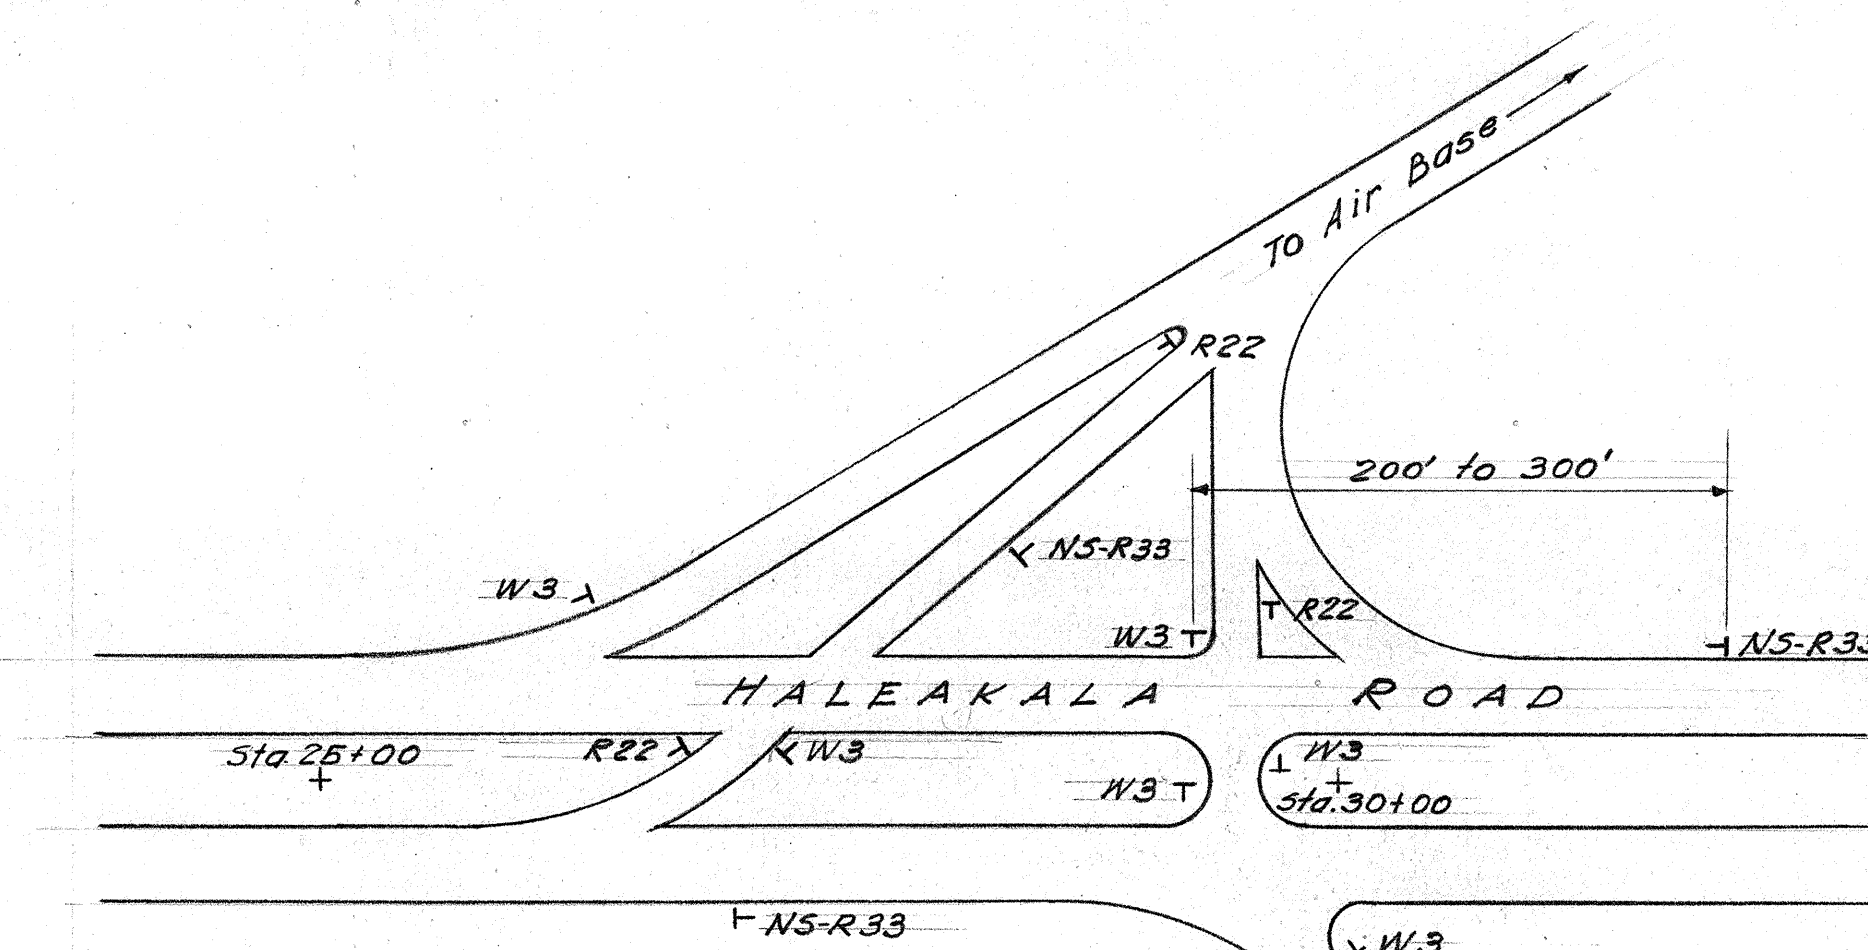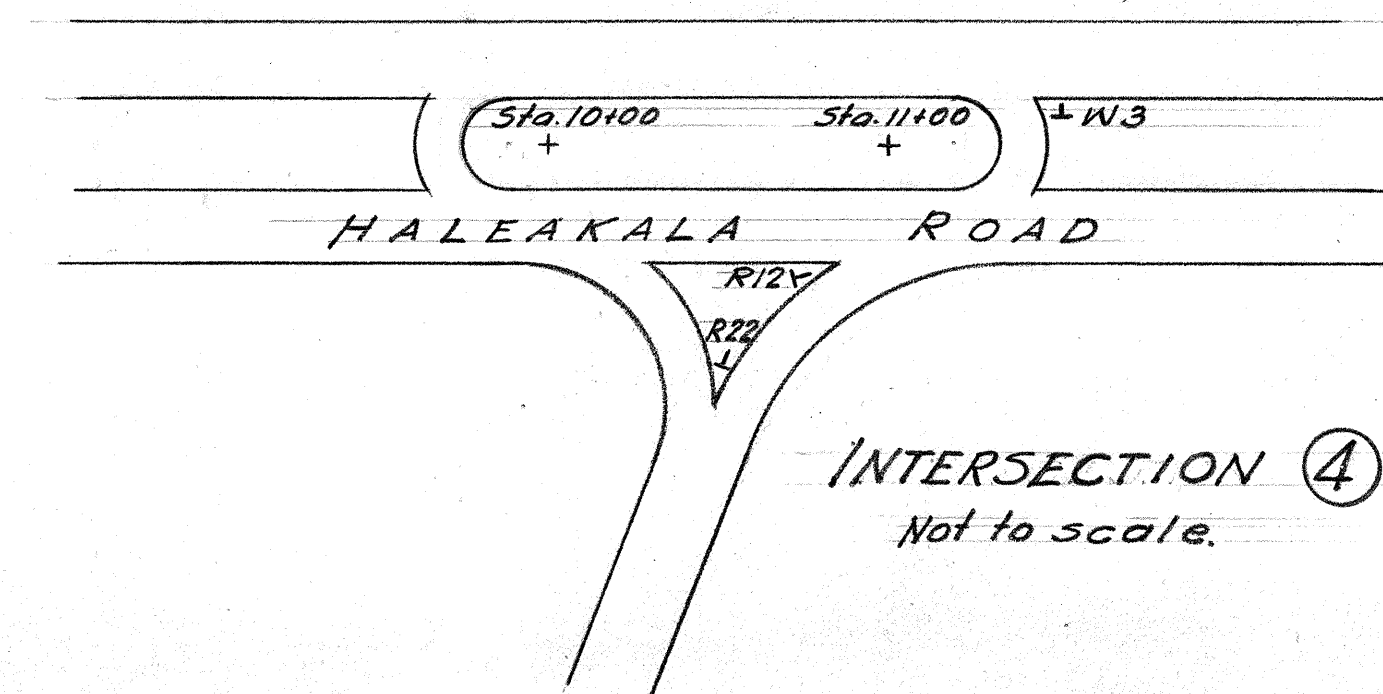

TERRITORIAL HIGHWAY DEPARTMENT
TERRITORY OF HAWAII
LOCATION & DETAILS OF TRAFFIC SIGNS
ON
HALEAKALA ROAD & PAIA SPUR
HAWAII PROJECT NO. DA-NC 8(1)
Feb. 10, 1945.

SHEET No. 1 OF 2 SHEETS



5119.13C

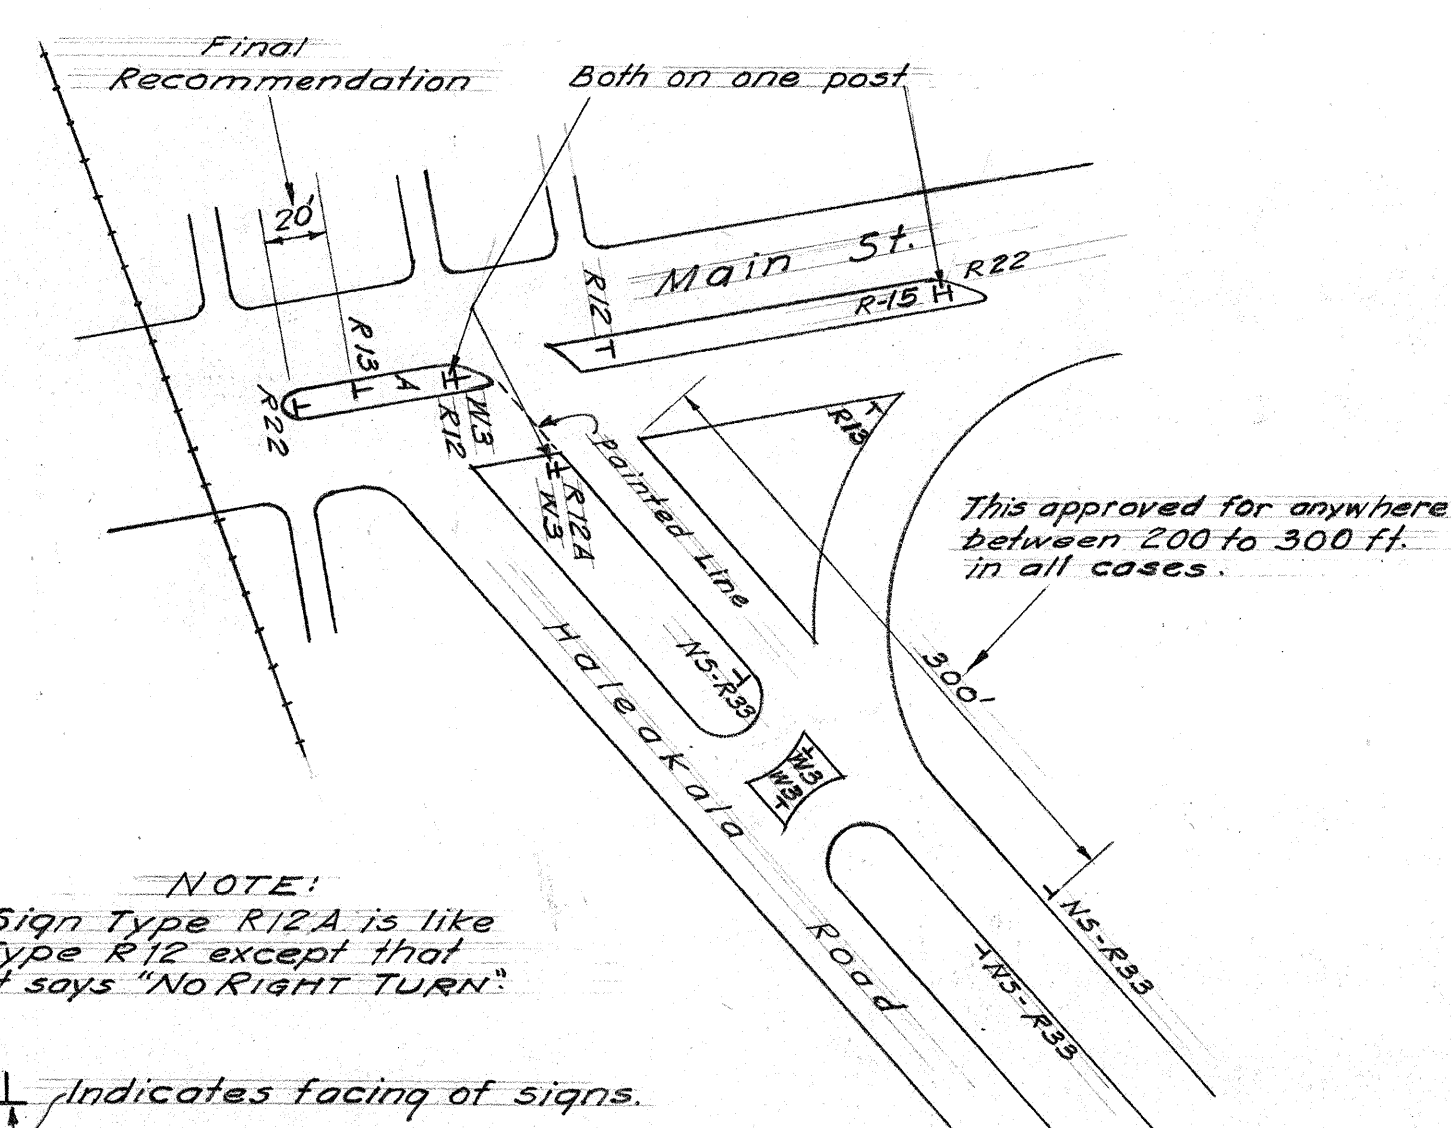

NOTE:
Sign Type R12A is like Type R12 except that it says "No Right Turn".


Indicates facing of signs.

INTERSECTION ①
Not to scale.

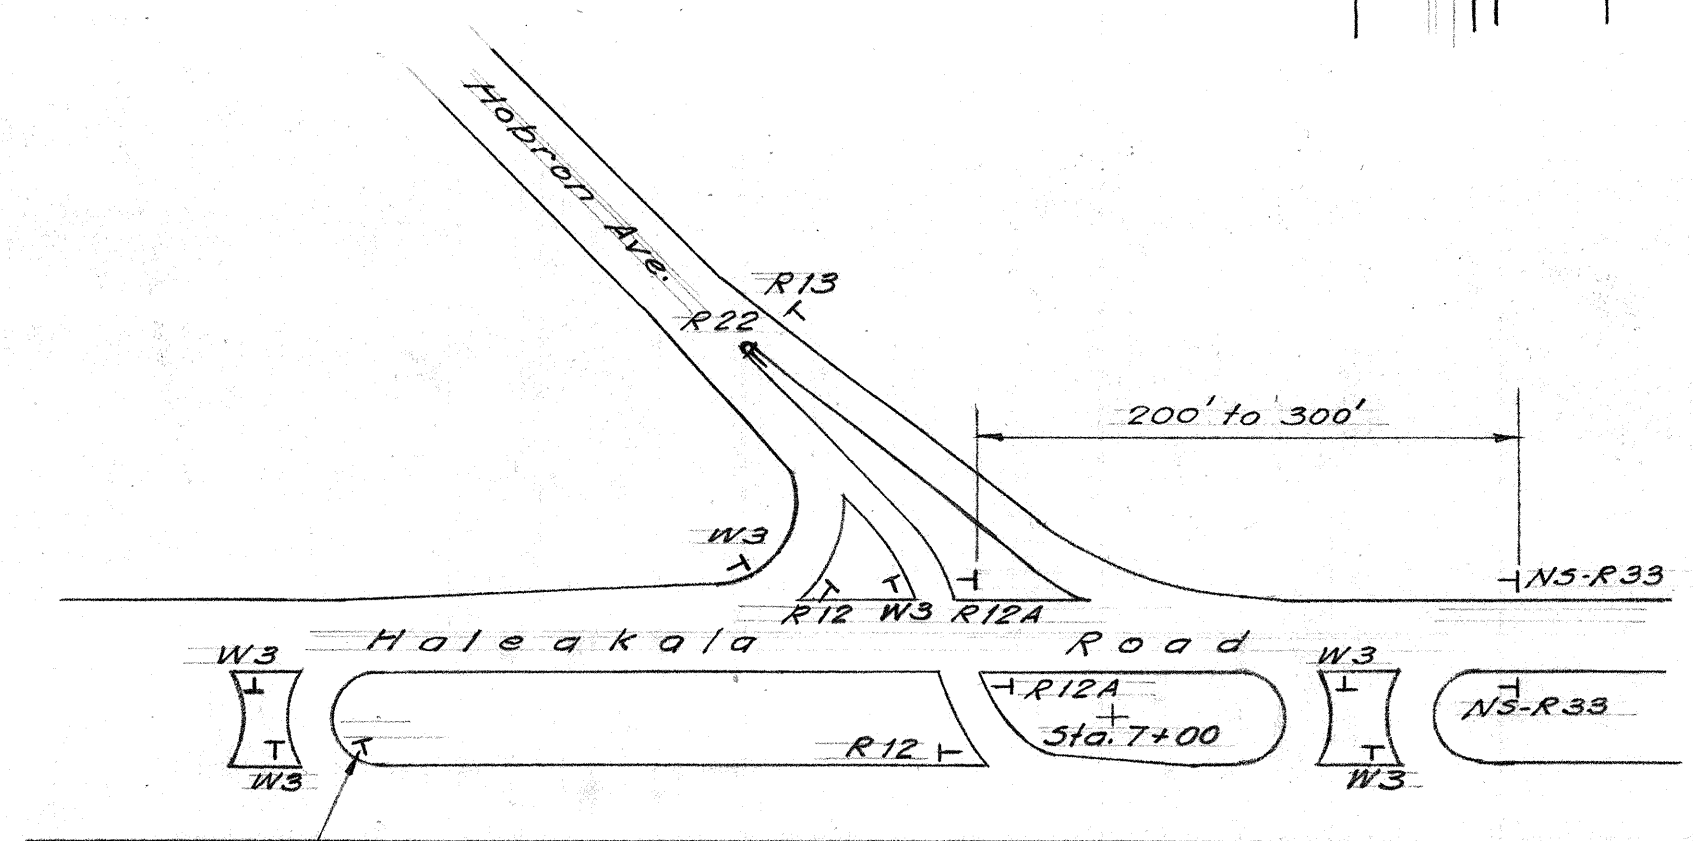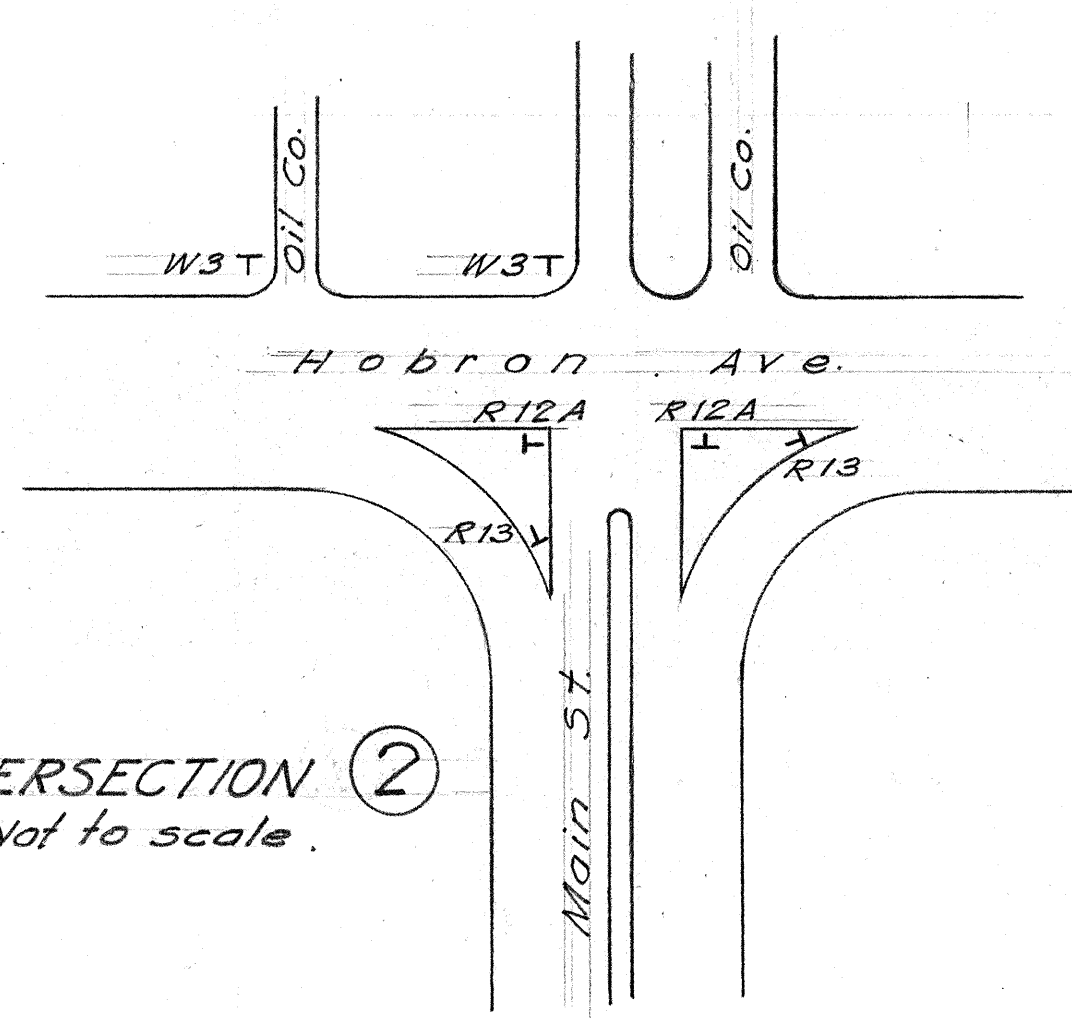


All turns of this type should have W-3 at exit.


ORIGINAL PLAN	DATE
SURVEY PLOTTED BY	
DESIGNED BY	
DRAWN BY	
QUANTITIES CHECKED BY	
NOTE BOOK	
CHECKED BY	

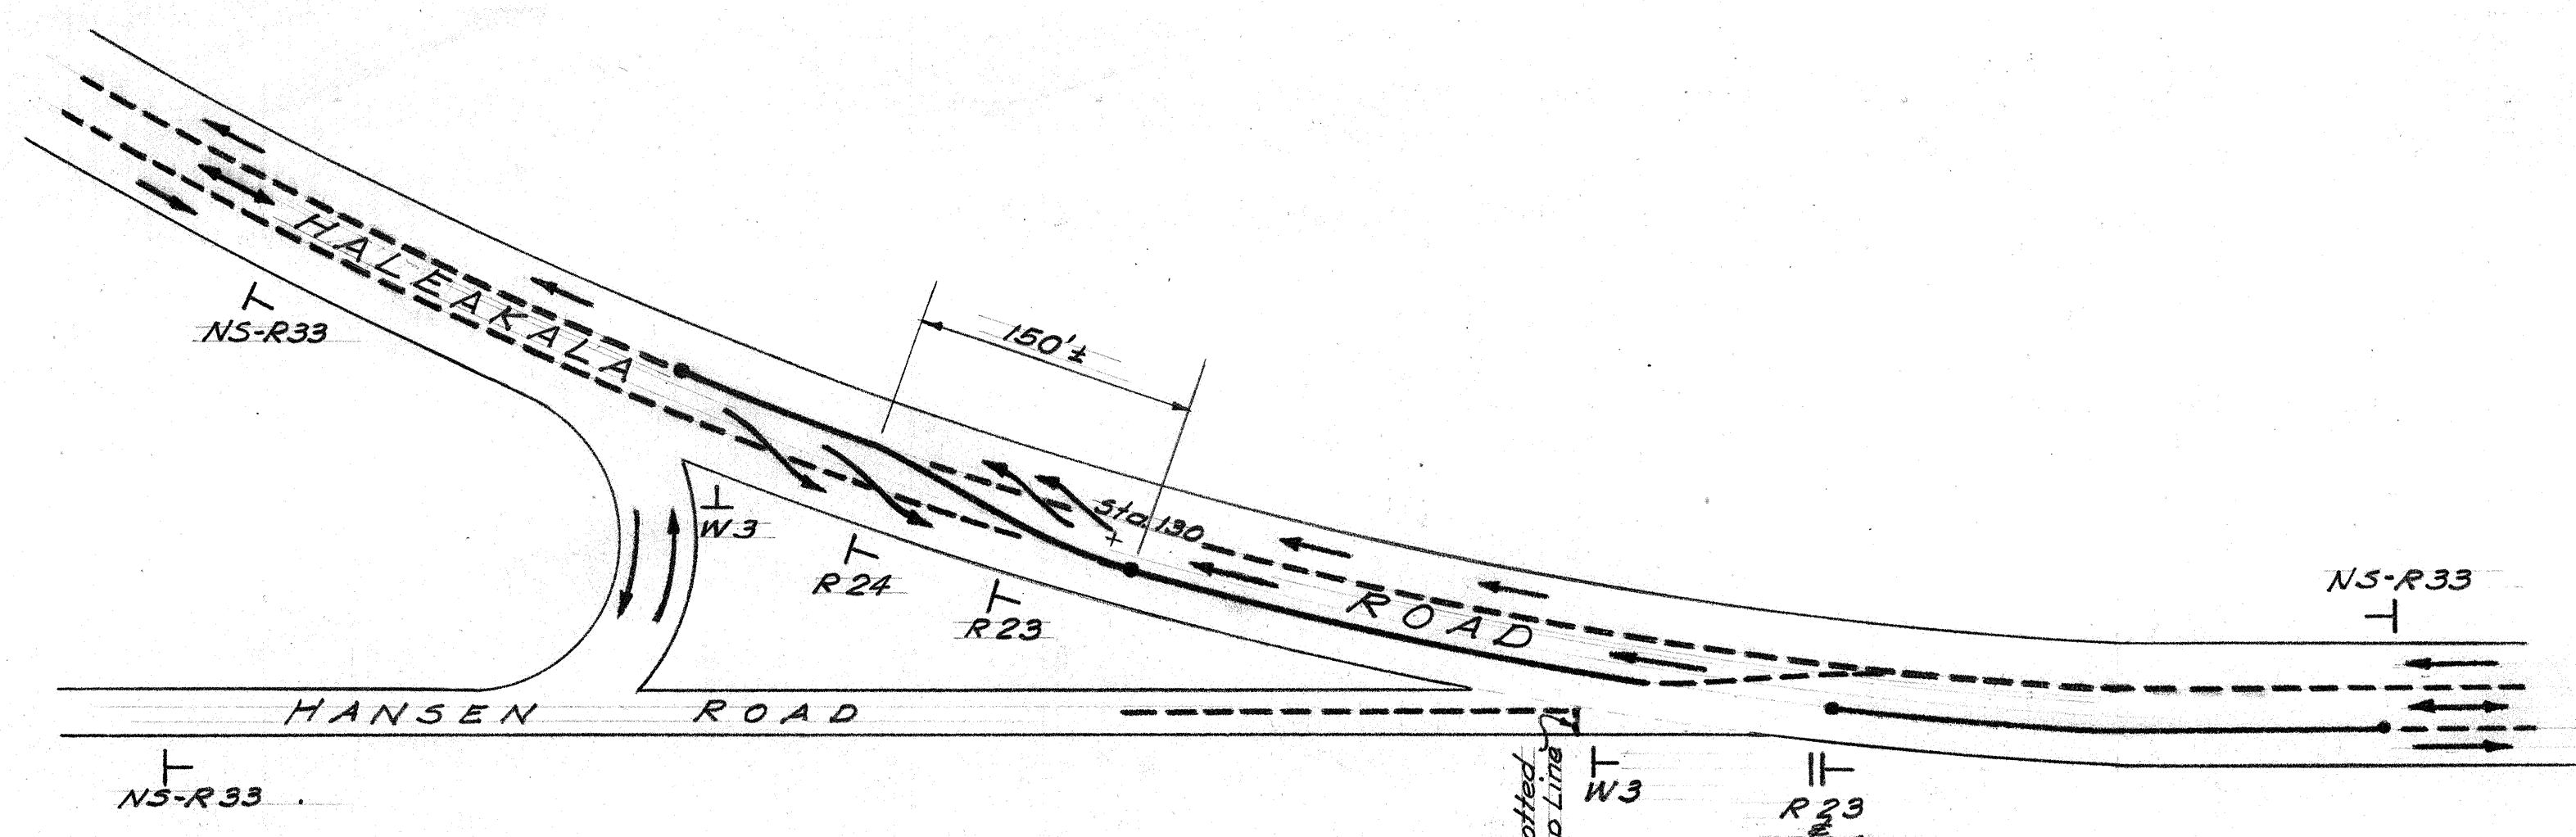


INTERSECTION 8
Not to scale.

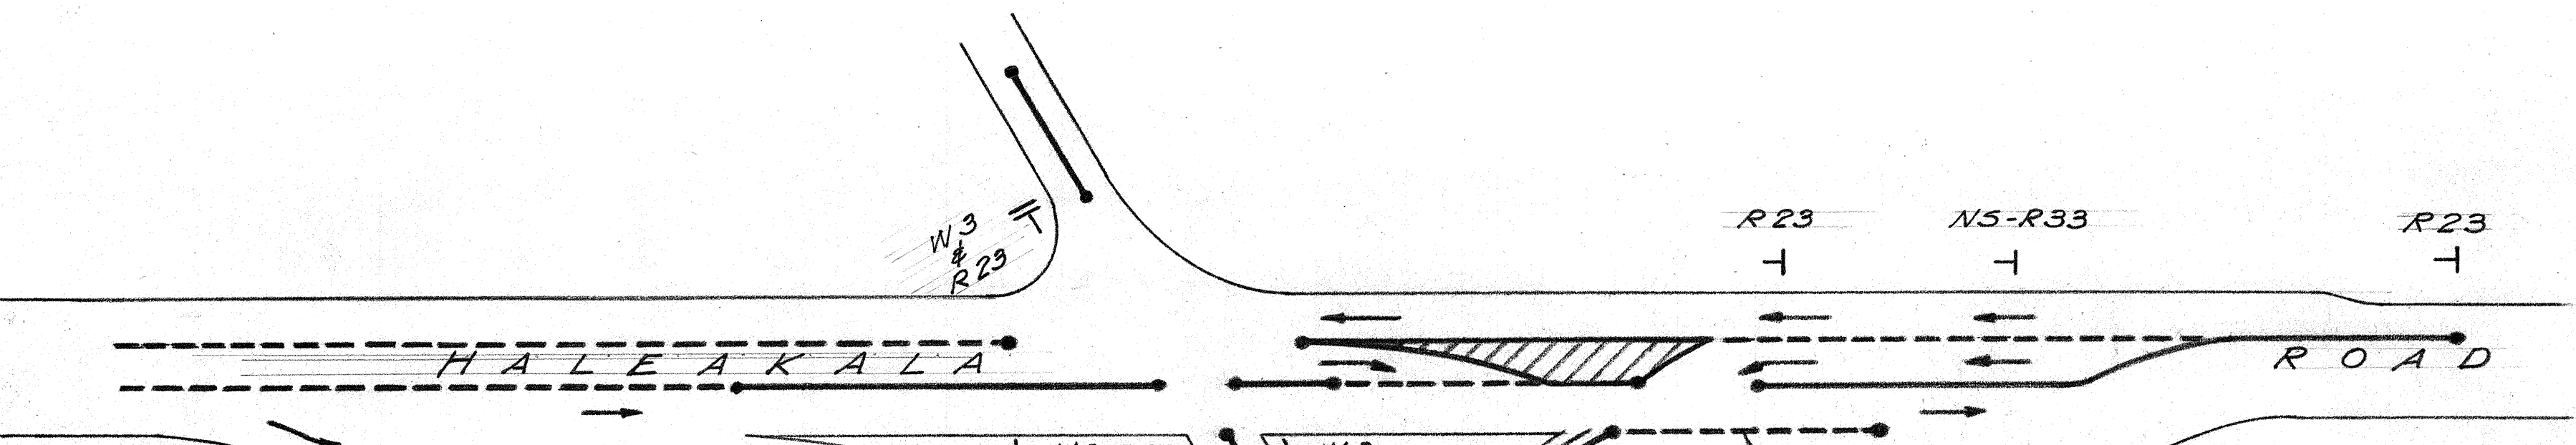


INTERSECTION 9
Not to scale.

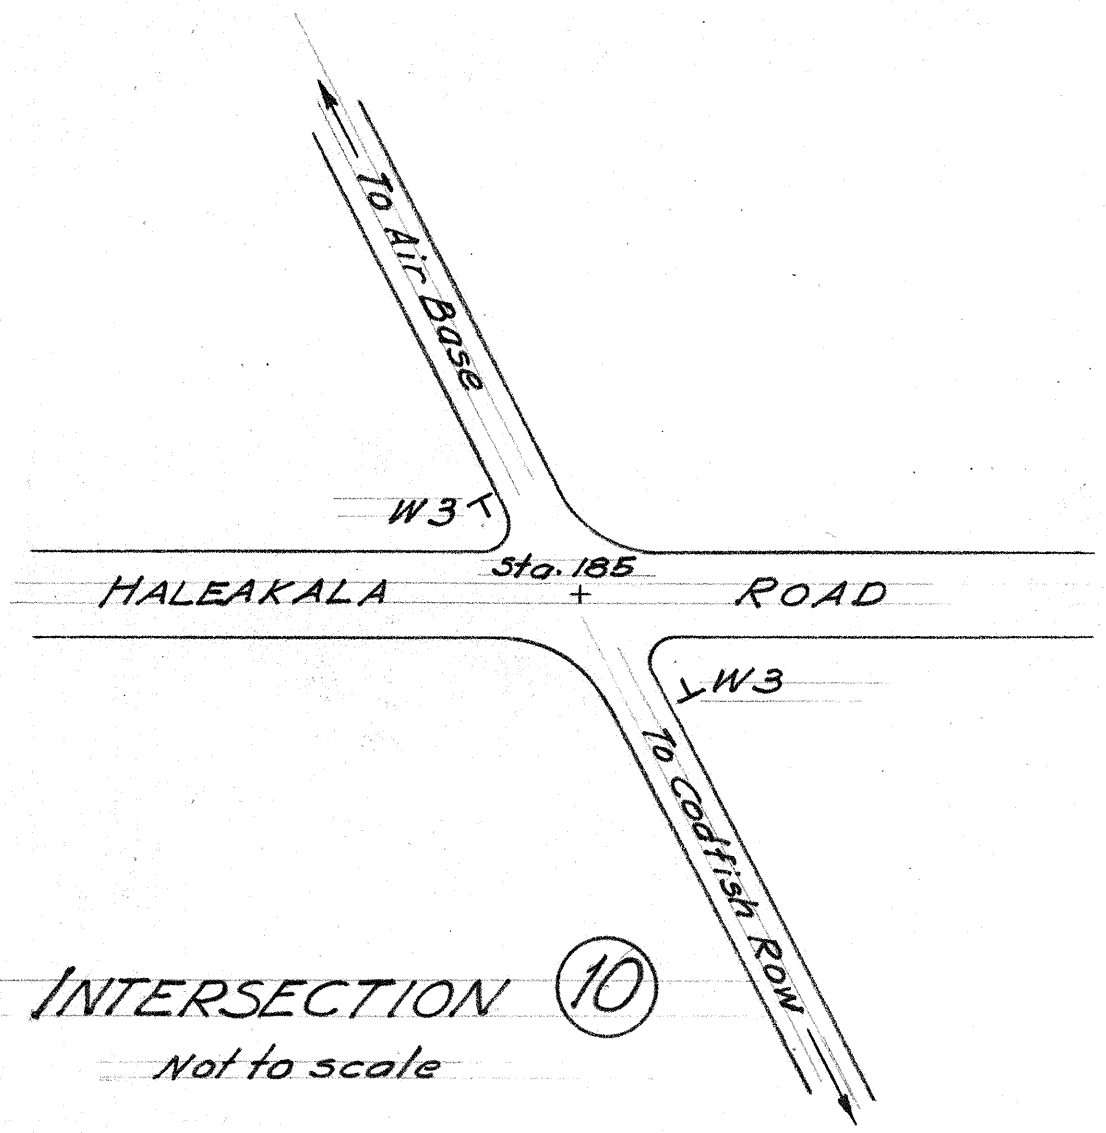


INTERSECTION 10
Not to scale.

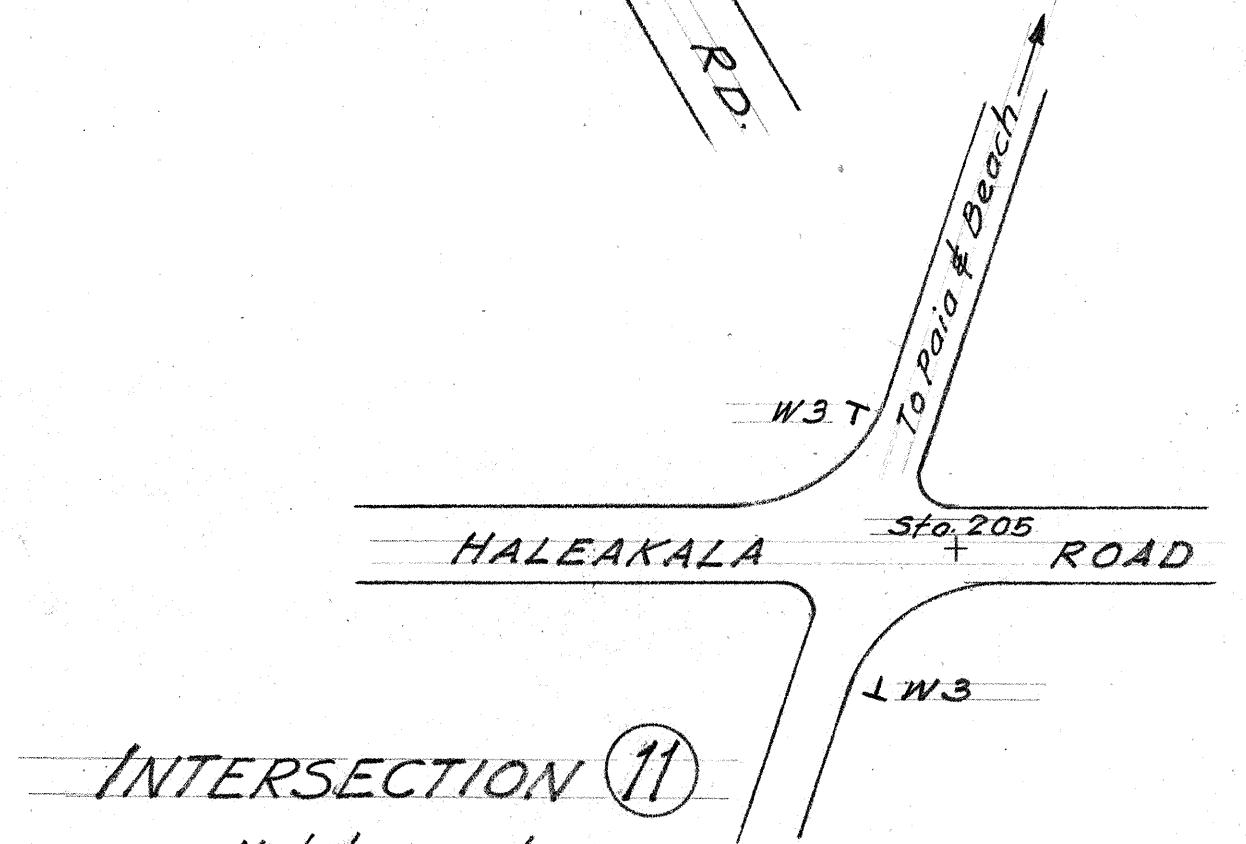


INTERSECTION 11
Not to scale.

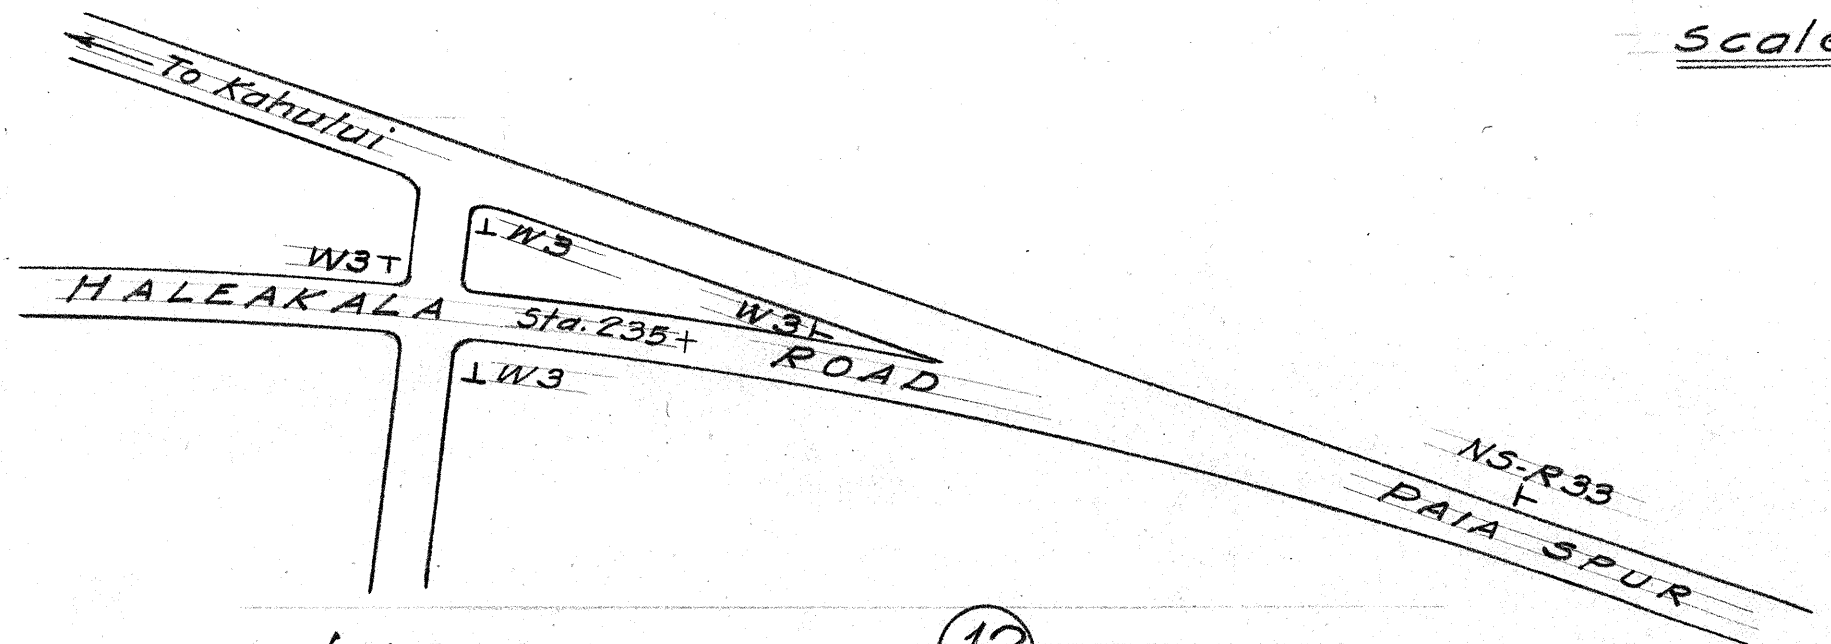


INTERSECTION 12
Not to scale.

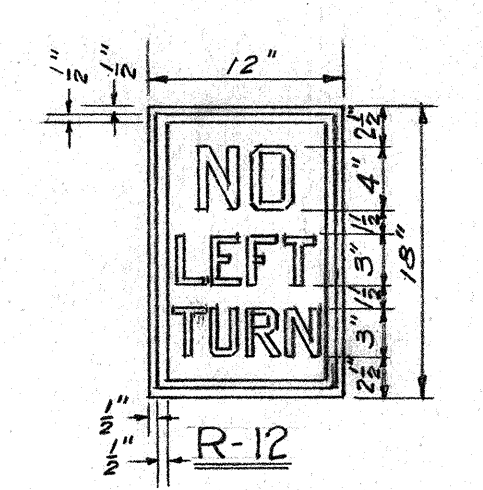


R-12
Black letters and borders on White background.

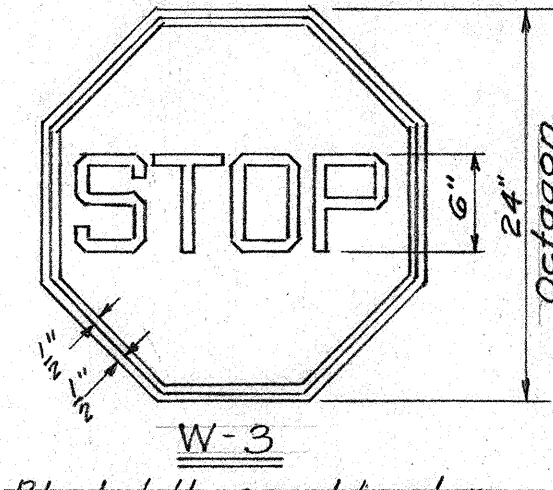


W-3
Black letters and borders on Yellow background.

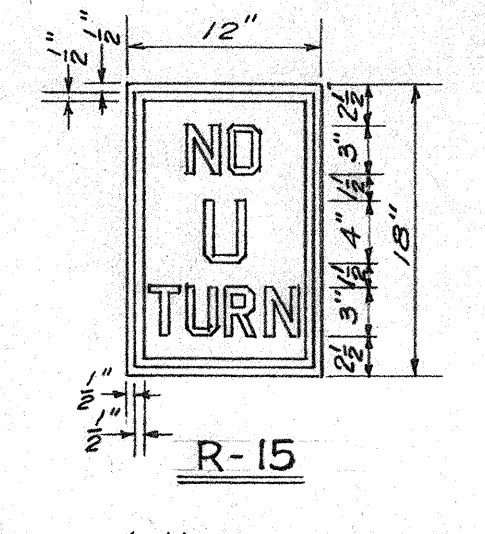


R-15
Black letters and borders on White background.

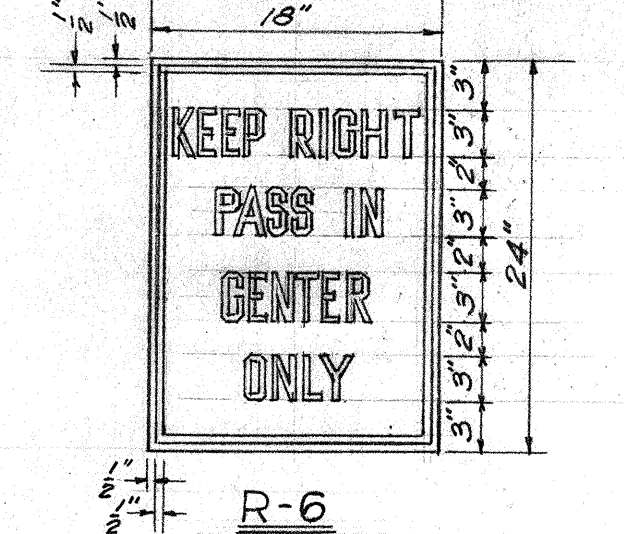


R-6
Black letters and borders on White background.

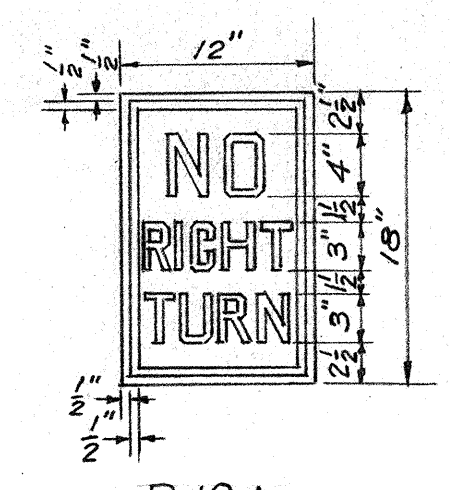


R-12A
Black letters and borders on White background.

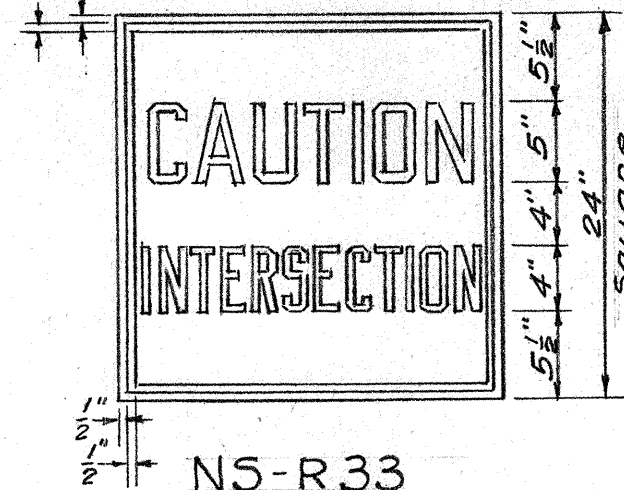


NS-R33
Black letters and borders on Yellow background.

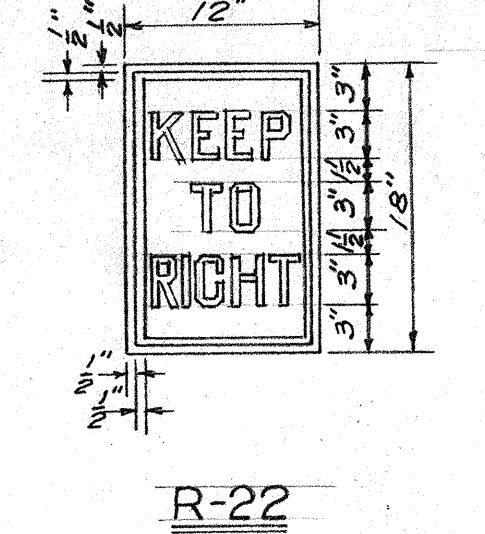


R-22
Black letters and borders on White background.

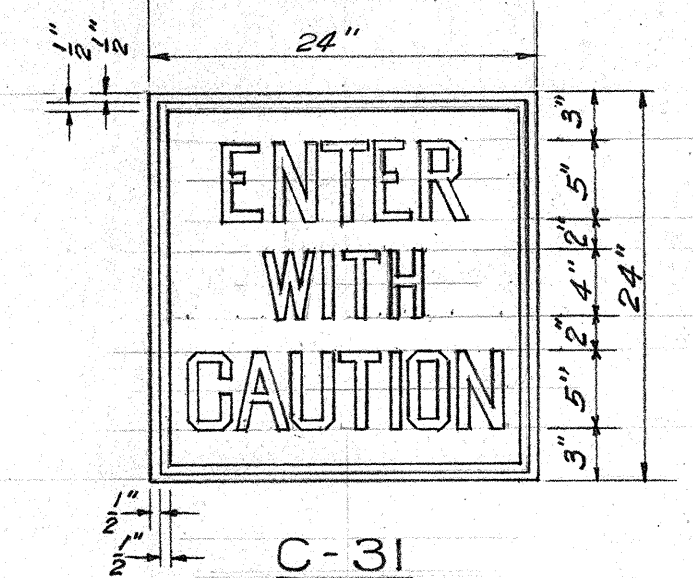


C-31
Black letters and borders on Yellow background.

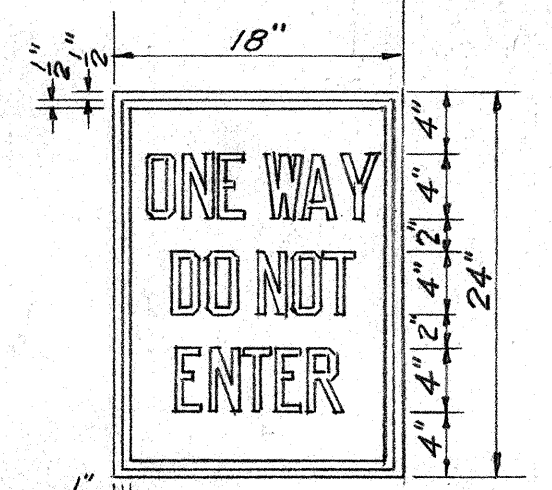


R-13
Black letters and borders on White background.

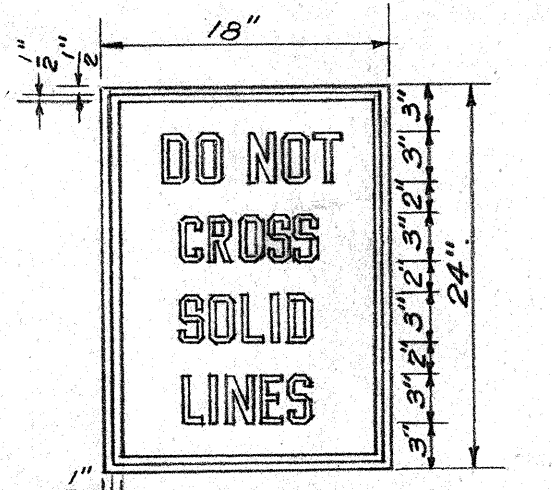

R-23
Black letters and borders on White background.

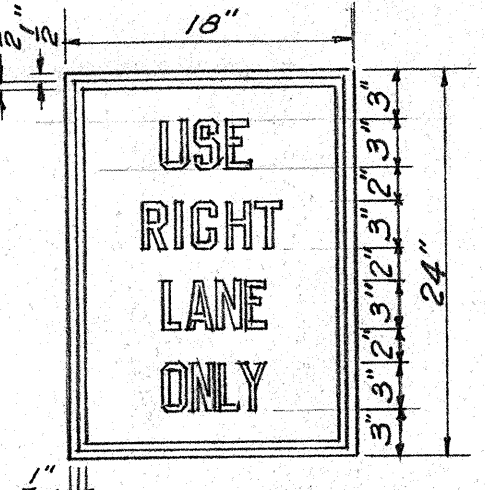

R-24
Black letters and borders on White background.

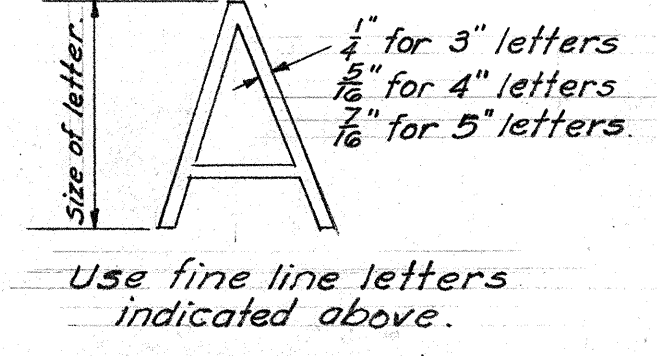

DETAILS OF TRAFFIC SIGNS
Scale: 1" = 1'-0"

TERRITORIAL HIGHWAY DEPARTMENT
TERRITORY OF HAWAII
LOCATION & DETAILS OF TRAFFIC SIGNS
ON
HALEAKALA ROAD & PAIA SPUR
HAWAII PROJECT No. DA-NC 8(1)
Feb. 10, 1945.

ORIGINAL PLAN NOTE BOOK
DESIGNED BY
DRAWN BY
CHECKED BY
DATE