

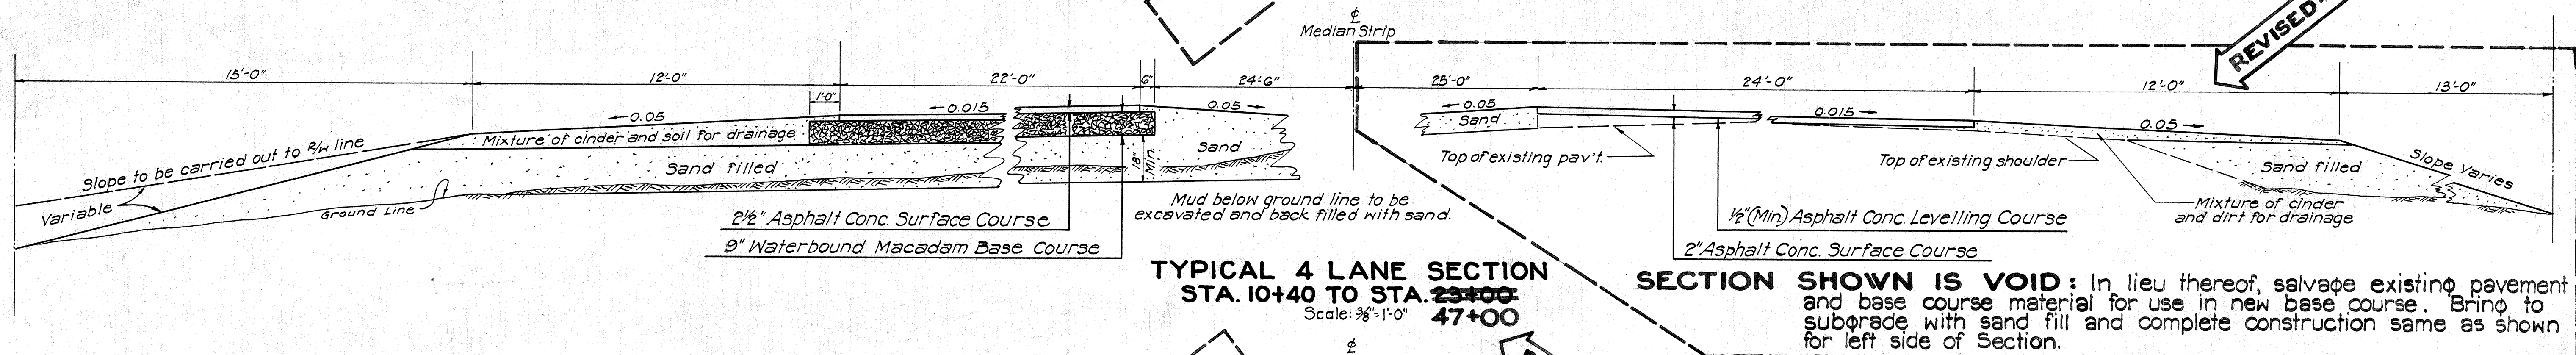
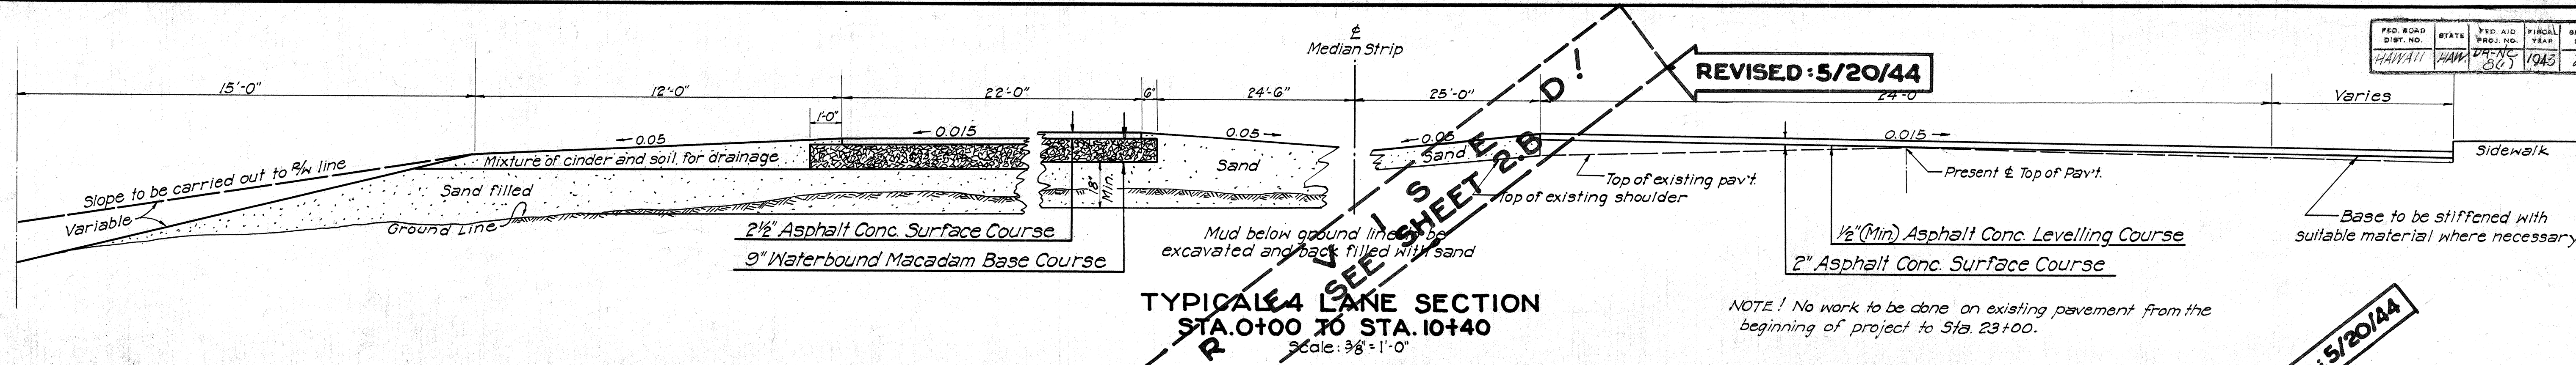


REVISED: 5/20/44

FED. ROAD DIST. NO.	STATE	PROJ. NO.	FISCAL YEAR	SHEET NO.	TOTAL SHEETS
HAWAII	HAWAII	DA-NC 807	1943	2	43

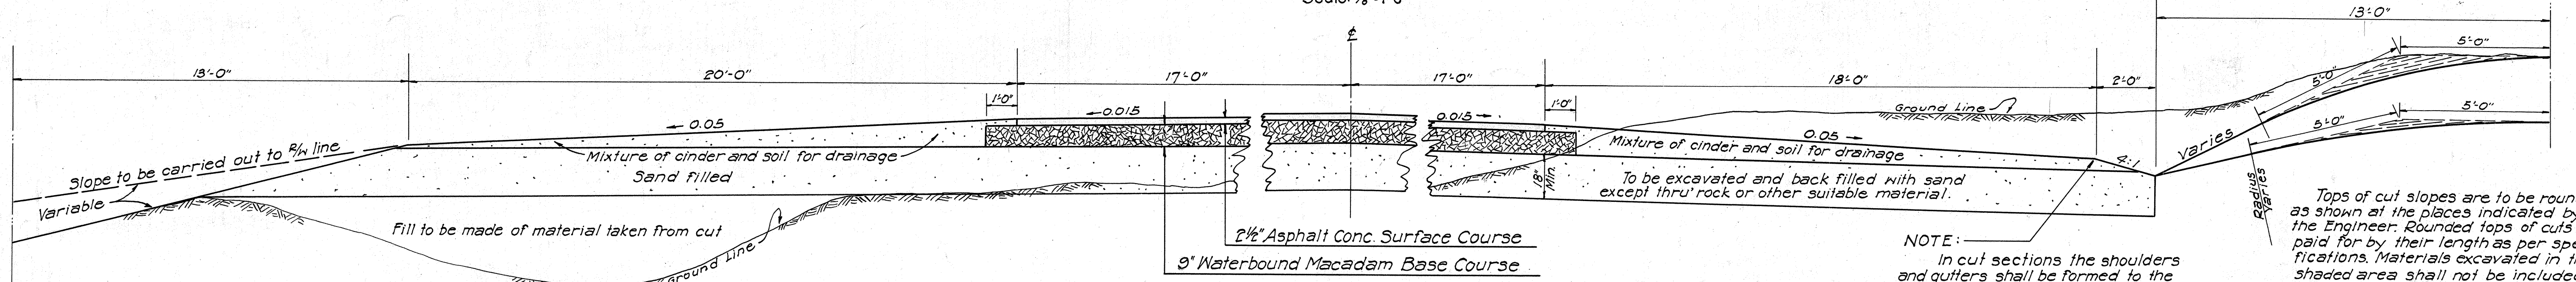


SECTION SHOWN IS VOID: In lieu thereof, salvage existing pavement and base course material for use in new base course. Bring to subgrade with sand fill and complete construction same as shown for left side of Section.

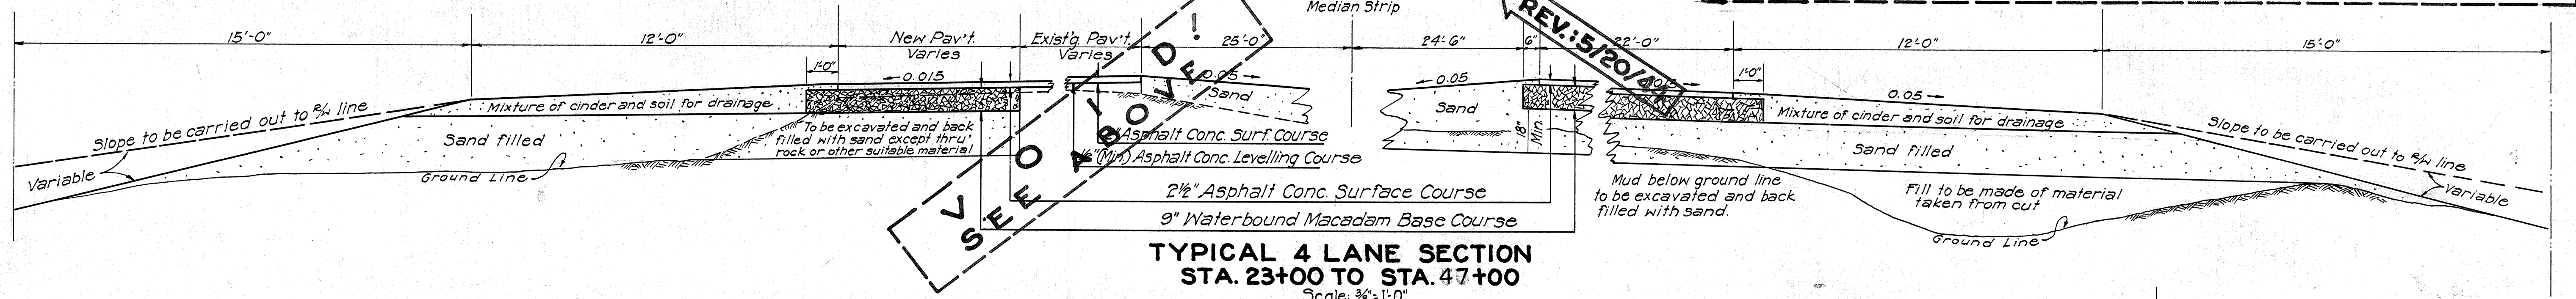

NOTE:
In cut sections the shoulders and gutters shall be formed to the dimensions and slopes required and then the edge of shoulders rounded off evenly at no particular radius.

Tops of cut slopes are to be rounded as shown at the places indicated by the Engineer. Rounded tops of cuts are paid for by their length as per specifications. Materials excavated in the shaded area shall not be included for payment under the items of "Excavation & Overhaul".

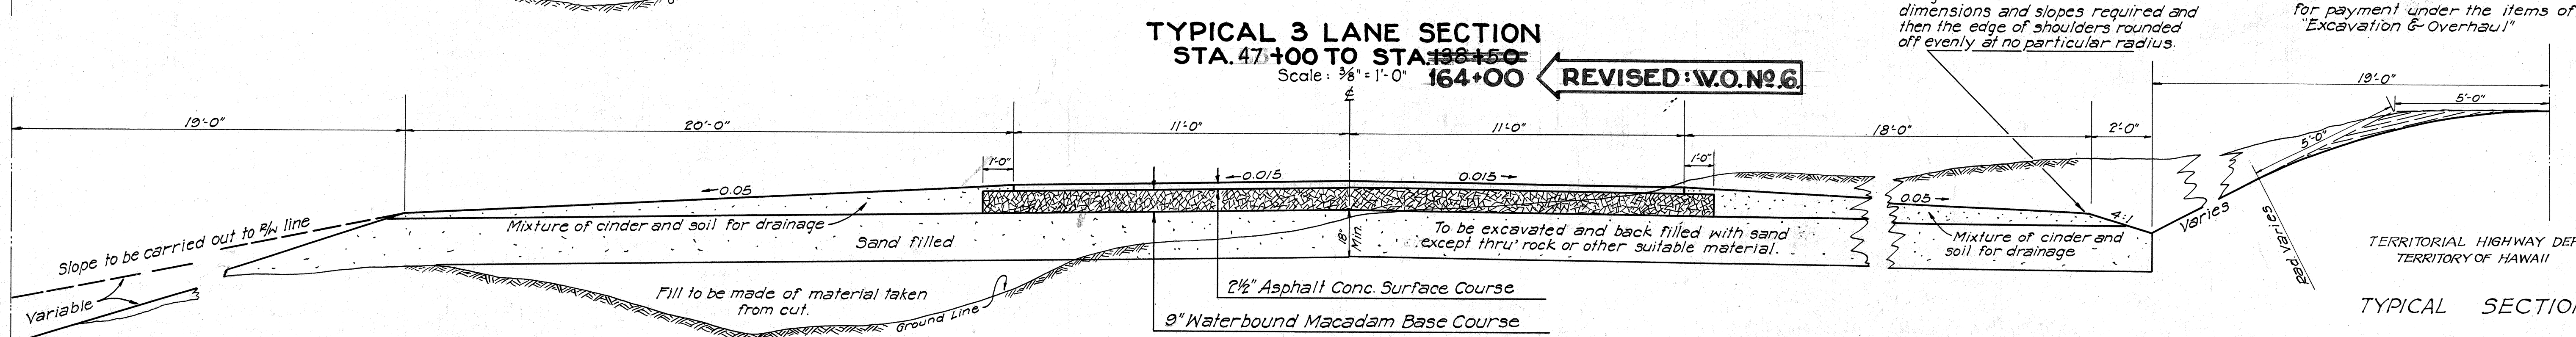

REVISED: 5/20/44 All Base Course to be changed to Cinder Base Course


TERRITORIAL HIGHWAY DEPARTMENT
TERRITORY OF HAWAII

TYPICAL SECTIONS


HALEAKALA RD. & PAIA SPUR DA-NC 8(1)

DA-NC 8(1) Maui 4/28/43-31


5119.2

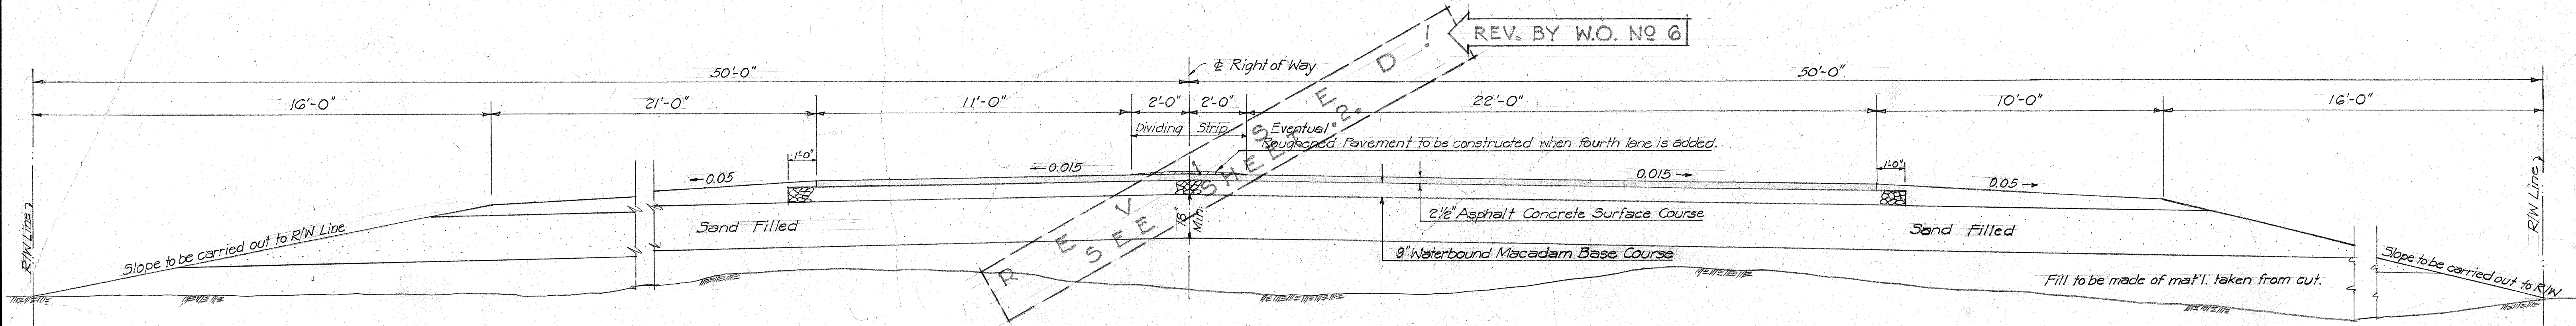

TYPICAL 3 LANE PAVEMENT STA. 138+50 TO STA. 164+00
Scale: 3/8" = 1'-0"

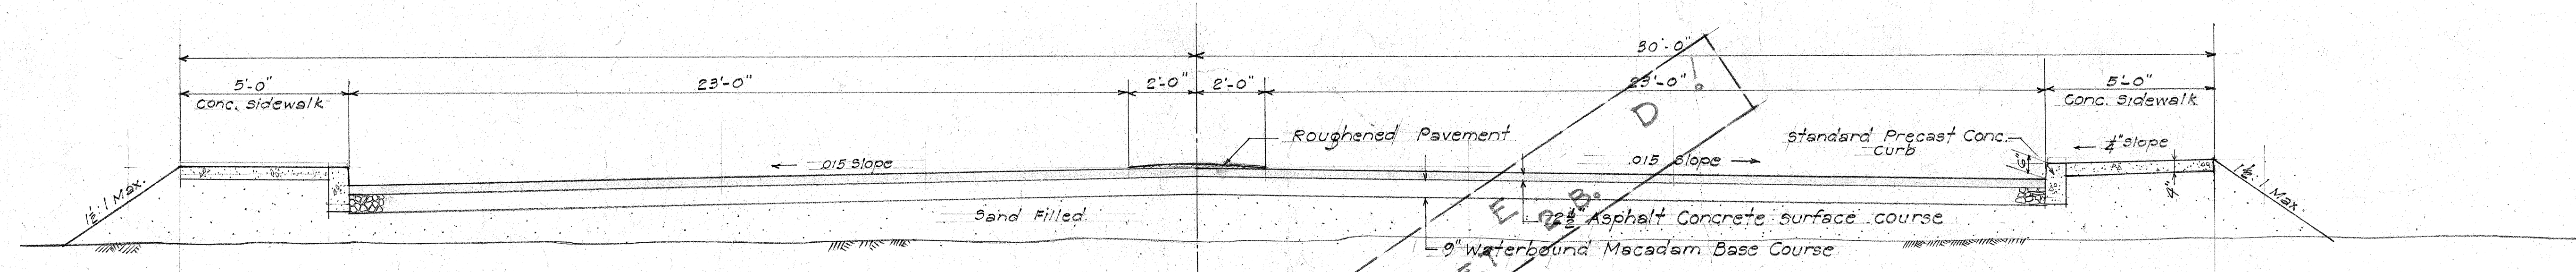

TYPICAL SECTION OF 46 FT. DIVIDED ON CONNECTION
Scale: 3/8" = 1'-0"

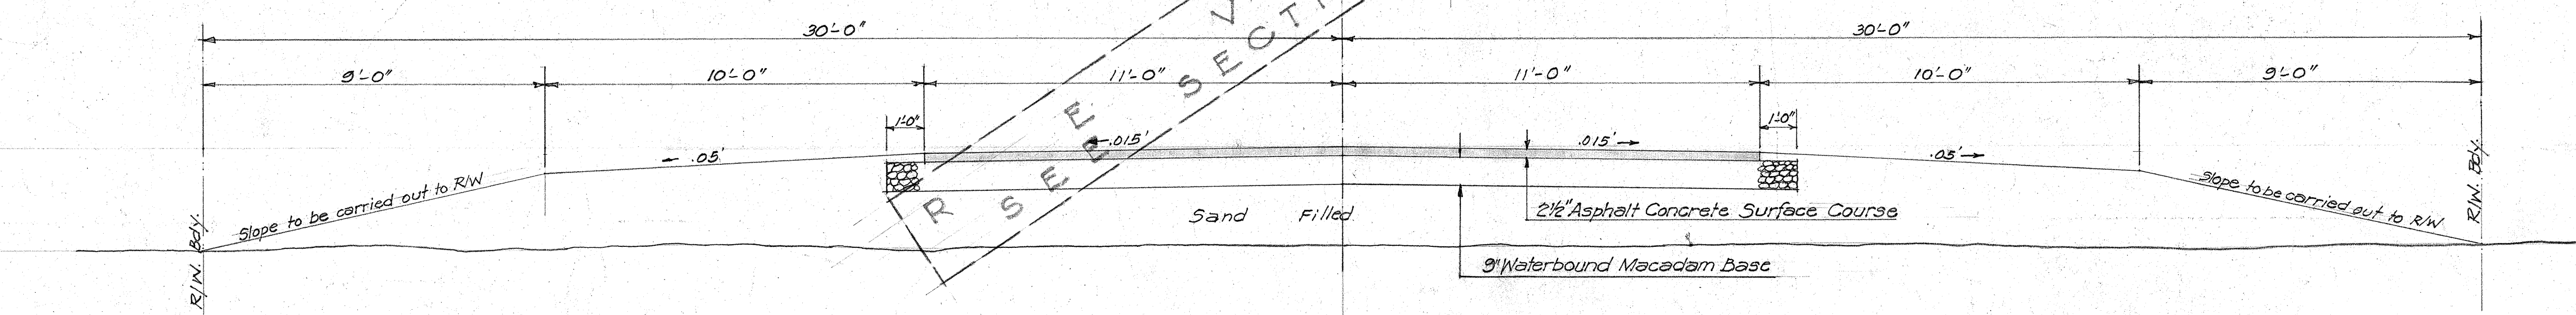

TYPICAL SECTION - HOBROH AVE. EXTENSION
Scale: 3/8" = 1'-0"

REVISED: 5/20/44


ORIGINAL PLAN	DATE
SURVEY PLOTTED BY	
DESIGNED BY	
DRAWN BY	
QUANTITIES CHECKED BY	
CHECKED BY	

TERRITORIAL HIGHWAY DEPARTMENT
TERRITORY OF HAWAII

TYPICAL SECTION


DA-NCB (1) Sept. 1943

NOTE: Beyond Sta. +38.12, the width of Median Strip varies from 16'0" as noted to 4'0" at Sta. 0+42.88 (End of traffic island).
North sidewalk varies from 6'0" at Sta. +38.90 (curb stationing) to 5'0" at Sta. 0+85.70.

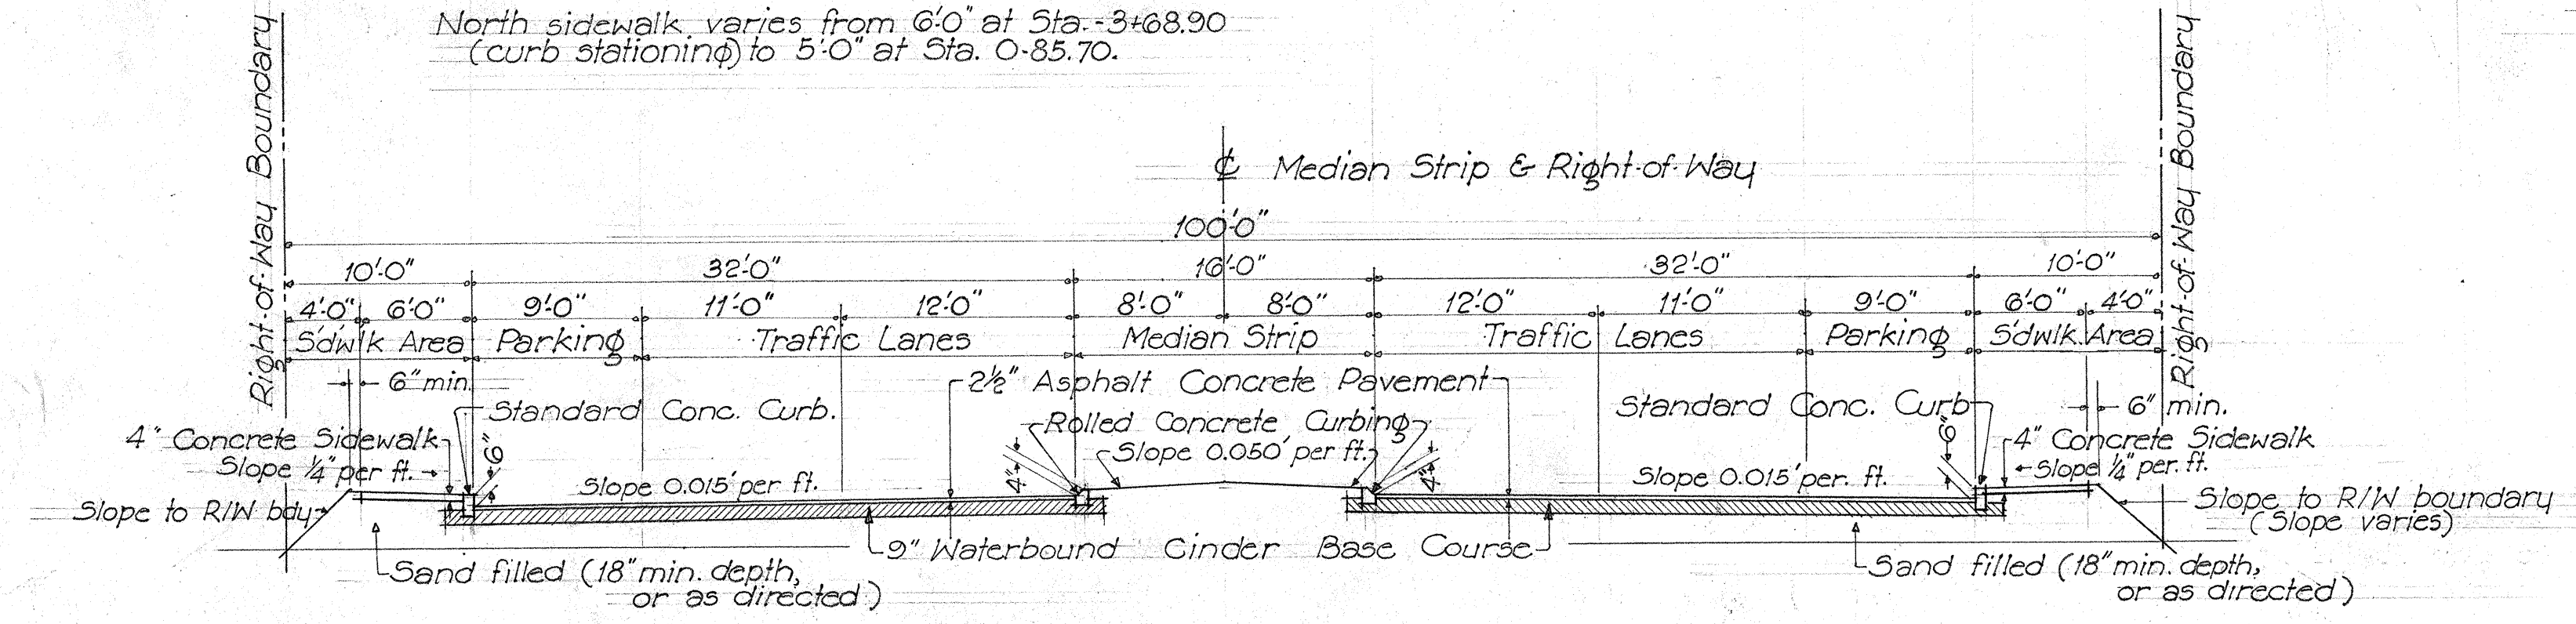


MAIN STREET: SECTION BACK OF STA. +38.29

Scale: 1/8" = 1'-0"

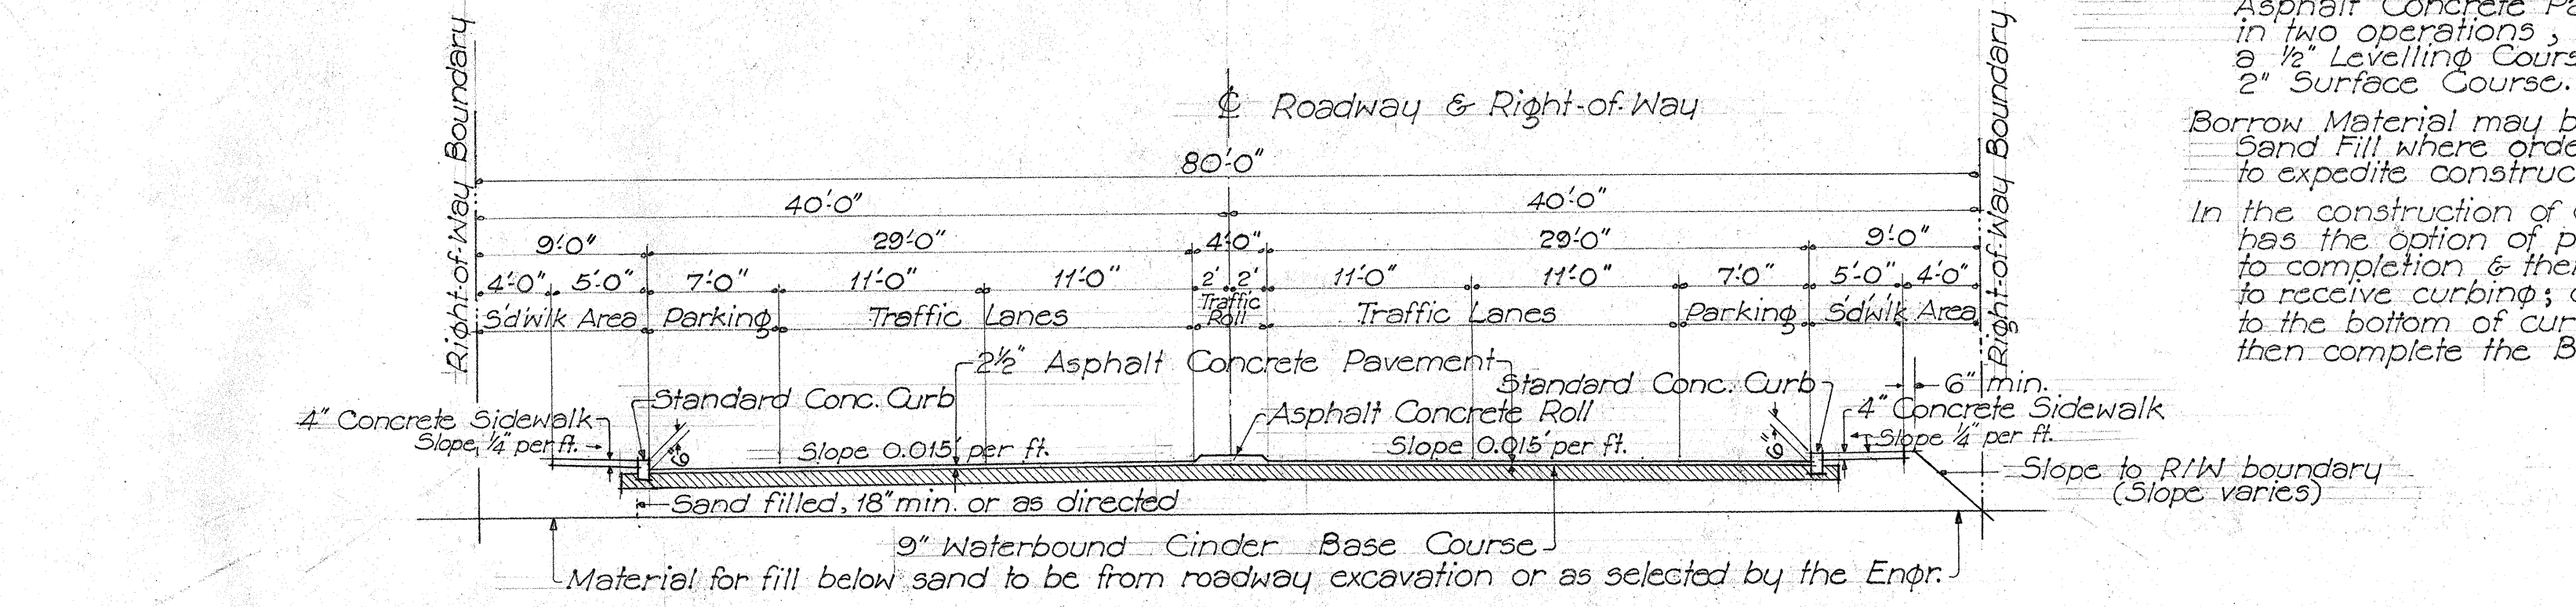


MAIN STREET: SECTION BEYOND STA. 0+42.88

Scale: 1/8" = 1'-0"

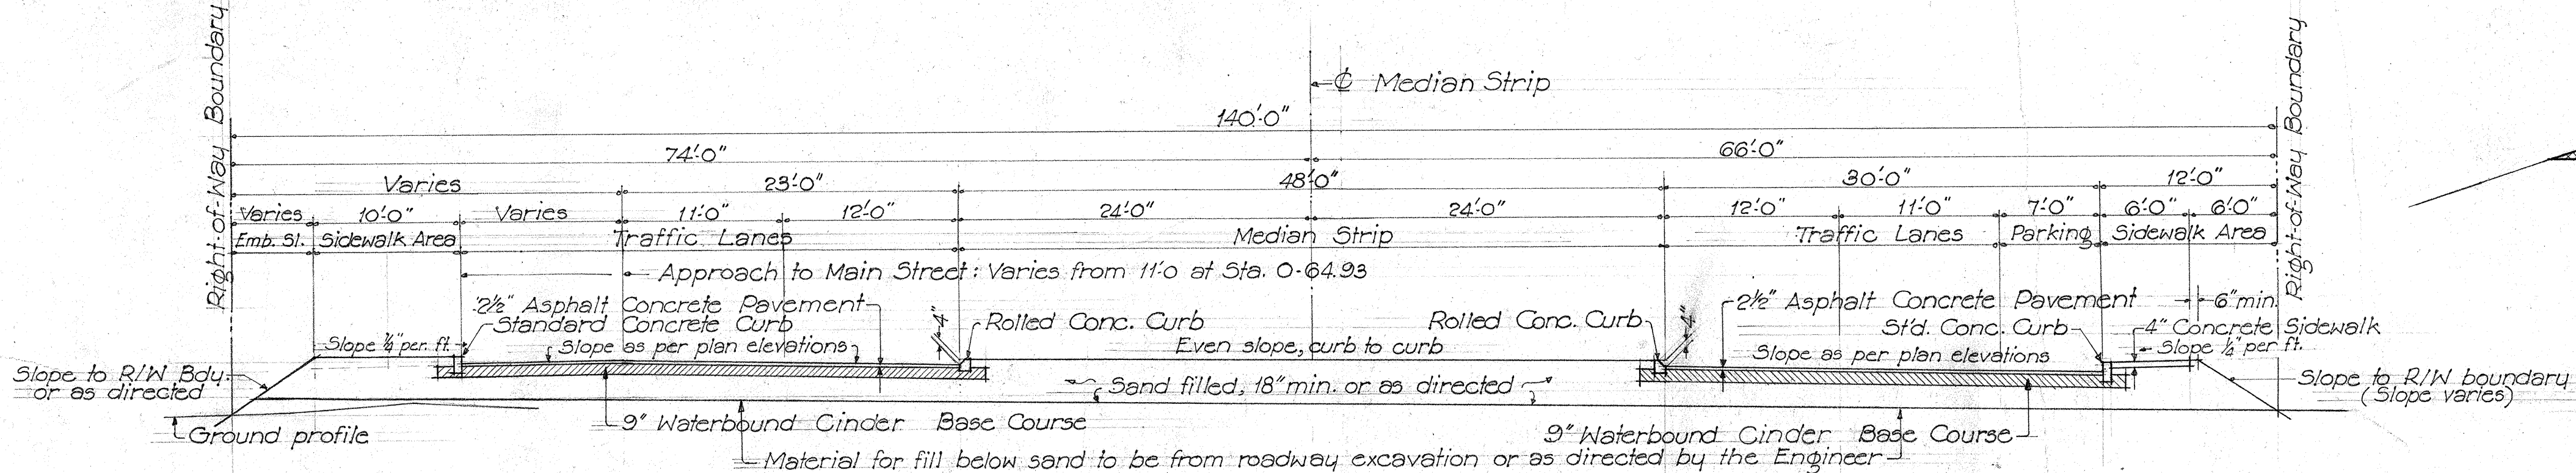


HALEAKALA ROAD: SECTION AT STA. 0+75

Scale: 1/8" = 1'-0"

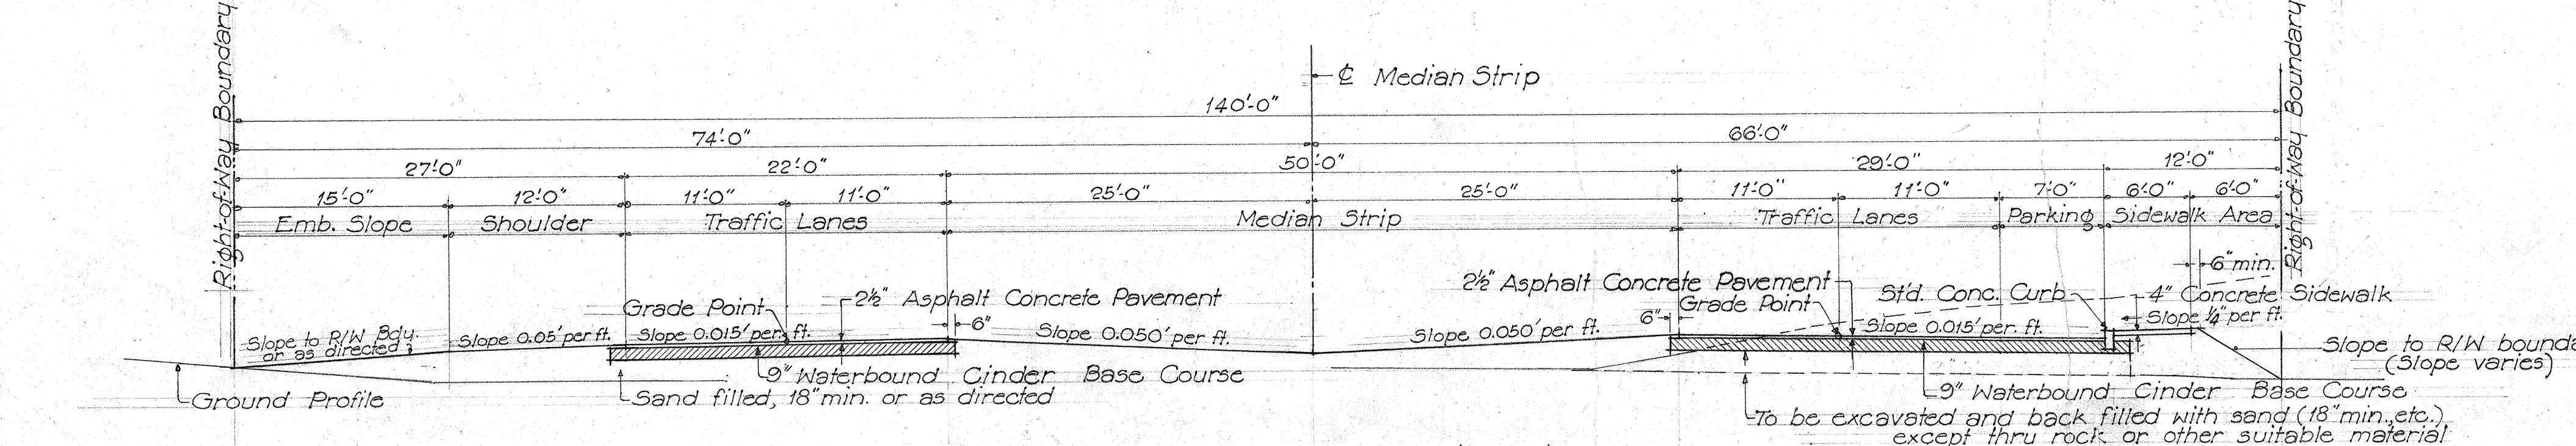


HALEAKALA ROAD: TYPICAL SECTION

Scale: 1/8" = 1'-0"
(From Sta. 0+00 to Sta. 10+40)

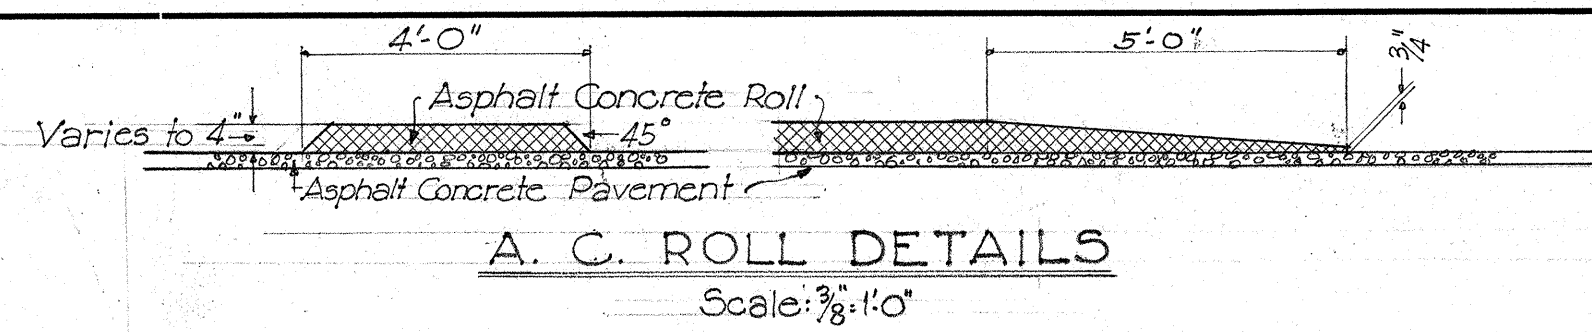


A. C. ROLL DETAILS

Scale: 1/8" = 1'-0"

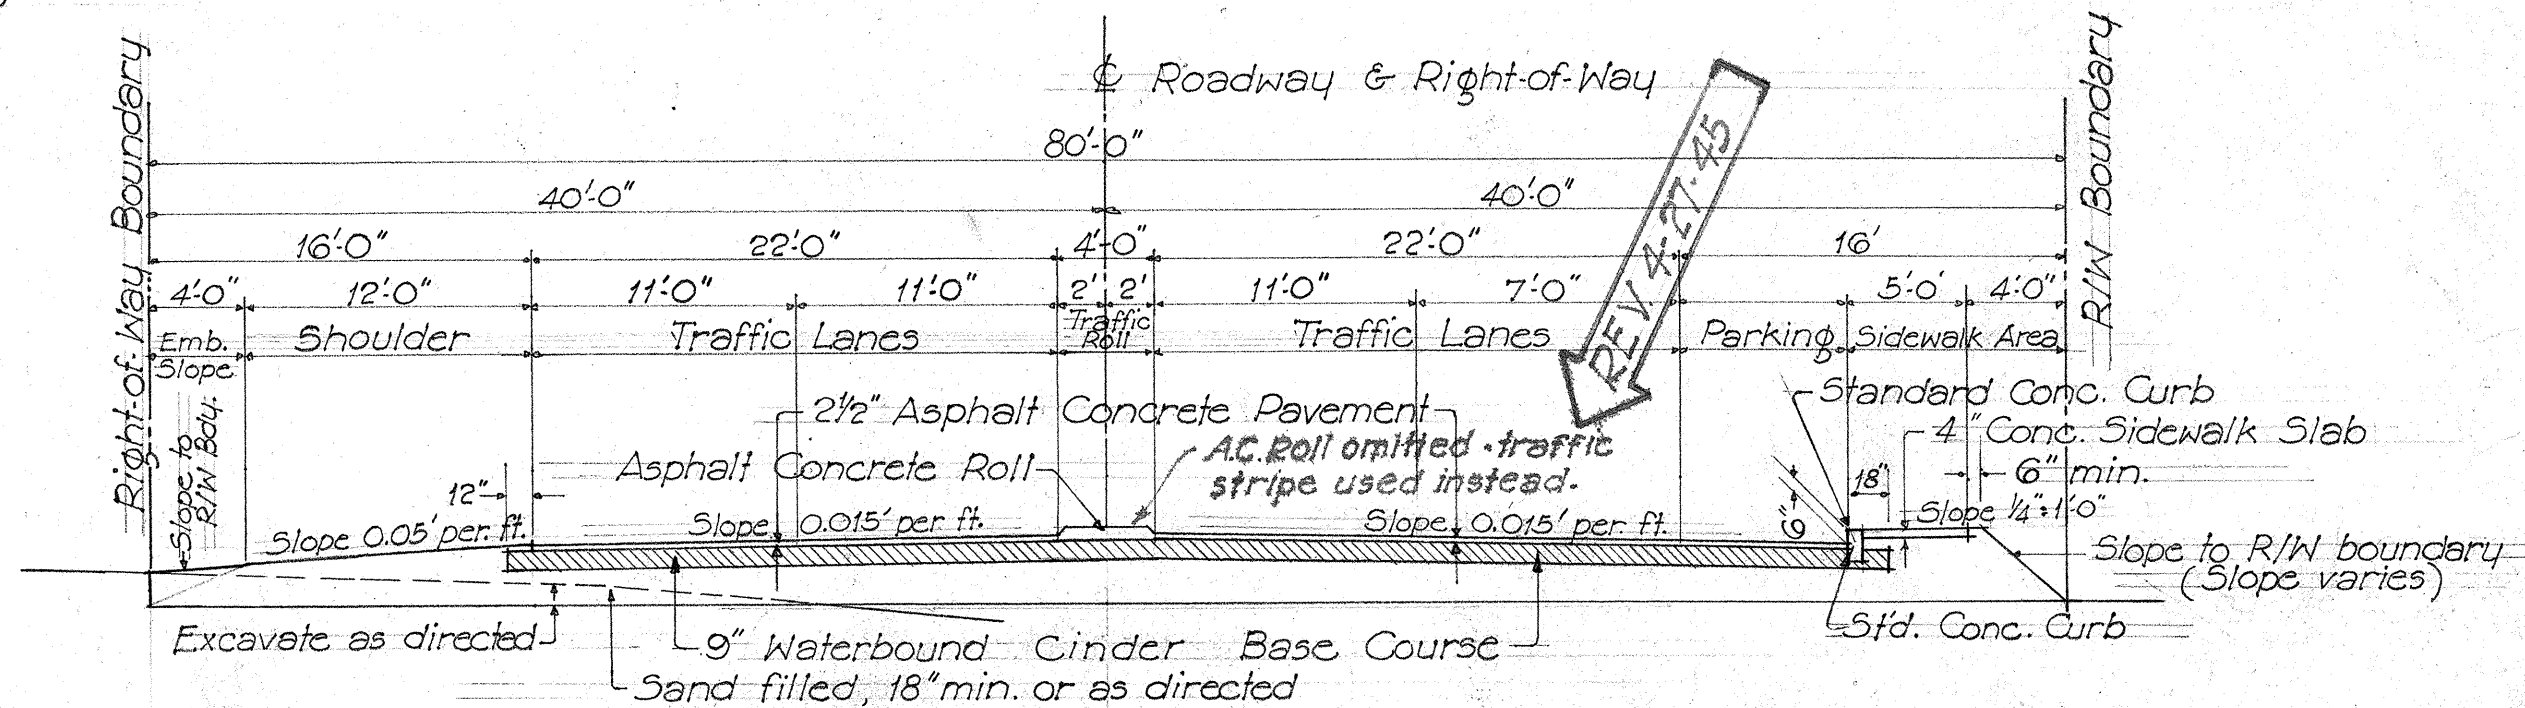


HOBRON AVENUE: 4 LANES DIVIDED

Scale: 1/8" = 1'-0"

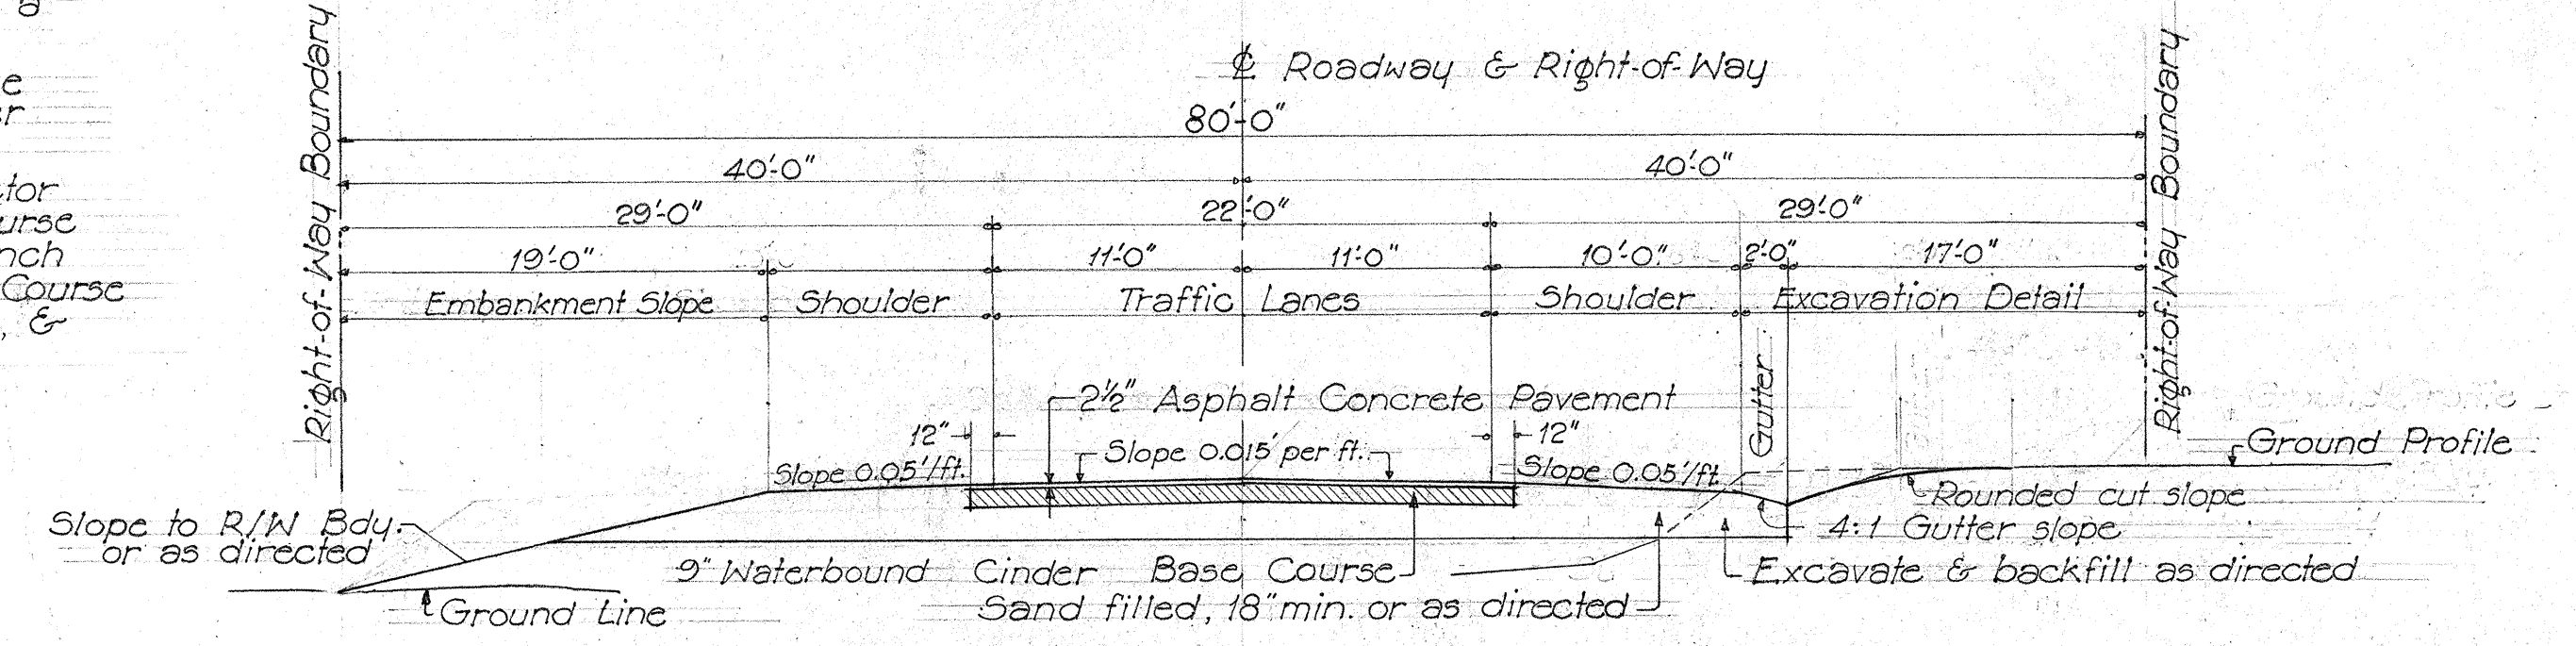


HOBRON AVENUE: 2 LANES UNDIVIDED

Scale: 1/8" = 1'-0"

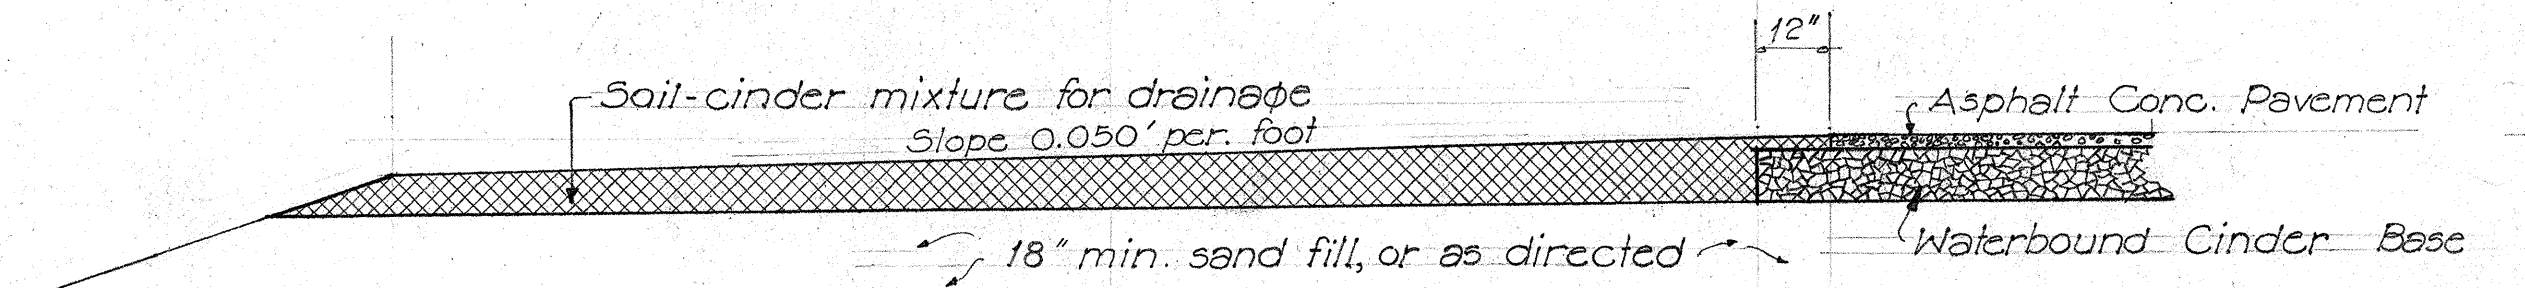

SHOULDER DETAIL

Scale: 1/8" = 1'-0"

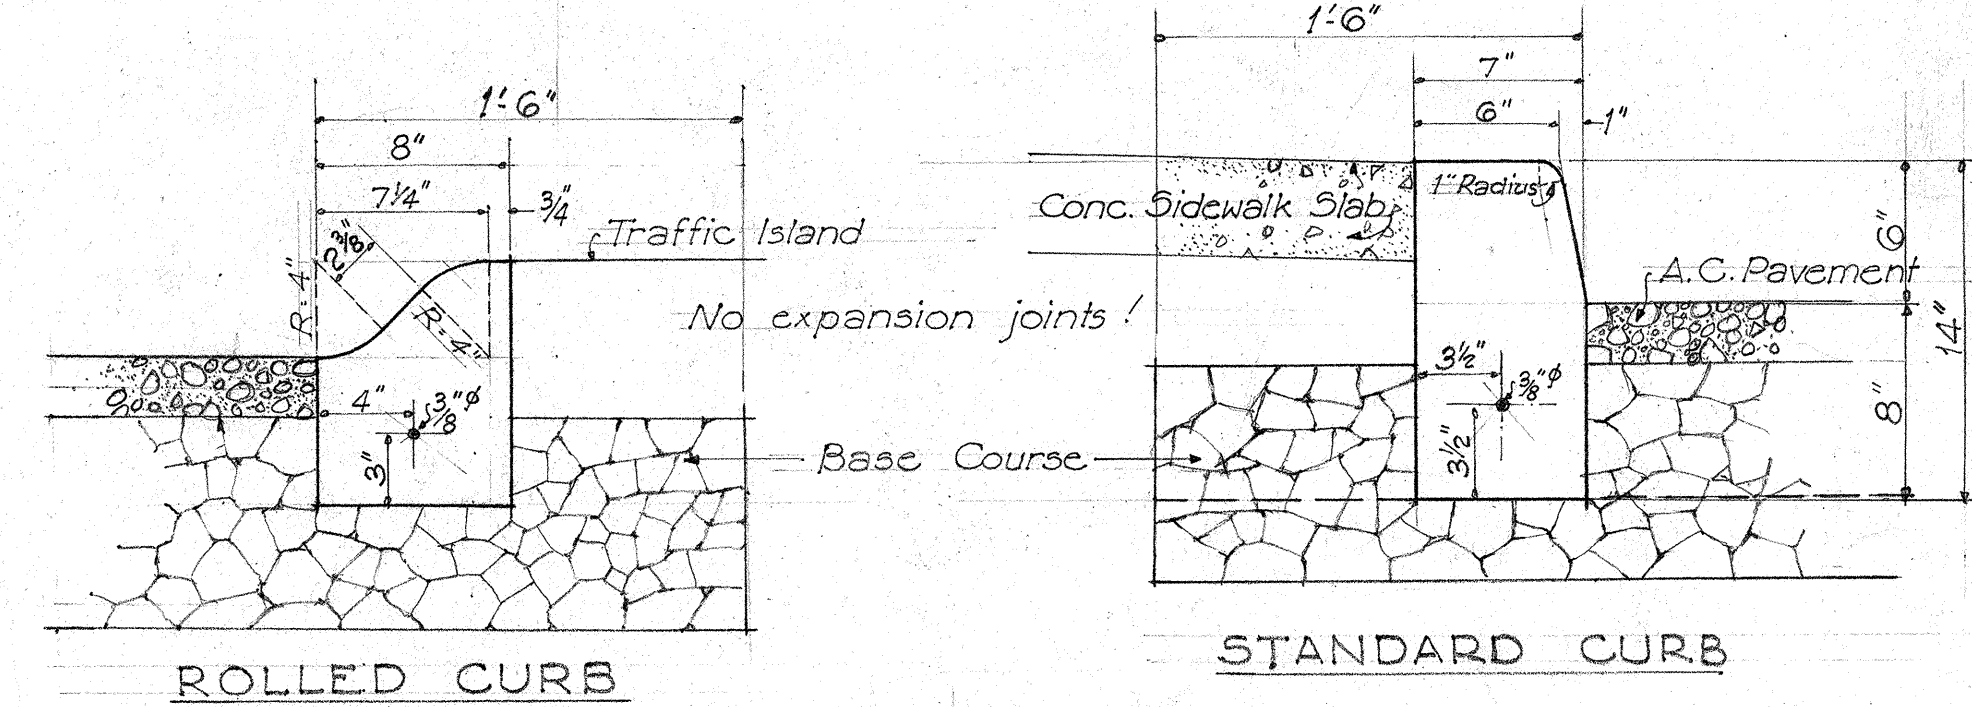

CURB SILHOUETTES

Scale: 1/8" = 1'-0"

SURVEY PLOTTED BY	DATE
DESIGNED BY	
TRACED BY	
QUANTITIES BY	
CHECKED BY	
NOTE BOOK	
No.	

TERRITORIAL HIGHWAY DEPARTMENT
TERRITORY OF HAWAII
REVISED SECTIONS
(REVISIONS MADE APRIL, 1944)
PROJECT NO DA-NC-8(1)
Haleakala Road - Paia Spur
Scales as noted May 1944
SHEET NO OF SHEETS